



Alabama State Port Authority
Addendum to R&P or Specification Booklet

Project Name Terminal Railway Office Addition/Renovation

Project No. 11012 **Task No.** 02 **Addendum No.** 2

To: Prospective Bidders

Date: 8/25/2022

The following items are clarifications to questions received. These items are hereby included in the bid documents by this addendum.

| Item | Description |
|------|---|
| 1. | The Pre-Bid sign in sheet is attached and is hereby incorporated into the bid documents by this addendum. |
| 2. | Attached is the revised Division I schedule of prices and is hereby incorporated into the bid documents by this addendum |
| 3. | A 5'x5 exterior canopy has been added above the exterior door on DWG. 4146-S3. DWG. 4146-S3 Rev C is attached and is hereby incorporated into the bid documents by this addendum. |
| 4. | The required U-Factor and SHGC value for windows has been revised on DWG. 4146-S4. DWG. 4146-S4 Rev C is attached and is hereby incorporated into the bid documents by this addendum. |
| 5. | Note 9 on DWG.4146-E1 has been revised to clarify the contractors requirement for installation of the automatic transfer switch. DWG. 4146-E1 Rev C is attached and is hereby incorporated into the bid documents by this addendum. |
| 6. | Additional exit fixtures and exterior wall mounted area fixtures have been added to DWG. 4146-E2. DWG. 4146-E2. Rev C is attached and is hereby incorporated into the bid documents by this addendum |
| 7. | Additional exit fixtures and exterior wall mounted area fixtures have been added to DWG. 4146-E3. DWG. 4146-E3. Rev C is attached and is hereby incorporated into the bid documents by this addendum |
| 8. | Note 12 on DWG.4146-E4 has been revised to clarify the contractors requirement for installation of the automatic transfer switch. DWG. 4146-E4 Rev C is attached and is hereby incorporated into the bid documents by this addendum. |
| 9. | Question: According the bid documents the breakroom is illustrated with case work. Please provide details and specs for this scope. Answer: A new drawing (4146-S4A) has been created to provide details and specifications for the case |



Alabama State Port Authority
Addendum to R&P or Specification Booklet

| | |
|-----|--|
| | <p>work in breakroom 209.</p> <p>DWG. 4146-S4A Rev C is attached and is hereby incorporated into the bid documents by this addendum.</p> |
| 10. | <p>Question: What color exterior wall panels is the owner requesting?</p> <p>Answer: New exterior wall panels shall be white.</p> |
| 11. | <p>Question: Is a geotechnical report available?</p> <p>Answer: Yes, the geotechnical report is attached to this addendum.</p> |
| 12. | <p>Question: Are test piles required to be driven for this project?</p> <p>Answer: No test piles will be required for this project.</p> |
| 13. | <p>Question: What master keying system does the owner use?</p> <p>Answer: Currently the owner uses Cal-Royal for locks. All new lock sets shall be compatible with the current building key.</p> |
| 14. | <p>Question: There are no specifications for the manufacturers for locks, hinges, closers. What locks are being used?</p> <p>Answer: Currently the owner uses Cal-Royal for locks and hinges.</p> |
| 15. | <p>Question: Per the door schedule the owner is only requiring hinges, locks, and some closers. Will floor stops and kick plates be required?</p> <p>Answer: Wall stops will be required. Kick Plates and floor stops are not required.</p> |
| 16. | <p>Question: Will the doors be welded or knockdown frames?</p> <p>Answer: New doors shall be welded frame</p> |
| 17. | <p>Question: What specific Vinyl Composition Tile (VCT) flooring product shall be used?</p> <p>Answer: Armstrong Standard Excelon Imperial Texture (Contractor shall provide owner with samples to determine color)</p> |
| 18. | <p>Question: Are all components of the exterior stairs on DWG. 4146-S10 to be galvanized or just the handrails?</p> <p>Answer: All components of the exterior stairs are to be hot dipped galvanized, in addition, generator platform and HVAC platform components are to be hot dipped galvanized.</p> |
| 19. | <p>Question: Can you provide information on the door hardware that need to be furnished for this job? In the specs it states lockets, passage, and strikes are to be furnished as per the Owner's master keying system.</p> <p>Answer: Contractor shall provide lock sets, hinges, and door closers as indicated on DWG. 4146-S4. Currently the owner uses Cal-Royal for locks. All new lock sets shall be compatible with the current building key.</p> |
| 20. | <p>Question: The door schedule calls for impact rated glass for all the interior door lites. The door schedule notes noted that the doors shall be 30-minute fire rated, but the rating on the door</p> |



Alabama State Port Authority
Addendum to R&P or Specification Booklet

| | |
|-----|--|
| | <p>schedule notes “none”. Can you confirm what type of glass you wanted to go in the interior door lites.</p> <p>Answer: DWG. 4146-S4 has been revised to state that interior door lites are to be tempered glass. In addition, the door schedule note for doors to be 30-minute fire rated has been deleted.</p> <p>DWG. 4146-S4 Rev C is attached and is hereby incorporated into the bid documents by this addendum.</p> |
| 21. | <p>Question: In the meeting it was stated by the electrical engineer that the future generator would need the future conduit ran. As per DWG 4146-E5 note 6 this is not the case. Please advise</p> <p>Answer: DWG. 4146-E5 has been revised to state that the future generator and conductors are not part of this contract and that the contractor shall install conduit from the ATS to the generator platform, stub-up, cap and install pull string for future use, see notes 4,7 & 8.</p> <p>DWG. 4146-E5 Rev C is attached and is hereby incorporated into the bid documents by this addendum.</p> |
| 22. | <p>Question: DWG 4146-E5 shows the electrical riser and the panel board coordination schedule. These conflict with each other, please clarify conduit/wire size for new service and service loads.</p> <p>Answer: The electrical riser diagram and panelboard schedules have been revised to reflect the required panelboard coordination schedule requirements.</p> <p>DWG. 4146-E5 Rev C is attached and is hereby incorporated into the bid documents by this addendum.</p> |

Please indicate your receipt of this addendum by adding the addendum number in the appropriate place in your Requisition & Proposal or Specification Book.

[illegible]



Alabama State Port Authority
Specification Booklet

Project Name 2022 Terminal Railway Operations Building Expansion

Location Mobile, AL

Project # 11012 **Task #** 02

May 2022

I-5 | Page

SCHEDULE OF PRICES

| ITEM | DESCRIPTION | QUANTITY | UNIT PRICE | AMOUNT |
|------|---|-----------|-------------|--------|
| 1.0 | General Construction Requirements | 1 LS | Lump Sum | \$ |
| 1.1 | Mobilization | 1 LS | Lump Sum | \$ |
| 1.2 | Demobilization | 1 LS | Lump Sum | \$ |
| 2.0 | <i><u>Site Work</u></i> | | | |
| 2.1 | Erosion Control | 1 LS | Lump Sum | \$ |
| 2.2 | Grading & Excavation for Building Area | _____ CY | \$_____ /CY | \$ |
| 2.3 | Concrete for Foundations | _____ CY | \$_____ /CY | \$ |
| 2.4 | Generator & HVAC Platform Foundation | _____ CY | \$_____ /CY | \$ |
| 2.5 | Timber Pile Installation | 1 LS | Lump Sum | \$ |
| 2.6 | Water Meter Relocation | 1 LS | Lump Sum | \$ |
| 2.7 | Utility Relocation (Power, Fiber Optics) | 1 LS | Lump Sum | \$ |
| 3.0 | <i><u>Structural Steel</u></i> | | | |
| 3.1 | Generator Platform | 1 LS | Lump Sum | \$ |
| 3.2 | HVAC Platform | 1 LS | Lump Sum | \$ |
| 4.0 | <i><u>Building Addition/Renovation</u></i> | | | |
| 4.1 | New Office Addition | LS | Lump Sum | \$ |
| 4.2 | Existing Office Renovation | LS | Lump Sum | \$ |
| 5.0 | <i><u>Mechanical Components and Systems</u></i> | | | |



Alabama State Port Authority
Specification Booklet

Project Name 2022 Terminal Railway Operations Building Expansion

Location Mobile, AL




Project # 11012 **Task #** 02

May 2022


I-6 | Page

| | | | | |
|-----|---|----|-----------|----|
| 5.1 | VRF Equipment | LS | Lump Sum | \$ |
| 5.2 | Exhaust Fans | LS | Lump Sum | \$ |
| 5.3 | Ductwork | LS | Lump Sum | \$ |
| 6.0 | <u>Electrical Components and Systems</u> | | | |
| 6.1 | Office Area | LS | Lump Sum | \$ |
| 6.2 | Generator Auto-Transfer Switch | LS | Lump Sum | \$ |
| 7.0 | <u>Plumbing</u> | | | |
| 7.1 | Office Area | LS | Lump Sum | \$ |
| 8.0 | Miscellaneous | LS | Lump Sum | \$ |
| | Total Base Bid | | \$ | |
| 9.0 | Bid Alternate-Slab-On-Grade | LS | Lump Sum | \$ |

- (1) This is a Lump Sum Bid for the work as shown on the drawings and as specified. The quantity under each item may be increased, decreased, or deleted after award of Contract in accordance with provisions of the Contract Documents. The Unit Prices are for adjustment only.
- (2) Total Base Bid shall be the sum of Items 1.0 – 8.0. All optional items to be included in the contract shall be approved by the Owner.
- (3) The general construction requirements should include insurances, taxes, overhead profit and all other miscellaneous construction activities involved with the specific construction phase including in the drawings or specifications.
- (4) Miscellaneous (Item 8.0) should include final grading and any other items not specifically detailed in the schedule of prices but including in the drawings or specifications.

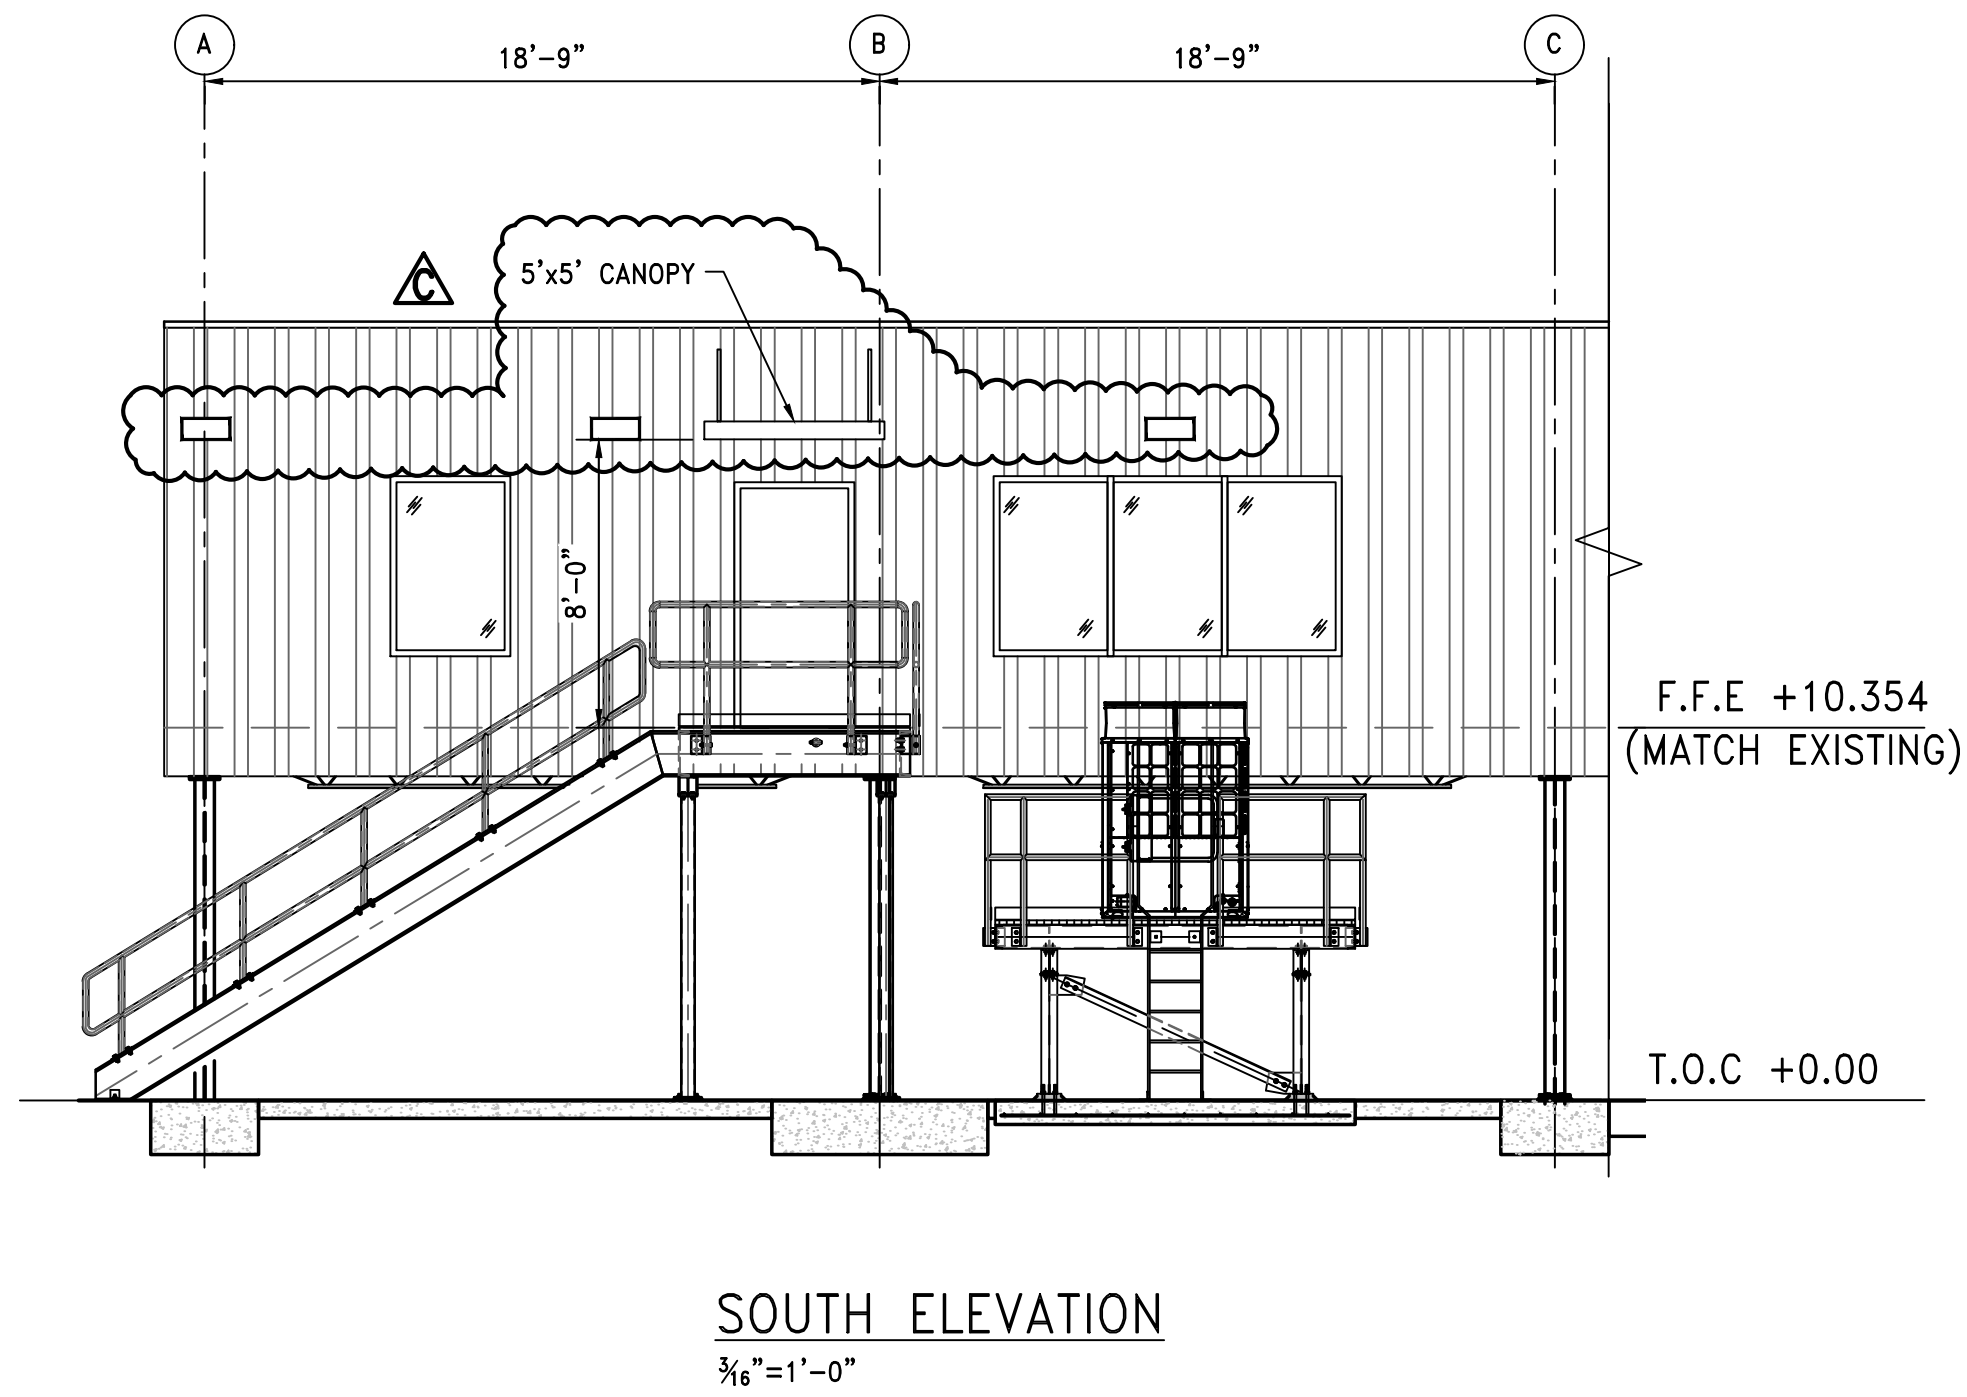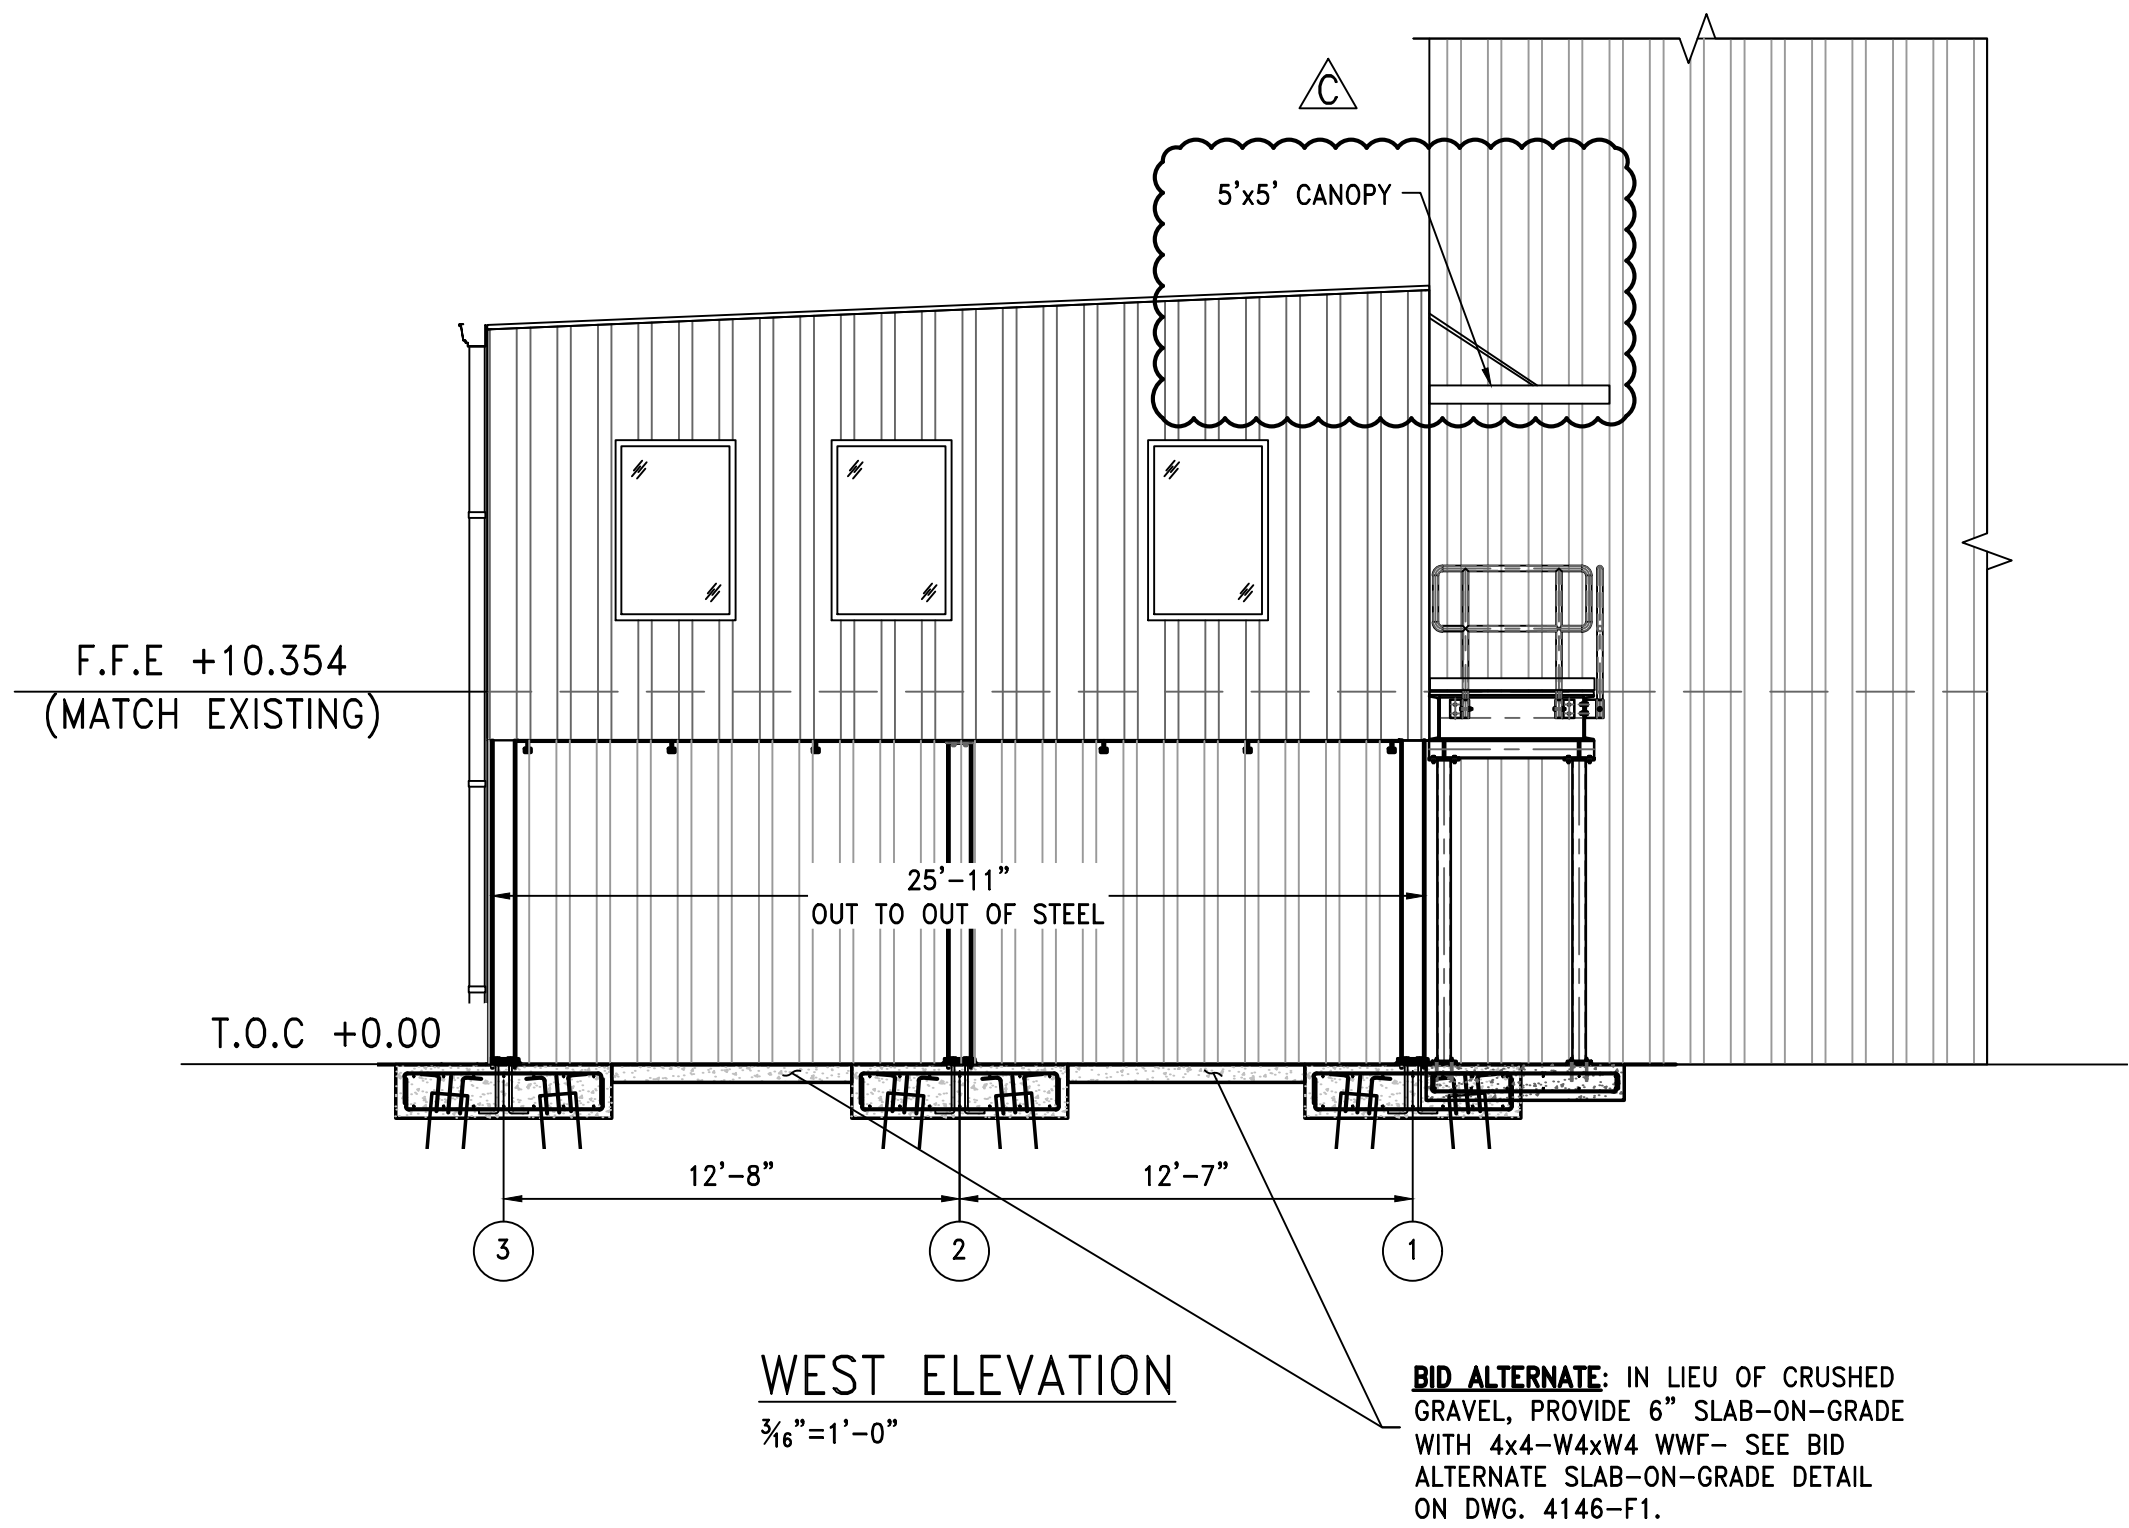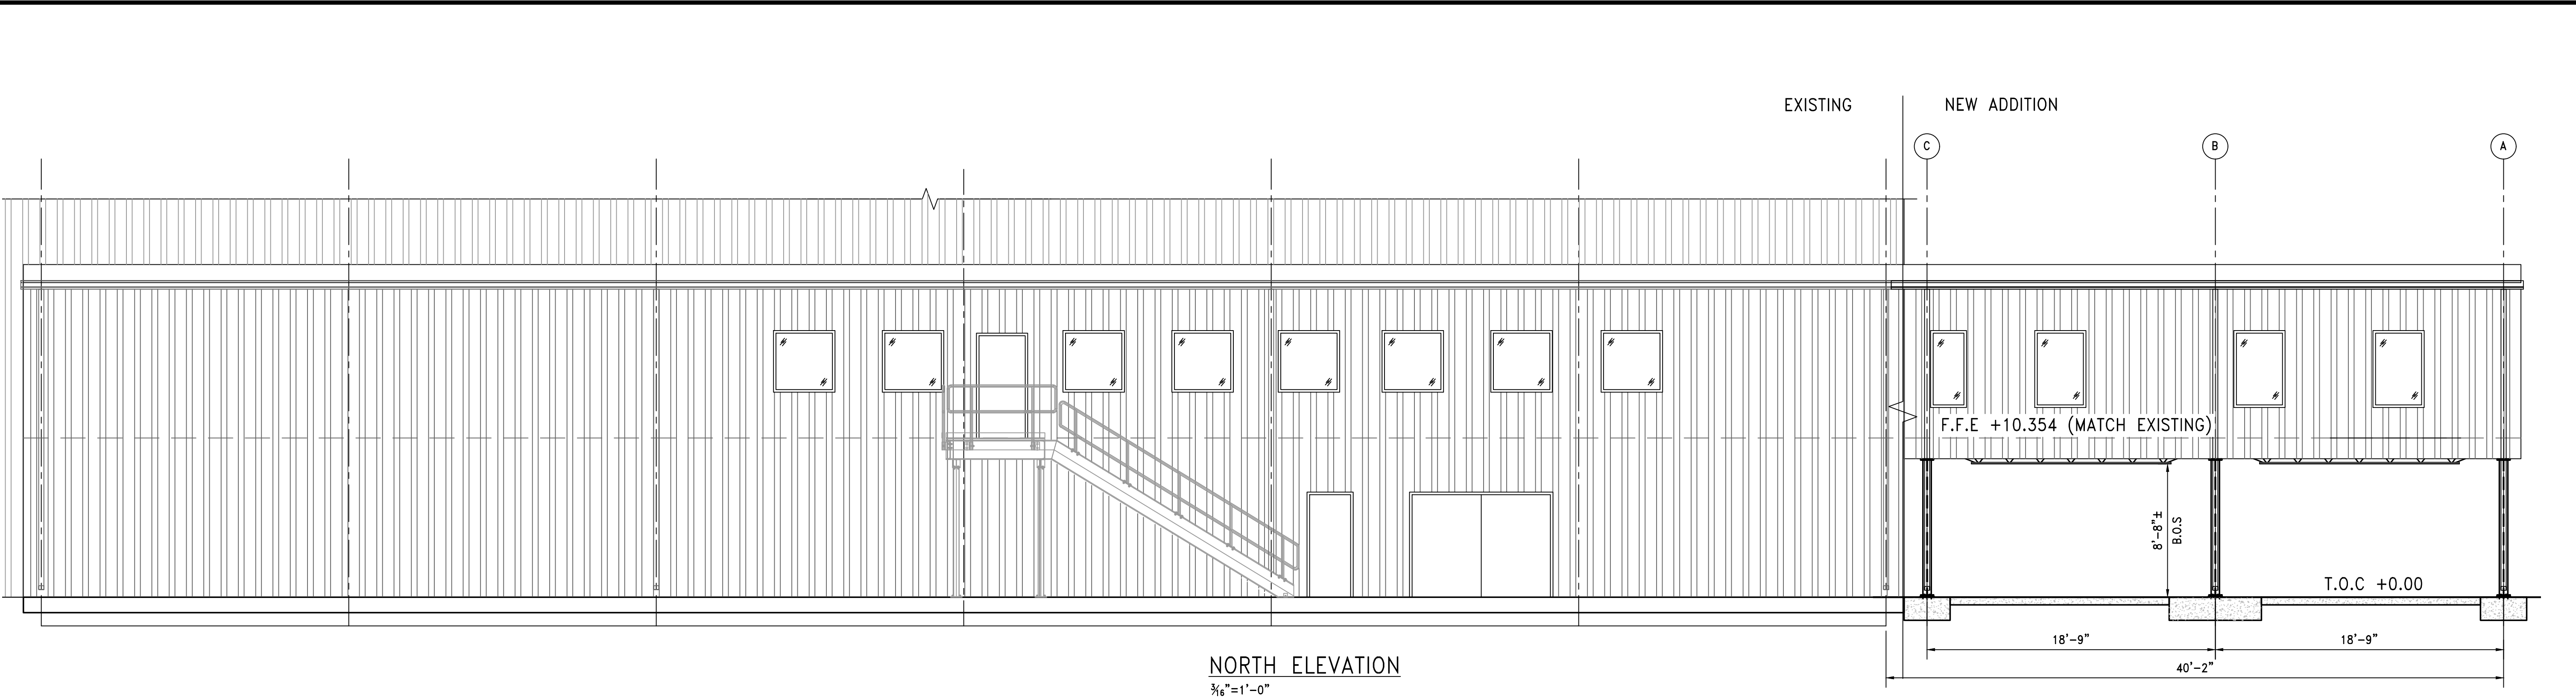

© COWLES, MURPHY, GLOVER & ASSOCIATES, INC. 2022
CONFIDENTIAL, VALUABLE, AND PROPRIETARY INFORMATION

| | | | | | | | | | | | | | | |
|------|---|----------|-----|-------|---|--|--|---------------------|----------|--------------|----------|----------------|----|--|
| | | | | |  <p>Cowles, Murphy, Glover & ASSOCIATES <i>A Full Service Engineering Firm</i></p> <p>PERFORMANCE • RELIABILITY • EXPERIENCE</p> | PROJECT | | TITLE | | 22x34 REV. C | | | | |
| | | | | | | TERMINAL RAILWAY OFFICE ADDITION/RENOVATION | | EXTERIOR ELEVATIONS | | | | | | |
| | | | | | | 126 INDUSTRIAL CANAL ROAD MOBILE, ALABAMA | | | | | | | | |
| | | | | | | | | | | | | | | |
| | | | | | | | | | | | | | | |
| C | ADDENDUM 2 ADD EGRESS LIGHTING AND CANOPY | 08/25/22 | JWM | GDEC | 457 St. Michael St., Mobile, AL 36602 13 Thrash Rd., LaGrange, GA 30241 11880 Cranston Dr. Ste 102, Arlington, TN 38002 Alabama (251) 433-1611 Georgia (706) 302-2831 Tennessee (901) 290-5444 | | | | SCALE | DRAWN BY | DATE | SHEET | OF | |
| B | ISSUED FOR BID | 08/01/22 | JWM | GDEC | | | | | AS NOTED | JWM | 05/31/22 | | | |
| REV. | DESCRIPTION | DATE | BY | CHK'D | | | | | JOB NO. | CHECKED BY | DATE | DRAWING NUMBER | | |
| | | | | | | | | | 4146-22 | JDG | 05/31/22 | 4146-S3 | | |

| ROOM FINISH SCHEDULE | | | | | | | | | | |
|----------------------|-------------------|-------|------|------|---|---|---|---------|--------|-----------------------------|
| ROOM | | FLOOR | BASE | WALL | | | | CEILING | | REMARKS |
| | | | | N | S | E | W | MAT'L | HEIGHT | |
| 201 | OFFICE 1 | VCT | VB | 2 | 1 | 1 | 1 | LI | 8' | |
| 202 | OFFICE 2 | VCT | VB | 2 | 1 | 1 | 1 | LI | 8' | |
| 203 | OFFICE 3 | VCT | VB | 2 | 1 | 1 | 1 | LI | 8' | |
| 204 | CONFERENCE ROOM | VCT | VB | 1 | 2 | 1 | 1 | LI | 8' | |
| 205 | OFFICE 4 | VCT | VB | 2 | 1 | 1 | 1 | LI | 8' | |
| 206 | OFFICE 5 | VCT | VB | 2 | 1 | 1 | 1 | LI | 8' | |
| 207 | OFFICE 6 | VCT | VB | 2 | 1 | 1 | 2 | LI | 8' | |
| 208 | OFFICE 7 | VCT | VB | 1 | 2 | 1 | 2 | LI | 8' | |
| 209 | BREAKROOM | VCT | VB | 1 | 2 | 1 | 1 | LI | 8' | |
| 210 | OFFICE 8 | VCT | VB | 1 | 2 | 1 | 1 | LI | 8' | |
| 211 | OFFICE 9 | VCT | VB | 1 | 2 | 1 | 1 | LI | 8' | |
| 212 | OFFICE 10 | VCT | VB | 1 | 2 | 1 | 1 | LI | 8' | |
| 213 | CORRIDOR | VCT | VB | 1 | 1 | 1 | 1 | LI | 8' | |
| 214 | CORRIDOR | VCT | VB | 1 | 1 | 1 | 1 | LI | 8' | |
| 215 | CLOSET | VCT | VB | 1 | 1 | 1 | 1 | LI | 8' | |
| 216 | RESTROOM | VCT | CB | 3 | 3 | 3 | 3 | LI | 8' | |
| 217 | OFFICE 11 | VCT | VB | 1 | 2 | 2 | 1 | LI | 8' | |
| 218 | OPERATIONS OFFICE | VCT | VB | 2 | 1 | 1 | 1 | LI | 8' | |
| 219 | CLOSET | EX | EX | 4 | 4 | 4 | 4 | LI | 8' | |
| 220 | CLOSET | EX | EX | 4 | 4 | 4 | 4 | LI | 8' | |
| 221 | LOCKER ROOM | EX | EX | 4 | 4 | 4 | 4 | LI | 8' | |
| 222 | WOMEN'S RESTROOM | EX | EX | 4 | 4 | 4 | 4 | LI | 8' | TOILET PARTITIONS TO REMAIN |
| 223 | MEN'S RESTROOM | EX | EX | 4 | 4 | 4 | 4 | LI | 8' | TOILET PARTITIONS TO REMAIN |

ROOM FINISH SCHEDULE

KEY NOTES

WALLS:

1.

3½" METAL STUD WALL FRAMING WITH ⅝" PAINTED GYPSUM WITH ¾" BATT INSULATION

2.

3½" METAL STUD WALL FRAMING WITH ⅝" PAINTED GYPSUM WITH SPRAY FOAM INSULATION

3.

3½" METAL STUD WALL FRAMING WITH ⅝" MOISTURE RESISTANT PAINTED GYPSUM WITH ¾" BATT INSULATION AND ¼" FRP 4'-0" HIGH WITH 3" OF BATT INSULATION

4.

EXISTING WALLS TO REMAIN

FLOORING:

VCT

VINYL COMPOSITION TILE

EX

EXISTING TO REMAIN

CEILING:

LI

ARMSTRONG TILE #1728 FINE FISSURED 2'X2'X½" MINERAL BOARD, WHITE, SQUARE EDGE DETAIL, 6¼" BATT INSULATION.

BASE:

CB

6" HIGH CERAMIC BASE

VB

VINYL BASE

EX

EXISTING TO REMAIN

| DOOR # | RATING | DOOR SIZE | DOOR MATERIAL | FRAME MATERIAL | HARDWARE | REMARKS |
|--------|--------|---------------|---------------------------|----------------|---|------------------------------------|
| 201A | NONE | 3'-0" x 7'-0" | SCWD | METAL | PRIVACY LOCK SET, 1½ PAIR S.S. BUTT HINGES | CT GLASS-SEE DOOR TYPE "B" |
| 201B | NONE | 3'-0" x 7'-0" | SCWD | METAL | PRIVACY LOCK SET, 1½ PAIR S.S. BUTT HINGES | CT GLASS-SEE DOOR TYPE "B" |
| 202A | NONE | 3'-0" x 7'-0" | SCWD | METAL | PRIVACY LOCK SET, 1½ PAIR S.S. BUTT HINGES | CT GLASS-SEE DOOR TYPE "B" |
| 202B | NONE | 3'-0" x 7'-0" | SCWD | METAL | PRIVACY LOCK SET, 1½ PAIR S.S. BUTT HINGES | CT GLASS-SEE DOOR TYPE "B" |
| 203 | NONE | 3'-0" x 7'-0" | SCWD | METAL | PRIVACY LOCK SET, 1½ PAIR S.S. BUTT HINGES | CT GLASS-SEE DOOR TYPE "B" |
| 204A | NONE | 3'-0" x 7'-0" | SCWD | METAL | DOOR CLOSER, 1½ PAIR S.S. BUTT HINGES | CT GLASS-SEE DOOR TYPE "C" |
| 204B | 60 PSF | 3'-0" x 7'-0" | METAL DOOR WITH POLY CORE | METAL | ENTRY LOCKSET W/ DEADBOLT, DOOR CLOSER, 1½ PAIR S.S. BUTT HINGES, VINYL DOOR SEAL, NEOPRENE SWEEP, SADDLE THRESHOLD | CT/IR GLASS-SEE DOOR TYPE "A" |
| 205 | NONE | 3'-0" x 7'-0" | SCWD | METAL | PRIVACY LOCK SET, 1½ PAIR S.S. BUTT HINGES | CT GLASS-SEE DOOR TYPE "B" |
| 206 | NONE | 3'-0" x 7'-0" | SCWD | METAL | PRIVACY LOCK SET, 1½ PAIR S.S. BUTT HINGES | CT GLASS-SEE DOOR TYPE "B" |
| 207 | NONE | 3'-0" x 7'-0" | SCWD | METAL | PRIVACY LOCK SET, 1½ PAIR S.S. BUTT HINGES | CT GLASS-SEE DOOR TYPE "B" |
| 208 | NONE | 3'-0" x 7'-0" | SCWD | METAL | PRIVACY LOCK SET, 1½ PAIR S.S. BUTT HINGES | CT GLASS-SEE DOOR TYPE "B" |
| 209A | NONE | 3'-0" x 7'-0" | SCWD | METAL | PRIVACY LOCK SET, 1½ PAIR S.S. BUTT HINGES | CT GLASS-SEE DOOR TYPE "B" |
| 209B | NONE | 3'-0" x 7'-0" | SCWD | METAL | PRIVACY LOCK SET, 1½ PAIR S.S. BUTT HINGES | CT GLASS-SEE DOOR TYPE "B" |
| 210 | NONE | 3'-0" x 7'-0" | SCWD | METAL | PRIVACY LOCK SET, 1½ PAIR S.S. BUTT HINGES | CT GLASS-SEE DOOR TYPE "B" |
| 211 | NONE | 3'-0" x 7'-0" | SCWD | METAL | PRIVACY LOCK SET, 1½ PAIR S.S. BUTT HINGES | CT GLASS-SEE DOOR TYPE "B" |
| 212 | NONE | 3'-0" x 7'-0" | SCWD | METAL | PRIVACY LOCK SET, 1½ PAIR S.S. BUTT HINGES | CT GLASS-SEE DOOR TYPE "B" |
| 213 | NONE | 3'-0" x 7'-0" | SCWD | METAL | DOOR CLOSER, 1½ PAIR S.S. BUTT HINGES | CT GLASS-SEE DOOR TYPE "C" |
| 214 | NONE | 3'-0" x 7'-0" | SCWD | METAL | PRIVACY LOCK SET, DOOR CLOSER, 1½ PAIR S.S. BUTT HINGES | CT GLASS-SEE DOOR TYPE "B" |
| 215 | NONE | 3'-0" x 7'-0" | SCWD | METAL | PRIVACY LOCK SET, 1½ PAIR S.S. BUTT HINGES | CT GLASS-SEE DOOR TYPE "B" |
| 216 | NONE | 3'-0" x 7'-0" | SCWD | METAL | PRIVACY LOCK SET, 1½ PAIR S.S. BUTT HINGES | SEE DOOR TYPE "D" |
| 217 | NONE | 3'-0" x 7'-0" | SCWD | METAL | PRIVACY LOCK SET, 1½ PAIR S.S. BUTT HINGES | CT GLASS-SEE DOOR TYPE "C" |
| 218A | 60 PSF | 2'-8" x 7'-0" | METAL DOOR WITH POLY CORE | METAL | EXISTING DOOR & HARDWARE TO REMAIN | EXISTING DOOR & HARDWARE TO REMAIN |
| 218B | NONE | 3'-0" x 7'-0" | SCWD | METAL | PRIVACY LOCK SET, 1½ PAIR S.S. BUTT HINGES | CT GLASS-SEE DOOR TYPE "C" |
| 219 | NONE | 6'-0" x 7'-0" | SCWD | METAL | EXISTING DOOR & HARDWARE TO REMAIN | EXISTING DOOR & HARDWARE TO REMAIN |
| 220 | 60 PSF | 2'-8" x 7'-0" | METAL DOOR WITH POLY CORE | METAL | EXISTING DOOR & HARDWARE TO REMAIN | EXISTING DOOR & HARDWARE TO REMAIN |
| 221 | NONE | 2'-8" x 7'-0" | SCWD | METAL | DOOR CLOSER, 1½ PAIR S.S. BUTT HINGES | EXISTING DOOR & HARDWARE TO REMAIN |
| 222 | NONE | 2'-8" x 7'-0" | SCWD | METAL | DOOR CLOSER, 1½ PAIR S.S. BUTT HINGES | EXISTING DOOR & HARDWARE TO REMAIN |

NOTE:
-ALL EXTERIOR GLASS TO BE CLEAR TEMPERED, IMPACT RESISTANT, MEETING WIND REQUIREMENT OF 161 MPH.
-ALL EXTERIOR DOORS SHALL BE AIR TIGHT AND WEATHER TIGHT. (DOORS SHALL PERMIT LESS THAN 0.01 CU.FT./MIN. OF OUTSIDE AIR)

WINDOW SCHEDULE NOTES:

1.

CLEAR TEMPERED

2.

IMPACT RESISTANT: 161 WIND REQUIREMENT MIN.

3.

VINYL FRAME FIXED

4.

U-FACTOR: 0.35

5.

SHGC: 0.27

6.

WINDOW TYPE AA, EE, AND FF ARE REPLACING EXISTING. CONTRACTOR SHALL VERIFY DIMENSIONS PRIOR TO PLACING ORDER.

AA

STOREFRONT KAWNEER IR 501
CLEAR INSULATED-LOW-E #2
HURRICANE RESISTANT
GLAZING. SEE NOTE 6.

BB

STOREFRONT KAWNEER IR 501
CLEAR INSULATED-LOW-E #2
HURRICANE RESISTANT GLAZING

CC

STOREFRONT KAWNEER IR 501
CLEAR INSULATED-LOW-E #2
HURRICANE RESISTANT GLAZING

DD

STOREFRONT KAWNEER IR 501
CLEAR INSULATED-LOW-E #2
HURRICANE RESISTANT
GLAZING. SEE NOTE 6.

A

HOLLOW METAL DOOR WITH
POLYSTYRENE CORE AND IR
TOP WINDOW (6"W x 30"H)

B

SOLID CORE WOOD
DOOR CT TOP WINDOW
(6"W x 30"H)

C

SOLID CORE WOOD
DOOR CT HALF GLASS
WINDOW

D

SOLID CORE
WOOD DOOR

DOOR SCHEDULE NOTES:

GENERAL: PROVIDE WALL BUMPERS FOR ALL DOORS.

1.

SCWD = SOLID CORE WOOD DOOR

1A.

WOOD DOORS TO HAVE HOLLOW METAL FRAME

1B.

WOOD DOORS TO BE ROTARY NATURAL BIRCH, FACTORY PRE-FINISHED, STANDARD COLOR STAINED.

2.

NL = NIGHTLATCH

3.

SS = STAINLESS STEEL

4.

ALL DOORS NOT TYPE A TO BE FLUSH, UNLESS NOTED OTHERWISE.

5.


IR = IMPACT RESISTANT

CT = CLEAR TEMPERED


| | | | | | | | | | | | | | | | | |
|------|------------------------|----------|-----|-------|---|---------|--|--|-------|--------------------------|--|--|--|--|--|--|
| | | | | | <div><div>Cowles, Murphy, Glover</div><div>& ASSOCIATES</div><div>A Full Service Engineering Firm</div></div> <div>PERFORMANCE • RELIABILITY • EXPERIENCE</div> | PROJECT | TERMINAL RAILWAY OFFICE ADDITION/RENOVATION | 126 INDUSTRIAL CANAL ROAD MOBILE, ALABAMA | TITLE | DOOR AND WINDOW SCHEDULE | | | | | | |
| C | REVISED PER ADDENDUM 2 | 08/24/22 | MAD | JDG | | | | | | | | | | | | |
| B | ISSUED FOR BID | 08/01/22 | JWM | GDEC | | | | | | | | | | | | |
| REV. | DESCRIPTION | DATE | BY | CHK'D | | | | | | | | | | | | |
| | | | | | © COWLES, MURPHY, GLOVER & ASSOCIATES, INC., 2022 CONFIDENTIAL, VALUABLE, AND PROPRIETARY INFORMATION | | | | | | | | | | | |
| | | | | | SCALE AS NOTED DRAWN BY JWM DATE 05/31/22 SHEET 22x34 of 22 JOB NO. 4146-22 CHECKED BY JDG DATE 05/31/22 DRAWING NUMBER 4146-S4 | | | | | | | | | | | |

457 St. Michael St., Mobile, AL 36602
13 Thrash Rd., LaGrange, GA 30241
11880 Cranston Dr. Ste 102, Arlington, TN 38002
Alabama (251) 433-1611
Georgia (706) 302-2831 Tennessee (901) 290-5444


Z:\1100-4199\4146-ASPA TRR Office Expansion\Design\4146-S4.dwg, 8/24/2022 4:37:58 PM, DWG To PDF.pc3, 1:1

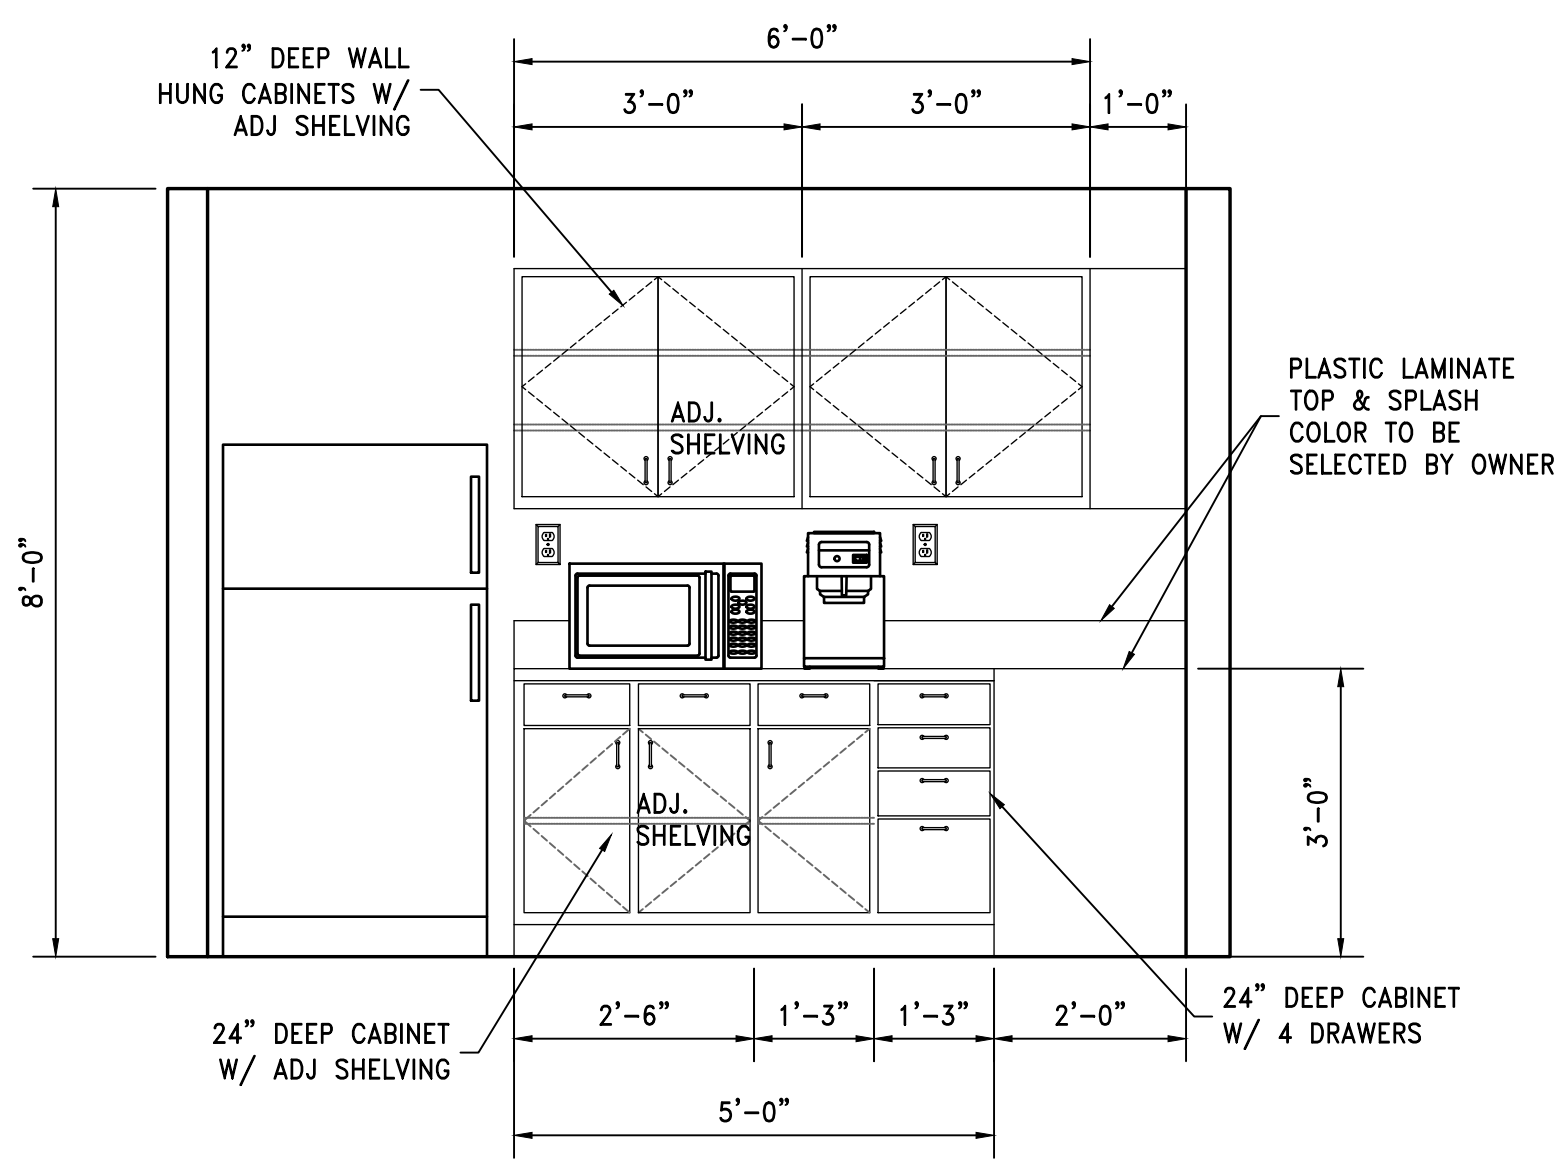

OFFICE BREAKROOM ELEVATION
3/8"=1'-0"

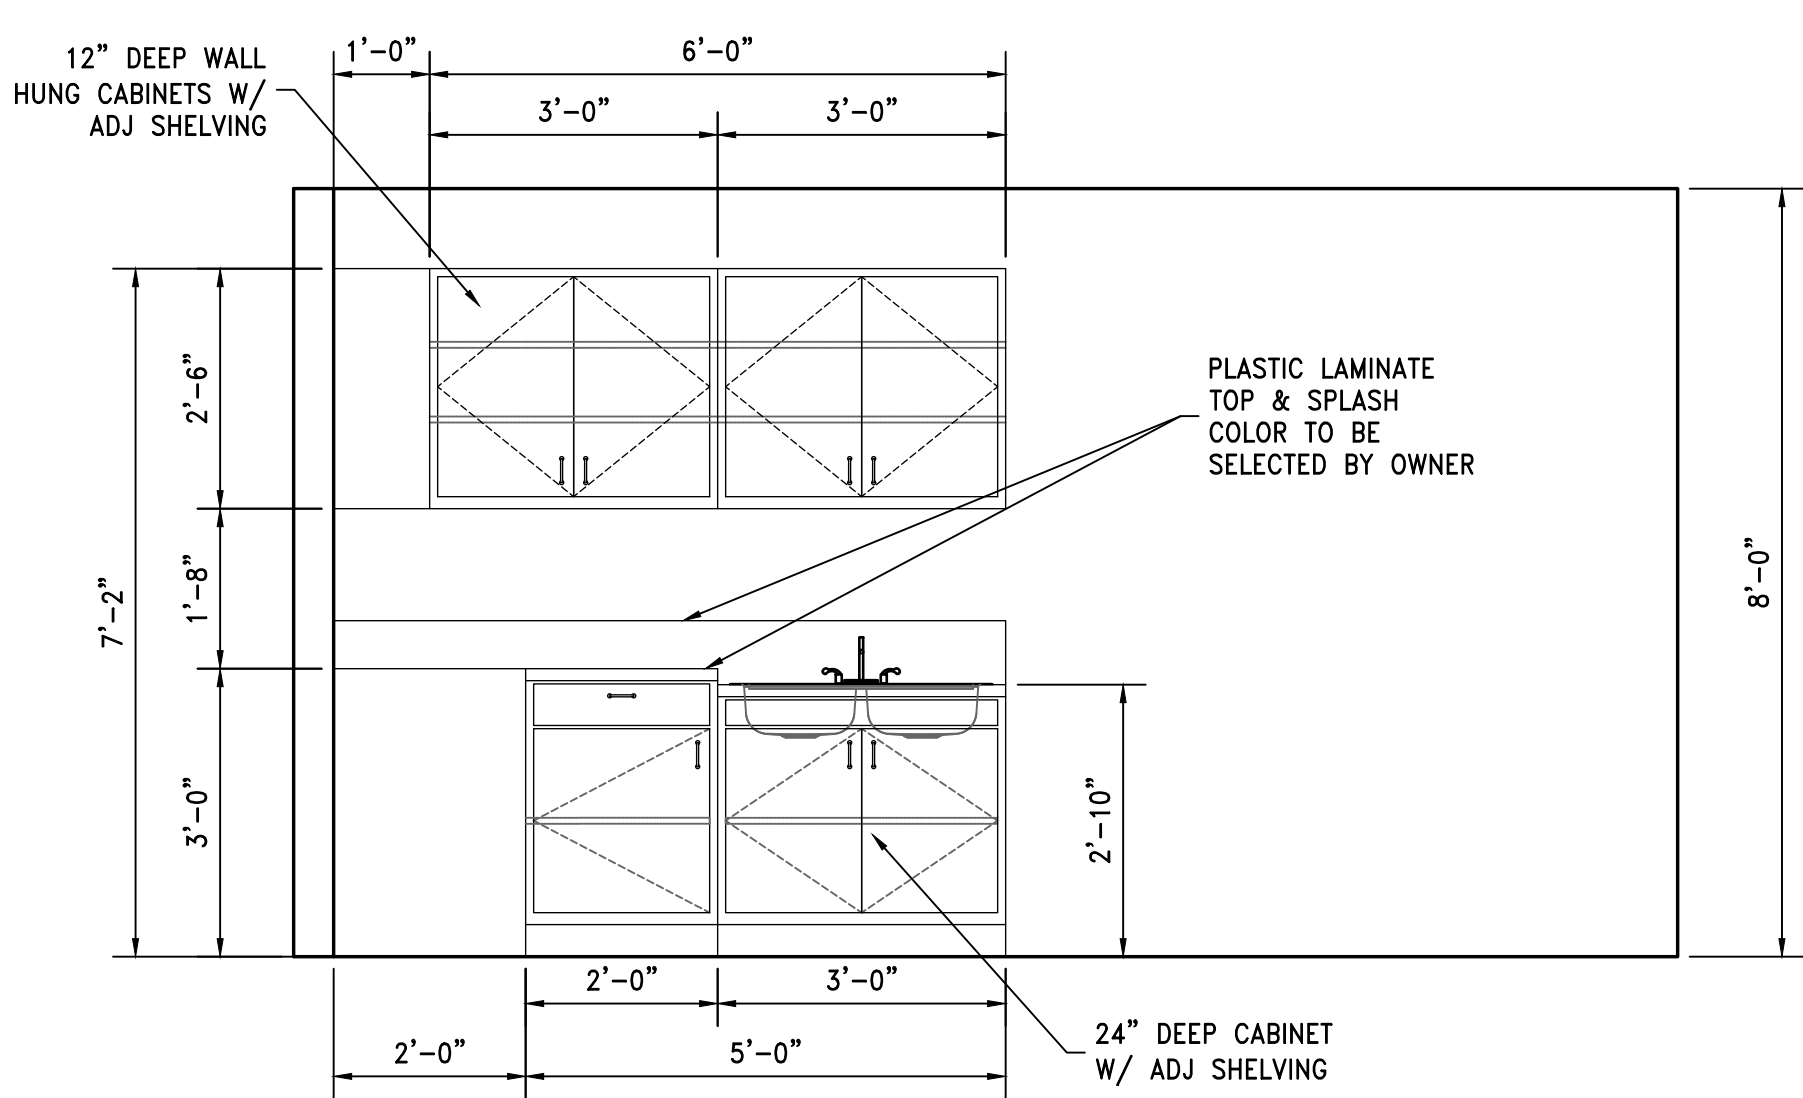

OFFICE BREAKROOM ELEVATION
3/8"=1'-0"

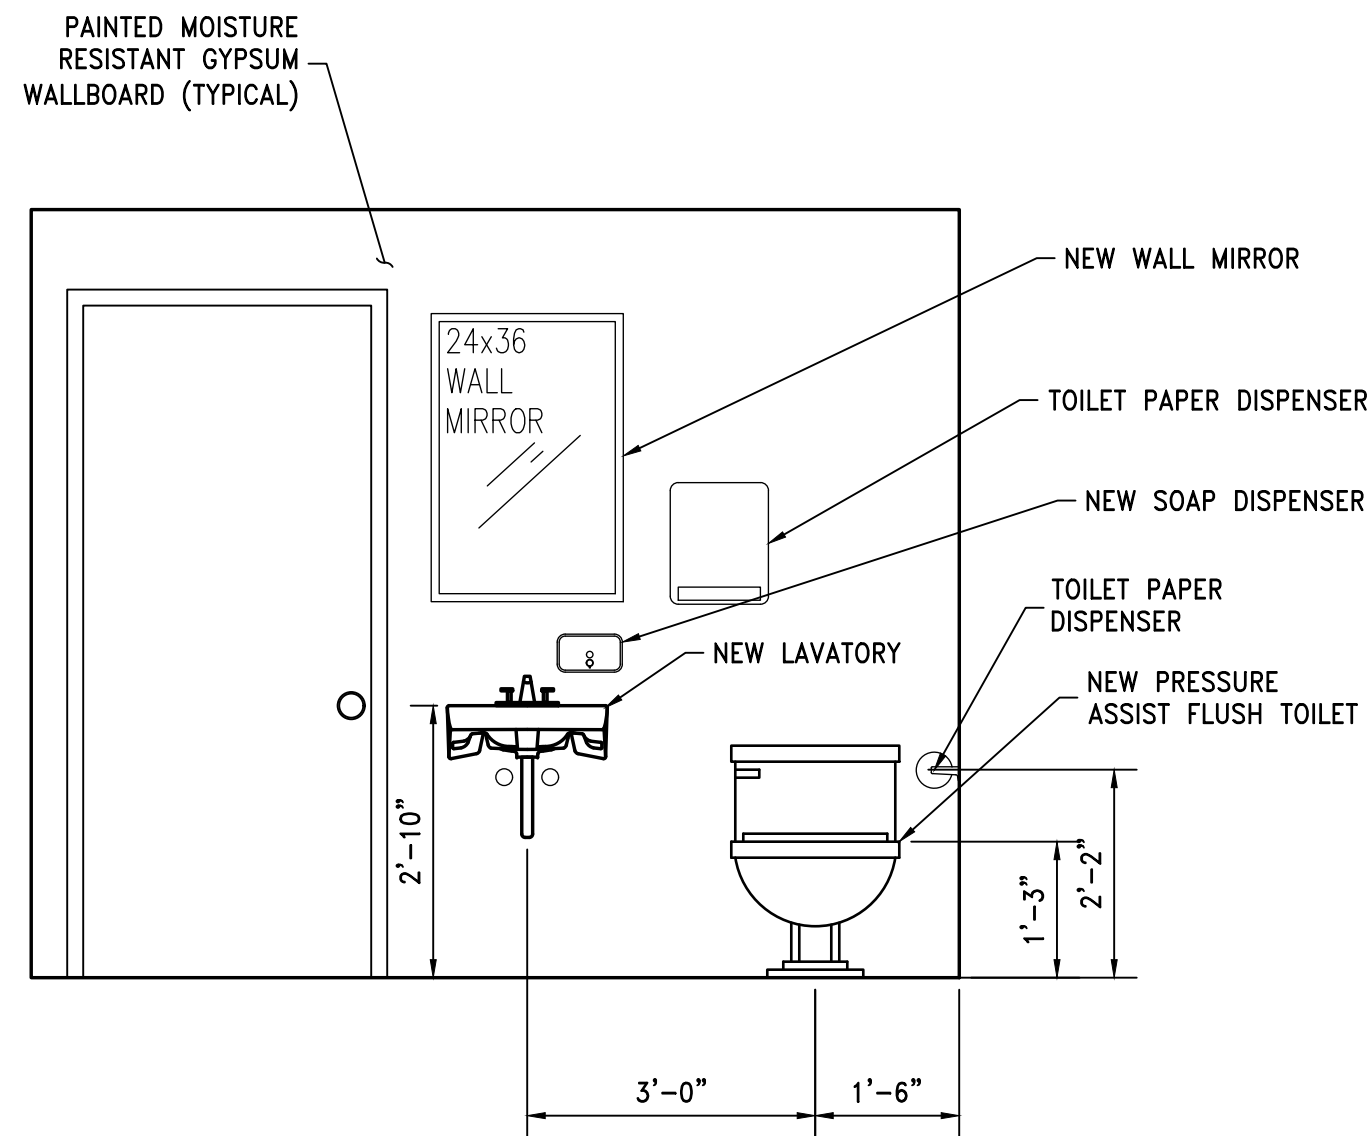

RESTROOM ELEVATION
3/8"=1'-0"

| | | | | |
|------|------------------------|----------|-----|-------|
| | | | | |
| | | | | |
| | | | | |
| C | REVISED PER ADDENDUM 2 | 08/24/22 | MAD | JDG |
| B | ISSUED FOR BID | 08/01/22 | JWM | GDEC |
| REV. | DESCRIPTION | DATE | BY | CHK'D |

**Cowles, Murphy, Glover
& ASSOCIATES**
A Full Service Engineering Firm


PERFORMANCE • RELIABILITY • EXPERIENCE

457 St. Michael St., Mobile, AL 36602
13 Thrash Rd., LaGrange, GA 30241
11880 Cranston Dr. Ste 102, Arlington, TN 38002
Alabama (251) 433-1611
Georgia (706) 302-2831 Tennessee (901) 290-5444

| | |
|---------|--|
| PROJECT | TERMINAL RAILWAY OFFICE ADDITION/RENOVATION |
| | 126 INDUSTRIAL CANAL ROAD MOBILE, ALABAMA |

| | | | | |
|--------------------|---------------------|------------------|-----------------------------------|--|
| TITLE | INTERIOR ELEVATIONS | | | |
| SCALE | AS NOTED | DRAWN BY JWM | DATE 05/31/22 | SHEET — OF — 22x34 REV. C |
| JOB NO. 4146-22 | CHECKED BY JDG | DATE 05/31/22 | DRAWING NUMBER 4146-S4A | |

© COWLES, MURPHY, GLOVER & ASSOCIATES, INC., 2022
CONFIDENTIAL, VALUABLE, AND PROPRIETARY INFORMATION

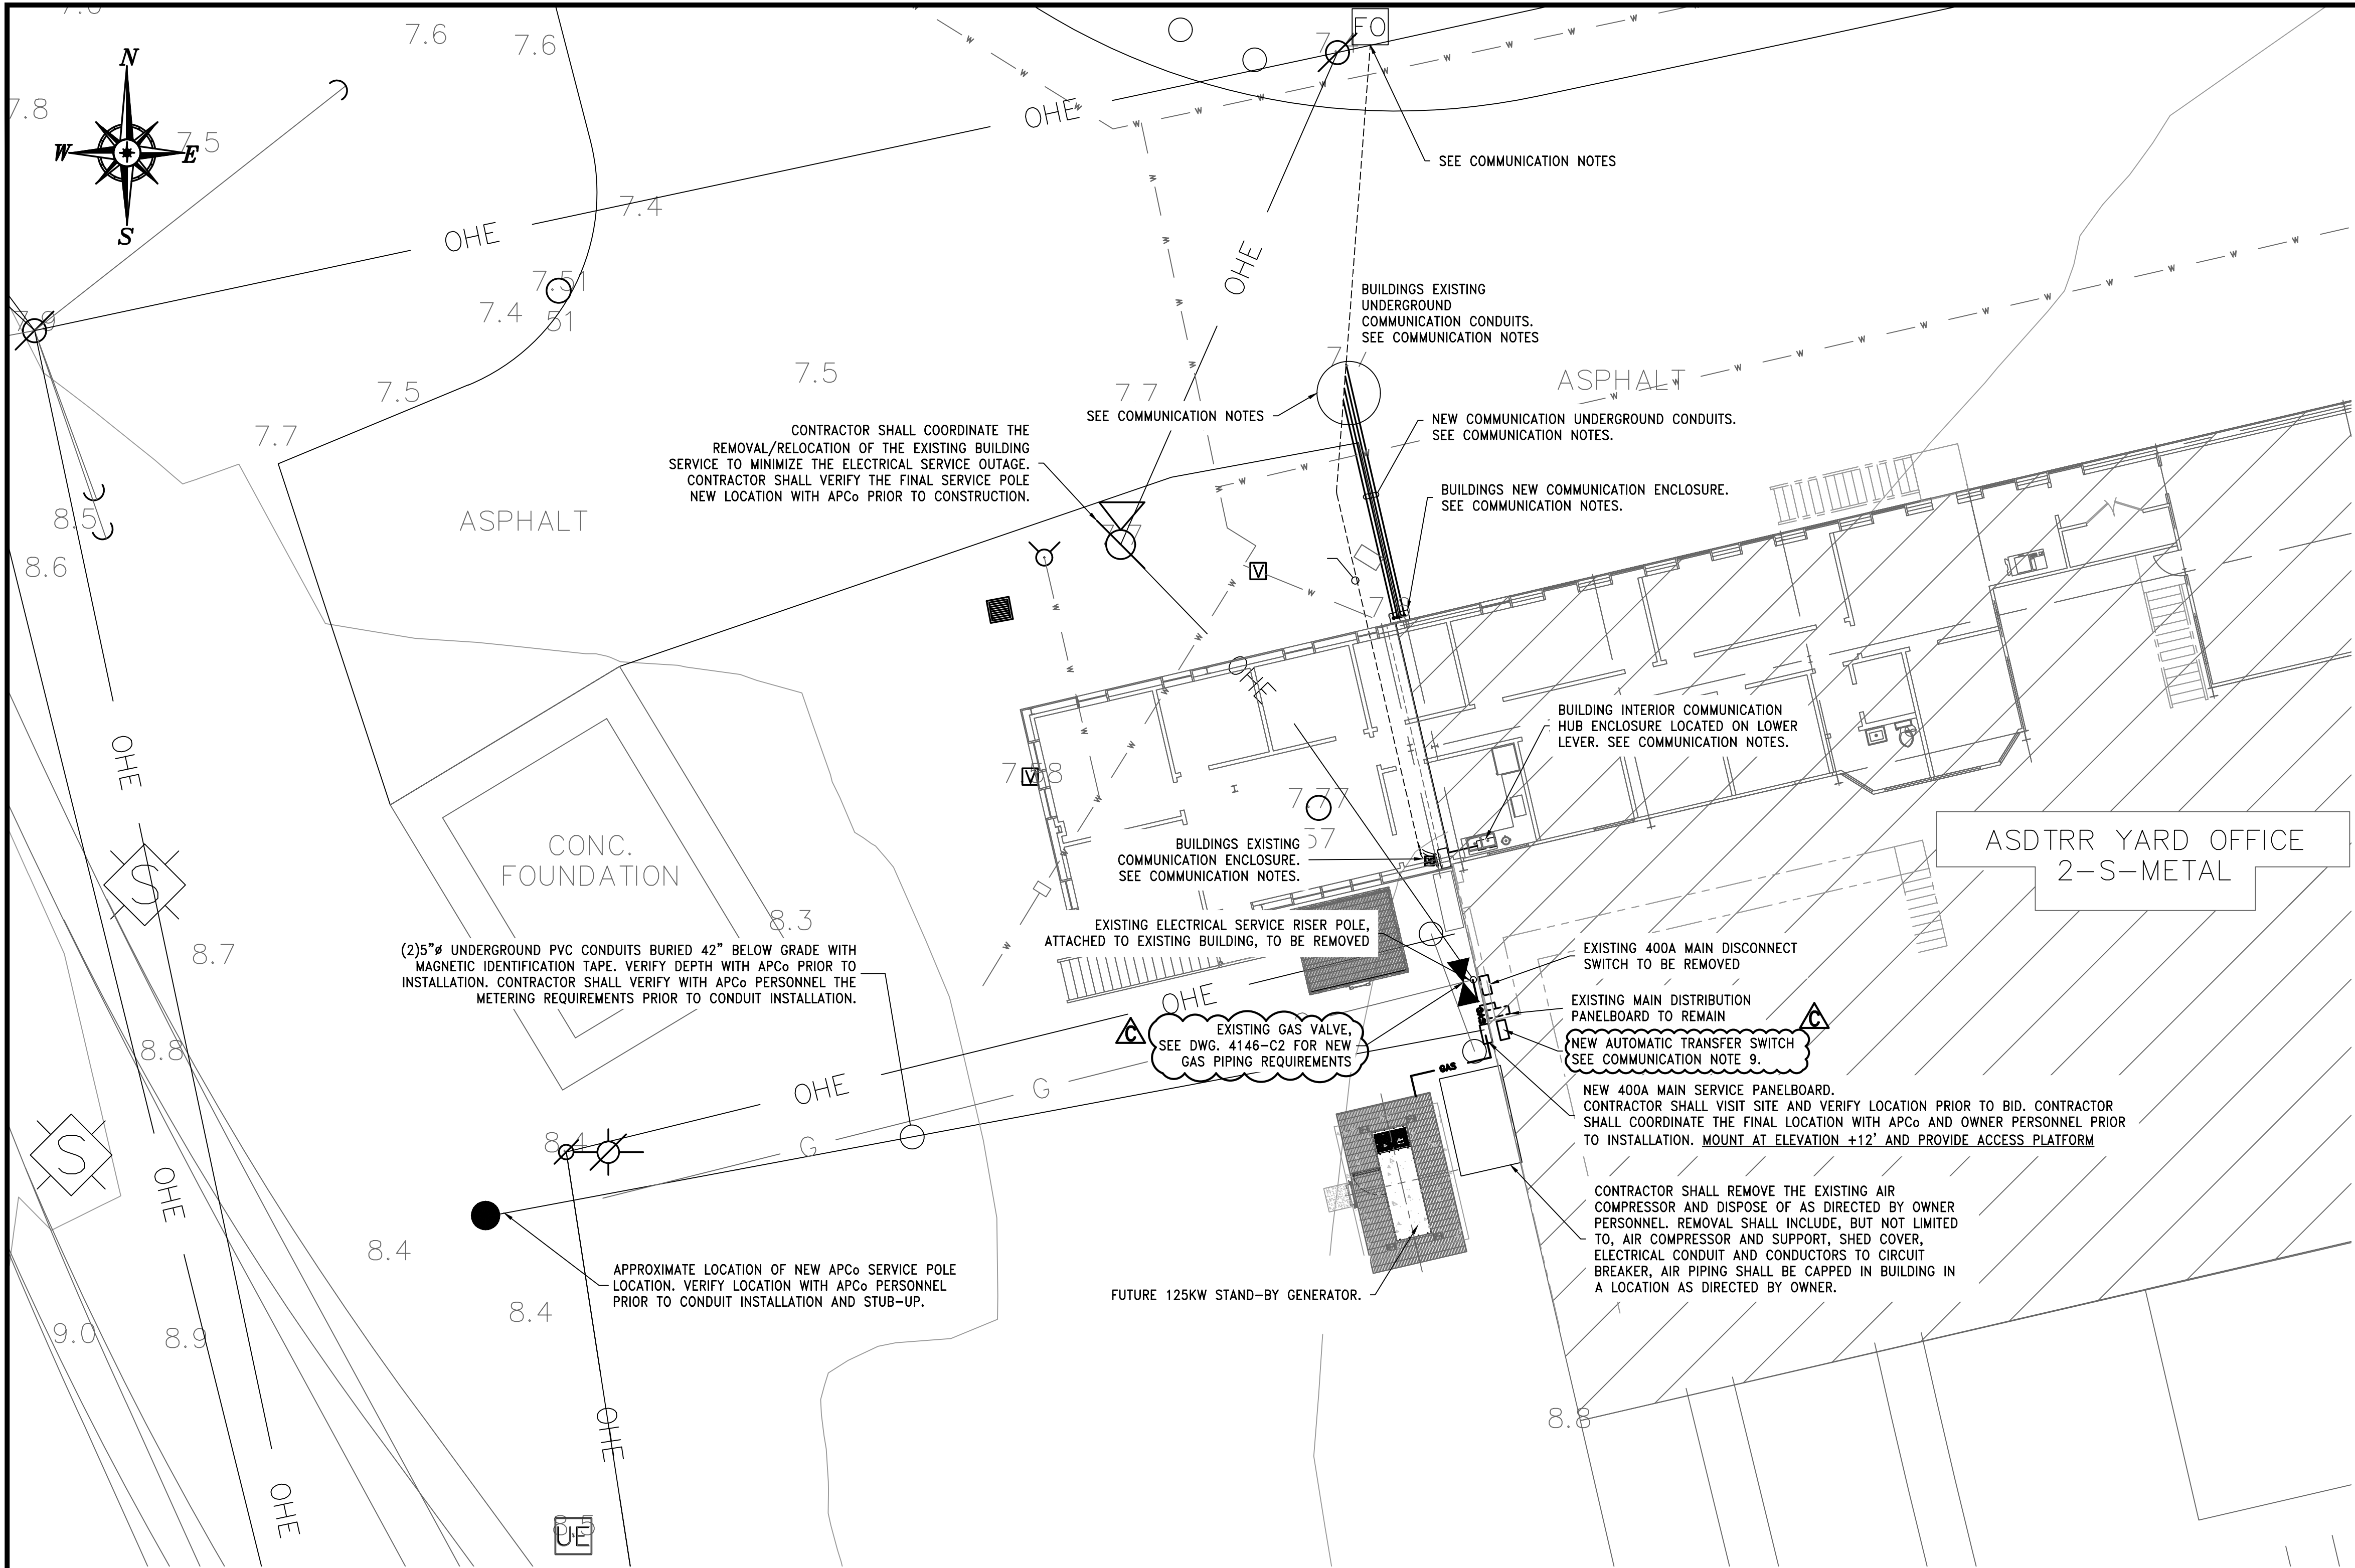

- COMMUNICATION NOTES:**
1. CONTRACTOR SHALL VERIFY WITH TRR IT PERSONNEL THE LOCATION OF THE EXISTING COMMUNICATION ENCLOSURE AND THE ROUTING OF THE CONDUIT THAT SERVE THE BUILDINGS INSIDE COMMUNICATION HUB.
 2. CONTRACTOR SHALL LOCATE THE EXISTING UNDERGROUND COMMUNICATION CONDUITS ROUTED FROM THE COMMUNICATION PROVIDER JUNCTION ENCLOSURE TO THE BUILDINGS EXISTING COMMUNICATION ENCLOSURE LOCATED ON THE EXTERIOR OF THE BUILDING.
 3. CONTRACTOR SHALL FURNISH AND INSTALL BUILDING NEW COMMUNICATION ENCLOSURE, NEMA-3R RATED, IN A LOCATION AS SHOWN ON THE SITE PLAN OR AS DIRECTED BY THE TRR IT PERSONNEL. BUILDINGS NEW COMMUNICATION ENCLOSURE SHALL BE SIMILAR IN SIZE AND RATING AS THE BUILDINGS EXISTING COMMUNICATION ENCLOSURE.
 4. CONTRACTOR SHALL LOCATE AND UNCOVER THE EXISTING COMMUNICATION UNDERGROUND CONDUITS NEAR A LOCATION AS SHOWN ON THE SITE PLAN OR A LOCATION THAT BEST SUITS THE REROUTING OF THE COMMUNICATION CONDUITS. CONTRACTOR SHALL PROVIDE PROTECTION AND BARRIERS FOR THE EXPOSED CONDUITS IN THE OPEN GROUND AREA.
 5. CONTRACTOR SHALL FURNISH AND INSTALL (4) UNDERGROUND COMMUNICATION CONDUITS, SIMILAR IN SIZE AND MATERIAL, FROM THE NEW BUILDING COMMUNICATION ENCLOSURE TO OPEN GROUND AREA NEAR THE EXPOSED EXISTING COMMUNICATION CONDUITS. THE NEW UNDERGROUND CONDUIT SHALL BE USED TO REROUTE THE COMMUNICATION CONDUCTORS/FIBER OPTIC CABLES FROM THE COMMUNICATION PROVIDERS JUNCTION ENCLOSURE TO THE NEW BUILDING COMMUNICATION ENCLOSURE
 6. CONTRACTOR SHALL COORDINATE WITH THE TRR IT PERSONNEL THE BEST AVAILABLE TIME TO REMOVE THE COMMUNICATION CABLES FROM THE BUILDINGS EXISTING COMMUNICATION ENCLOSURE AND UNDERGROUND CONDUITS FOR REROUTING INTO BUILDINGS NEW COMMUNICATION ENCLOSURE.
 7. CONTRACTOR SHALL, AFTER COMMUNICATION CABLE REMOVAL, SPLICE NEW UNDERGROUND COMMUNICATE CONDUITS WITH THE EXISTING UNDERGROUND COMMUNICATION CONDUITS AND VERIFY THE CONDUIT ARE SEALED WHEN CONNECTED.
 8. CONTRACTOR SHALL REINSTALL OR FURNISH NEW COMMUNICATION CABLES FROM THE COMMUNICATION PROVIDER JUNCTION ENCLOSURE TO THE BUILDINGS NEW COMMUNICATION ENCLOSURE. COMMUNICATION CABLES SHALL BE ROUTED FROM THE BUILDING NEW COMMUNICATION ENCLOSURE TO THE INTERIOR COMMUNICATION HUB AND TERMINATED BY TRR IT PERSONNEL. COMMUNICATION CABLE SHALL BE INSTALLED IN CONDUIT THRU THE INTERIOR OF THE BUILDING.
 9. CONTRACTOR SHALL FURNISH AND INSTALL NEW KOHLER #KSS-AMTA-260-S (OR APPROVED EQUAL) AUTOMATIC TRANSFER SWITCH WITH GENERATOR MONITORING SYSTEM FOR FUTURE 125kW STAND-BY GENERATOR INSTALLATION. 125kW STAND-BY GENERATOR SHALL BE A FUTURE ADDITION BY OTHERS. CONTRACTOR SHALL LOCATE THE ATS IN A LOCATION +1' ABOVE THE FEMA FLOOD ELEVATION AE, EL.+11. BOTTOM OF ATS SHALL BE AT ELEVATION +12'. ATS SHALL BE INSTALLED INDOORS AND SURFACE MOUNT. VERIFY LOCATION WITH ASPA PERSONNEL PRIOR TO INSTALLATION.

NEW ELECTRICAL SITE PLAN
1"=10'-0"

| | | | | |
|------|------------------------|----------|-----|-------|
| | | | | |
| | | | | |
| | | | | |
| C | REVISED PER ADDENDUM 2 | 08/24/22 | MAD | JJM |
| B | ISSUED FOR BID | 08/01/22 | RCC | JJM |
| REV. | DESCRIPTION | DATE | BY | CHK'D |

Cowles, Murphy, Glover
& ASSOCIATES

A Full Service Engineering Firm

PERFORMANCE • RELIABILITY • EXPERIENCE

457 St. Michael St., Mobile, AL 36602
13 Thrash Rd., LaGrange, GA 30241
11880 Cranston Dr. Ste 102, Arlington, TN 38002
Alabama (251) 433-1611
Georgia (706) 302-2831 Tennessee (901) 290-5444


PROJECT

TERMINAL RAILWAY
OFFICE ADDITION/RENOVATION

126 INDUSTRIAL CANAL ROAD
MOBILE, ALABAMA

| | | | | |
|-----------------------------------|-------------------|------------------|---------------------------|-----------------|
| TITLE NEW ELECTRICAL SITE PLAN | | | | |
| SCALE AS NOTED | DRAWN BY RCC | DATE 03/30/22 | SHEET — OF — | 22x34 REV. C |
| JOB NO. 4146-22 | CHECKED BY JJM | DATE 07/01/22 | DRAWING NUMBER 4146-E1 | |

© COWLES, MURPHY, GLOVER & ASSOCIATES, INC., 2022
CONFIDENTIAL, VALUABLE, AND PROPRIETARY INFORMATION

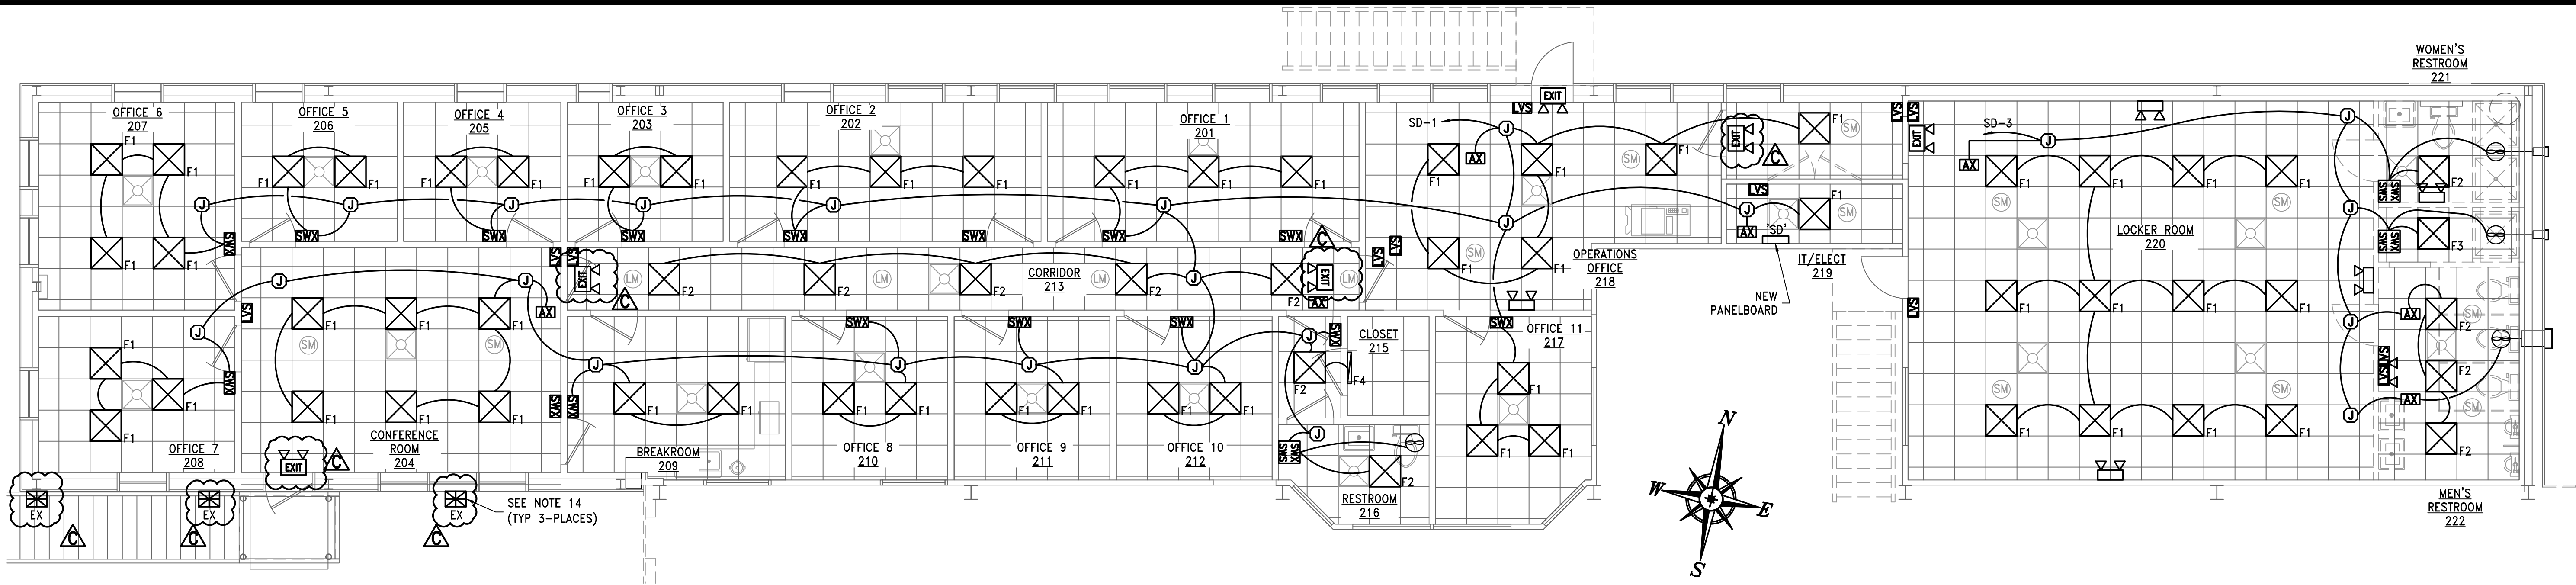

OFFICE ELECTRICAL LIGHTING PLAN
SCALE: 3/16"=1'-0"

| ELECTRICAL SYMBOL LEGEND | |
|--------------------------|--|
| SYMBOL | DESCRIPTION |
| | METALUX #22PD-40-PB1-L840-U, 2x2 LED RECESSED, BEVEL SHIELDING, 0-10V DIMMING, 33W (4,000 LUMENS) OR ENGINEER APPROVED EQUAL. |
| | METALUX #22PD-30-PB1-L840-U, 2x2 LED RECESSED, BEVEL SHIELDING, 0-10V DIMMING 25W (3,000 LUMENS) OR ENGINEER APPROVED EQUAL. |
| | METALUX #22PD-50-PB1-L840-U, 2x2 LED RECESSED, BEVEL SHIELDING, 0-10V DIMMING 42W (5,000 LUMENS) OR ENGINEER APPROVED EQUAL. |
| | METALUX #2SNLED-LD5-30HL-LW-UNV-L840-CD1-U ENGINEER, LED SURFACE FIXTURE, FULL FROST LENS-WIDE SPREAD, 4000K, 28W (2,975 LUMENS) OR APPROVED EQUAL. |
| | JUNCTION BOX WITH COVER |
| | EXIT LED FIXTURE EXITRONIX #VLED-U-WH-EL90-G2. BATTERY BACKUP EXIT LIGHT WITH EMERGENCY LED LAMPS, MOUNT 12" BELOW CEILING OR ENGINEER APPROVED EQUAL. |
| | EXITRONIX #LED-52-WH-G2, LED BATTERY BACK-UP, 2 WATT LAMPS, SELF-TEST/SELD-DIAGNOSTUCS, MOUNT 9" A.F.F. OR ENGINEER APPROVED EQUAL |
| | SENSORWORX #SWX-221-1, CEILING MOUNT OCCUPANCY SENSOR, LOW VOLTAGE, PASSIVE DUAL TECHNOLOGY (PIR/ACOUSTIC), SMALL MOTION 360°. |
| | SENSORWORX #SWX-222-1, CEILING MOUNT OCCUPANCY SENSOR, LOW VOLTAGE, PASSIVE DUAL TECHNOLOGY (PIR/ACOUSTIC), LARGE MOTION 360°. |
| | SENSORWORX #SWX-801-WH, DECORATOR LOW VOLTAGE WALL SWITCH, MOMENTARY OPERATION, WHITE. |
| | SENSORWORX #SWX-803-WH, DECORATOR LOW VOLTAGE DIMMER (0-10V) WALL SWITCH, MOMENTARY OPERATION, WHITE. |
| | SENSORWORX #SWX-900-AX, POWER PACK CONTROLLER, LINE VOLTAGE, 120/277V, SINGLE RELAY +150mA SUPPLY |
| | SENSORWORX #SWX-121-WH, OCCUPANCY SENSOR, LINE VOLTAGE, WALL SWITCH, PASSIVE DUAL TECHNOLOGY (PIR/ACOUSTIC), 1-POLE:AUTO ON (OCCUPANCY), WHITE |
| | SENSORWORX #SWX-121-D-WH, 0-10V DIMMING OCCUPANCY SENSOR, LINE VOLTAGE, WALL SWITCH, PASSIVE DUAL TECHNOLOGY (PIR/ACOUSTIC), 1-POLE:AUTO ON (OCCUPANCY), WHITE |
| | SENSORWORX #SWX-122-WH, OCCUPANCY SENSOR, LINE VOLTAGE, WALL SWITCH, PASSIVE DUAL TECHNOLOGY (PIR/ACOUSTIC), 2-POLE: PARTIAL ON, W/#SWX-831-SC, SEDECAR SWITCH, WHITE, 2-GANG |
| | NEMA-1/3R DISTRIBUTION PANEL, SEE SCHEDULE |
| | BATHROOM EXHAUST FAN TO BE SWITCHED FROM WALL MOUNTED SWITCH. |
| | McGRAW-Edison #GWC-SA2C-740-U-SL3-GM-CBP-CC-AHD245-BPC120, LED WALL MOUNT AREA FIXTURE, SL3 W/SPILL CONTROL OPTICS, BATTERY PACK, COASTAL CONSTRUCTION FINISH, AFTER HOURS DIM, BUTON TYPE PHOTOCONTROL 120V, OR ENGINEER, 60W (7,555 LUMENS) OR APPROVED EQUAL. |

- ELECTRICAL GENERAL NOTES:**
- ALL ELECTRICAL WORK SHALL BE INSTALLED AS REQUIRED BY THE NATIONAL ELECTRIC CODE (N.E.C.) AND ANY STATE, CITY AND/OR LOCAL CODE REQUIREMENTS. THE MORE STRINGENT CODE REQUIREMENT SHALL BE UTILIZED AND VERIFIED WITH THE LOCAL INSPECTION APPROVAL AGENCY. (DEFINITION "CODE" - STATE, CITY AND/OR LOCAL CODE REQUIREMENTS)
 - CONTRACTOR SHALL INSTALL ALL GROUNDING AS REQUIRED BY THE NATIONAL ELECTRIC CODE (N.E.C.) AND ANY STATE, CITY AND/OR LOCAL CODE REQUIREMENTS. THE MORE STRINGENT CODE REQUIREMENT SHALL BE UTILIZED AND VERIFIED WITH THE LOCAL INSPECTION APPROVAL AGENCY.
 - CONTRACTOR SHALL (PRIOR TO BID)
(a) VISIT THE JOB/CONSTRUCTION SITE AND FIELD VERIFY ALL EXISTING CONDITIONS
(b) TAKE ALL CONSIDERATIONS INTO ACCOUNT AT THE TIME OF BID. NO CONSIDERATIONS WILL BE GRANTED TO THE CONTRACTOR AFTER THE BID HAS BEEN ACCEPTED.
 - ALL LIGHT FIXTURES SHOWN/LISTED IN LIGHTING FIXTURE SCHEDULE SHALL BE 10-DAY PRE-APPROVED BY THE ENGINEER PRIOR TO BID.**
 - ALL ELECTRICAL SWITCHES SHALL BE INSTALLED AS PER N.E.C. ARTICLE 404 AND AS REQUIRED BY CODE. LIGHT SWITCHES AND COVERS SHALL BE WHITE UNLESS NOTED OTHERWISE BY THE ARCHITECT.
 - ALL RECEPTACLES AND COVERS SHALL BE INSTALLED AS PER N.E.C. ARTICLE 406 AND AS REQUIRED BY CODE. LIGHT SWITCHES AND COVERS SHALL BE WHITE UNLESS NOTED OTHERWISE BY THE ARCHITECT.
 - ALL ELECTRICAL METALLIC TUBING (EMT), RIGID NON-METALLIC CONDUIT, FLEXIBLE METALLIC CONDUIT, FLEXIBLE NON-METALLIC CONDUIT, "SEALTIGHT" TYPE CONDUITS AND ALL OTHER CONDUITS THAT DO NOT CONTAIN A REQUIRED CODE SIZED GROUND WIRE SHALL HAVE A REQUIRED CODE SIZED BOND WIRE INSTALLED WITH THE CIRCUIT CONDUCTORS.
 - RECEPTACLES INSTALLED WITHIN 6'-0" OF SINKS OR WATER SHALL BE CONNECTED TO A GROUND FAULT CIRCUIT INTERRUPTER TYPE CIRCUIT BREAKER OR TO A GROUND FAULT CIRCUIT INTERRUPTER TYPE RECEPTACLE.
 - CONTRACTOR SHALL FURNISH AND INSTALL WEATHER PROOF G.F.C.I. RECEPTACLE AT AN ACCESSIBLE LOCATION NEAR ALL HVAC EQUIPMENT IN ACCORDANCE WITH N.E.C. ARTICLE 210.63 AND AS REQUIRED BY CODE. CONTRACTOR IS RESPONSIBLE FOR THE COORDINATION OF THESE RECEPTACLES IN THE FIELD REGARDLESS OF THE PLAN LAYOUT.
 - CONTRACTOR SHALL, PRIOR TO BID AND ROUGH-IN, FIELD VERIFY ALL HVAC ELECTRICAL REQUIREMENTS AGAINST THE PLAN REQUIREMENTS. FAILURE TO VERIFY AND NOTIFY ENGINEER/ARCHITECT PRIOR TO ROUGH-IN SHALL INDICATE THAT THE CONTRACTOR ASSUMES ALL RESPONSIBILITY FOR THE DESIGN AND INSTALLATION REQUIREMENTS.
 - CONTRACTOR SHALL FURNISH AND INSTALL ALL AC UNITS SHALL HAVE INTEGRAL CONTROLLERS WITH OVERLOAD PROTECTION AND DISCONNECT FUNCTIONS PER N.E.C. CONTRACTOR SHALL INSTALL GFI DUPLEX SERVICE RECEPTACLES NEAR CONDENSER UNIT. PROVIDE MOTOR STARTERS WITH OVERLOAD PROTECTION AND DISCONNECT FUNCTIONS FOR AIR HANDLERS, IF NOT PROVIDED BY MECHANICAL CONTRACTOR.
 - CONTRACTOR SHALL FURNISH AND INSTALL NON-FUSED DISCONNECT SWITCHES AT EACH WATER HEATER. DISCONNECT SWITCH SHALL BE RATED AS REQUIRED BY THE EQUIPMENT SERVED.
 - SEE REFERENCE DRAWING 4146-E3 FOR OFFICE LIGHTING CONTROL PLAN.
 - CONTRACTOR SHALL ROUTE 1/2" CONDUIT W/(2)#12AWG & (1)#12AWG GRD FROM THE EMERGENCY LIGHTING ELECTRICAL TO EACH EXTERIOR EGRESS LIGHT FIXTURE 'EX'. EXTERIOR LIGHT FIXTURES 'EX' SHALL BE CONNECT TO CONSTANT POWER FROM THE LIGHTING CIRCUIT SERVING ROOM 204.
 - CONTRACTOR SHALL CONNECT EXIT AND EMERGENCY LIGHT FIXTURES TO THE CONSTANT POWER OF THE LIGHTING CIRCUIT SERVING EACH LOCAL AREA.

| | | | | |
|------|--------------------------------|----------|-----|-------|
| | | | | |
| | | | | |
| | | | | |
| C | ADDENDUM 2 ADD EGRESS LIGHTING | 08/25/22 | RCC | JJM |
| B | ISSUED FOR BID | 08/01/22 | RCC | JJM |
| REV. | DESCRIPTION | DATE | BY | CHK'D |

Cowles, Murphy, Glover

& ASSOCIATES

A Full Service Engineering Firm

PERFORMANCE • RELIABILITY • EXPERIENCE

457 St. Michael St., Mobile, AL 36602

13 Thrash Rd., LaGrange, GA 30241

11880 Cranston Dr. Ste 102, Arlington, TN 38002

Alabama (251) 433-1611

Georgia (706) 302-2831

Tennessee (901) 290-5444




PROJECT

TERMINAL RAILWAY
OFFICE ADDITION/RENOVATION

126 INDUSTRIAL CANAL ROAD
MOBILE, ALABAMA

| TITLE | | | | |
|---------------------------------|------------|----------|----------------|------------|
| OFFICE ELECTRICAL LIGHTING PLAN | | | | |
| SCALE | DRAWN BY | DATE | SHEET | 22x34 REV. |
| AS NOTED | JDG | 03/30/22 | — OF — | C |
| JOB NO. | CHECKED BY | DATE | DRAWING NUMBER | |
| 4146-22 | JJM | 07/01/22 | 4146-E2 | |

© COWLES, MURPHY, GLOVER & ASSOCIATES, INC. 2022
CONFIDENTIAL, VALUABLE, AND PROPRIETARY INFORMATION

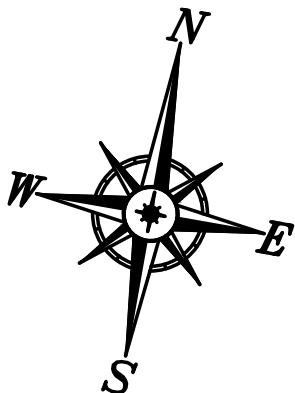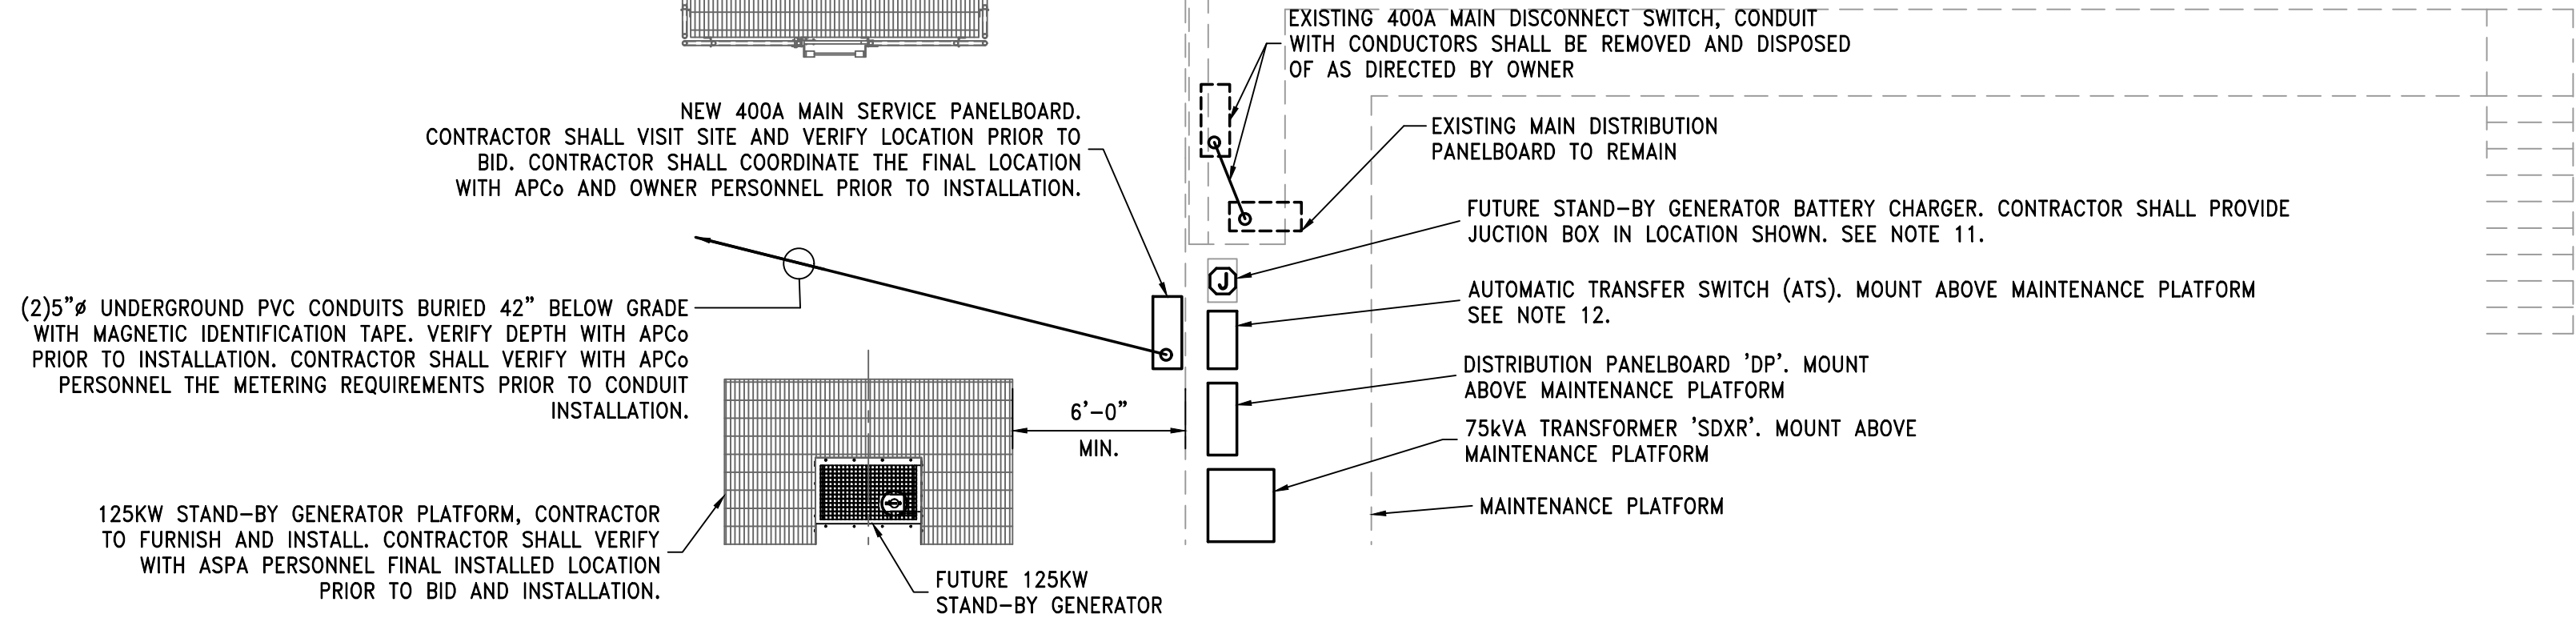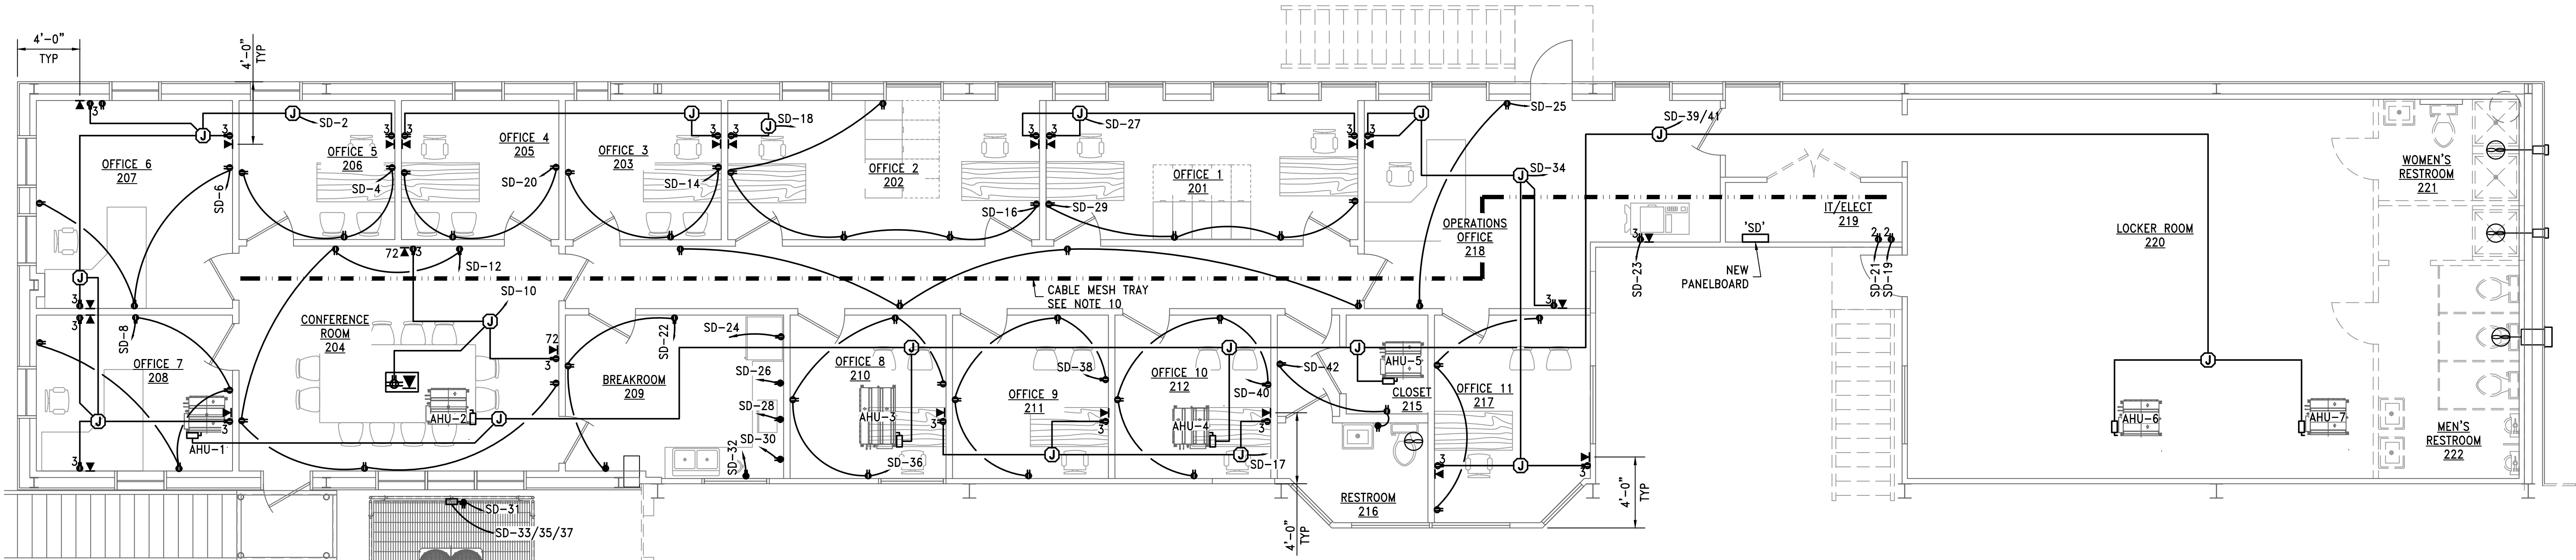

OFFICE ELECTRICAL POWER PLAN
SCALE: 3/8"=1'-0"

| ELECTRICAL SCHEDULE | |
|---------------------|--|
| SYMBOL | DESCRIPTION |
| | DATA JACK DUPLEX J-BOX WITH CONDUIT TO OVERHEAD CEILING. (2) CAT6 DATA CABLES ROUTED TO IT ROOM. TERMINATIONS BY OTHERS. |
| | DUPLEX RECEPTACLE. 110 VOLT GROUNDING TYPE, FLUSH WALL MTD. 18" A.F.F. UNLESS NOTED OTHERWISE. |
| | (2) DUPLEX RECEPTACLE. 110 VOLT GROUNDING TYPE, FLUSH WALL MTD. 18" A.F.F. UNLESS NOTED OTHERWISE. |
| | (3) DUPLEX RECEPTACLE. 110 VOLT GROUNDING TYPE, FLUSH WALL MTD. 18" A.F.F. UNLESS NOTED OTHERWISE. |
| | GROUND FAULT DUPLEX RECEPTACLE. FLUSH WALL MTD. 42" A.F.F. UNLESS NOTED OTHERWISE. WT IS FOR WEATHER TIGHT ENCLOSURE WHERE APPLICABLE |
| | (2)DUPLEX RECEPTACLE AND (1)DUPLEX DATA CONNECTION IN FLUSH MOUNTED FLOOR BOX. CONNECT RECEPTABLES TO GROUND FAULT CIRCUIT BREAKER. (2) CAT6 CABLE TO DATA POINT |
| | NON-FUSED DISCONNECT SWITCH, NEMA-3R, SIZED AS REQUIRED |
| | NEMA-12 OR NEMA-1 DISTRIBUTION PANEL, SEE SCHEDULE |
| | JUNCTION BOX WITH COVER |

ELECTRICAL NOTES:

- ALL ELECTRICAL WORK SHALL BE INSTALLED AS REQUIRED BY THE NATIONAL ELECTRIC CODE (N.E.C.) AND ANY STATE, CITY AND/OR LOCAL CODE REQUIREMENTS. THE MORE STRINGENT CODE REQUIREMENT SHALL BE UTILIZED AND VERIFIED WITH THE LOCAL INSPECTION APPROVAL AGENCY. (DEFINITION "CODE" - STATE, CITY AND/OR LOCAL CODE REQUIREMENTS)
- CONTRACTOR SHALL INSTALL ALL GROUNDING AS REQUIRED BY THE NATIONAL ELECTRIC CODE (N.E.C.) AND ANY STATE, CITY AND/OR LOCAL CODE REQUIREMENTS. THE MORE STRINGENT CODE REQUIREMENT SHALL BE UTILIZED AND VERIFIED WITH THE LOCAL INSPECTION APPROVAL AGENCY.
- ALL RECEPTABLES AND COVERS SHALL BE INSTALLED AS PER N.E.C. ARTICLE 406 AND AS REQUIRED BY CODE. LIGHT SWITCHES AND COVERS SHALL BE WHITE UNLESS NOTED OTHERWISE BY THE ARCHITECT.
- ALL ELECTRICAL METALLIC TUBING (EMT), RIGID NON-METALLIC CONDUIT, FLEXIBLE METALLIC CONDUIT, FLEXIBLE NON-METALLIC CONDUIT, "SEALTIGHT" TYPE CONDUITS AND ALL OTHER CONDUITS THAT DO NOT CONTAIN A REQUIRED CODE SIZED GROUND WIRE SHALL HAVE A REQUIRED CODE SIZED BOND WIRE INSTALLED WITH THE CIRCUIT CONDUCTORS.
- RECEPTABLES INSTALLED WITHIN 6'-0" OF SINKS OR WATER SHALL BE CONNECTED TO A GROUND FAULT CIRCUIT INTERRUPTER TYPE CIRCUIT BREAKER OR TO A GROUND FAULT CIRCUIT INTERRUPTER TYPE RECEPTACLE.
- CONTRACTOR SHALL FURNISH AND INSTALL WEATHER PROOF G.F.C.I. RECEPTACLE AT AN ACCESSIBLE LOCATION NEAR ALL HVAC EQUIPMENT IN ACCORDANCE WITH N.E.C. ARTICLE 210.63 AND AS REQUIRED BY CODE. CONTRACTOR IS RESPONSIBLE FOR THE COORDINATION OF THESE RECEPTABLES IN THE FIELD REGARDLESS OF THE PLAN LAYOUT.
- CONTRACTOR SHALL, PRIOR TO BID AND ROUGH-IN, FIELD VERIFY ALL HVAC ELECTRICAL REQUIREMENTS AGAINST THE PLAN REQUIREMENTS. FAILURE TO VERIFY AND NOTIFY ENGINEER/ARCHITECT PRIOR TO ROUGH-IN SHALL INDICATE THAT THE CONTRACTOR ASSUMES ALL RESPONSIBILITY FOR THE DESIGN AND INSTALLATION REQUIREMENTS.
- CONTRACTOR SHALL FURNISH AND INSTALL ALL AC UNITS SHALL HAVE INTEGRAL CONTROLLERS WITH OVERLOAD PROTECTION AND DISCONNECT FUNCTIONS PER N.E.C. CONTRACTOR SHALL INSTALL GFI DUPLEX SERVICE RECEPTABLES NEAR CONDENSER UNIT. PROVIDE MOTOR STARTERS WITH OVERLOAD PROTECTION AND DISCONNECT FUNCTIONS FOR AIR HANDLERS, IF NOT PROVIDED BY MECHANICAL CONTRACTOR.
- CONTRACTOR SHALL FURNISH AND INSTALL NEW IT SERVER RACK IN IT/ELECT ROOM 219 AS DIRECTED BY THE OWNER. CONTRACTOR SHALL VERIFY THE REQUIREMENTS OF THE IT SERVER RACK WITH OWNER PERSONNEL PRIOR TO BID.
- CONTRACTOR SHALL FURNISH AND INSTALL CABLE MESH TRAY SYSTEM IN OFFICE AREA FOR DATA CABLE ROUTING AND SUPPORT TO IT ROOM. CABLE MESH TRAY SHALL BE CABLOFIL, BY LEGRAND, #CF150-30 OR APPROVED EQUAL. CONTRACTOR SHALL FURNISH AND INSTALL THE REQUIRED SUPPORTS, GROUND STRAPS, FITTINGS AND CABLE MESH TRAY. CABLE MESH TRAY SHALL BE INSTALLED OVER THE CEILING AND LOCATED FOR EASY ACCESS. LOCATE CABLE MESH TRAY AS DIRECTED BY IT PERSONNEL.
- BATTERY CHARGER NOT IN THIS CONTRACT. BATTERY CHARGER CONDUIT AND CONDUCTORS SHALL BE INSTALLED AND TERMINATED IN A JUNCTION BOX LOCATED AS SHOWN ON PLANS.
- CONTRACTOR SHALL FURNISH AND INSTALL NEW KOHLER #KSS-AMTA-260-S (OR APPROVED EQUAL) AUTOMATIC TRANSFER SWITCH WITH GENERATOR MONITORING SYSTEM FOR FUTURE 125kW STAND-BY GENERATOR INSTALLATION. 125kW STAND-BY GENERATOR SHALL BE A FUTURE ADDITION BY OTHERS. CONTRACTOR SHALL LOCATE THE ATS IN A LOCATION +1' ABOVE THE FEMA FLOOD ELEVATION AE, EL.+11. BOTTOM OF ATS SHALL BE AT ELEVATION +12'. ATS SHALL BE INSTALLED INDOORS AND SURFACE MOUNT. VERIFY LOCATION WITH ASPA PERSONNEL PRIOR TO INSTALLATION.

| | | | | |
|------|------------------------|----------|-----|-------|
| | | | | |
| | | | | |
| | | | | |
| C | REVISED PER ADDENDUM 2 | 08/24/22 | MAD | JJM |
| B | ISSUED FOR BID | 08/01/22 | RCC | JJM |
| REV. | DESCRIPTION | DATE | BY | CHK'D |

Cowles, Murphy, Glover
& ASSOCIATES
A Full Service Engineering Firm

PERFORMANCE • RELIABILITY • EXPERIENCE

457 St. Michael St., Mobile, AL 36602
13 Thrash Rd., LaGrange, GA 30241
11880 Cranston Dr. Ste 102, Arlington, TN 38002
Alabama (251) 433-1611
Georgia (706) 302-2831 Tennessee (901) 290-5444

PROJECT

TERMINAL RAILWAY
OFFICE ADDITION/RENOVATION
126 INDUSTRIAL CANAL ROAD
MOBILE, ALABAMA

TITLE

OFFICE ELECTRICAL POWER PLAN

| | | | | | |
|----------|------------|----------|----------------|-------|------|
| SCALE | DRAWN BY | DATE | SHEET | 22x34 | REV. |
| AS NOTED | RCC | 03/30/22 | — OF — | | C |
| JOB NO. | CHECKED BY | DATE | DRAWING NUMBER | | |
| 4146-22 | JJM | 06/10/22 | 4146-E4 | | |

© COWLES, MURPHY, GLOVER & ASSOCIATES, INC., 2022
CONFIDENTIAL, VALUABLE, AND PROPRIETARY INFORMATION

| PANELBOARD SCHEDULE (277/480V 3Ø, 4W) | | | | | | | | | | | | | | | | | | | | | | | |
|---|--------------------------|-----------|------|-------------|-------------|------|-------------|-------|-------|-------------|---|---|-------------------|-----|------|-----------|------|------------------|-------|--|-------|-------|----|
| MARK: SERVICE PANEL "MDP" | | | | | | | | | | | | | | | | | | | | | | | |
| CKT # | LOAD DESCRIPTION | BREAKER P | TRIP | FEEDER FEED | CONDUIT GRD | SIZE | PHASE (kVA) | | | PHASE (kVA) | | | FEEDER/CONDUIT | | | BREAKER P | TRIP | LOAD DESCRIPTION | CKT # | | | | |
| | | | | | | | A | B | C | A | B | C | FEED | GRD | SIZE | | | | | | | | |
| 1 | EXISTING MAIN PANELBOARD | 3 | 350 | 500 MCM | 2 | 4" | 44.25* | | | - | | | - | - | - | - | | SPACE | 2 | | | | |
| 3 | | | | | | | | | | | | | | | | | | | | | SPACE | 4 | |
| 5 | | | | | | | | | | | | | | | | | | | | | | SPACE | 6 |
| 7 | | | | | | | | | | | | | | | | | | | | | | SPACE | 8 |
| 9 | AUTO-TRANSFER SWITCH | 3 | 225 | 4/0 | 4 | 2½" | 25.0 | | | - | | | - | - | - | - | | SPACE | 10 | | | | |
| 11 | | | | | | | | | | | | | | | | | | | | | SPACE | 12 | |
| 13 | | | | | | | | | | | | | | | | | | | | | | SPACE | 14 |
| 15 | | | | | | | | | | | | | | | | | | | | | | SPACE | 16 |
| 17 | SPACE | - | - | - | - | - | - | - | - | - | - | - | - | - | - | - | | SPACE | 18 | | | | |
| TOTAL (kVA) ØA 69.25 | | | | | | | 69.25 | 69.25 | 69.25 | - | - | - | HIGH PHASE (AMPS) | | | 250.0 | | | | | | | |
| TOTAL CONNECTED LOAD (kVA) | | | | | | | 207.75 | | | | | | TOTAL LOAD (AMPS) | | | 249.9 | | | | | | | |
| * - LOAD BASED ON HIGHEST APCo KWH MONTHLY BILLING FOR 2021 | | | | | | | | | | | | | | | | | | | | | | | |


| PANELBOARD SCHEDULE (277/480V 3Ø, 4W) | | | | | | | | | | | | | | | | | | | |
|---------------------------------------|--|-----------|------|-------------|-------------|------|-------------|-------|-------|-------------|---|---|-------------------|-----|------|-----------|------|------------------|-------|
| MARK: SERVICE PANEL "DP" | | | | | | | | | | | | | | | | | | | |
| CKT # | LOAD DESCRIPTION | BREAKER P | TRIP | FEEDER FEED | CONDUIT GRD | SIZE | PHASE (kVA) | | | PHASE (kVA) | | | FEEDER/CONDUIT | | | BREAKER P | TRIP | LOAD DESCRIPTION | CKT # |
| | | | | | | | A | B | C | A | B | C | FEED | GRD | SIZE | | | | |
| 1 | 75kVA | | | | | | 25.0 | | | - | | | - | - | - | - | | SPACE | 2 |
| 3 | 480V-120/208V SECOND FLOOR TRANSFORMER | 3 | 150 | 2/0 | 4 | 2" | | 25.0 | | - | | | - | - | - | - | | SPACE | 4 |
| 5 | | | | | | | | | 25.0 | | | | - | - | - | - | | SPACE | 6 |
| 7 | SPACE | - | - | - | - | - | - | - | - | - | - | - | - | - | - | - | | SPACE | 8 |
| 9 | SPACE | - | - | - | - | - | - | - | - | - | - | - | - | - | - | - | | SPACE | 10 |
| 11 | SPACE | - | - | - | - | - | - | - | - | - | - | - | - | - | - | - | | SPACE | 12 |
| 13 | SPACE | - | - | - | - | - | - | - | - | - | - | - | - | - | - | - | | SPACE | 14 |
| 15 | SPACE | - | - | - | - | - | - | - | - | - | - | - | - | - | - | - | | SPACE | 16 |
| 17 | SPACE | - | - | - | - | - | - | - | - | - | - | - | - | - | - | - | | SPACE | 18 |
| TOTAL (kVA) #A 25.00 | | | | | | | 69.25 | 69.25 | 69.25 | - | - | - | HIGH PHASE (AMPS) | | | 90.3 | | | |
| TOTAL CONNECTED LOAD (kVA) 75.0 | | | | | | | | | | | | | TOTAL LOAD (AMPS) | | | 90.2 | | | |

| PANELBOARD SCHEDULE (120/208V 3Ø, 4W) | | | | | | | | | | | | | | | | | | | |
|---------------------------------------|---------------------------|-----------|------|-------------|-------------|------|------------|-------|-------|------------|-------|-------|-------------------|-----|------|-----------|------|----------------------------|-------|
| MARK: "SD" | | | | | | | | | | | | | | | | | | | |
| CKT # | LOAD DESCRIPTION | BREAKER P | TRIP | FEEDER FEED | CONDUIT GRD | SIZE | PHASE (VA) | | | PHASE (VA) | | | FEEDER/CONDUIT | | | BREAKER P | TRIP | LOAD DESCRIPTION | CKT # |
| | | | | | | | A | B | C | A | B | C | FEED | GRD | SIZE | | | | |
| 1 | RM 201-219 LIGHTING | 1 | 20 | 10 | 12 | ½" | 1,500 | | | 1,620 | | | 10 | 12 | ½" | 1 | 20 | RM 206-207 DATA RECEPT | 2 |
| 3 | RM 220-222 LIGHTING | 1 | 20 | 10 | 12 | ½" | | 770 | | | 540 | | 10 | 12 | ½" | 1 | 20 | RM 206 RECEPT | 4 |
| 5 | SPARE | 1 | 20 | - | - | - | - | - | - | | | 720 | 10 | 12 | ½" | 1 | 20 | RM 207 RECEPT | 6 |
| 7 | SPARE | 1 | 20 | - | - | - | - | - | - | 720 | | | 10 | 12 | ½" | 1 | 20 | RM 208 RECEPT | 8 |
| 9 | SPACE | - | - | - | - | - | - | - | - | | 1,440 | | 10 | 12 | ½" | 1 | 20 | RM 204 DATA RECEPT | 10 |
| 11 | SPACE | - | - | - | - | - | - | - | - | | | 900 | 10 | 12 | ½" | 1 | 20 | RM 204 RECEPT | 12 |
| 13 | SPACE | - | - | - | - | - | - | - | - | 540 | | | 10 | 12 | ½" | 1 | 20 | RM 203 RECEPT | 14 |
| 15 | SPACE | - | - | - | - | - | - | - | - | | 900 | | 10 | 12 | ½" | 1 | 20 | RM 202 RECEPT | 16 |
| 17 | RM 210-212 DATA RECEPT | 1 | 20 | 10 | 12 | ½" | | | 1,620 | | | 1,620 | 10 | 12 | ½" | 1 | 20 | RM 202/203/205 DATA RECEPT | 18 |
| 19 | IT QUAD RECEPT | 1 | 20 | 10 | 12 | ½" | 720 | | | 540 | | | 10 | 12 | ½" | 1 | 20 | RM 205 RECEPT | 20 |
| 21 | IT QUAD RECEPT | 1 | 20 | 10 | 12 | ½" | | 720 | | | 540 | | 10 | 12 | ½" | 1 | 20 | RM 209 RECEPT | 22 |
| 23 | COPIER RECEPT | 1 | 20 | 10 | 12 | ½" | | | 1,200 | | | 1,200 | 10 | 12 | ½" | 1 | 20 | RM 209 REFRIG RECEPT | 24 |
| 25 | RM 218 RECEPT | 1 | 20 | 10 | 12 | ½" | 360 | | | 180 | | | 10 | 12 | ½" | 1 | 20 | RM 209 CONTER RECEPT | 26 |
| 27 | RM 201/202 DATA RECEPT | 1 | 20 | 10 | 12 | ½" | | 1,620 | | | 1,100 | | 10 | 12 | ½" | 1 | 20 | RM 209 MICROWAVE RECEPT | 28 |
| 29 | RM 201 RECEPT | 1 | 20 | 10 | 12 | ½" | | 720 | | | 180 | | 10 | 12 | ½" | 1 | 20 | RM 209 COUNTER RECEPT | 30 |
| 31 | HP-1 RECEPT | 1 | 20 | 10 | 12 | ½" | 360 | | | 1,200 | | | 10 | 12 | ½" | 1 | 20 | RM 209 COFFEE RECEPT | 32 |
| 33 | | | | | | | | 4,805 | | | 1,620 | | 10 | 12 | ½" | 1 | 20 | RM 201/217/218 DATA RECEPT | 34 |
| 35 | HP-1 | 3 | 50 | 6 | 10 | 1" | | | | | 720 | | 10 | 12 | ½" | 1 | 20 | RM 210 RECEPT | 36 |
| 37 | | | | | | | 4,805 | | 4,805 | | 720 | | 10 | 12 | ½" | 1 | 20 | RM 211 RECEPT | 38 |
| 39 | AHU-1 - AHU-5 | 2 | 20 | 10 | 12 | ½" | | 540 | | | 720 | | 10 | 12 | ½" | 1 | 20 | RM 212 RECEPT | 40 |
| 41 | | | | | | | | | - | | | 540 | 10 | 12 | ½" | 1 | 20 | RM 215-216 RECEPT | 42 |
| 43 | SPACE | - | - | - | - | - | - | - | - | - | - | - | - | - | - | 1 | 20 | SPACE | 44 |
| 45 | SPACE | - | - | - | - | - | - | - | - | - | - | - | - | - | - | 1 | 20 | SPACE | 46 |
| 47 | SPACE | - | - | - | - | - | - | - | - | - | - | - | - | - | - | - | - | SPACE | 48 |
| 49 | SPACE | - | - | - | - | - | - | - | - | - | - | - | - | - | - | - | - | SPACE | 50 |
| 51 | SPACE | - | - | - | - | - | - | - | - | - | - | - | - | - | - | - | - | SPACE | 52 |
| 53 | GENERATOR BATTERY CHARGER | 1 | 20 | 10 | 12 | ½" | | | 840 | | | | - | - | - | - | - | SPACE | 54 |
| TOTAL (kVA) #A 13.265 | | | | | | | 7,745 | 8,455 | 9,185 | 5,520 | 6,860 | 5,880 | HIGH PHASE (AMPS) | | | 127.6 | | | |
| TOTAL CONNECTED LOAD (kVA) 43.64 | | | | | | | | | | | | | TOTAL LOAD (AMPS) | | | 121.2 | | | |

NOTES:
CONTRACTOR SHALL VERIFY WITH THE OWNER THE REQUIRED CIRCUIT BREAKERS TO BE FURNISHED WITH PANELBOARD PRIOR TO PURCHASE AND INSTALLATION.

| PANELBOARD COORDINATION SCHEDULE | | | | | | | | | | | | | | | |
|----------------------------------|---------|----------|---------|---|------|-------|---------------|-------------|------------|----------------|----------|-------------|---------|-----------------|--|
| MARK | TYPE | MOUNTING | VOLTAGE | Ø | WIRE | MAIN | SERVICE RATED | KAIC RATING | BUS RATING | NEUTRAL RATING | C/B TYPE | FEEDER | | | |
| | | | | | | | | | | | | CONDUCTORS | GROUND | CONDUIT | |
| MDP | NEMA-12 | SURFACE | 480/277 | 3 | 4 | MLO | YES | 35 | 400 | 400 | BOLT-ON | (4)600MCM | (1)#2/0 | (2)5":(1-SPARE) | |
| DP | NEMA-12 | SURFACE | 480/277 | 3 | 4 | MLO | NO | 35 | 250 | 250 | BOLT-ON | (4)#4/0 AWG | (1)#4 | (1)2½" | |
| SD | NEMA-12 | SURFACE | 120/208 | 3 | 4 | 250MB | NO | 18 | 250 | 250 | BOLT-ON | (4)#250MCM | (1)#4 | (1)3" | |


NOTES: ALL BUSSING COPPER, INCLUDING NEUTRAL AND GROUND.
ALL LUGS 100 AMPS AND GREATER SHALL BE COPPER.
ALL LUGS ON CIRCUIT BREAKERS GREATER THAN 400 AMPS SHALL BE COPPER.

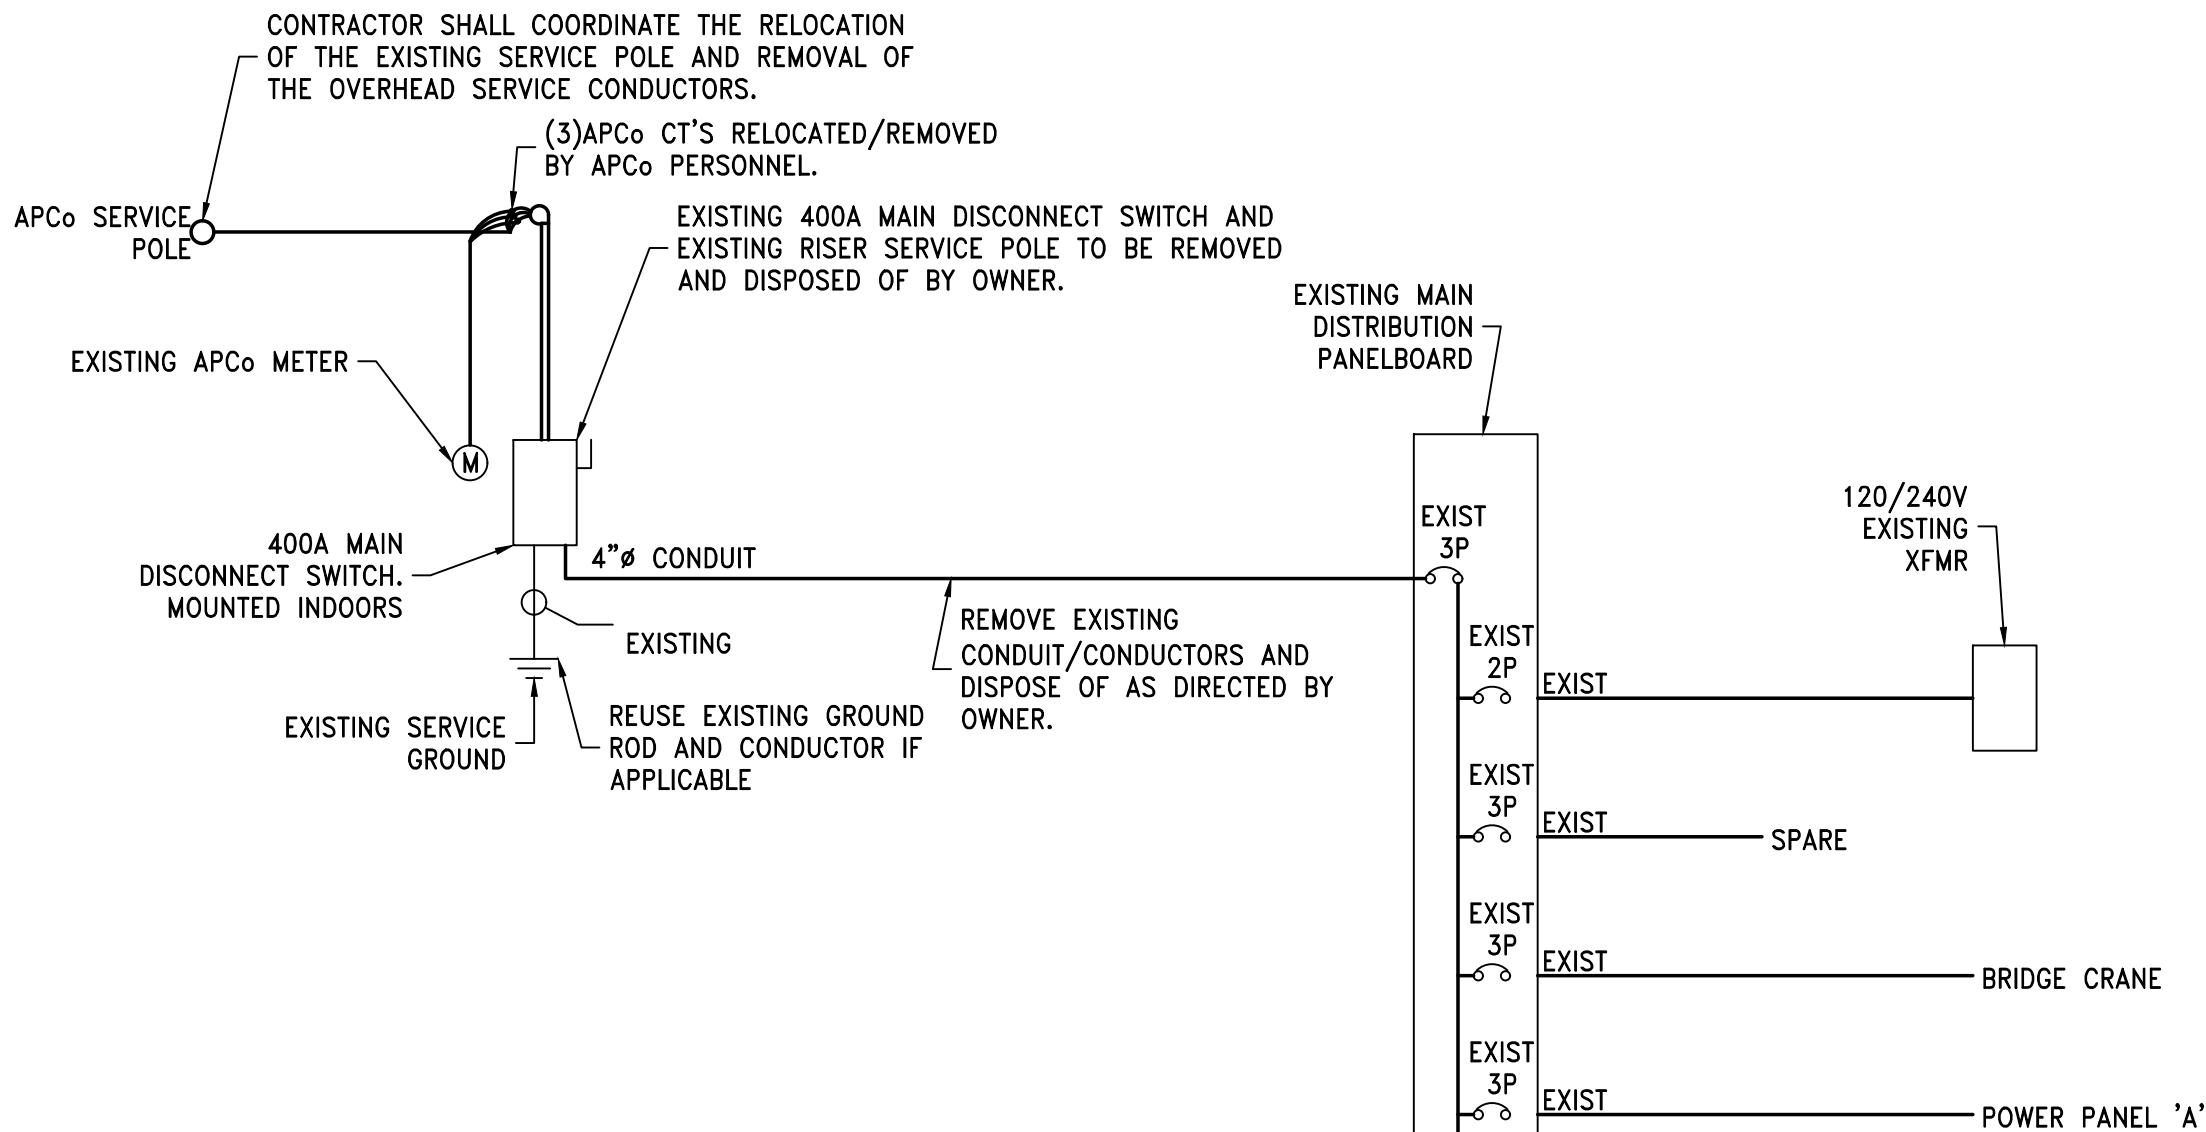

EXISTING ELECTRICAL AC RISER DIAGRAM WITH DEMO NOTES

SCALE:N.T.S.
NOTES:

- CONTRACTOR SHALL COORDINATE THE REMOVAL OF THE EXISTING ELECTRICAL SERVICE EQUIPMENT WITH APCo/OWNER REPRESENTATIVE AND THE INSTALLATION OF THE NEW ELECTRICAL SERVICE EQUIPMENT AS TO MINIMIZE THE ELECTRICAL SERVICE OUTAGE.
- CONTRACTOR SHALL VERIFY WITH APCo PERSONNEL THE REQUIREMENTS FOR A NEW FACILITY METERING EQUIPMENT LOCATION AND INSTALL AS PER APCo REQUIREMENTS.

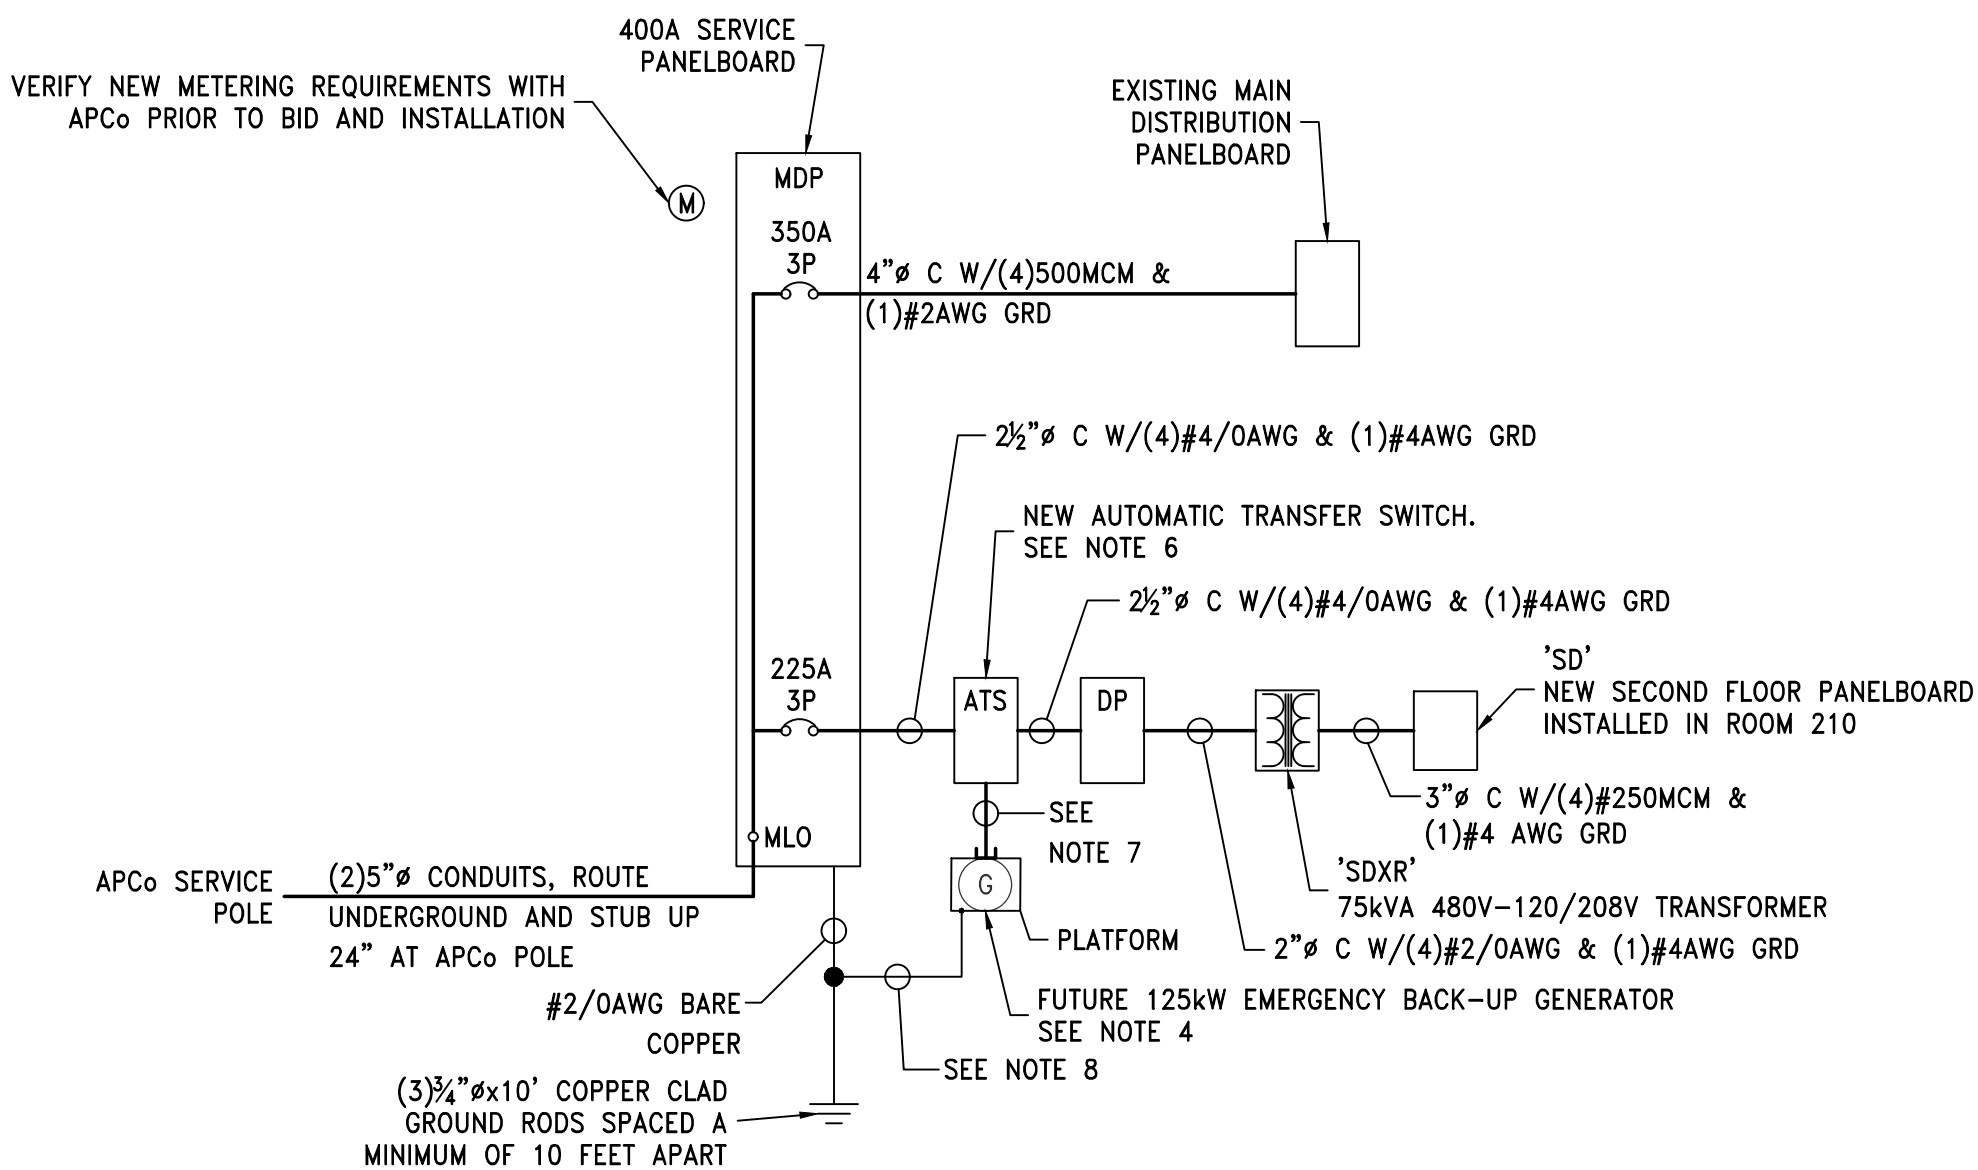

NEW ELECTRICAL AC RISER DIAGRAM

SCALE:N.T.S.
NOTES:

- CONTRACTOR SHALL COORDINATE THE REMOVAL OF THE EXISTING ELECTRICAL SERVICE EQUIPMENT WITH APCo/OWNER REPRESENTATIVE AND THE INSTALLATION OF THE NEW ELECTRICAL SERVICE EQUIPMENT AS TO MINIMIZE THE ELECTRICAL SERVICE OUTAGE.
- CONTRACTOR SHALL VERIFY WITH APCo PERSONNEL THE REQUIREMENTS FOR A NEW FACILITY METERING EQUIPMENT LOCATION AND INSTALL AS PER APCo REQUIREMENTS.
- CONTRACTOR SHALL VISIT THE SITE AND VERIFY THE LOCATION OF THE NEW MAIN SERVICE PANELBOARD PRIOR TO BID AND INSTALLATION.
- STAND-BY GENERATOR NOT IN THIS CONTRACT. STAND-BY GENERATOR AND CONDUCTORS SHALL NOT BE INSTALLED UNDER THIS CONTRACT.
- BATTERY CHARGER NOT IN THIS CONTRACT. BATTERY CHARGER CONDUIT AND CONDUCTORS SHALL BE INSTALLED AND TERMINATED IN A JUNCTION BOX LOCATED AS SHOWN ON 4146-E4.
- CONTRACTOR SHALL FURNISH AND INSTALL NEW KOHLER #KSS-AMTA-260-S (OR APPROVED EQUAL) AUTOMATIC TRANSFER SWITCH WITH GENERATOR MONITORING SYSTEM FOR FUTURE 125kW STAND-BY GENERATOR INSTALLATION. 125kW STAND-BY GENERATOR SHALL BE A FUTURE ADDITION BY OTHERS.
- CONTRACTOR SHALL ROUTE (1)2½"Ø CONDUIT (POWER) AND (1)1½"Ø CONDUIT (CONTROL/MONITORING) FROM THE ATS ENCLOSURE TO THE GENERATOR PLATFORM AND STUB-UP IN A LOCATION NEAR THE FUTURE GENERATOR CONTROL ENCLOSURE, STUB-UP 4 FOOT, CAP AND INSTALL PULL STRING FOR FUTURE USE.
- CONTRACTOR SHALL ROUTE (1)#2 AWG BARE COPPER GROUND CONDUCTOR FROM THE NEW SERVICE GROUND CONNECTION TO THE GENERATOR PLATFORM AND SECURE TO PLATFORM STRUCTURE COLUMN WITH CADWELD DEVICE.

© COWLES, MURPHY, GLOVER & ASSOCIATES, INC. 2022
CONFIDENTIAL, VALUABLE, AND PROPRIETARY INFORMATION

| | | | | | |
|------|------------------------|--|----------|-----|-------|
| | | | | | |
| | | | | | |
| C | REVISED PER ADDENDUM 2 | | 08/24/22 | RCC | JJM |
| B | ISSUED FOR BID | | 08/01/22 | RCC | JJM |
| REV. | DESCRIPTION | | DATE | BY | CHK'D |

Cowles, Murphy, Glover & ASSOCIATES
A Full Service Engineering Firm

PERFORMANCE • RELIABILITY • EXPERIENCE

457 St. Michael St., Mobile, AL 36602
13 Thrash Rd., LaGrange, GA 30241
11880 Cranston Dr. Ste 102, Arlington, TN 38002
Alabama (251) 433-1611
Georgia (706) 302-2831 Tennessee (901) 290-5444

PROJECT

**TERMINAL RAILWAY
OFFICE ADDITION/RENOVATION**
**126 INDUSTRIAL CANAL ROAD
MOBILE, ALABAMA**

TITLE

| ELECTRICAL AC-ONE-RISER DIAGRAM | | | | |
|---------------------------------|------------|----------|----------------|------------|
| SCALE | DRAWN BY | DATE | SHEET | 22x34 REV. |
| AS NOTED | JDG | 03/30/22 | — of — | C |
| JOB NO. | CHECKED BY | DATE | DRAWING NUMBER | |
| 4146-22 | JJM | 06/10/22 | 4146-E5 | |



**SOUTHERN
EARTH SCIENCES**
Geotechnical | Environmental | Materials Testing

**Alabama State Docks
Terminal Railway Office Expansion**

**126 Industrial Canal Road
Mobile, AL**

**Report of Subsurface Investigation and
Geotechnical Engineering Evaluation**

Prepared for:
COWLES, MURPHY, GLOVER & ASSOCIATES
SESI Project No: M22-264
April 22, 2022



**SOUTHERN
EARTH SCIENCES**
Geotechnical | Environmental | Materials Testing

MOBILE OFFICE

5460 Rangeline Road
Mobile, AL 36619

Tel: (251) 344-7711
Fax: (251) 443-9000
www.soeearth.com

April 22, 2022

COWLES, MURPHY, GLOVER & ASSOCIATES

457 St. Michael Street
Mobile, AL 36602

ATTENTION: Mr. Miles Dearing

REFERENCE: Report of Subsurface Investigation and Geotechnical Engineering Evaluation
Alabama State Docks Terminal Railway Office Expansion
126 Industrial Canal Road
Mobile, AL
SESI Project No: M22-264

Dear Mr. Dearing,

Southern Earth Sciences, Inc. (SESI) has completed the authorized scope of subsurface investigation and geotechnical engineering evaluation for the referenced project. This report presents our understanding of the available project information and outlines our soil related recommendations and comments regarding construction and foundation support for the proposed office expansion.

We appreciate this opportunity to be of service and look forward to our continued involvement throughout pile testing and construction phases of the project. Please do not hesitate to contact us if you have any questions.

Sincerely,

SOUTHERN EARTH SCIENCES, INC.

Curran Nicholas, E.I.
Geotechnical Project Manager

CN/mc

Attachments

Matt Coaker, P.E.
Vice President
Registered, Alabama 30850

COWLES, MURPHY, GLOVER & ASSOCIATES

Report of Subsurface Investigation and Geotechnical Engineering Evaluation

Alabama State Docks Terminal Railway Office Expansion

Mobile, AL

SESI Project No: M22-264

April 22, 2022

| | | |
|-------|--|-------|
| 1.0 | Project Information..... | - 1 - |
| 2.0 | Field Investigation..... | - 1 - |
| 3.0 | Generalized Subsurface Conditions | - 1 - |
| 4.0 | Groundwater..... | - 2 - |
| 5.0 | Foundation Considerations and Conclusions..... | - 2 - |
| 5.1 | Pile Supported Foundation | - 3 - |
| 5.1.1 | Test Pile Recommendations..... | - 3 - |
| 5.1.2 | Pile Installation Considerations..... | - 4 - |
| 5.1.3 | Vibration Monitoring During Pile Driving..... | - 4 - |
| 6.0 | General Comments and Limitations | - 5 - |

APPENDIX 1

Test Location Plan

APPENDIX 2

CPT Sounding Log

COWLES, MURPHY, GLOVER & ASSOCIATES

Report of Subsurface Investigation and Geotechnical Engineering Evaluation

Alabama State Docks Terminal Railway Office Expansion

Mobile, AL

SESI Project No: M22-264

April 22, 2022

1.0 PROJECT INFORMATION

Based on our understanding of the provided information, the project will consist of the expansion of the existing elevated, wood framed, pile supported office building structure. The expansion is approximately 1,000 ft² in plan area. The office expansion will be constructed on the west side of the existing office building located at 126 Industrial Canal Road in Mobile, Alabama. The project site is currently a gravel parking/drive area. We assume that final site grade beneath and adjacent to the structure will be no more than about 2 feet above existing site grade. According to Miles Dearing with Cowles, Murphy, Glover & Associates (CGL), the maximum column load is on the order of 25 kips. No detailed grading or topographic information was available for the structure at the writing of this report.

2.0 FIELD INVESTIGATION

One (1) Cone Penetrometer Test (CPT) sounding was performed within close proximity to the proposed office expansion area. Test location was selected by SES personnel using the provided site plan, reference to site features and a handheld GPS with an accuracy of ± 30 feet. A Test Location Plan depicting the approximate test location is attached in **Appendix 1**.

The CPT sounding was performed in general accordance with ASTM Specification D-5778 using a 20-ton Hogentogler Electronic truck-mounted CPT rig. The CPT sounding was advanced to a depth of approximately 50 feet below the existing ground surface. Soil classifications were interpreted from methods recommended by Robertson and Campanella. Correlations between Cone Resistance values and Standard Penetration Testing "N" values were performed according to the methods developed by Robertson, Campanella and Wightman. The soil types and stratigraphy shown on the CPT Log sheet are based upon material parameters measured and evaluated as the cone is advanced. The CPT Log sheet graphically showing the cone tip resistance, friction, equivalent N60-value and interpreted soil behavior type at the sounding location is attached in **Appendix 2**.

3.0 GENERALIZED SUBSURFACE CONDITIONS

Subsurface descriptions below are generalized to highlight the major subsurface stratigraphy encountered across the site. The CPT sounding log sheet attached in **Appendix 2** presents specific information at the individual sounding location including correlated soil behavior type, equivalent SPT values and ground water level. This information is representative of conditions encountered at this test location. Variations may occur and should be expected throughout the project site. The stratification represents the approximate boundary between subsurface materials as the actual transition may be gradual.

COWLES, MURPHY, GLOVER & ASSOCIATES

Report of Subsurface Investigation and Geotechnical Engineering Evaluation

Alabama State Docks Terminal Railway Office Expansion

Mobile, AL

SESI Project No: M22-264

April 22, 2022

Beneath an upper layer of gravel, soils at this site generally consist of medium dense sands to an approximate depth of about 3 feet underlain by soft to medium silt and clay to an approximate depth of 9 feet. Below about 9 feet, loose to medium dense sands were encountered to approximately 25 feet beneath the existing ground surface underlain by soft to medium silt and clay to approximately 39 feet below existing ground surface. Medium dense to dense sands were encountered below this level to termination of the investigation at approximately 50 feet below existing ground surface. Detailed descriptions of soils encountered at this test location are shown on the CPT Sounding log included in **Appendix 2**. Reference to depth has been made with respect to the existing ground surface at the time of our field investigation.

4.0 GROUNDWATER

The CPT sounding hole collapsed at a depth of approximately 5.7 feet below the existing ground surface. The CPT sounding hole caved in upon removal of the CPT rods with no free water being observed at the cave-in depth. A hole collapse often occurs at or slightly above the groundwater or saturated soil level but can also occur due to the presence of loose soils without the presence of groundwater. The shallow collapsed depths at most locations are likely the result of perched groundwater caused by the low permeability silty and clayey soils present within the upper reaches of much of this site.

Groundwater depths or elevations should be verified at the time of construction for cases where groundwater variations are potentially significant for construction. Fluctuation in the groundwater table will occur due to variances in rainfall, elevation, drainage, types of soil encountered and other factors not evident at the time measurements were made. Reference to depth has been made with respect to the existing ground surface encountered at the time of our field investigation. Groundwater levels encountered at the test location at the time of our investigation is shown on the CPT sounding Log attached in **Appendix 2**.

5.0 FOUNDATION CONSIDERATIONS AND CONCLUSIONS

Our evaluation of foundation conditions has been based on the project previously described in this report and subsurface data obtained during the investigation. In evaluating the CPT sounding, we have used empirical correlations previously established between standard penetration resistances, soil index properties and foundation stability and the characteristics for soils similar to those encountered at the referenced site. Soil parameters used in the evaluation were derived from the CPT sounding data using the interpretation software RAPID CPT® by Dataforensics.

COWLES, MURPHY, GLOVER & ASSOCIATES

Report of Subsurface Investigation and Geotechnical Engineering Evaluation

Alabama State Docks Terminal Railway Office Expansion

Mobile, AL

SESI Project No: M22-264

April 22, 2022

5.1 Pile Supported Foundation

To assist in project planning and foundation design, we have developed the following table presenting recommended pile penetration depths and allowable compression and tension pile capacities from static analysis. The allowable pile capacities are based on a Factor of Safety (FOS) of 2.0 for compression and 2.5 for tension, respectively.

Piles have been designed to derive their capacity as a result of a combination of side resistance in the medium dense sands and soft to medium silts and clays in the upper 40 feet of the site and primarily in end bearing in the medium dense sands beginning at about 40 feet below ground surface. Pile foundation recommendations are provided in the following sections of this report.

TABLE 1 - TAPERED TIMBER PILE CAPACITIES

| <i>Recommended Penetration Below Existing Grade (ft)</i> | <i>Tip Diameter Size (inches)</i> | <i>Allowable Axial Compressive Capacity (tons)</i> | <i>Allowable Axial Tension Capacity (tons)</i> |
|--|-----------------------------------|--|--|
| 40 - 42 | 8 | 15 | 9 |
| | 9 | 17 | 10 |
| | 10 | 20 | 12 |

*Penetration depths referenced from existing ground surface at the time of investigation

We will be pleased to evaluate additional pile types/sections at your request. The pile length, sizes and capacities presented are based on soil-pile interaction and do not consider the structural aspects of the pile. *Pile penetration depths are measured from the existing ground surface and should be adjusted accordingly to ensure that the correct penetration depth is achieved.* Fill heights exceeding about 2 feet above original site elevations would result in reduced pile capacity as a result of down drag forces on the piles caused by fill induced settlement. We should be notified if more than 2 feet of fill will be placed above the original ground surface.

5.1.1 Test Pile Recommendations

We recommend a test pile program which includes installing one (1) test pile using a Pile Driving Analyzer (PDA). PDA results, in conjunction with driving resistances, can be calibrated with the driving hammer to formulate installation criteria and estimate the installed capacity of individual piles, allowing full utilization of the achieved capacity. The test pile should be installed using the same equipment configuration to be used for production pile installation in accordance with the installation procedures described above.

COWLES, MURPHY, GLOVER & ASSOCIATES

Report of Subsurface Investigation and Geotechnical Engineering Evaluation

Alabama State Docks Terminal Railway Office Expansion

Mobile, AL

SESI Project No: M22-264

April 22, 2022

A tentative driving resistance should be computed using a dynamic formula such as the Wave Equation. In computing the required driving resistance, we recommend an ultimate capacity of at least two times the design capacity be used in the dynamic formula.

PDA results would be used to verify the placement procedures and that the pile section produces the desired design capacity. The test pile section, equipment, and installation procedures should be the same as those planned for use in the foundation. Since adjustments of the pile lengths or installation procedures may be made based on the test pile installation and PDA test results, we recommend the test pile program and production pile installation be performed under the direct supervision of the project geotechnical engineer of record.

5.1.2 Pile Installation Considerations

Hard driving is expected between approximately 10 to 15 feet below ground surface. Consideration should be given to the means and methods that will be required to advance piling to the recommended tip elevation. Medium dense sands were encountered above the intended bearing stratum. Jetting through these intermediate sands will help facilitate pile penetration while reducing driving effort and associated vibrations. Piles may be jetted to within 5 feet of the recommended penetration depth. Jetting should not be performed within about 5 feet of design pile tip elevation. Piles should be driven a minimum of 5 feet to final tip elevation.

5.1.3 Vibration Monitoring During Pile Driving

Infrastructure, underground utilities, and nearby structures can be damaged by vibrations and subsidence caused by vibrations during pile driving. Care should be taken by the contractor to ensure that vibrations do not impact the adjacent structure.

Due to the existing building adjacent to the site, monitoring of the ground vibration during installation of the planned foundation system may need to be considered. We offer this service and would be please to assist at your request. Thresholds of vibration induced cracking are generally site specific and depend on the type and age of the structure, the frequency of ground vibration, and the type of soil supporting the structure. Research by the U.S. Bureau of Mines (USBM) and other investigative groups have established criteria relating the occurrence of structural damage to certain frequencies and level of peak ground motion.

COWLES, MURPHY, GLOVER & ASSOCIATES

Report of Subsurface Investigation and Geotechnical Engineering Evaluation

Alabama State Docks Terminal Railway Office Expansion

Mobile, AL

SESI Project No: M22-264

April 22, 2022

6.0 GENERAL COMMENTS AND LIMITATIONS

While the CPT sounding is representative of subsurface conditions at the respective locations and for its respective vertical reach, local variations characteristic of the subsurface materials of the region are anticipated and may be encountered. The delineation between soil types shown on the log is approximate and the description represents our interpretation of subsurface conditions at the designated test location and on the particular date explored.

This report has been prepared in order to aid in the evaluation of this project and to assist the engineers in the project planning and structural design. At the time of writing, changes were still being considered to foundations, site grading, and other aspects of the project that could have a significant impact on the applicability or relevance of the recommendations provided in this report. SESI should be consulted as the design process continues to ensure that the recommendations provided in this report are still applicable, and that they are being properly interpreted.

This report is intended for use with regard to the specific project discussed herein as we understand it at this time, and any substantial changes in the project, loads, locations, or assumed grades should be brought to our attention so that we may determine how such changes may affect our conclusions and recommendations. We would appreciate the opportunity to review the plans and specifications for construction to ensure that our conclusions and recommendations are interpreted correctly.

Professional judgments on design alternatives and criteria are presented in this report. These are based partly on our evaluations of technical information gathered, partly on our understanding of the characteristics of the project being planned, and partly on our general experience with subsurface conditions in the area. We do not guarantee performance of the project in any respect, only that our engineering work and judgments rendered meet the standard of care of our profession.

The Geotechnical Engineer of Record should be retained by the Owner in the construction phase of the project so they can observe subsurface conditions revealed during construction, confirm that design assumptions are still applicable or provide revised recommendations based on conditions encountered during construction, and to help ensure that our recommendations are properly interpreted. We recommend that Southern Earth Sciences, Inc. be retained to perform observation and field-testing services during the site preparation and foundation construction.

COWLES, MURPHY, GLOVER & ASSOCIATES

Report of Subsurface Investigation and Geotechnical Engineering Evaluation

Alabama State Docks Terminal Railway Office Expansion


Mobile, AL

SESI Project No: M22-264

April 22, 2022

APPENDIX 1

Test Location Plan

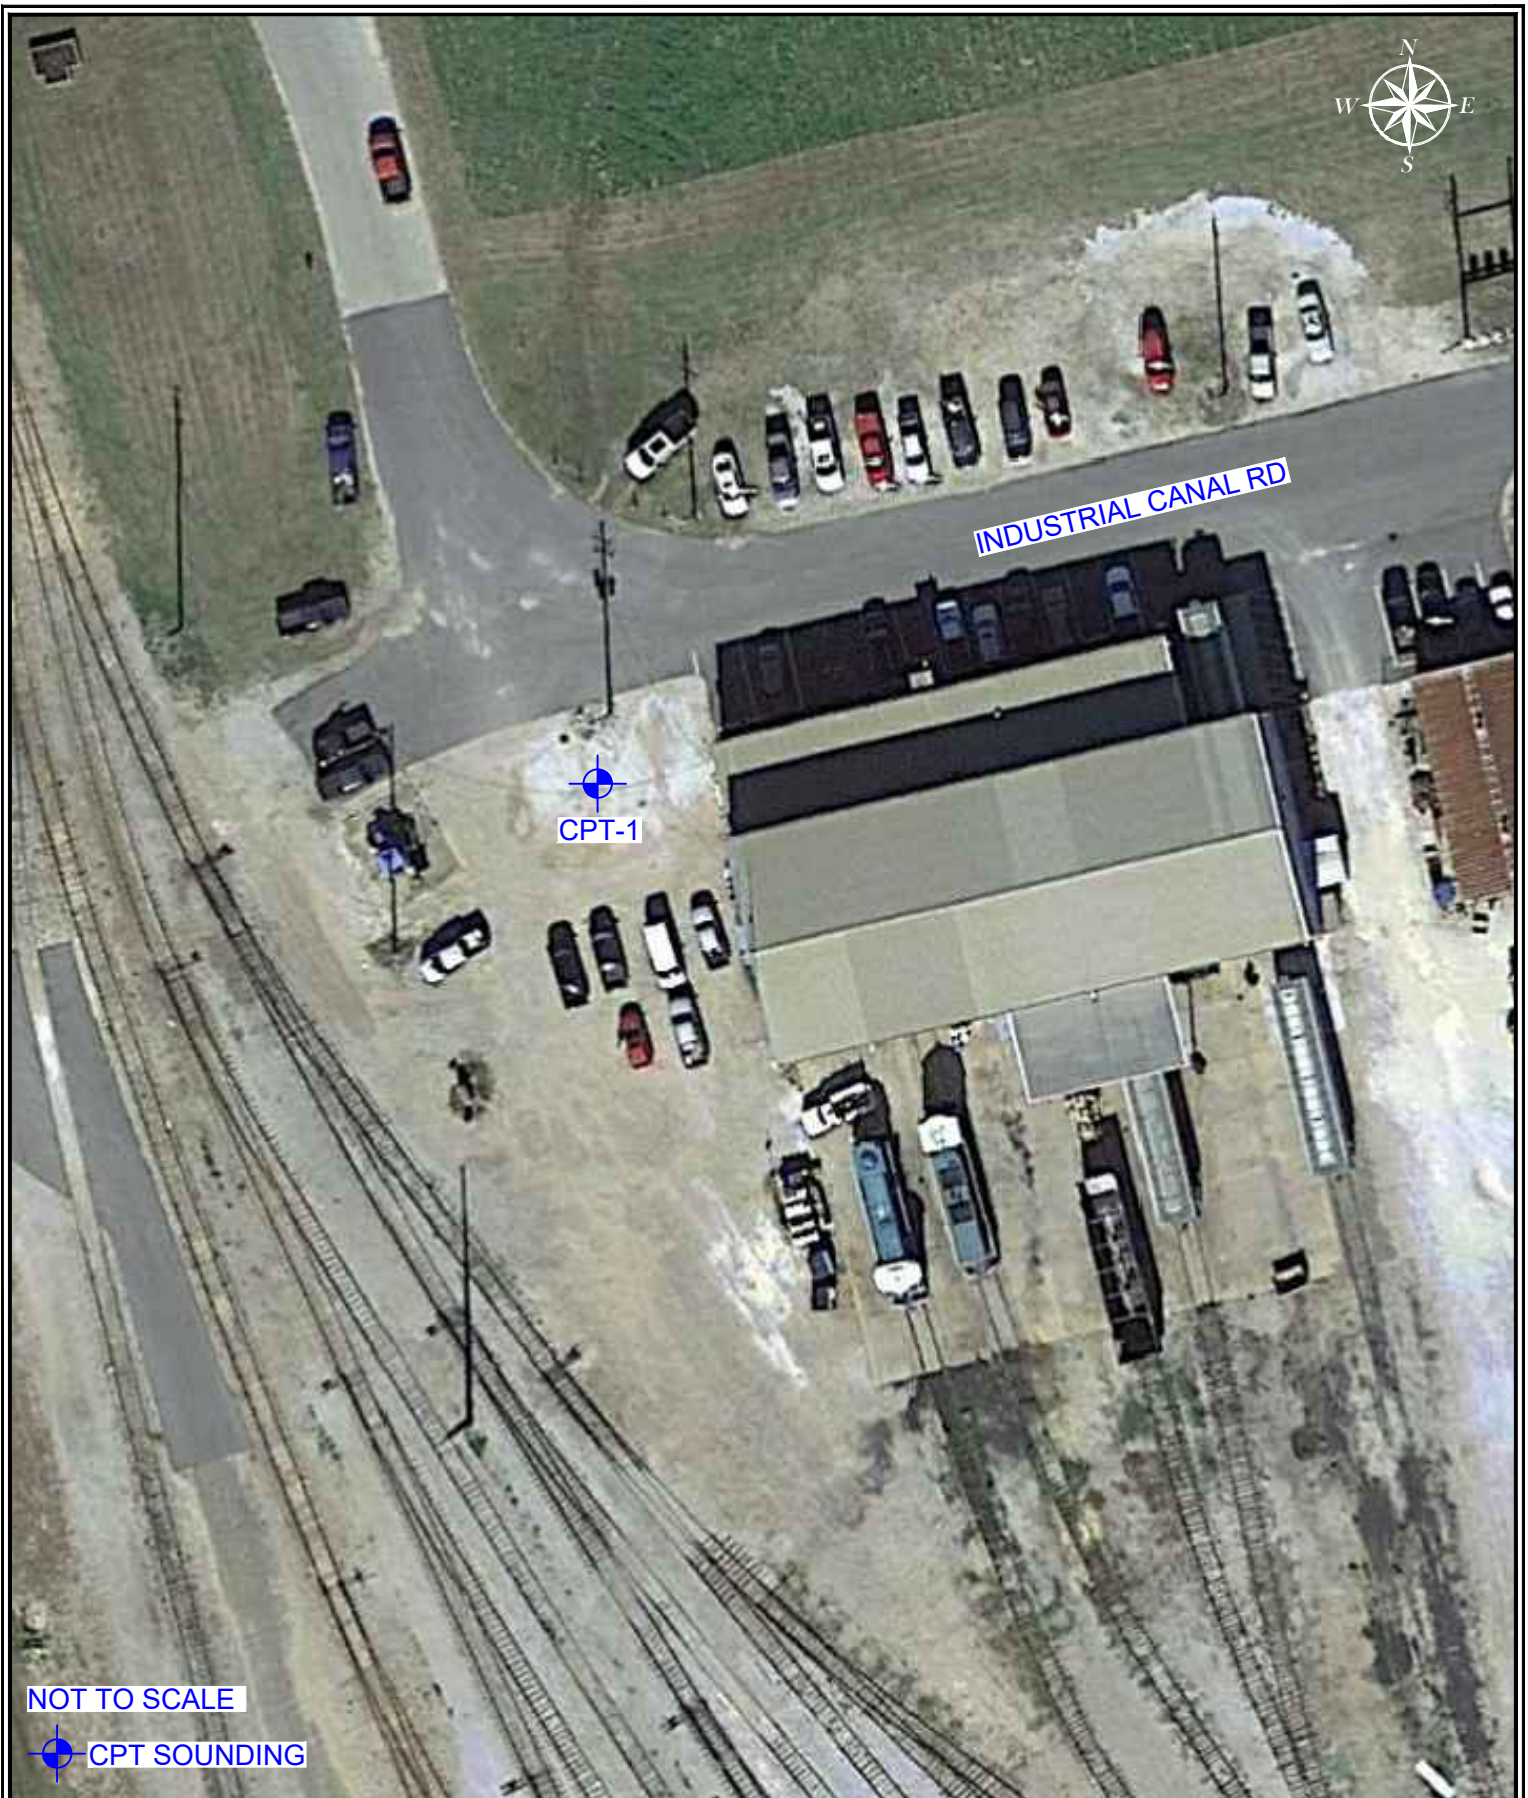

NOT TO SCALE


CPT SOUNDING

STATE DOCKS TERMINAL RAILWAY
FACILITY EXPANSION
MOBILE, AL



**SOUTHERN
EARTH SCIENCES**
Geotechnical | Environmental | Materials Testing

TEST LOCATION PLAN
SESI JOB #: M22-264

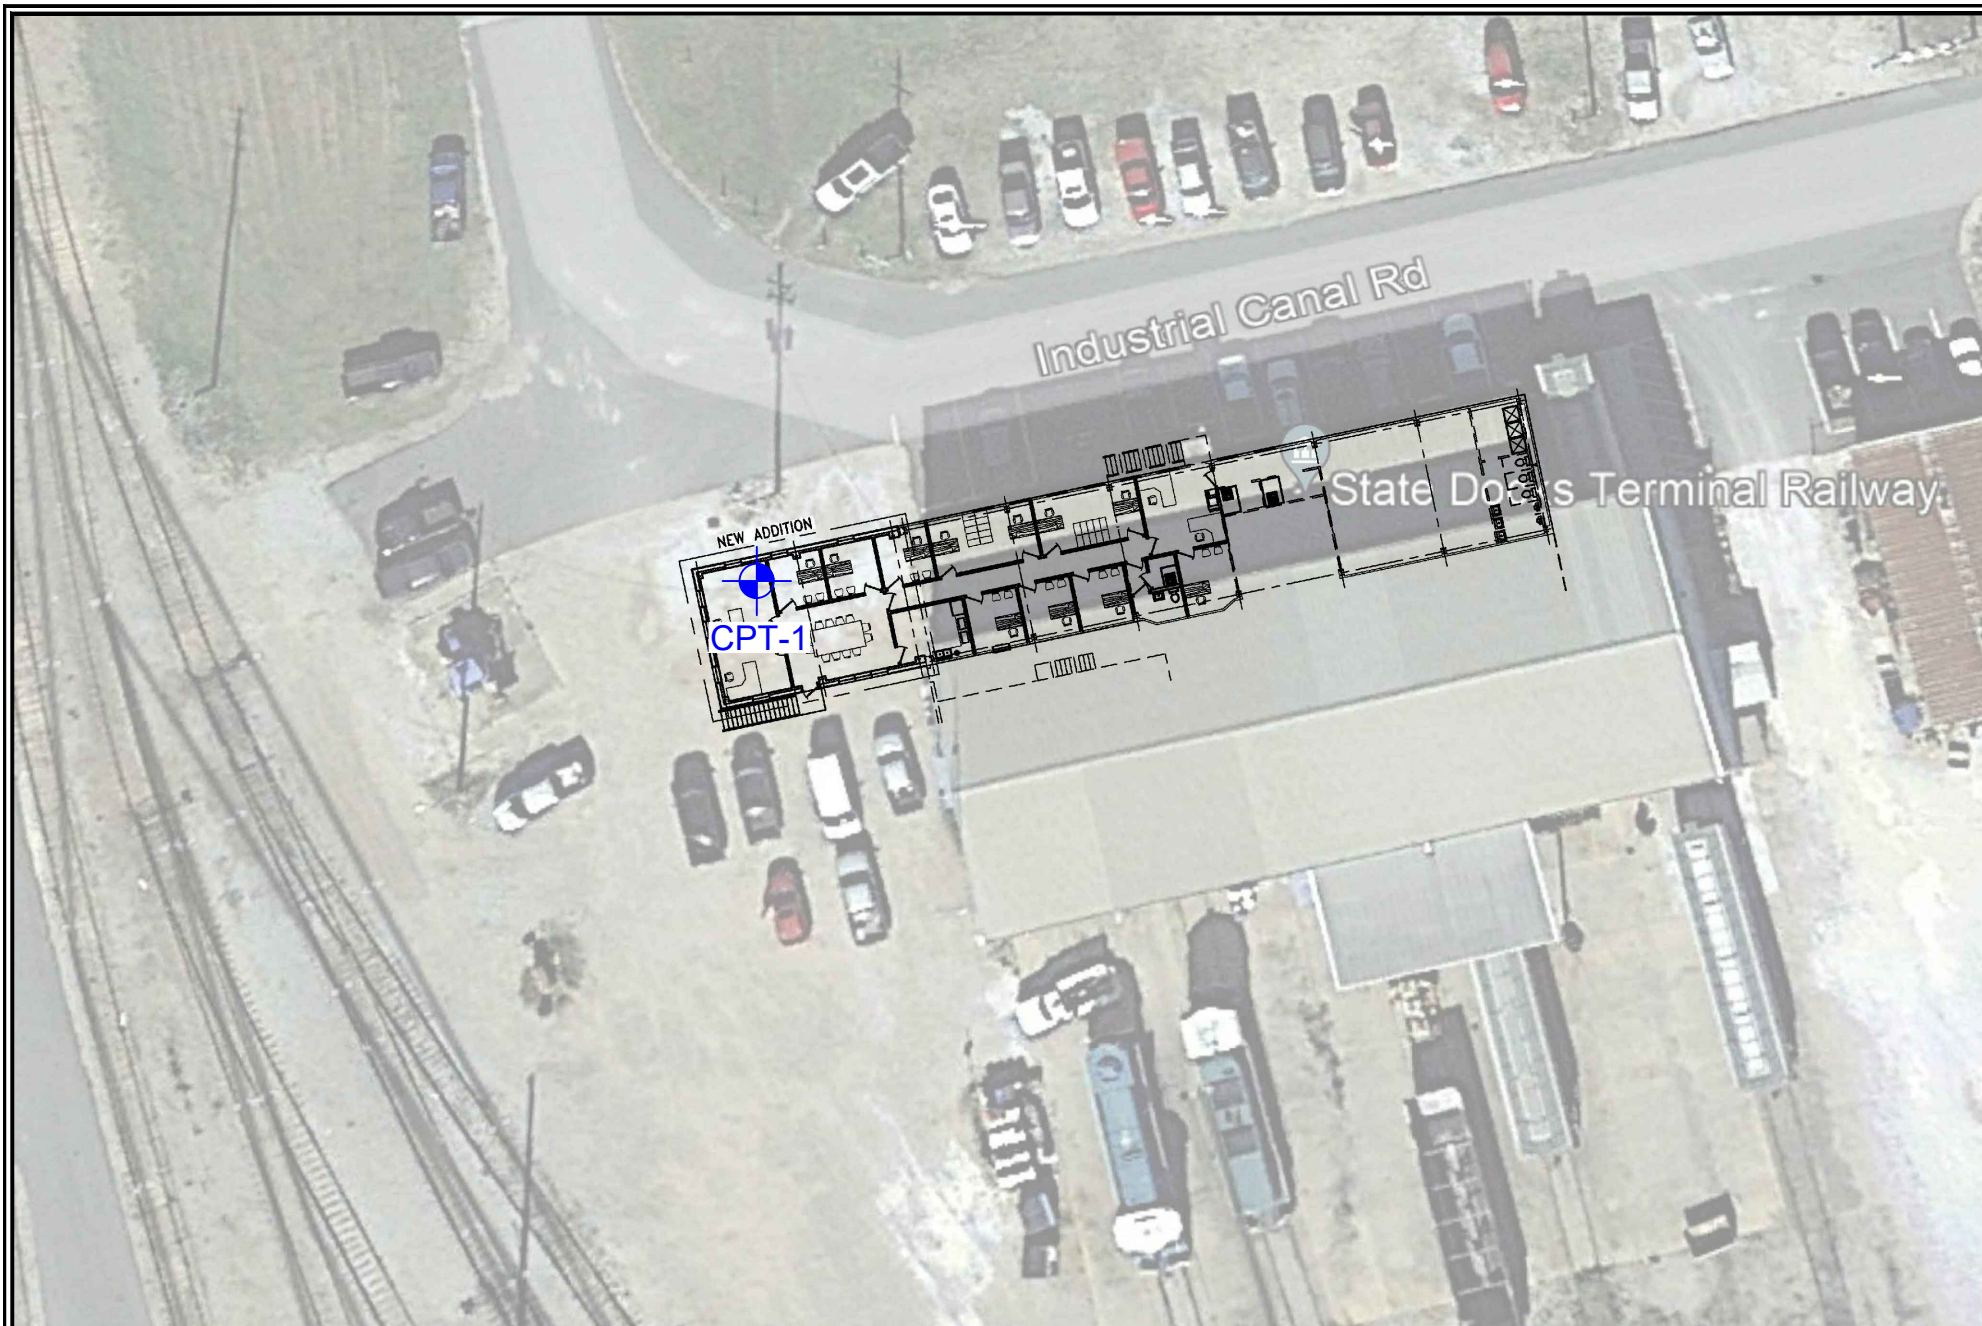

NOT TO SCALE
CPT SOUNDING

STATE DOCKS TERMINAL RAILWAY
FACILITY EXPANSION
MOBILE, AL



**SOUTHERN
EARTH SCIENCES**
Geotechnical | Environmental | Materials Testing

TEST LOCATION PLAN
SESI JOB #: M22-264

COWLES, MURPHY, GLOVER & ASSOCIATES

Report of Subsurface Investigation and Geotechnical Engineering Evaluation

Alabama State Docks Terminal Railway Office Expansion

Mobile, AL

SESI Project No: M22-264

April 22, 2022


APPENDIX 2

CPT Sounding Log

Southern Earth Sciences

Operator: Brandon Green
Sounding: CPT-1
Cone Used: DDG1526
GPS Data: N30.72421 W88.05273

CPT Date/Time: 3/30/2022 2:00:50 PM
Location: S.D.T. Railway Expansion
Job Number: M22-264
Groundwater: Collapsed Dry At 5.7-ft.

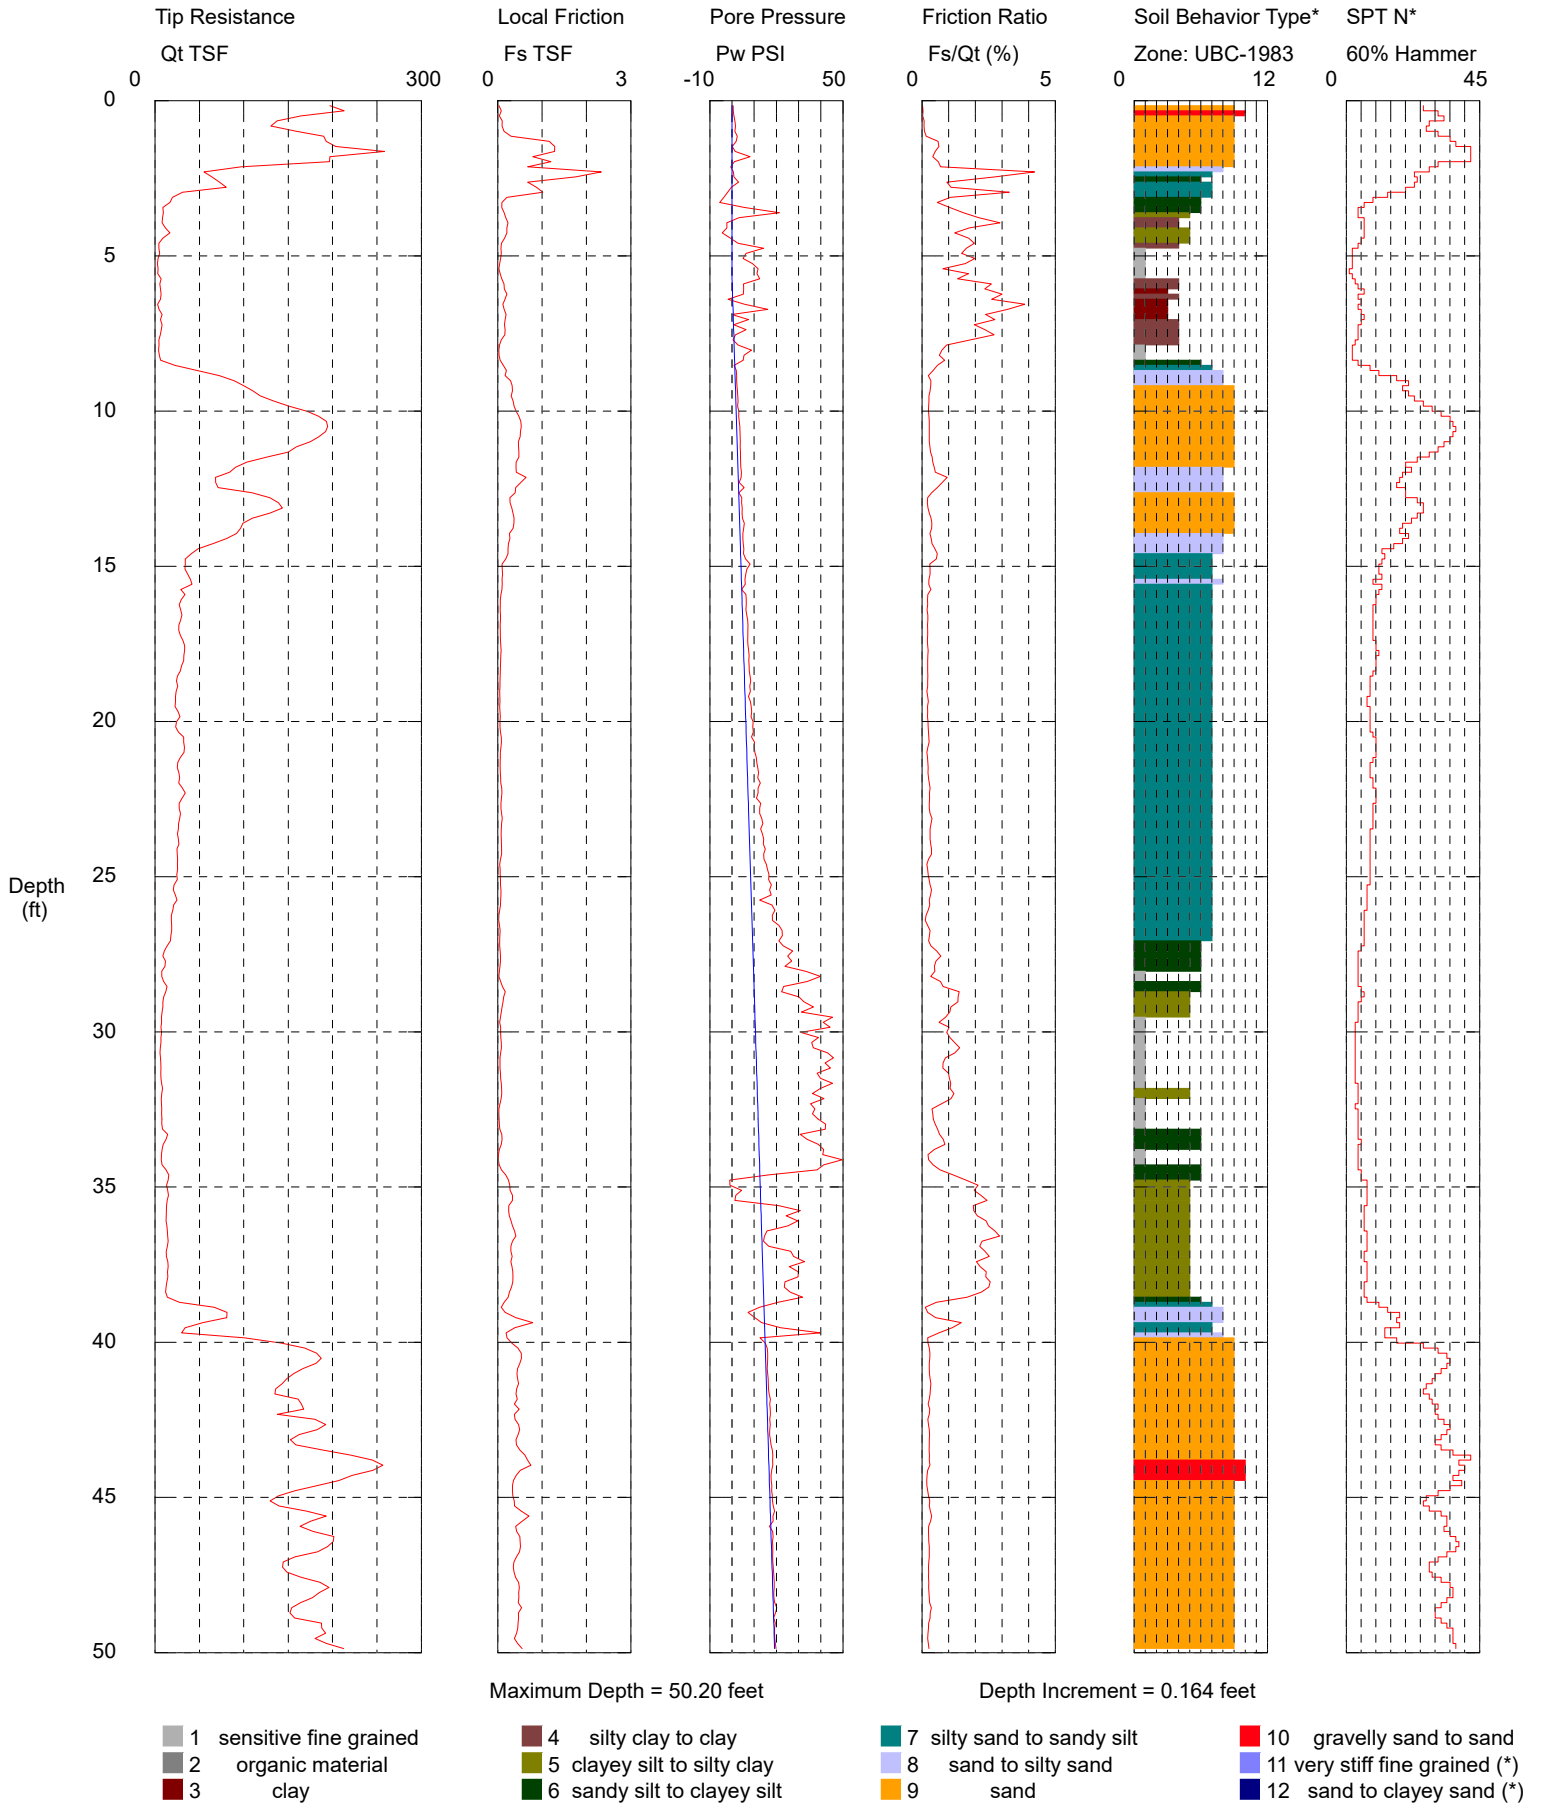

*Soil behavior type and SPT based on data from UBC-1983