

**M**

**MOTT  
MACDONALD**

**M**



**PORT OF MOBILE**  
ALABAMA PORT AUTHORITY

**APPENDIX E**  
**EXISTING DRAWINGS**

# ALABAMA STATE PORT AUTHORITY

## PIER B SOUTH SHEET PILE WALL REPLACEMENT MOBILE, ALABAMA (10996-TASK 2)

KAY IVEY, GOVERNOR  
JOHN C. DRISCOLL, DIRECTOR AND C.E.O

ALABAMA STATE PORT AUTHORITY - BOARD OF DIRECTORS  
BESTOR WARD, CHAIRMAN

ALVIN K. HOPE II, 1st VICE CHAIR  
DARYL H. DEWBERRY  
TONY COCHRAN  
CARL JAMISON

BEN C. STIMPSON, 2nd VICE CHAIR  
DR. PATRICIA SIMS  
HORACE HORN  
THE HON. MERCERIA LUDGOOD



LOCATION MAP  
NTS

AS-BUILT INFORMATION SHOWN ON THIS DRAWING HAS BEEN OBSERVED AND SUPPLIED BY THE CONTRACTOR. MOTT MACDONALD DOES NOT ATTEST TO THE ACCURACY OF THE CONTRACTOR'S MARK-UPS, BUT SIGNIFICANT FIELD CHANGES SHOWN ON THE DRAWINGS WERE VERIFIED BY MOTT MACDONALD FOR CONFORMANCE WITH THE ORIGINAL DESIGN INTENT.



Mott MacDonald  
107 St. Francis Street  
Suite 2900  
Mobile, Alabama 36602  
United States of America  
Telephone: (251) 343-4366  
www.mottmac.com/americas


Client  
ALABAMA STATE  
PORT AUTHORITY

MOBILE, ALABAMA

Rev	Date	Drawn	Description	Ch'k'd	App'd
2	07-27-23	KWD	AS-BUILT RECORD DRAWINGS	CEL	LJD
1	05-18-22	KWD	ADD 1 ISSUED FOR CONST	CEL	LJD
0	01-14-22	KWD	ISSUED FOR BID	CEL	LJD

LOWRY J. DENTY, P.E.  
24892 ALABAMA - CERTIFICATION NUMBER

AS-BUILT  
RECORD

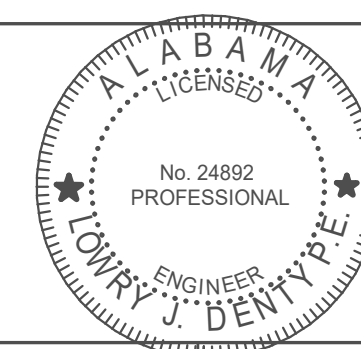

Project Number  
397324

Designed	JQ	Eng Check	KP
Drawn	KWD MC	Coordination	LJD
Dwg Check	CEL	Approved	BP
Scale at ANSI D	Status	Rev	Security
None	IFC	1	STD

Drawing Number  
GA-01

Title  
PIER B SOUTH  
COVER SHEET

GENERAL

PIER B SOUTH


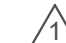
397324

7/28/2023 9:22:18 AM

# SHEET INDEX

GENERAL		
SHEET	REV	DRAWING NAME
GA-01	2	COVER SHEET
GA-02	2	SHEET INDEX AND SUMMARY OF WORK
GA-03	2	GENERAL NOTES AND ABBREVIATIONS
GA-04	2	OVERALL SITE PLAN
GA-05	2	GENERAL DEMOLITION NOTES
GA-06	2	GENERAL MARINE NOTES
SHEET PILE WALL REPLACEMENT		
SHEET	REV	DRAWING NAME
DEMOLITION		
DS-01	2	DEMOLITION OVERALL DECK DEMOLITION PLAN
DS-02	2	DEMOLITION DECK PLANS AREAS 2 & 3 (BENTS 34B - 74A)
DS-03	2	DEMOLITION DECK PLANS AREAS 4 & 5 (BENTS 1 - 34A)
DS-04	2	DEMOLITION BERTH BASIN SECTION AT EXISTING BENT 1
DS-05	2	DEMOLITION BERTH BASIN SECTION AT WAREHOUSE MCC ROOM
DS-06	2	DEMOLITION BERTH BASIN SECTION AT EXISTING BENT 67
DS-07	2	DEMOLITION DETAILS
DS-08	2	DEMOLITION DETAILS
NEW CONSTRUCTION		
MA-01	2	NEW SHEET PILE WALL INDEX OF PLAN AREAS
MA-02	2	NEW SHEET PILE WALL AREAS 2 & 3 WALL PLANS
MA-03	2	NEW SHEET PILE WALL AREAS 4 & 5 WALL PLANS
MA-04	2	NEW SHEET PILE WALL AREAS 2 & 3 RELIEVING PLATFORM DECK REPAIR PLANS
MA-05	2	NEW SHEET PILE WALL AREAS 4 & 5 RELIEVING PLATFORM DECK REPAIR PLANS
MA-06	2	NEW SHEET PILE WALL AREAS 2, 3, 4, & 5 TYPICAL SECTION THRU NEW WALL
MA-07	2	NEW SHEET PILE WALL DETAILS
MA-08	2	NEW SHEET PILE WALL DETAILS
MA-09	2	NEW SHEET PILE WALL DETAILS
MA-10	2	NEW SHEET PILE WALL RETURN WALL ELEVATION
MA-11	2	NEW SHEET PILE WALL RETURN WALL TYPICAL SECTIONS
UTILITY PLANS		
U-01	2	NEW SHEET PILE RETAINING WALL AREAS 2 & 3 UTILITY PLANS
U-02	2	NEW SHEET PILE RETAINING WALL AREAS 4 & 5 UTILITY PLANS
U-03	2	NEW SHEET PILE RETAINING WALL UTILITY DETAILS

BASIS OF DESIGN
<ol style="list-style-type: none"> <li>THE NEW BULKHEAD STARTING AT EXISTING BENT 68 AND ENDING AT EXISTING BENT 1 IS AN INDEPENDENT CANTILEVER WALL. THE EXISTING PIER MAY BE REMOVED IN THE FUTURE WITHOUT ANY TEMPORARY OR PERMANENT SUPPORT AT THE TOP OF THIS PORTION OF WALL. THE EXISTING RELIEVING PLATFORM IS USED TO REDUCE THE LIVE LOAD SURCHARGE ON THE NEW WALL. REFER TO SHEET GA-06 FOR LIVE LOAD DESIGN LOADING.</li> <li>THE NEW BULKHEAD PARALLEL TO EXISTING BENT 1 IS SUPPORTED AT THE TOP BY THE EXISTING PIER STRUCTURE. PRIOR TO REMOVING THE EXISTING PIER IN THE FUTURE, THIS PORTION OF WALL WOULD NEED TO BE EVALUATED FOR TEMPORARY OR PERMANENT SUPPORT AT THE TOP AND/OR REDUCE SURCHARGE LOADING UNTIL NEW SUPPORT IS INSTALLED.</li> </ol>

SHEET PILE WALL REPLACEMENT SUMMARY OF WORK
<p>THE MAJOR COMPONENTS INCLUDE, BUT IS NOT LIMITED TO THE FOLLOWING:</p> <ol style="list-style-type: none"> <li>PARTIAL DEMOLITION AND LEGAL DISPOSAL OF EXISTING RELIEVING PLATFORM CONCRETE SLAB-ON-GRADE (BENTS 1 TO 68).</li> <li>PARTIAL DEMOLITION AND LEGAL DISPOSAL OF EXISTING ASPHALT AND REMOVAL OF RAILROAD TRACKS (WEST OF RETURN WALL AT BENT 1). TRACKS TO BE STORED BY CONTRACTOR AND GIVEN TO ASPA FOR FUTURE USE. </li> <li>EXCAVATE WEST OF RETURN WALL AT BENT 1.</li> <li>DISCONNECT ACTIVE EXISTING UTILITIES THAT EXTEND THROUGH EXISTING TIMBER WALL AND RECONNECT AFTER NEW STEEL WALL IS INSTALLED (LIMIT OUTAGE TIME).</li> <li>INSTALL NEW STEEL SHEET PILE WALL (BENTS 1 TO 68 AND ALONG RETURN WALL AT BENT 1).</li> <li>INSTALL FLOWABLE FILL IN VOIDS UNDERNEATH THE RELIEVING PLATFORM.</li> <li>PARTIAL DEMOLITION AND LEGAL DISPOSAL OF EXISTING TIMBER BULKHEAD.</li> <li>INSTALL NEW CONCRETE CAP FOR THE FULL LENGTH OF NEW STEEL SHEET PILE WALL.</li> <li>FILL EXCAVATION WEST OF RETURN WALL ALONG BENT 1 AND PLACE NEW CONCRETE SLAB. </li> <li>INSTALL NEW PORTION OF RELIEVING PLATFORM CONCRETE SLAB.</li> </ol>

GENERAL

PIER B SOUTH

397324

7/28/2023 9:22:21 AM

AS-BUILT INFORMATION SHOWN ON THIS DRAWING HAS BEEN OBSERVED AND SUPPLIED BY THE CONTRACTOR. MOTT MACDONALD DOES NOT ATTEST TO THE ACCURACY OF THE CONTRACTOR'S MARK-UPS, BUT SIGNIFICANT FIELD CHANGES SHOWN ON THE DRAWINGS WERE VERIFIED BY MOTT MACDONALD FOR CONFORMANCE WITH THE ORIGINAL DESIGN INTENT.



Mott MacDonald  
107 St. Francis Street  
Suite 2900  
Mobile, Alabama 36602  
United States of America  
Telephone: (251) 343-4366  
www.mottmac.com/americas

Client  
**ALABAMA STATE PORT AUTHORITY**  
  
MOBILE, ALABAMA

Rev	Date	Drawn	Description	Ch'k'd	App'd
2	07-27-23	KWD	AS-BUILT RECORD DRAWINGS	CEL	LJD
1	05-18-22	KWD	ADD 1 ISSUED FOR CONST	CEL	LJD
0	01-14-22	KWD	ISSUED FOR BID	CEL	LJD

AS-BUILT RECORD		
Project Number	B/O	Total
397324		

Designed	JQ	Eng Check	KP
Drawn	KWD MC	Coordination	LJD
Dwg Check	CEL	Approved	BP
Scale at ANSI D	Status	Rev	Security
None	IFC	1	STD
Drawing Number			
GA-02			

Title
PIER B SOUTH SHEET INDEX AND SUMMARY OF WORK

**A. GENERAL NOTES**

- THESE NOTES CONTAIN GENERAL INFORMATION; CONTRACTOR SHALL VERIFY ALL INFORMATION PROVIDED HEREIN WITH THE TECHNICAL SPECIFICATIONS AND CONTRACT DOCUMENTS AND SHALL NOTIFY THE EOR IN WRITING OF ANY CONFLICTS BEFORE WORK IS INITIATED. IN THE EVENT OF A CONFLICT BETWEEN THE CONTRACT DRAWINGS, GENERAL NOTES, AND SPECIFICATIONS THE MORE STRINGENT PROVISION SHALL GOVERN.
- COMPLY WITH REQUIREMENTS OF THE INTERNATIONAL BUILDING CODE, OSHA, AND ALL OTHER APPLICABLE FEDERAL, STATE, AND LOCAL CODES, STANDARDS, ORDINANCES, REGULATIONS, AND LAWS THAT HAVE BEEN ADOPTED AT THE TIME OF THE BID PROCUREMENT.
- ANY DISCREPANCIES, OMISSIONS, OR VARIATIONS NOTED ON THE DRAWINGS OR IN THE SPECIFICATIONS DISCOVERED DURING THE BIDDING PERIOD SHALL BE IMMEDIATELY COMMUNICATED IN WRITING TO THE EOR.
- THE CONTRACTOR IS SOLELY RESPONSIBLE FOR JOB SAFETY.
- ALL DIMENSIONS AND DETAILS SHALL BE VERIFIED BY THE CONTRACTOR PRIOR TO FABRICATION AND CONSTRUCTION.
- THE CONTRACTOR SHALL ABIDE BY ALL APPLICABLE LOCAL, ENVIRONMENTAL PROTECTION STANDARDS, PERMITTING LAWS AND REGULATIONS.
- THE CONTRACTOR SHALL PROTECT EXISTING FACILITIES, STRUCTURES, AND UTILITY LINES FROM ANY DAMAGE. THE CONTRACTOR SHALL ALSO PROTECT THE WORK, ADJACENT PROPERTY, AND THE PUBLIC. THE CONTRACTOR IS SOLELY RESPONSIBLE FOR DAMAGE OR INJURY DUE TO HIS ACTIONS OR NEGLIGENCE.
- CONTRACTOR SHALL COORDINATE WITH THE PORT & EOR FOR THE LOCATION AND EXTENTS OF STAGING AREAS PRIOR TO MOBILIZATION.
- LOCATION OF EXISTING UTILITIES SHOWN ARE TO BE CONSIDERED APPROXIMATE. ALL UTILITIES MAY NOT BE SHOWN.
- CONTRACTOR SHALL VERIFY AND DETERMINE THE LOCATION OF ALL EXISTING UTILITIES, SHOWN OR NOT SHOWN IN THE CONSTRUCTION DRAWINGS BEFORE GROUND DISTURBING ACTIVITIES AND DEMOLITION BEGINS. ANY UNDERGROUND UTILITY LINES LOCATED IN THE PROJECT AREA SHALL BE PROTECTED UNLESS SPECIFICALLY CALLED OUT ON THE DRAWINGS TO BE DEMOLISHED. THE CONTRACTOR SHALL PREMARK ALL AREAS WHERE EXCAVATION AND GRADING OPERATIONS ARE TO OCCUR AND SHALL CONTACT THE PORT AND THE EOR 48 HOURS PRIOR TO THE START OF ONSITE CONSTRUCTION ACTIVITIES.
- CONTRACTOR IS RESPONSIBLE FOR REVIEW OF SITE CONDITIONS TO DEVELOP AN APPROPRIATE WORK PLAN PRIOR TO MOBILIZATION AND CONDUCTING ANY WORK AT THE SITE.
- CONTRACTOR SHALL VERIFY THE CONDITION OF THE EXISTING PIER PRIOR TO APPLYING CONSTRUCTION LOADING AND PERFORMING ANY DEMOLITION WORK.
- THE SITE IS SUBJECT TO PERIODIC FLUCTUATIONS IN WATER LEVELS AS A RESULT OF TIDES AND LARGE PASSING VESSELS IN THE RIVER. CONTRACTOR IS REQUIRED TO EXAMINE THE WORK AREA AND MAKE DETERMINATIONS REGARDING THE EFFECT OF WATER LEVEL FLUCTUATIONS ON ALL CONSTRUCTION WORK ACTIVITIES AND OPERATIONS.
- CONTRACTOR SHALL MAINTAIN TRAFFIC CONTROL IN ACCORDANCE WITH THE ALABAMA STATE PORT REQUIREMENTS USING ADEQUATE BARRICADES, CONSTRUCTION SIGNS, AND GUARDS DURING PROGRESS OF CONSTRUCTION WORK.
- CONTRACTOR SHALL MAINTAIN A TURBIDITY CURTAIN AS INDICATED IN APPENDIX C OF THE PROJECT SPECIFICATIONS.

**B. REFERENCE DOCUMENTS**

- DESIGN AND CONSTRUCTION OF ALL STRUCTURES AND EQUIPMENT SHALL BE IN ACCORDANCE WITH THE DESIGN CODES AND STANDARDS PROVIDED BELOW.

DISCIPLINE	STANDARD/REFERENCE	TITLE
SAFETY	ASPA TECHNICAL SPECIFICATIONS	SECTION 01015- SPECIAL CONDITION AND PRECAUTIONARY MEASURES GOVERNING WORK AT ALABAMA STATE PORT.
	OSHA 29 CFR 1926	SAFETY AND HEALTH REGULATIONS FOR CONSTRUCTION
STRUCTURAL	AISC	AMERICAN INSTITUTE OF STEEL CONSTRUCTION, MANUAL OF STEEL CONSTRUCTION (15TH EDITION)
	ASCE 7-18	MINIMUM DESIGN LOADS FOR BUILDINGS AND OTHER STRUCTURES
	ACI 318-14	BUILDING CODE REQUIREMENTS FOR STRUCTURAL CONCRETE
	ACI 301-10	SPECIFICATIONS FOR STRUCTURAL CONCRETE
	AWS D1.1	STRUCTURAL WELDING CODE, 2015
CIVIL/ ROADWAY	IBC 2018	INTERNATIONAL BUILDING CODE, 2018
	CITY OF MOBILE ZONING AND DEVELOPMENT CODE	
	ALDOT STANDARD SPECS FOR ROAD AND BRIDGE CONSTRUCTION.	ALDOT STANDARD SPECIFICATION 2020
	USDOT / FHWA MUTCD	MANUAL ON UNIFORM TRAFFIC CONTROL DEVICES 2009 EDITION (REV. 2012)
	ALDOT PPM VOL. I	PLANS PREPARATION MANUAL VOL. 1
MARINE	ALABAMA MANUAL FOR DEVELOPING PLANS DESIGNING BEST MANAGEMENT PRACTICES	ALABAMA HANDBOOK FOR EROSION CONTROL, SEDIMENT CONTROL, AND STORM WATER MANAGEMENT ON CONSTRUCTION SITES AND URBAN AREAS, VOL. 1, 2018.
	UFC 4-152-01	DESIGN OF PIERS AND WHARVES, 2015
	UFC 4-151-10	GENERAL CRITERIA FOR WATERFRONT CONSTRUCTION, 2001
	US ARMY CORPS OF ENGINEERS	COASTAL ENGINEERING MANUAL, 2003

**C. PROJECT DATUM**

- STRUCTURE ELEVATIONS WERE OBTAINED FROM A TOPOGRAPHIC SURVEY CONDUCTED BY LAWLER AND COMPANY, DATED 11 SEPT 2018. ALL ELEVATIONS ARE REFERENCED TO NAVD88.

**D. SHOP DRAWINGS**

- CONTRACTOR SHALL SUBMIT SHOP DRAWINGS FOR THE STEEL SHEET PILE WALL TO THE EOR FOR REVIEW PRIOR TO THE PURCHASE OR FABRICATION OF ANY SHEET PILE.
- ADDITIONAL SHOP DRAWING SUBMITTAL REQUIREMENTS ARE IN THE TECHNICAL SPECIFICATIONS.

**E. ENVIRONMENTAL PERMITS**

- ALL CONSTRUCTION SHALL IMPLEMENT AND ABIDE BY ALL REGULATORY AND ENVIRONMENTAL REQUIREMENTS AS SPECIFIED IN THE ENVIRONMENTAL PERMITS SECURED BY THE PORT FOR THE PROJECT.

**F. GEOTECHNICAL INVESTIGATION**

- GEOTECHNICAL INVESTIGATIONS WERE UNDERTAKEN BY GEOTECHNICAL ENGINEERING - TESTING, INC. (GET). THESE INVESTIGATIONS CONSISTED OF DRILLING A SERIES OF ONSHORE BOREHOLES AND TO DEVELOP THE GEOTECHNICAL DESIGN PARAMETERS ASSOCIATED WITH THE SITE PREPARATION AND STRUCTURAL FOUNDATION DESIGN OF PIER B SOUTH. AVAILABLE GEOTECHNICAL INFORMATION IS PROVIDED BY GET IN THEIR FINAL REPORT "ALABAMA STATE PORT AUTHORITY PIER B SOUTH RENOVATION" DATED 3-27-2020.
- THE CONTRACTOR IS RESPONSIBLE FOR FAMILIARIZING THEMSELVES WITH THE SOIL CONDITIONS PRESENT AT THE PROJECT SITE PRIOR TO BIDDING. IT IS THE CONTRACTOR'S RESPONSIBILITY TO DETERMINE AND CONDUCT AT THEIR OWN EXPENSE ANY ADDITIONAL GEOTECHNICAL TESTING BELIEVED TO BE NECESSARY TO BID OR PERFORM THE WORK.

**G. MATERIAL SALVAGE**

- ALL MATERIAL NOT SPECIFICALLY CALLED OUT ON THE PLANS TO BE SALVAGED SHALL BECOME THE PROPERTY OF THE CONTRACTOR AND SHALL BE REMOVED FROM THE SITE.

**H. CLOSEOUT DOCUMENTS**

- THE CONTRACTOR SHALL PROVIDE CLOSEOUT DOCUMENTS, INCLUDING AS-BUILT DRAWINGS AND OPERATIONS AND MAINTENANCE (O&M) MANUALS, AS REQUIRED.

**I. SELECT FILL:**

- REFER TO TECHNICAL SPECIFICATION SECTION 02300 - EARTHWORK

**J. SURVEY NOTES**

- HORIZONTAL SURVEY CONTROL HAS BEEN ESTABLISHED AT THE SITE AS SHOWN USING THE BENCHMARK AND CONTROL POINTS AS SHOWN BELOW AND ON THE SURVEY DRAWING LOCATED IN DIVISION V APPENDIX. ANY MONUMENTS THAT ARE DISTURBED BY CONSTRUCTION OPERATIONS OR AS THE RESULT OF EROSION SHALL BE RESET BY THE CONTRACTOR IN ACCORDANCE WITH RECOGNIZED ENGINEERING AND SURVEYING PRACTICE.

- PROJECT BENCHMARKS ARE AS FOLLOWS:

BENCHMARKS				
ID	NORTHING	EASTING	ELEVATION (NAVD88)	DESCRIPTION
CP-1	258142.756	1797295.174	8.749 FT	X ON ELECTRICAL MANHOLE
CP-3	258181.418	1797516.166	9.996 FT	X ON DRAIN GRATE
CP-4	257731.999	1797574.584	9.851 FT	X ON STEEL RAIL
BM-1	257474.390	1798886.580	10.030 FT	BENCHMARK AT EAST END OF PIER B

**K. TEMPORARY OPERATIONS**

- WORK AT THE PIER B SOUTH TERMINAL MUST BE COORDINATED TO ALLOW CONTINUOUS BERTHING OF CARGO VESSELS ON THE OPPOSITE SIDE OF THE SLIP (PIER A), AND ONE (1) TUGBOAT TO MOOR AT THE WEST END OF THE SLIP ON PIER B.
- THE TUGBOAT BERTHING AREA SHOWN ON THE OVERALL SITE PLAN MUST REMAIN ACCESSIBLE FOR TUGBOAT MOORING AND BERTHING. IF THE CONTRACTOR NEEDS TO TEMPORARILY USE SUCH AREA FOR CONSTRUCTION ACTIVITIES, THEY SHALL COORDINATE WITH AND OBTAIN APPROVAL FROM THE PORT FOR THE TEMPORARY RELOCATION OF THE TUGBOAT BERTHING AND MOORING AREA TO A DIFFERENT LOCATION WITHIN PIER B.

**L. ABBREVIATIONS INDEX**

AB	ANCHOR BOLT	LSH	LONG SLOTTED HOLES
APPROX	APPROXIMATE OR APPROXIMATELY	MAX	MAXIMUM
AWS	AMERICAN WELDING SOCIETY	MD	MOORING DOLPHIN
B/	BOTTOM OF	MISC	MISCELLANEOUS
BC	BOLT CIRCLE	MIN	MINIMUM
BD	BREASTING DOLPHIN	NIC	NOT IN CONTRACT
B/F	BACK FACE	NTS	NOT TO SCALE
BM	BEAM	OC	ON CENTER
BOT	BOTTOM	OD	OUTSIDE DIAMETER
B.O.	BOTTOM OF	O/F	OUTSIDE FACE
BOS	BOTTOM OF STEEL	OPP	OPPOSITE
C/C	CENTER TO CENTER	PL OR PL	PLATE
CL OR CL	CENTERLINE	PT	PRESSURE TREATED
CLR	CLEAR	RAD	RADIUS
COL	COLUMN	R/C	REINFORCED CONCRETE
CONC	CONCRETE	REF	REFERENCE
CONN	CONNECTION	REINF	REINFORCEMENT OR REINFORCING
CONST	CONSTRUCTION	REQD	REQUIRED
CONT	CONTINUOUS	SC	SLIP CRITICAL
CP	CONTROL POINT	SIM	SIMILAR
CTRD	CENTERED	S/T	SNUG TIGHTEN
DET	DETAIL	SPA	SPACE OR SPACES
DIA OR Ø	DIAMETER	SPCD	SPACED
DWG	DRAWING	SPCG	SPACING
EA	EACH	SPEC	SPECIFICATION
EF	EACH FACE	SSH	SHORT SLOTTED HOLES
EL:	ELEVATION (HEIGHT)	STD	STANDARD
ELEV	ELEVATION (VIEW)	STIFF	STIFFENER
EOR	ENGINEER OF RECORD	STL	STEEL
EQ	EQUAL OR EQUALLY	SUPT	SUPPORT
EQIP	EQUIPMENT	SYMM	SYMMETRICAL
EW	EACH WAY	THK	THICK OR THICKNESS
EWEF	EACH WAY, EACH FACE	T/	TOP OF
EX	EXISTING	TYP	TYPICAL
EXIST	EXISTING	UON	UNLESS OTHERWISE NOTED
EXP	EXPANSION	USACE	U.S. ARMY CORPS OF ENGINEERS
F/	FACE OF	VERT	VERTICAL
GALV	GALVANIZED	w/	WITH
GEN	GENERAL	WO	WITHOUT
HB	HIGH STRENGTH BOLLARD	WP	WORKING POINT
HORIZ	HORIZONTAL		
HSB	HIGH STRENGTH BOLT		
ID	INSIDE DIAMETER		
INCL	INCLUDING		
JT	JOINT		
LOC	LOCATION		
LG	LONG		

**M. SYMBOL LEGEND**

-----	PROPERTY LINE
- - - - -	PROJECT BOUNDARY LINE
⊕	WORK POINT

GENERAL

PIER B SOUTH

397324

7/28/2023 9:22:25 AM



Mott MacDonald  
107 St. Francis Street  
Suite 2900  
Mobile, Alabama 36602  
United States of America  
Telephone: (251) 343-4366  
www.mottmac.com/americas


Client  
**ALABAMA STATE PORT AUTHORITY**

MOBILE, ALABAMA

**LOWRY J. DENTY, P.E.**

24892 ALABAMA - CERTIFICATION NUMBER

AS-BUILT RECORD

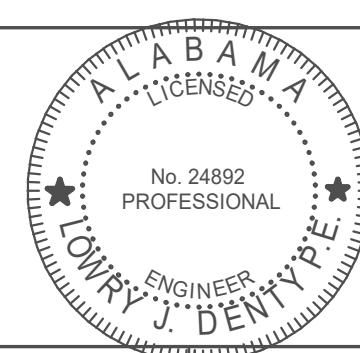

Project Number

**397324**

B/O

Total

Designed	JQ		Eng Check	KP	
Drawn	KWD	MC	Coordination	LJD	
Dwg Check	CEL		Approved	BP	
Scale at ANSI D	Status	Rev	Security		
None	IFC	1	STD		
Drawing Number	<b>GA-03</b>				

Title  
**PIER B SOUTH**  
**GENERAL NOTES AND ABBREVIATIONS**

AS-BUILT INFORMATION SHOWN ON THIS DRAWING HAS BEEN OBSERVED AND SUPPLIED BY THE CONTRACTOR. MOTT MACDONALD DOES NOT ATTEST TO THE ACCURACY OF THE CONTRACTOR'S MARK-UPS, BUT SIGNIFICANT FIELD CHANGES SHOWN ON THE DRAWINGS WERE VERIFIED BY MOTT MACDONALD FOR CONFORMANCE WITH THE ORIGINAL DESIGN INTENT.



**1** OVERALL SITE PLAN  
1" = 200'-0"

**LEGEND**

- LIMITS OF EXISTING WAREHOUSE BUILDING
- LIMITS OF EXISTING RELIEVING PLATFORM
- LIMITS OF EXISTING SLAB ON GRADE
- LIMITS OF EXISTING PIER B SOUTH
- TUG BOAT BERTHING AREA
- PROJECT LIMITS

AS-BUILT INFORMATION SHOWN ON THIS DRAWING HAS BEEN OBSERVED AND SUPPLIED BY THE CONTRACTOR. MOTT MACDONALD DOES NOT ATTEST TO THE ACCURACY OF THE CONTRACTOR'S MARK-UPS, BUT SIGNIFICANT FIELD CHANGES SHOWN ON THE DRAWINGS WERE VERIFIED BY MOTT MACDONALD FOR CONFORMANCE WITH THE ORIGINAL DESIGN INTENT.




Mott MacDonald  
107 St. Francis Street  
Suite 2900  
Mobile, Alabama 36602  
United States of America  
Telephone: (251) 343-4366  
www.mottmac.com/americas

Client  
**ALABAMA STATE  
PORT AUTHORITY**  
  
MOBILE, ALABAMA

Rev	Date	Drawn	Description	Ch'k'd	App'd
2	07-27-23	KWD	AS-BUILT RECORD DRAWINGS	CEL	LJD
1	05-18-22	KWD	ADD 1 ISSUED FOR CONST	CEL	LJD
0	01-14-22	KWD	ISSUED FOR BID	CEL	LJD

**LOWRY J. DENTY, P.E.**  
24892 ALABAMA - CERTIFICATION NUMBER

**AS-BUILT  
RECORD**

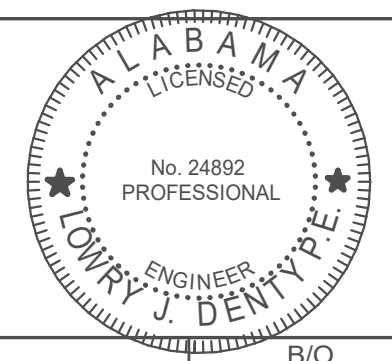

Project Number **397324** B/O Total

Designed	JQ	Eng Check	KP
Drawn	KWD	Coordination	LJD
Dwg Check	CEL	Approved	BP
Scale at ANSI D As Shown	Status IFC	Rev 1	Security STD
Drawing Number		<b>GA-04</b>	

Title  
**PIER B SOUTH  
OVERALL SITE PLAN**

GENERAL

PIER B SOUTH

397324

7/28/2023 10:12:10 AM

GENERAL

PIER B SOUTH

397324

7/28/2023 9:22:32 AM

A. GENERAL

- PROPERTY OBSTRUCTIONS WHICH ARE TO REMAIN IN PLACE, SUCH AS BUILDINGS, SEWERS DRAINS, WATER OR GAS PIPES, CONDUITS, CABLES, POLES, WALLS, POSTS, ETC. ARE TO BE CAREFULLY PROTECTED. CONTRACTOR SHALL NOTIFY ENGINEER PRIOR TO REMOVING ANY OBSTRUCTIONS NOT SPECIFICALLY NOTED ON THE PLANS.
- THE CONTRACTOR IS RESPONSIBLE FOR DEMOLITION PLANNING AND EXECUTION IN A SAFE MANNER.
- IT IS RECOGNIZED THAT THE PROJECT CANNOT BE COMPLETED WITHOUT IMPACTING THE PIER DECK. THE PIER FOOTPRINT AND PERIMETER AREAS TO BE DISTURBED DURING THE DEMOLITION SHALL BE SUBJECT TO A PRE AND POST CONSTRUCTION INSPECTION TO ENSURE THAT ALL STRUCTURES TO REMAIN WERE NOT DAMAGED DURING THE EXECUTION OF THE PROJECT, AS REQUIRED.
- CONTRACTOR IS TO BECOME FAMILIAR WITH THE EXISTING PIER PRIOR TO COMMENCING DEMOLITION. CONTRACTOR SHALL PREPARE A WRITTEN DEMOLITION PLAN AND SUBMIT TO EOR. PLAN SHALL DETAIL THE METHODOLOGY AND SEQUENCE OF DEMOLITION. ALL WORK SHALL BE PERFORMED IN SUCH A MANNER AS TO ENSURE JOB SITE & HUMAN SAFETY.
- THE CONTRACTOR SHALL TAKE ALL NECESSARY PRECAUTIONS TO STRICTLY CONTAIN THE DEMOLITION WITHIN THE LIMITS OF THE REQUIRED WORK ZONE AND AVOID ANY DAMAGE TO EXISTING STRUCTURES AND UTILITY LINES THAT ARE TO REMAIN.
- ANY DAMAGE INCURRED IN EXECUTION OF THIS CONTRACT TO ANY PART OF THE PROPERTY AND/OR STRUCTURE NOT SPECIFICALLY DESIGNATED FOR DEMOLITION SHALL BE REPAIRED BY CONTRACTOR AT NO ADDITIONAL COST TO THE OWNER.
- THE CONTRACTOR SHALL USE METHODS/PROCEDURES DEEMED APPROPRIATE FOR DEMOLITION OF STRUCTURE SHOWN. DEMOLITION BY EXPLOSIVES IS PROHIBITED.
- THE CONTRACTOR SHALL PLACE DEBRIS CONTROL DEVICES, STAGING, AND OTHER DEVICES AS NECESSARY TO PREVENT DEBRIS, AND AIRBORNE MATERIALS FROM LEAVING THE WORK ZONE. WATER SPRAY AND OTHER APPROPRIATE METHODS SHALL BE USED AT ALL TIMES. THE CONTRACTOR SHALL BE RESPONSIBLE FOR CLEAN-UP OF ANY MATERIALS DEPOSITED OUTSIDE THE WORK AREA.
- NO CONCRETE CRUSHING ALLOWED ON SITE.
- THE CONTRACTOR IS RESPONSIBLE FOR THE DEMOLITION OF ALL EXISTING STRUCTURES AS DEFINED IN THE DRAWINGS.
- THE CONTRACTOR SHALL DEMOLISH EXISTING WOOD BULKHEAD ONLY AS REQUIRED FOR CONSTRUCTION OF THE NEW BULKHEAD AND CONCRETE CAP. REFER TO DEMOLITION DRAWINGS FOR ADDITIONAL INFORMATION REGARDING DEMOLITION EXTENTS.
- ALL MATERIALS DEMOLISHED, REMOVED AND/OR DISCARDED SHALL BE REMOVED FROM THE PROJECT SITE TO AN APPROVED DISPOSAL FACILITY.
- DEMOLITION AND REMOVAL WORK SHALL PROCEED IN A MANNER THAT PREVENTS COLLAPSE OR DAMAGE TO THE EXISTING STRUCTURES THAT ARE DESIGNATED TO REMAIN. THE RELEASE OF CONSTRUCTION DEBRIS INTO THE WATERWAY IS PROHIBITED.

B. SITE ACCESS AND LOGISTICS

- SCHEDULE FOR ALL CONSTRUCTION ACTIVITIES SHALL BE COORDINATED WITH THE ALABAMA STATE PORT SO AS TO MINIMIZE IMPACT TO ALABAMA STATE PORT ACTIVITIES.
- THE CONTRACTOR SHALL ABIDE AND ENFORCE ACCESS REGULATIONS AND REQUIREMENTS TO THE PIER DURING CONSTRUCTION.
- PARKING AND LAYDOWN AREAS SHALL BE COORDINATED WITH THE ALABAMA STATE PORT PRIOR TO MOBILIZATION.
- APPLICATION OF TEMPORARY AND PERMANENT EROSION CONTROL MEASURES FOR THE PROJECT SHALL BE IN ACCORDANCE WITH PROCEDURES AND SPECIFICATIONS OF THE CURRENT ALABAMA EROSION AND SEDIMENT CONTROL HANDBOOK FOR CONSTRUCTION BEST MANAGEMENT PRACTICES.
- THE CONTRACTOR SHALL BE RESPONSIBLE FOR MAINTAINING EROSION CONTROL MEASURES DURING CONSTRUCTION.
- ALL PAVED AREAS DISTURBED SHALL BE PATCHED WITH 5,500 PSI CONCRETE UNLESS OTHERWISE SPECIFIED.

C. UTILITIES

- TEMPORARY DISRUPTION TO THE EXISTING UTILITIES ARE REQUIRED FOR NEW CONSTRUCTION. COORDINATE SCHEDULED OUTAGES WITH ASPA AND EOR 72 HOURS PRIOR TO PERFORMING WORK. TIME OF OUTAGES SHALL BE PRE-APPROVED BY THE OWNER AND SHALL MINIMIZE DISRUPTION OF ASPA'S DAILY OPERATIONS.
- TEMPORARY ELECTRIC SERVICE, AS REQUIRED DURING THE DURATION OF CONSTRUCTION, IS THE RESPONSIBILITY OF THE CONTRACTOR.
- THE CONTRACTOR SHALL NOT MAKE ANY OPENING OR EXCAVATION WITHIN THE PROJECT AREA UNTIL CONTACT HAS BEEN MADE WITH 'DIG SAFE' AND ALL UTILITIES TO LOCATE ANY EXISTING POWER, TELEPHONE, CABLE TV, WATER OR OTHER UNDERGROUND SERVICES.
- THE UTILITY LOCATIONS SHOWN ON THE DRAWINGS ARE APPROXIMATE AND ARE PROVIDED AS A GUIDE TO THE CONTRACTOR. NO GUARANTEE IS MADE THAT UTILITIES WILL BE ENCOUNTERED WHERE SHOWN OR THAT ALL UTILITIES ARE SHOWN. THE CONTRACTOR SHALL VERIFY ALL LOCATIONS IN THE FIELD AND BE RESPONSIBLE FOR REPAIR OF UTILITIES DISTURBED DURING CONSTRUCTION.
- ANY DAMAGE TO EXISTING UTILITIES CAUSED BY THE EXECUTION OF WORK UNDER THIS CONTRACT SHALL BE REPAIRED BY THE CONTRACTOR AT NO ADDITIONAL EXPENSE TO THE OWNER OR INCREASE TO CONTRACT TIME. THE OWNER DOES NOT ASSUME OR IMPLY TO ANY LIABILITY FOR THE LOCATION, PROTECTION, AND/OR REPAIR OF ANY EXISTING UTILITIES THAT MAY OCCUPY JOINT RIGHT-OF-WAY OR OTHERWISE CONFLICT WITH THE DEMOLITION TO BE PERFORMED UNDER THIS CONTRACT.

D. MATERIAL DISPOSAL

- NO ADDITIONAL PAYMENT WILL BE MADE TO THE CONTRACTOR FOR COSTS ASSOCIATED WITH MATERIAL DISPOSAL.
- THE CONTRACTOR IS RESPONSIBLE FOR LEGAL DISPOSAL OF ALL CONSTRUCTION DEBRIS AT AN APPROVED FACILITY IN ACCORDANCE WITH ALL APPLICABLE LOCAL STATE AND FEDERAL REGULATORY REQUIREMENTS.
- IT SHALL BE THE RESPONSIBILITY OF THE CONTRACTOR TO FAMILIARIZE HIMSELF WITH THE MATERIALS TO BE DISPOSED OF AND ALL GOVERNING AGENCY REQUIREMENTS.
- THE CONTRACTOR IS RESPONSIBLE FOR DEMOLITION AND REMOVAL OF ALL EXISTING PIER COMPONENTS FROM THE SITE THAT ARE NOT SPECIFIED FOR REUSE OR SELECTED FOR RETAINAGE BY THE OWNER.
- ALL DEBRIS SHALL BE SEPARATED AND DISPOSED OF IN A MANNER CONSISTENT WITH THE ALABAMA DEPARTMENT OF ENVIRONMENTAL MANAGEMENT (ADEM) SOLID WASTE FACILITY DISPOSAL GUIDELINES. DISPOSAL SITE OR LANDFILL USED FOR DISPOSITION OF MATERIAL SHALL BE AUTHORIZED BY ADEM AND SHALL HAVE A MOBILE COUNTY SOLID WASTE MANAGEMENT PERMIT IF DISPOSING IN MOBILE COUNTY.
- CONTRACTOR SHALL BE RESPONSIBLE FOR ENSURING STAGING AND DISPOSAL OF DEBRIS FOLLOWING THESE GUIDELINES AND AS OTHERWISE SPECIFIED.
- THE CONTRACTOR SHALL PROVIDE THE FOLLOWING DEBRIS DISPOSAL INFORMATION PRIOR TO START OF WORK:

FACILITY NAME  
 ADDRESS OF FACILITY  
 ADEM PERMIT NUMBER  
 COUNTY PERMIT NUMBER  
 LANDFILL TICKET FOR EACH LOAD

E. ADJACENT BUILDING MONITORING

- CONTRACTOR SHALL BE RESPONSIBLE FOR MONITORING OF ON-SITE, ADJACENT WAREHOUSE AND STRUCTURES LOCATED WITHIN 500 FEET FOR SETTLEMENT AND DAMAGE AS APPLICABLE WITHIN THE LIMITS SPECIFIED HEREIN, AND NOTIFY THE EOR AND PORT OF ANY OBSERVED SETTLEMENT OR DISPLACEMENT.
- CONTRACTOR SHALL NOT DEVIATE FROM RECOMMENDATIONS FOR METHODOLOGY NOTED ON THESE PLANS, ALDOT STANDARDS, AS WELL AS VIBRATION MONITORING PLAN TO BE SUBMITTED BY THE CONTRACTOR AS PART OF THE DEMOLITION REQUIREMENTS.
- CONTRACTOR'S RETAINED TESTING AGENCY SHALL OVERSEE AND APPROVE THE IMPLEMENTATION OF THE MONITORING METHODOLOGY AND PROCESSES.
- SHOULD ANY MOVEMENT OR DAMAGE BE DETECTED, THE CONTRACTOR SHALL CEASE DEMOLITION AND RELATED ACTIVITIES AND IMMEDIATELY NOTIFY THE PORT AND ENGINEER. THE CONTRACTOR SHALL SUBMIT TO THE ENGINEER FOR APPROVAL METHODS FOR MITIGATION OF NOTED MOVEMENT BEFORE RESUMING ACTIVITIES.
- ALL FACILITIES AND STRUCTURES DAMAGED DURING DEMOLITION SHALL BE RESTORED TO THEIR ORIGINAL DOCUMENTED CONDITION AND TO THE REASONABLE SATISFACTION OF THE AFFECTED PROPERTY OWNER AT THE CONTRACTOR'S SOLE EXPENSE.

F. EXISTING REFERENCE DOCUMENTS

- REFER TO EXISTING DRAWINGS LISTED BELOW FOR SIZES, MATERIAL AND TYPE OF CONSTRUCTION PRIOR TO BIDDING AND DEMOLITION.
  - ALABAMA STATE DOCKS COMMISSION, CONCRETE WHARF PIER NO. 2, DATED 1925.
  - ALABAMA STATE DOCKS DEPARTMENT, PIER "B" SOUTH WAREHOUSE REHABILITATION PILE SUPPORTED RELIEVING PLATFORM, DATED 1987.
  - ALABAMA STATE PORT AUTHORITY, PIER B SURVEY DATED SEPTEMBER 11, 2018.

AS-BUILT INFORMATION SHOWN ON THIS DRAWING HAS BEEN OBSERVED AND SUPPLIED BY THE CONTRACTOR. MOTT MACDONALD DOES NOT ATTEST TO THE ACCURACY OF THE CONTRACTOR'S MARK-UPS, BUT SIGNIFICANT FIELD CHANGES SHOWN ON THE DRAWINGS WERE VERIFIED BY MOTT MACDONALD FOR CONFORMANCE WITH THE ORIGINAL DESIGN INTENT.



Mott MacDonald  
 107 St. Francis Street  
 Suite 2900  
 Mobile, Alabama 36602  
 United States of America  
 Telephone: (251) 343-4366  
 www.mottmac.com/americas

Client


**ALABAMA STATE PORT AUTHORITY**

MOBILE, ALABAMA

Rev	Date	Drawn	Description	Ch'k'd	App'd
2	07-27-23	KWD	AS-BUILT RECORD DRAWINGS	CEL	LJD
1	05-18-22	KWD	ADD 1 ISSUED FOR CONST	CEL	LJD
0	01-14-22	KWD	ISSUED FOR BID	CEL	LJD

**LOWRY J. DENTY, P.E.**  
 24892 ALABAMA - CERTIFICATION NUMBER

**AS-BUILT RECORD**

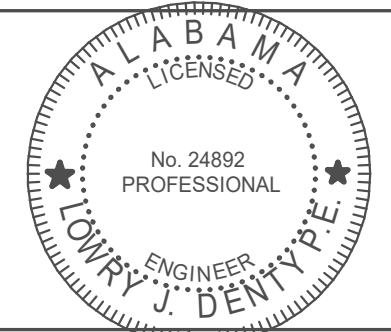

Project Number **397324**

B/O Total

Designed	JQ	Eng Check	KP
Drawn	KWD MC	Coordination	LJD
Dwg Check	CEL	Approved	BP
Scale at ANSI D	Status	Rev	Security
None	IFC	1	STD
Drawing Number <b>GA-05</b>			

Title

**PIER B SOUTH**

**GENERAL DEMOLITION NOTES**

**A. DESIGN CRITERIA**

**SITE ELEVATIONS**

- THE FOLLOWING TIDE LEVELS ARE REFERENCED TO NAVD88 FROM NOAA STATION - MOBILE STATE DOCKS, AL-STATION ID 8737048.
- STRUCTURE ELEVATIONS WERE OBTAINED FROM THE TOPOGRAPHIC SURVEY CONDUCTED BY LAWLER AND COMPANY, DATED 11 SEPT 2018. ALL ELEVATIONS ARE REFERENCED TO NAVD88.

**B. DESIGN LOADS**

**1. TARGET DESIGN LIFE:**

ELEMENT	TARGET DESIGN LIFE, YEARS	MAINTENANCE INTERVAL, YEARS
MARINE STRUCTURES - STRUCTURAL STEEL	75	15
MARINE STRUCTURES - STRUCTURAL CONCRETE	75	15
MARINE COATING SYSTEM	30	15 (OR AS REQUIRED)

**2. DEAD LOADS**

MATERIAL	UNIT WEIGHT (PCF)
STEEL OR CAST STEEL	490
CAST IRON	450
ALUMINUM ALLOYS	175
TIMBER (UNTREATED)	45-50
TIMBER (TREATED)	45-60
CONCRETE REINFORCED (NORMAL WEIGHT)	145-160
CONCRETE REINFORCED (LIGHTWEIGHT)	90-120

**3. LIVE LOADS**

COMPONENT	DESIGN LIVE LOAD
SURCHARGE ON BULKHEAD PARALLEL TO BENT 1	1000 PSF
SURCHARGE ON BULKHEAD (EX BENT 1 TO 6B)	0 PSF
EXISTING RELIEVING PLATFORM	500 PSF

**4. EARTHQUAKE LOADS (PER AASHTO)**

ITEM	DESCRIPTION
SITE CLASS	D
PEAK GROUND ACCELERATION	0.07
HORIZONTAL RESPONSE	0.033
SITE FACTOR AT ZERO-PERIOD RANGE	1.6
SITE FACTOR (SHORT PERIOD)	1.6
SITE FACTOR (LONG PERIOD)	2.4
SEISMIC DESIGN CATEGORY	A
RISK CATEGORY	III
RISK TARGETED MAXIMUM CONSIDERED EARTHQUAKE	0.103
RISK TARGETED MINIMUM CONSIDERED EARTHQUAKE	0.058
RESPONSE MODIFICATION FACTOR	3
IMPORTANCE FACTOR	1.0

**C. PROJECT DATUM**

TIDE RANGE	NAVD 88 ELEVATION
WATER CONDITION	NAVD 88 ELEVATION
MEAN LOWER LOW WATER ELEVATION	-0.41'
MEAN HIGHER HIGH WATER	1.16'
MEAN SEA LEVEL	-0.33'
MEAN LOW WATER	-0.40'
HIGHEST ASTRONOMICAL TIDE	1.87'
LOWEST ASTRONOMICAL TIDE	-1.70'
EXIST. TOP OF WALL ELEVATION	+10.0'

**D. SHEET PILING**

- STRUCTURAL STEEL ELEMENTS SHALL CONFORM TO THE SPECIFICATIONS AND GRADES AS FOLLOWS:

SHEET PILES	ASTM A572 GR. 60
-------------	------------------

- UPON COMPLETION OF THE PILE INSTALLATION, INSPECTION, AND APPROVAL, THE PILE SHALL BE NEATLY CUT ON PLANE NORMAL TO THE AXIS OF THE PILE AT THE ELEVATION SPECIFIED ON THE DRAWINGS.
- AXIAL ALIGNMENT OF THE PILES AND SHEET PILES SHALL NOT DEVIATE BY MORE THAN ¼ INCHES PER FOOT FROM THE VERTICAL. PULLING PILES INTO POSITION SHALL NOT BE PERMITTED WITHOUT PRIOR REVIEW AND APPROVAL BY THE DESIGN ENGINEER.
- JETTING OF PILES FOR INSTALLATION SHALL NOT BE PERMITTED.
- THE CONTRACTOR SHALL ANTICIPATE THE NEED TO UTILIZE CAST IRON POINTS OR DRIVING SHOES TO PENETRATE DENSE FOUNDATION MATERIAL WITHOUT CAUSING DAMAGE TO THE PILE TIP WERE USED, PILE POINTS AND SHOES SHALL CONFORM TO THE REQUIREMENTS OF ASTM A148 AND SHALL BE MANUFACTURED BY SKYLINE OR APPROVED EQUAL.
- TOLERANCES:

- FINAL POSITIONS OF SHEET PILES AT CUTOFF SHALL NOT DEVIATE MORE THAN TWO (2) INCHES LATERALLY FROM THE LOCATIONS SHOWN ON THE CONTRACT DRAWINGS.
- THE FINAL CUTOFF ELEVATIONS SHALL NOT DEVIATE MORE THAN 2 INCHES ABOVE, OR MORE THAN 3-1/2 INCHES BELOW, THE ELEVATIONS SHOWN ON THE CONTRACT DRAWINGS. IN NO CASE SHALL THE SHEET PILE BE EMBEDDED LESS THAN 18" INTO THE PILE CAP.

- PROPOSED SHEET PILE RETAINING WALL HAS BEEN DESIGNED TAKING INTO CONSIDERATION THE EXISTING SOIL SLOPE LOCATED TO THE SOUTHWEST OF THE WALL. THEREFORE, THE SLOPE PROFILE SHOWN ON THE DRAWINGS SHALL BE MAINTAINED AND NOT MODIFIED OR AFFECTED BY FUTURE BERTH DREDGING OR PIER IMPROVEMENTS.

- ALL SHEET PILES:  
ZZ SECTIONS CAN BE USED IN LIEU OF AZ SECTIONS OF SAME SIZE AND GRADE.

**E. REINFORCED CONCRETE**

- ALL CONCRETE WORK SHALL CONFORM TO ACI 301, "SPECIFICATIONS FOR STRUCTURAL CONCRETE FOR BUILDINGS" AND ACI 318, "BUILDING CODE REQUIREMENTS FOR REINFORCED CONCRETE" FOR EXPOSURE CATEGORIES AND CLASSES F2, S1, W1, AND C2 AS DEFINED IN CHAPTER 19. THE CONCRETE MIX DESIGNS SHALL BE SUBMITTED TO THE ENGINEER FOR REVIEW A MINIMUM OF TWO WEEKS PRIOR TO CASTING CONCRETE.
- ALL CONCRETE SHALL HAVE A MINIMUM COMPRESSIVE STRENGTH OF 5,000 PSI AT 28 DAYS.
- CHAMFER ALL EXPOSED EXTERNAL CORNERS OF CONCRETE WITH 45 DEGREE CHAMFER, 1 IN., UNLESS OTHERWISE NOTED.
- REINFORCING BARS SHALL CONFORM TO ASTM 615, GRADE 60.
- CONCRETE COVER OVER REINFORCEMENT AND TIES, UNLESS OTHERWISE NOTED, SHALL BE 4 INCHES FOR BULKHEAD, AND SHALL MEET THE REQUIREMENTS OF THE TECHNICAL SPECIFICATIONS.
- ALL REINFORCEMENT SPLICES SHALL BE ACI CLASS B SPLICES UNLESS OTHERWISE NOTED ON DRAWINGS.
- ALL REINFORCING BAR HOOKS SHALL BE ACI "STANDARD HOOKS" AND SHALL MEET THE MINIMUM BEND DIAMETER REQUIREMENTS OF ACI 318.
- ALL FORM WORK SHALL REMAIN UNDISTURBED UNTIL CONCRETE HAS REACHED 70% OF ITS MINIMUM REQUIRED COMPRESSIVE STRENGTH.
- CONCRETE FINISHES SHALL BE PER ACI 301-10 AND AS NOTED BELOW:
  - EXPOSED FACES OF BULKHEAD TO PUBLIC VIEW - SURFACE FINISH 3
  - NON-EXPOSED FACES OF BULKHEAD TO PUBLIC VIEW - SURFACE FINISH 2
  - TOP SURFACE OF NEW RELIEVING PLATFORM SECTIONS - BROOM FINISH
- MEDIUM TO COARSE TEXTURED BROOM FINISH SHALL CONSIST OF 1/16 TO 1/8 OF AN INCH DEEP BROOM STRIATIONS CREATED WITH STIFF-BRISTLED BROOM AND PERPENDICULAR TO THE LINE OF TRAFFIC.
- ALL CONSTRUCTION JOINTS SHALL BE THOROUGHLY CLEANED AND FREE OF LAITANCE.
- CONCRETE WORK SHALL BE CURED IN ACCORDANCE WITH STANDARD ACCEPTED PRACTICE AND AS SPECIFIED IN TECHNICAL SPECIFICATION SECTION 03300 - CAST IN PLACE CONCRETE.

**F. TEMPORARY EXCAVATION AND SHORING**

- THE CONTRACTOR SHALL BE RESPONSIBLE FOR THE DESIGN AND ADEQUACY OF ANY REQUIRED TEMPORARY SHORING SYSTEMS AND TEMPORARY EXCAVATION SLOPES IN ACCORDANCE WITH OCCUPATIONAL SAFETY AND HEALTH ADMINISTRATION (OSHA) REQUIREMENTS FOR THE EXCAVATION AREAS DURING THE INSTALLATION OF PROJECT MATERIALS PRIOR TO BACKFILLING AND CONTRACTOR'S GEOTECHNICAL ENGINEER RECOMMENDATIONS.

**G. COATINGS**

- STRUCTURAL STEEL COATING SHALL MEET THE REQUIREMENTS OF TECHNICAL SPECIFICATION SECTION 09 96 26 - MARINE COATINGS. THE SELECTED COATING MATERIAL SHALL BE LISTED ON THE ALDOT APPROVED PRODUCT LIST.
- STEEL SHEET PILES SHALL BE COATED PER THE REQUIREMENTS OF TECHNICAL SPECIFICATIONS 09 96 26 MARINE COATINGS AND 31 41 16 STEEL SHEET PILE.
- ALL STEEL SURFACES TO BE COATED SHALL BE PREPARED IN ACCORDANCE WITH SSPC-SP10, NEAR-WHITE BLAST CLEANING.
- ALL COATING DAMAGE SHALL BE TOUCHED UP. COATING SHALL BE CONSIDERED DAMAGED WITHIN TWO (2) INCHES OF ANY FIELD WELD AND SHALL BE GRINDED AND RECOATED EVEN IF NO DAMAGE IS APPARENT.

**CEMENT MORTAR FLOWABLE BACKFILL (NOT USED)**

- FLOWABLE FILL SHALL BE EXCAVATABLE AND COMPLY WITH THE PROPORTIONS AND PROPERTIES OF MIX DESIGNATION 2 FROM ALDOT SPECIFICATION SECTION 260 - CEMENT MORTAR FLOWABLE BACKFILL.
- THE FRESHLY PLACED MORTAR SHALL REMAIN UNDISTURBED BY CONSTRUCTION ACTIVITIES FOR A TIME PERIOD OF 16 HOURS.
- DURING MIXING OPERATION - THE SAND, FLYASH AND CEMENT SHALL BE INTRODUCED IN THAT ORDER.
- NO MORTAR SHALL BE PLACED WHEN THE AMBIENT TEMPERATURE IS BELOW 40 F.

**I. EPOXY ANCHORING**

- EPOXY ANCHORING OF REINFORCEMENT BARS, BOWELS, AND BOLTS INTO CONCRETE SHALL BE MADE WITH HILTI HIT-RE500 V3 OR APPROVED EQUAL. INSTALLATION SHALL BE ACCORDING TO MANUFACTURER'S WRITTEN RECOMMENDATIONS.

**J. GEOFOAM**

- GEOFOAM SHALL BE EPS29 MEETING ASTM D6817 WITH A MINIMUM COMPRESSIVE RESISTANCE OF 1570 PSF AT 1% DEFORMATION.

**K. VIBRATIONS ON FRESHLY PLACED CONCRETE**


- ENSURE THAT FRESHLY PLACED CONCRETE IS NOT SUBJECT TO VIBRATIONS GREATER THAN 1.5 INCHES PER SECOND FROM PILE DRIVING / VIBRATING SOURCES LOCATED WITHIN 30 FEET (FROM THE NEAREST OUTSIDE EDGE OF FRESHLY PLACED CONCRETE TO THE VIBRATION SOURCE) UNTIL THAT CONCRETE HAS ATTAINED ITS FINAL SET AS DEFINED BY ASTM

GENERAL

PIER B SOUTH

397324

7/28/2023 9:22:33 AM

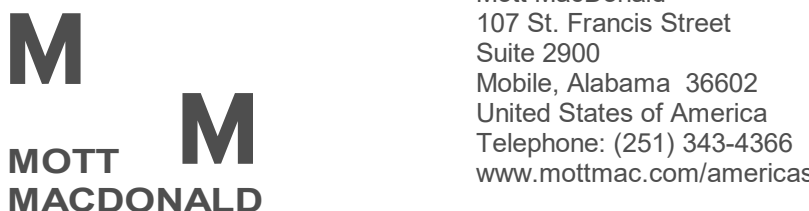


Mott MacDonald  
107 St. Francis Street  
Suite 2900  
Mobile, Alabama 36602  
United States of America  
Telephone: (251) 343-4366  
www.mottmac.com/america

Client  
**ALABAMA STATE PORT AUTHORITY**  
  
MOBILE, ALABAMA

Rev	Date	Drawn	Description	Ch'kd	App'd
2	07-27-23	KWD	AS-BUILT RECORD DRAWINGS	CEL	LJD
1	05-18-22	KWD	ADD 1 ISSUED FOR CONST	CEL	LJD
0	01-14-22	KWD	ISSUED FOR BID	CEL	LJD

**LOWRY J. DENTY, P.E.**  
24892 ALABAMA - CERTIFICATION NUMBER  
  
**AS-BUILT RECORD**  
  
Project Number **397324**

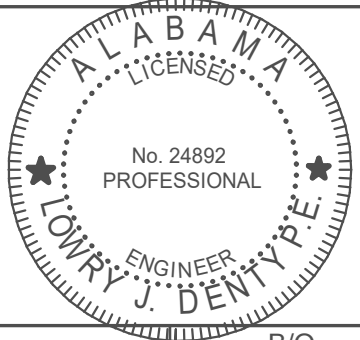

Designed	JQ	Eng Check	KP
Drawn	KWD MC	Coordination	LJD
Dwg Check	CEL	Approved	BP
Scale at ANSI D	Status	Rev	Security
None	IFC	1	STD
Drawing Number <b>GA-06</b>			



Title  
**PIER B SOUTH**  
  
**GENERAL MARINE NOTES**

AS-BUILT INFORMATION SHOWN ON THIS DRAWING HAS BEEN OBSERVED AND SUPPLIED BY THE CONTRACTOR. MOTT MACDONALD DOES NOT ATTEST TO THE ACCURACY OF THE CONTRACTOR'S MARK-UPS, BUT SIGNIFICANT FIELD CHANGES SHOWN ON THE DRAWINGS WERE VERIFIED BY MOTT MACDONALD FOR CONFORMANCE WITH THE ORIGINAL DESIGN INTENT.








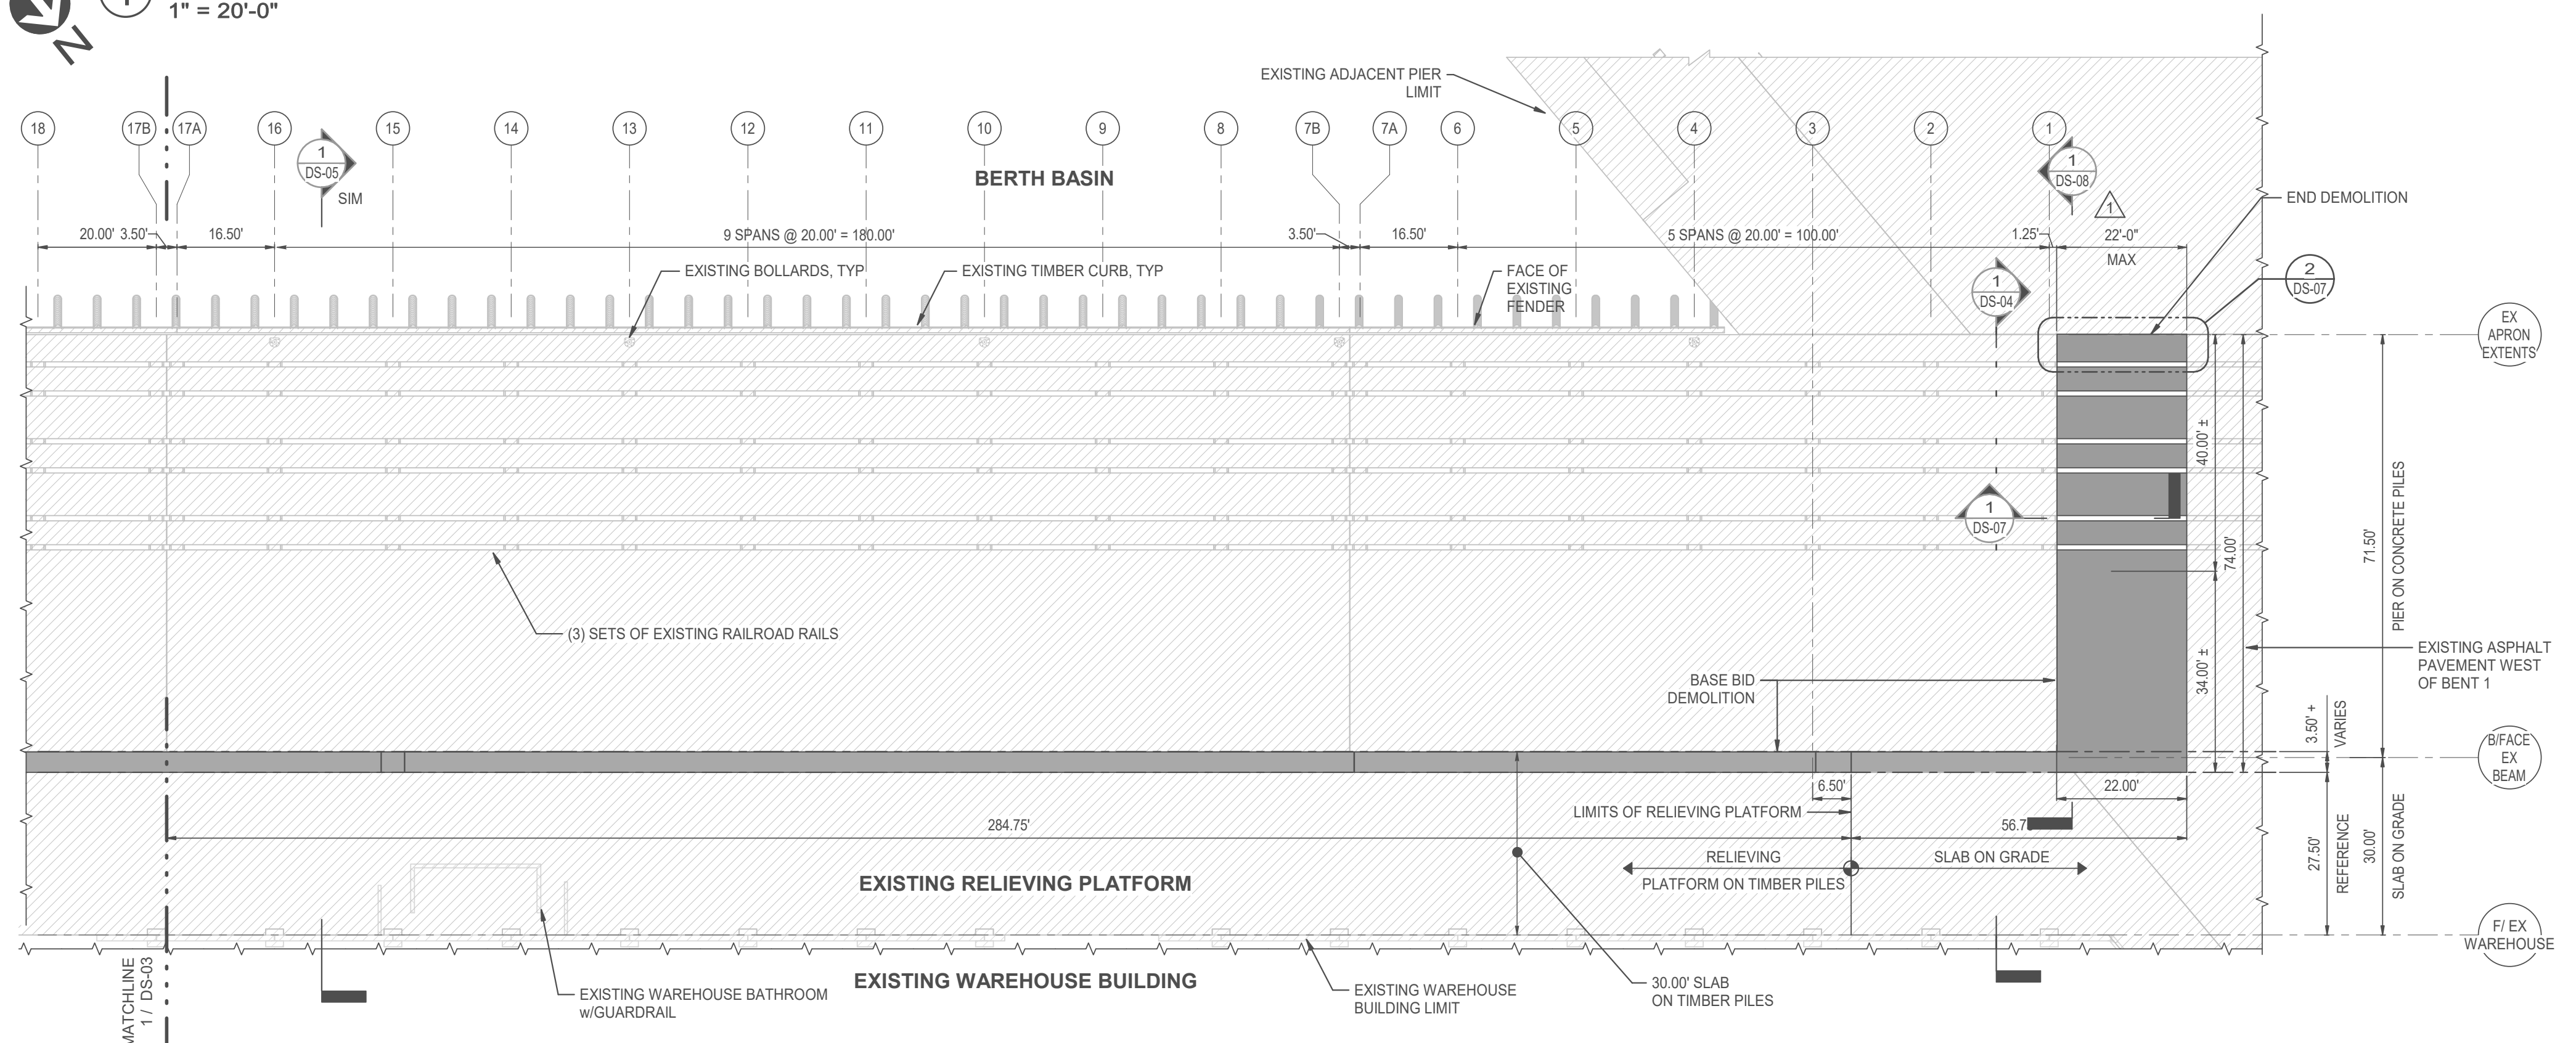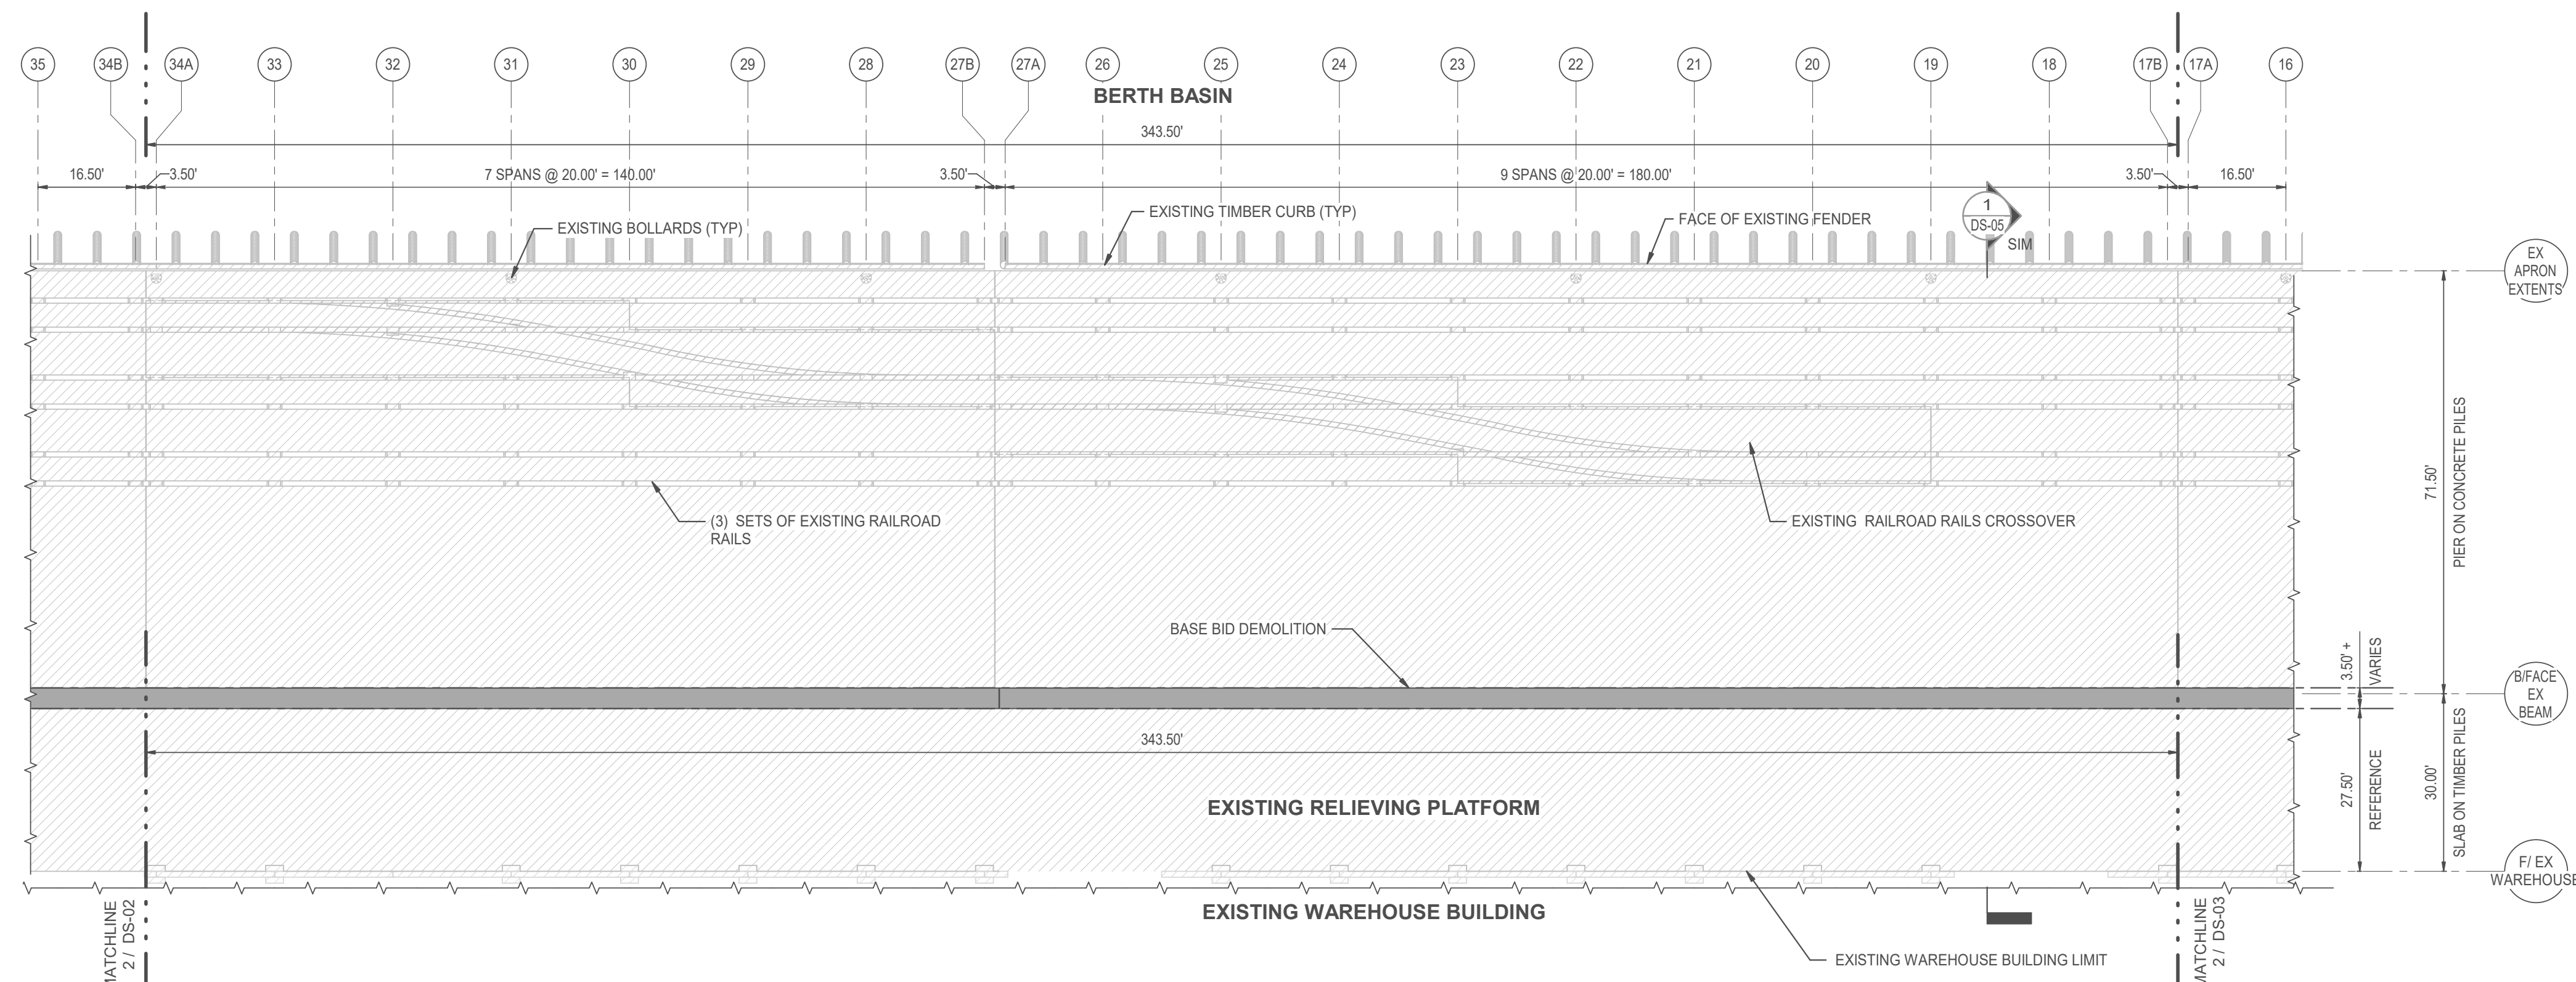


**DEMOLITION LEGEND**

	INDICATES LIMITS OF BASE BID DEMOLITION
	INDICATES EXISTING STRUCTURE TO REMAIN

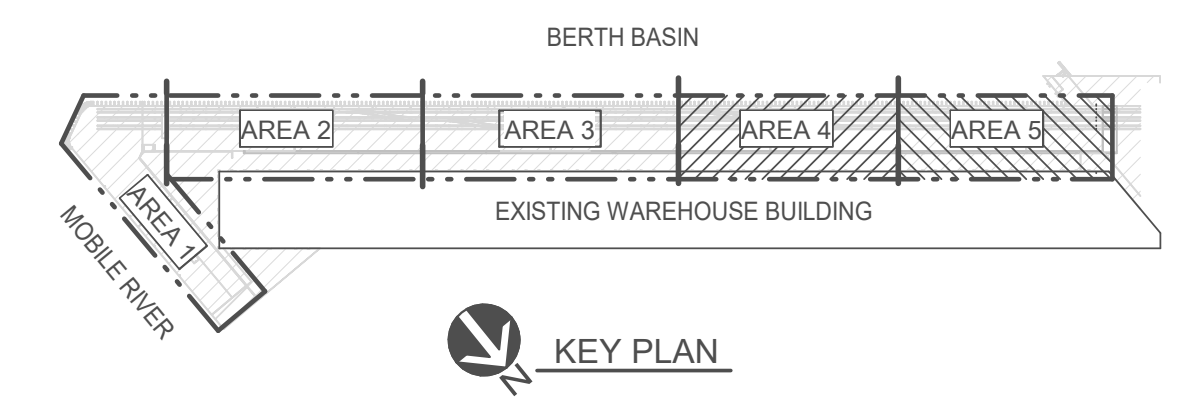

AS-BUILT INFORMATION SHOWN ON THIS DRAWING HAS BEEN OBSERVED AND SUPPLIED BY THE CONTRACTOR. MOTT MACDONALD DOES NOT ATTEST TO THE ACCURACY OF THE CONTRACTOR'S MARK-UPS, BUT SIGNIFICANT FIELD CHANGES SHOWN ON THE DRAWINGS WERE VERIFIED BY MOTT MACDONALD FOR CONFORMANCE WITH THE ORIGINAL DESIGN INTENT.

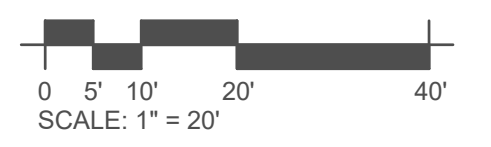

SHEET PILE WALL REPLACEMENT

PIER B SOUTH

397324

7/31/2023 3:42:56 PM


**M M**  
MOTT MACDONALD

Mott MacDonald  
107 St. Francis Street  
Suite 2900  
Mobile, Alabama 36602  
United States of America  
Telephone: (251) 343-4366  
www.mottmac.com/americas

Client  
**ALABAMA STATE PORT AUTHORITY**  
MOBILE, ALABAMA

2	07-27-23	KWD	AS-BUILT RECORD DRAWINGS	CEL	LJD
1	05-18-22	KWD	ADD 1 ISSUED FOR CONST	CEL	LJD
0	01-14-22	KWD	ISSUED FOR BID	CEL	LJD
Rev	Date	Drawn	Description	Ch'k'd	App'd

**LOWRY J. DENTY, P.E.**  
24892 ALABAMA - CERTIFICATION NUMBER

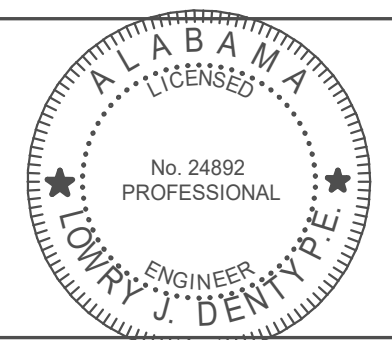


**AS-BUILT RECORD**  
Project Number **397324**


Designed	JQ	Eng Check	KP
Drawn	KWD	Coordination	LJD
Dwg Check	CEL	Approved	BP
Scale at ANSI D	Status	Rev	Security
As Shown	IFC	1	STD
Drawing Number	<b>DS-03</b>		

Title  
**PIER B SOUTH**  
**DEMOLITION DECK PLANS AREAS 4 & 5 (BENTS 1 - 34A)**

This drawing is the property of Mott MacDonald and may not be reproduced without written permission. This document should not be relied on or used in circumstances other than those for which it was originally prepared and for which Mott MacDonald was commissioned. Mott MacDonald accepts no responsibility for this document to any party other than the person or entity by whom it was commissioned.

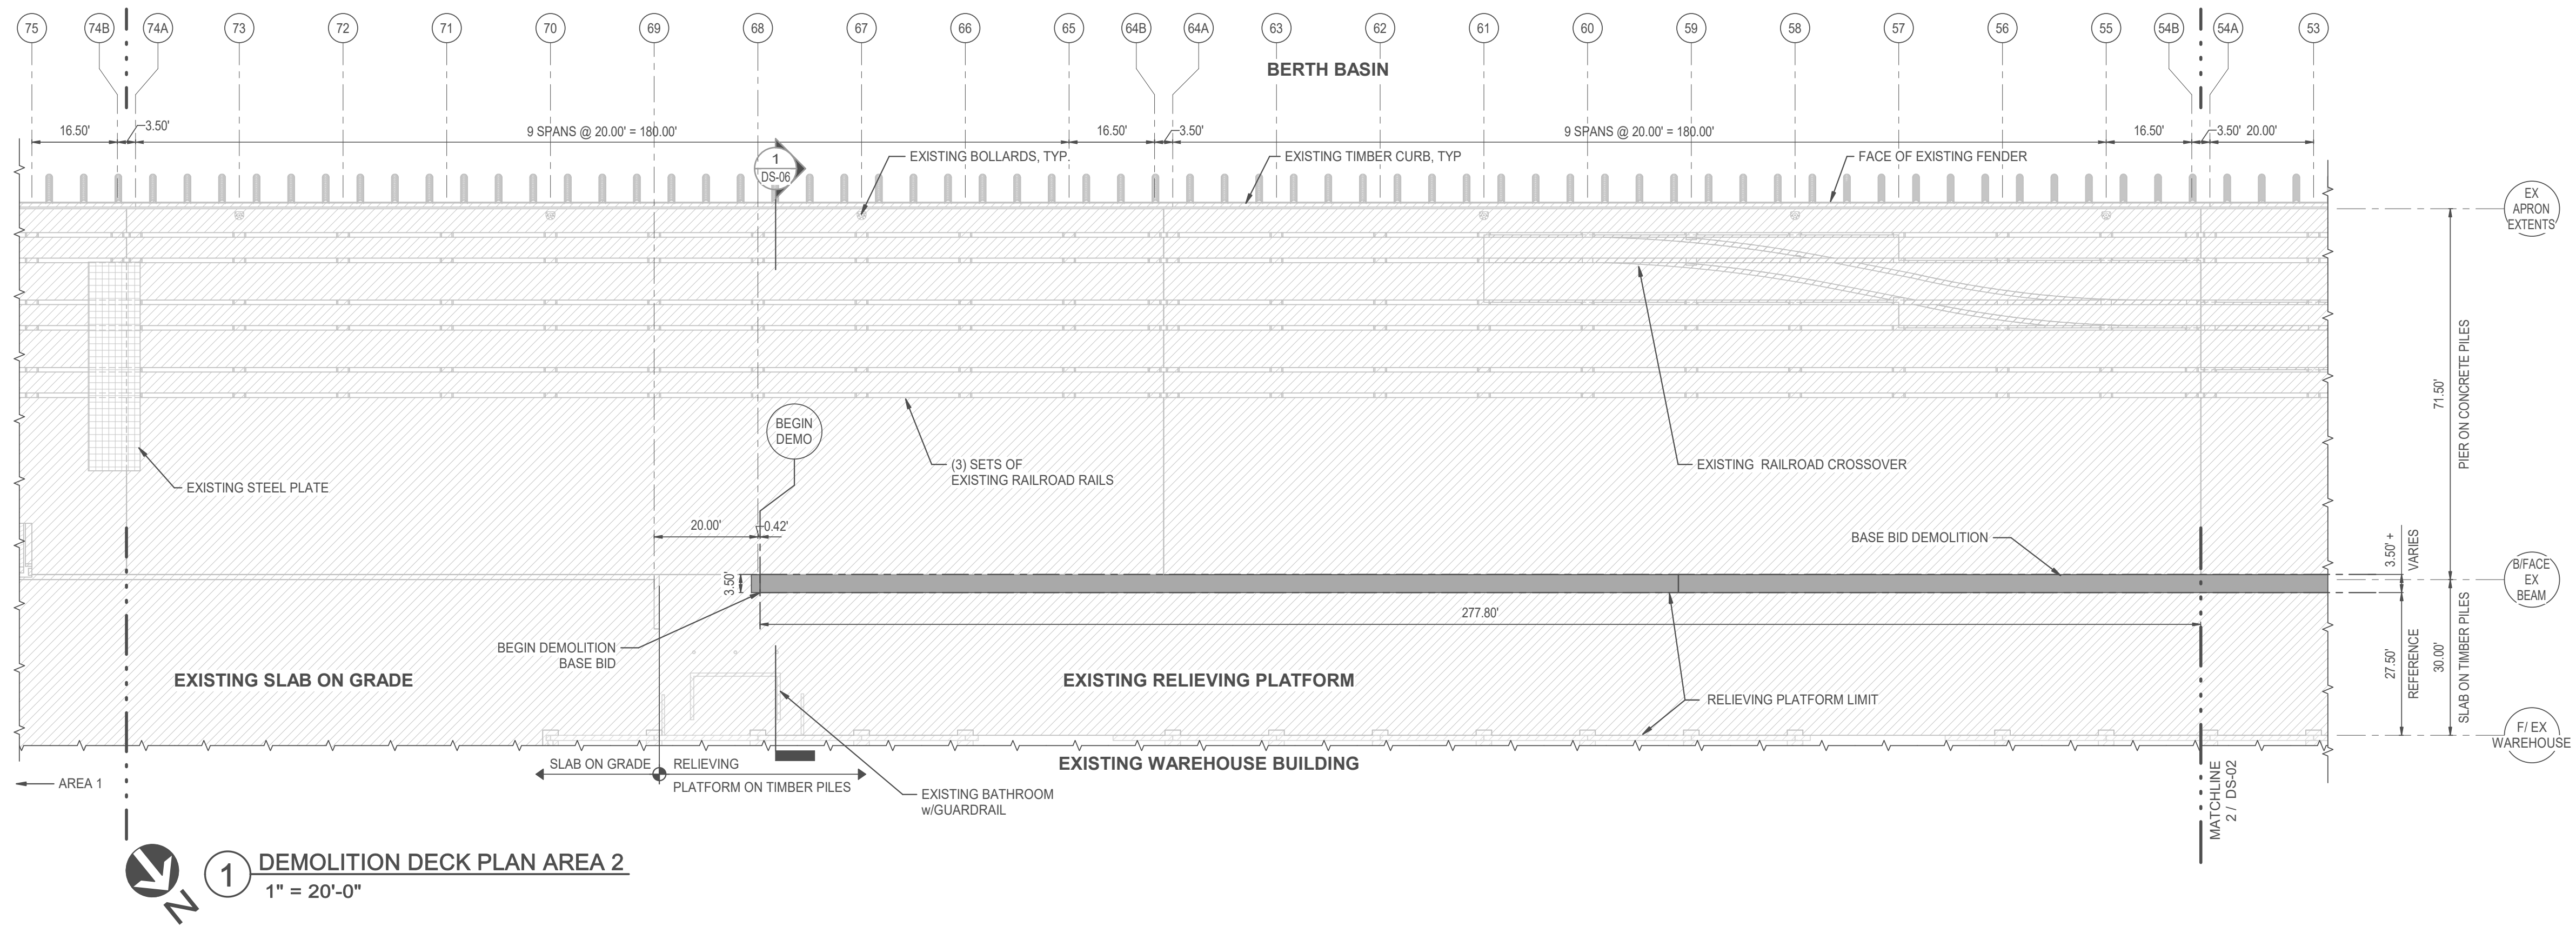


**1** DEMOLITION DECK PLAN AREA 2  
1" = 20'-0"

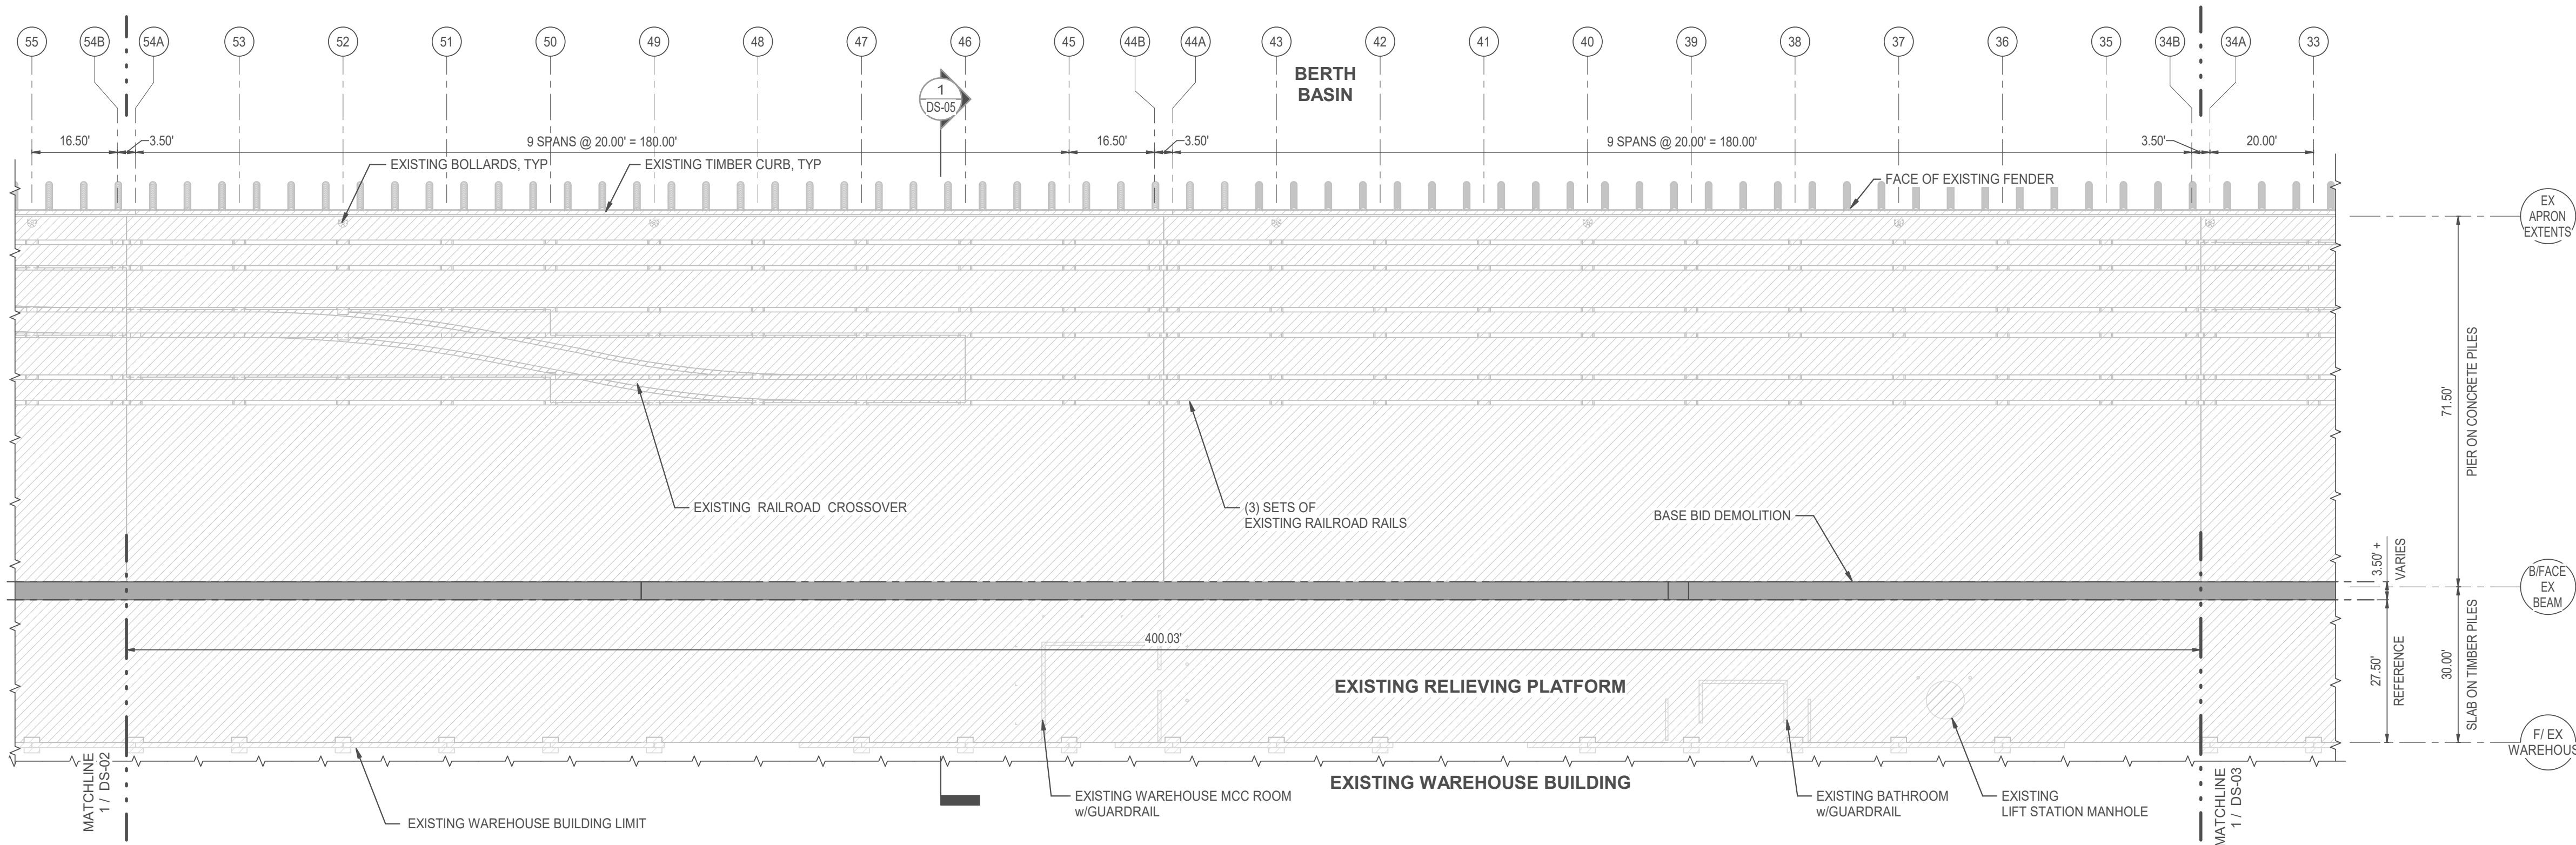


**2** DEMOLITION DECK PLAN AREA 3  
1" = 20'-0"

**DEMOLITION LEGEND**

- INDICATES LIMITS OF BASE BID DEMOLITION
- INDICATES EXISTING STRUCTURE TO REMAIN

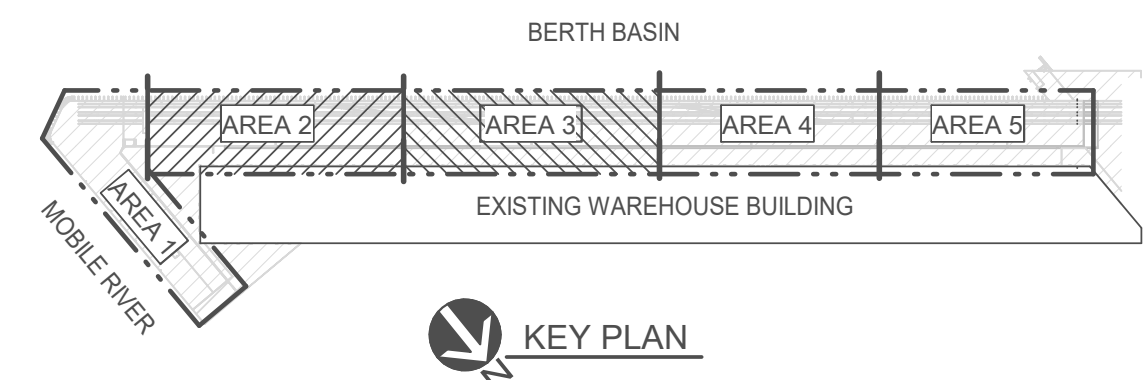

AS-BUILT INFORMATION SHOWN ON THIS DRAWING HAS BEEN OBSERVED AND SUPPLIED BY THE CONTRACTOR. MOTT MACDONALD DOES NOT ATTEST TO THE ACCURACY OF THE CONTRACTOR'S MARK-UPS, BUT SIGNIFICANT FIELD CHANGES SHOWN ON THE DRAWINGS WERE VERIFIED BY MOTT MACDONALD FOR CONFORMANCE WITH THE ORIGINAL DESIGN INTENT.

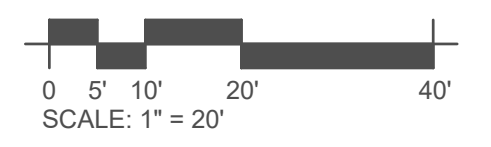

SHEET PILE WALL REPLACEMENT

PIER B SOUTH

397324


7/31/2023 3:43:07 PM

Mott MacDonald  
107 St. Francis Street  
Suite 2900  
Mobile, Alabama 36602  
United States of America  
Telephone: (251) 343-4366  
www.mottmac.com/americas

Client  
**ALABAMA STATE PORT AUTHORITY**  
  
MOBILE, ALABAMA

Rev	Date	Drawn	Description	Ch'k'd	App'd
2	07-27-23	KWD	AS-BUILT RECORD DRAWINGS	CEL	LJD
1	05-18-22	KWD	ADD 1 ISSUED FOR CONST	CEL	LJD
0	01-14-22	KWD	ISSUED FOR BID	CEL	LJD

**LOWRY J. DENTY, P.E.**  
24892 ALABAMA - CERTIFICATION NUMBER

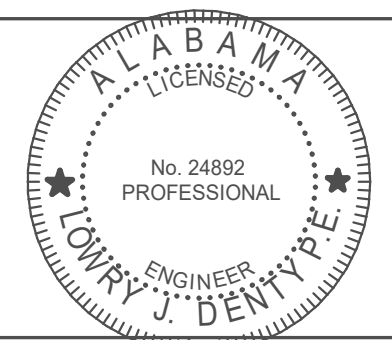

AS-BUILT RECORD  
Project Number **397324**

Designed	JQ	Eng Check	KP
Drawn	KWD	Coordination	LJD
Dwg Check	CEL	Approved	BP
Scale at ANS I D	Status	Rev	Security
As Shown	IFC	1	STD
Drawing Number	<b>DS-02</b>		

Title  
**PIER B SOUTH**  
  
**DEMOLITION DECK PLANS AREAS 2 & 3 (BENTS 34B - 74A)**


This drawing is the property of Mott MacDonald and may not be reproduced without written permission. This document should not be relied on or used in circumstances other than those for which it was originally prepared and for which Mott MacDonald was commissioned. Mott MacDonald accepts no responsibility for this document to any party other than the person or entity by whom it was commissioned.

SHEET PILE WALL REPLACEMENT

PIER B SOUTH

397324

7/31/2023 3:43:14 PM

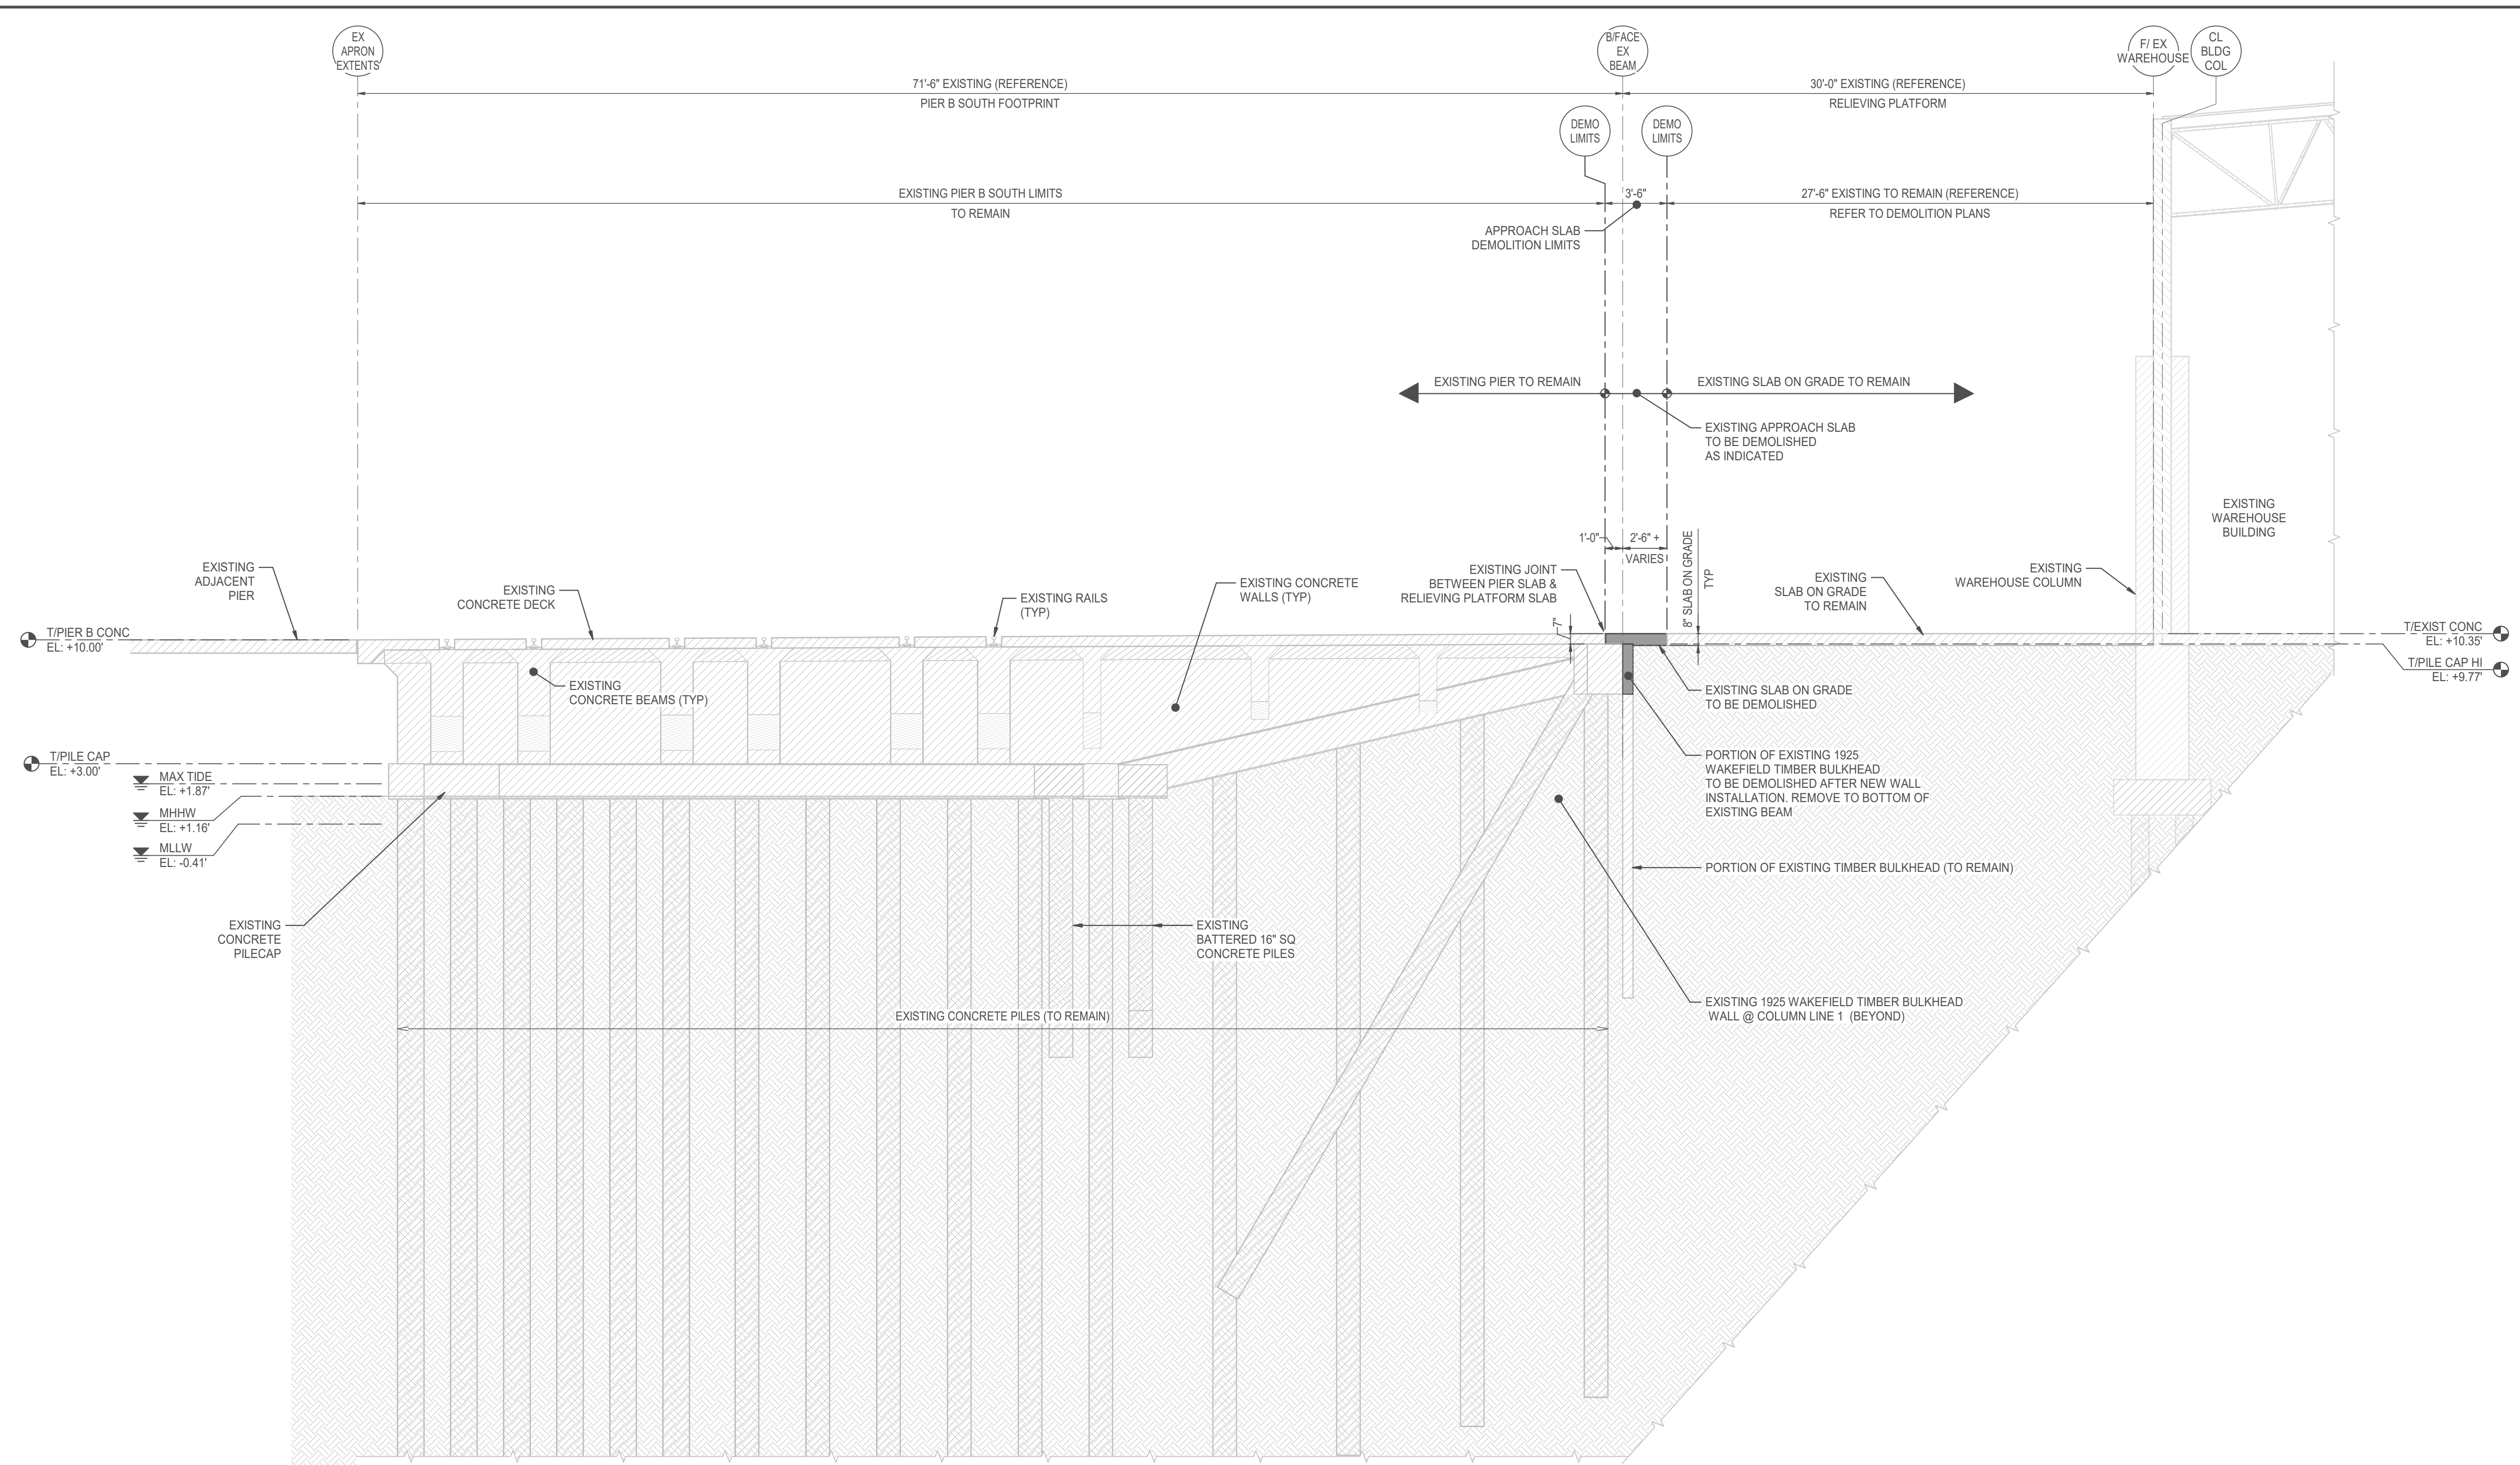


**DEMOLITION LEGEND**

- INDICATES LIMITS OF DEMOLITION
- INDICATES EXISTING STRUCTURE TO REMAIN
- EXISTING SOIL

**1 DEMOLITION SECTION AT EXISTING BENT 1**  
3/16" = 1'-0"

AS-BUILT INFORMATION SHOWN ON THIS DRAWING HAS BEEN OBSERVED AND SUPPLIED BY THE CONTRACTOR. MOTT MACDONALD DOES NOT ATTEST TO THE ACCURACY OF THE CONTRACTOR'S MARK-UPS, BUT SIGNIFICANT FIELD CHANGES SHOWN ON THE DRAWINGS WERE VERIFIED BY MOTT MACDONALD FOR CONFORMANCE WITH THE ORIGINAL DESIGN INTENT.

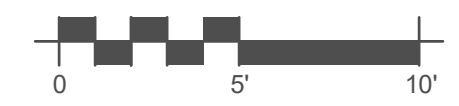

**M M**  
**MOTT MACDONALD**

Mott MacDonald  
107 St. Francis Street  
Suite 2900  
Mobile, Alabama 36602  
United States of America  
Telephone: (251) 343-4366  
www.mottmac.com/america


Client  
**ALABAMA STATE PORT AUTHORITY**  
  
MOBILE, ALABAMA

Rev	Date	Drawn	Description	Ch'kd	App'd
2	07-27-23	KWD	AS-BUILT RECORD DRAWINGS	CEL	LJD
1	05-18-22	KWD	ADD 1 ISSUED FOR CONST	CEL	LJD
0	01-14-22	KWD	ISSUED FOR BID	CEL	LJD

**LOWRY J. DENTY, P.E.**  
24892 ALABAMA - CERTIFICATION NUMBER

**AS-BUILT RECORD**

Project Number **397324**

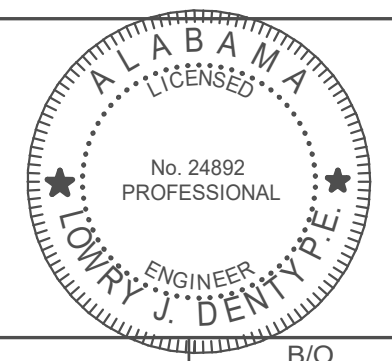

Designed	JQ	Eng Check	KP
Drawn	KWD	Coordination	LJD
Dwg Check	CEL	Approved	BP
Scale at ANSI D As Shown	Status IFC	Rev 1	Security STD
Drawing Number		<b>DS-04</b>	

Title  
**PIER B SOUTH**  
  
**DEMOLITION BERTH BASIN SECTION AT EXISTING BENT 1**


This drawing is the property of Mott MacDonald and may not be reproduced without written permission. This document should not be relied on or used in circumstances other than those for which it was originally prepared and for which Mott MacDonald was commissioned. Mott MacDonald accepts no responsibility for this document to any party other than the person or entity by whom it was commissioned.

SHEET PILE WALL REPLACEMENT

PIER B SOUTH

397324

7/31/2023 3:43:17 PM

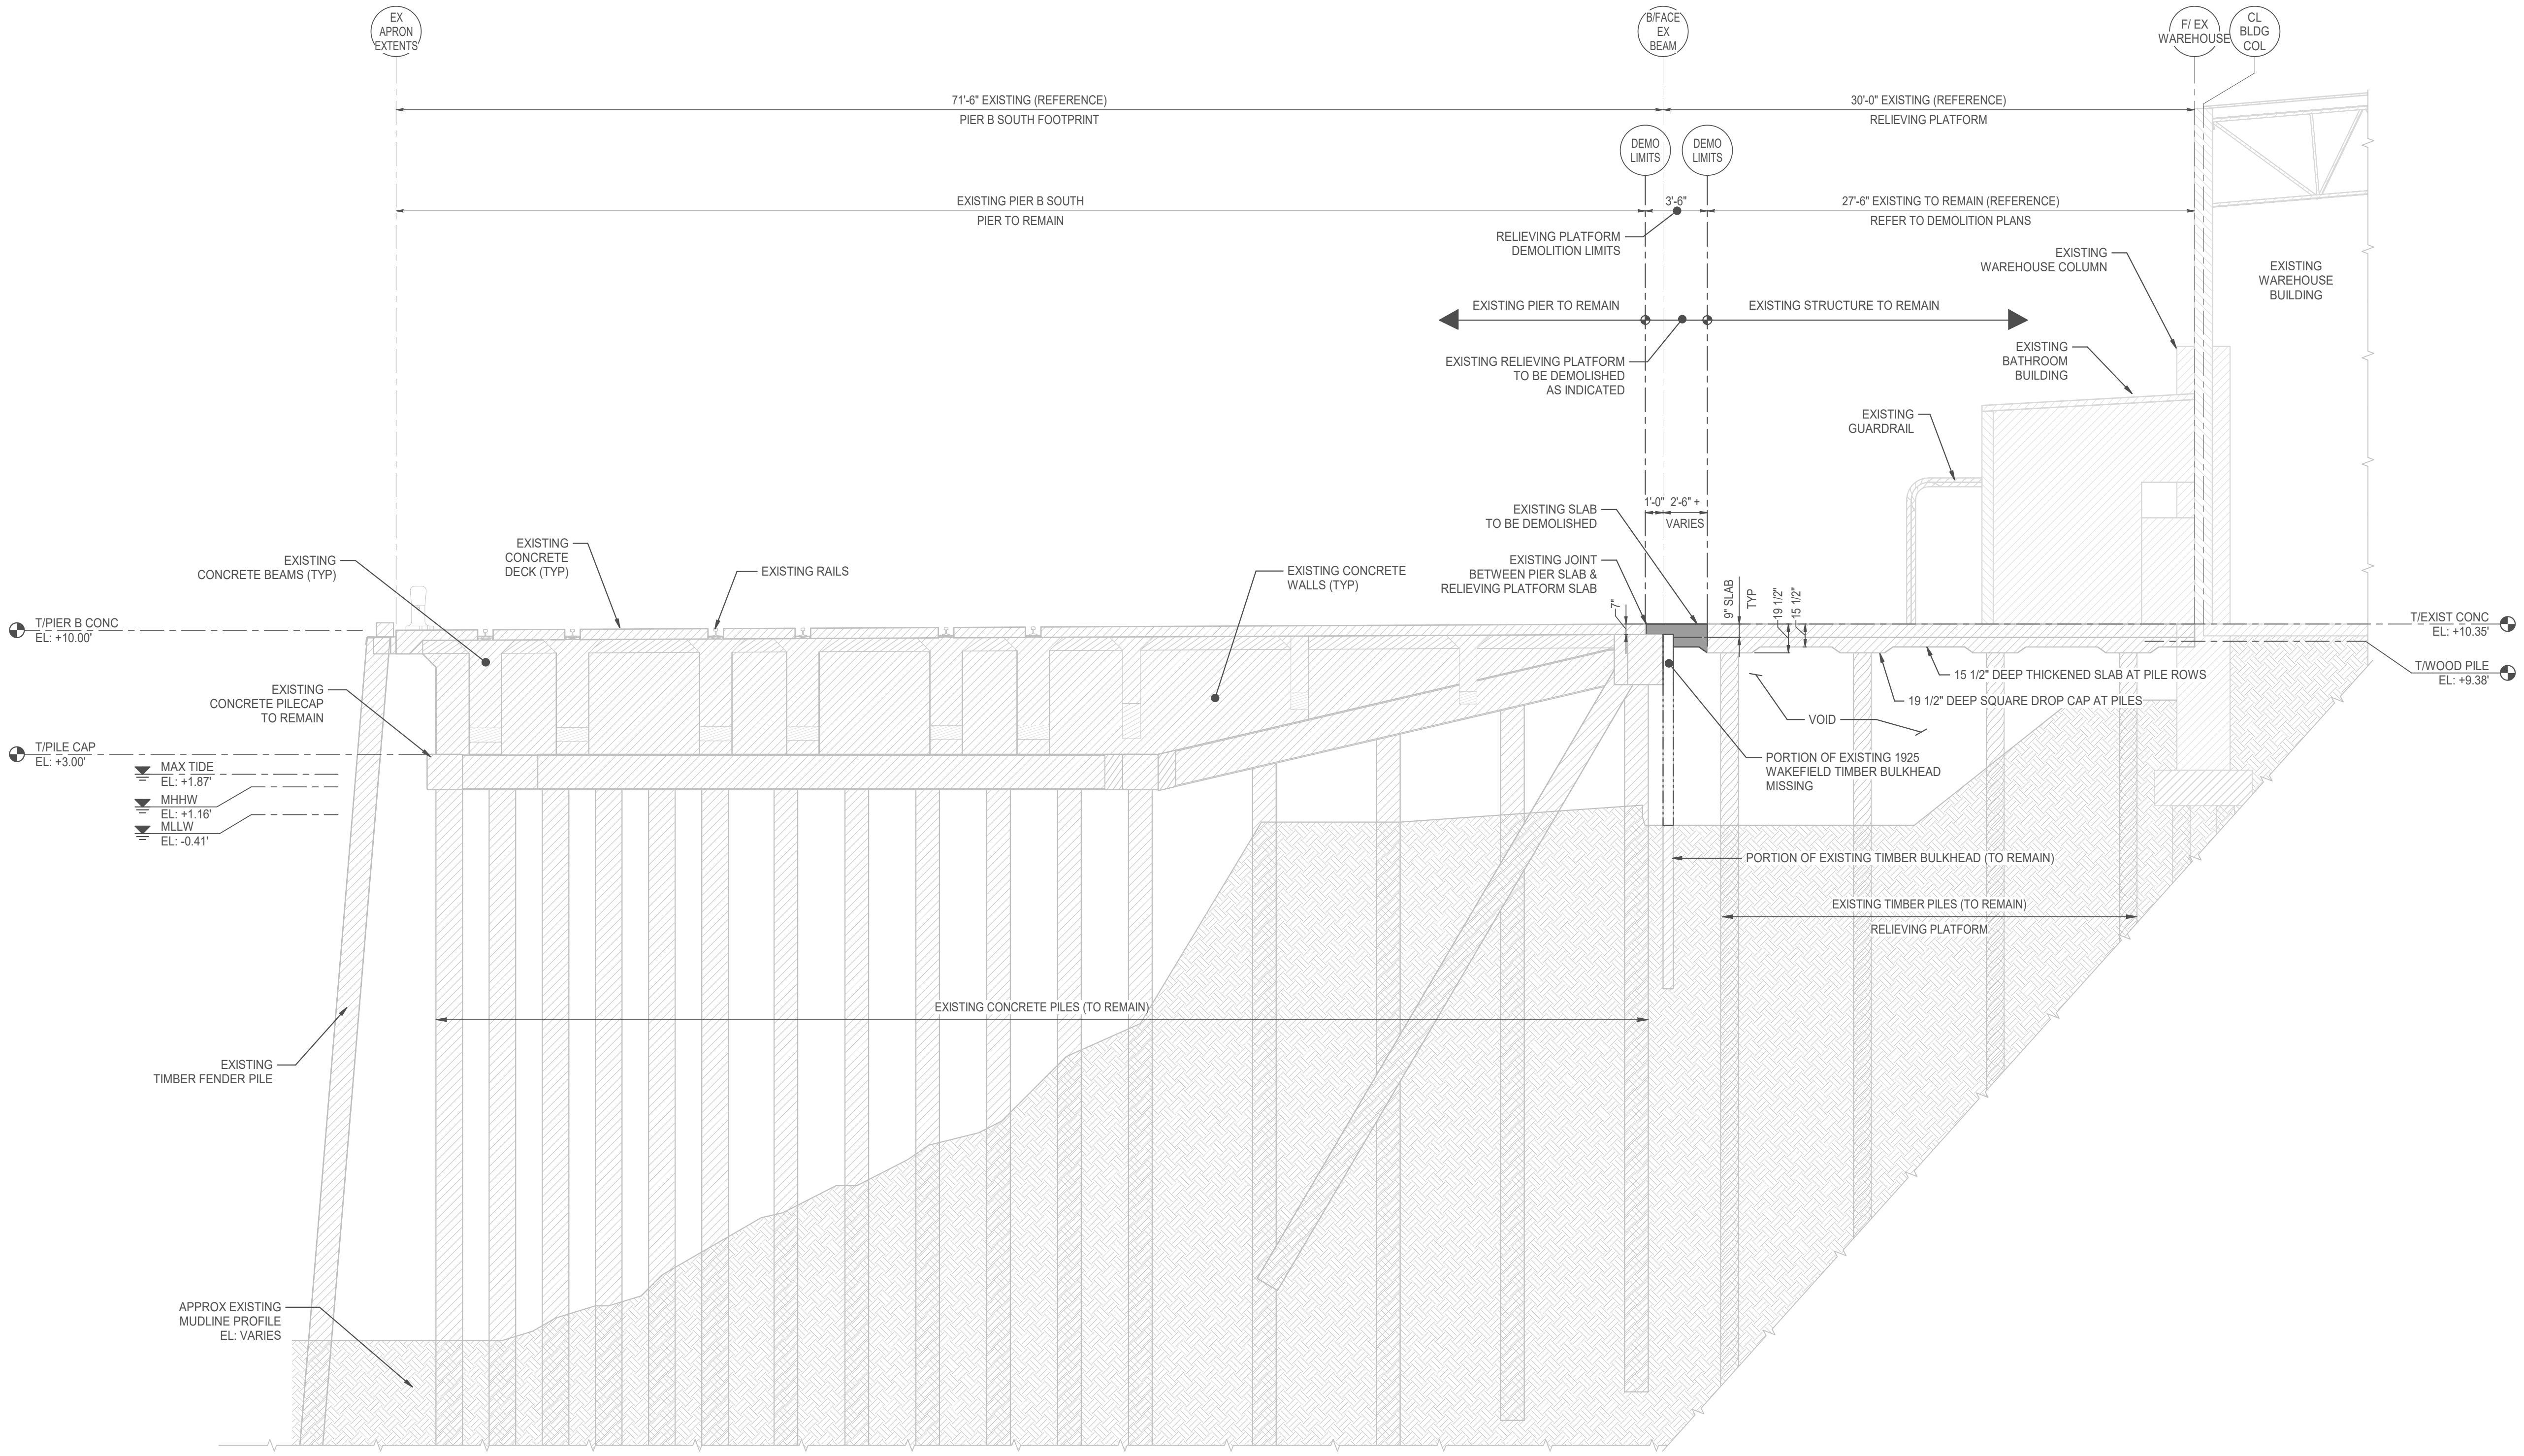

**DEMOLITION LEGEND**

- INDICATES LIMITS OF DEMOLITION
- INDICATES EXISTING STRUCTURE TO REMAIN
- EXISTING SOIL

**1 DEMOLITION SECTION AT EXISTING BENT 67**  
3/16" = 1'-0"

AS-BUILT INFORMATION SHOWN ON THIS DRAWING HAS BEEN OBSERVED AND SUPPLIED BY THE CONTRACTOR. MOTT MACDONALD DOES NOT ATTEST TO THE ACCURACY OF THE CONTRACTOR'S MARK-UPS, BUT SIGNIFICANT FIELD CHANGES SHOWN ON THE DRAWINGS WERE VERIFIED BY MOTT MACDONALD FOR CONFORMANCE WITH THE ORIGINAL DESIGN INTENT.



**M M**  
**MOTT MACDONALD**

Mott MacDonald  
107 St. Francis Street  
Suite 2900  
Mobile, Alabama 36602  
United States of America  
Telephone: (251) 343-4366  
www.mottmac.com/america


Client  
**ALABAMA STATE PORT AUTHORITY**  
  
MOBILE, ALABAMA

Rev	Date	Drawn	Description	Ch'k'd	App'd
2	07-27-23	KWD	AS-BUILT RECORD DRAWINGS	CEL	LJD
1	05-18-22	KWD	ADD 1 ISSUED FOR CONST	CEL	LJD
0	01-14-22	KWD	ISSUED FOR BID	CEL	LJD

**LOWRY J. DENTY, P.E.**  
24892 ALABAMA - CERTIFICATION NUMBER

**AS-BUILT RECORD**

Project Number **397324**

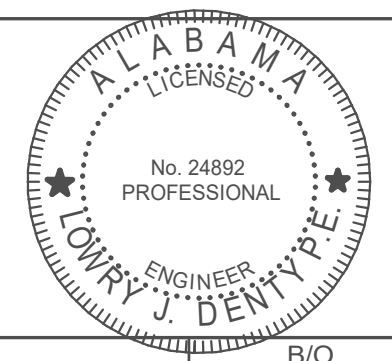

Designed	JQ	Eng Check	KP
Drawn	KWD	Coordination	LJD
Dwg Check	CEL	Approved	BP
Scale at ANSD As Shown	Status IFC	Rev 1	Security STD
Drawing Number		<b>DS-06</b>	

Title  
**PIER B SOUTH**  
  
**DEMOLITION BERTH BASIN SECTION AT EXISTING BENT 67**


This drawing is the property of Mott MacDonald and may not be reproduced without written permission. This document should not be relied on or used in circumstances other than those for which it was originally prepared and for which Mott MacDonald was commissioned. Mott MacDonald accepts no responsibility for this document to any party other than the person or entity by whom it was commissioned.

SHEET PILE WALL REPLACEMENT


PIER B SOUTH

397324

7/31/2023 3:43:21 PM

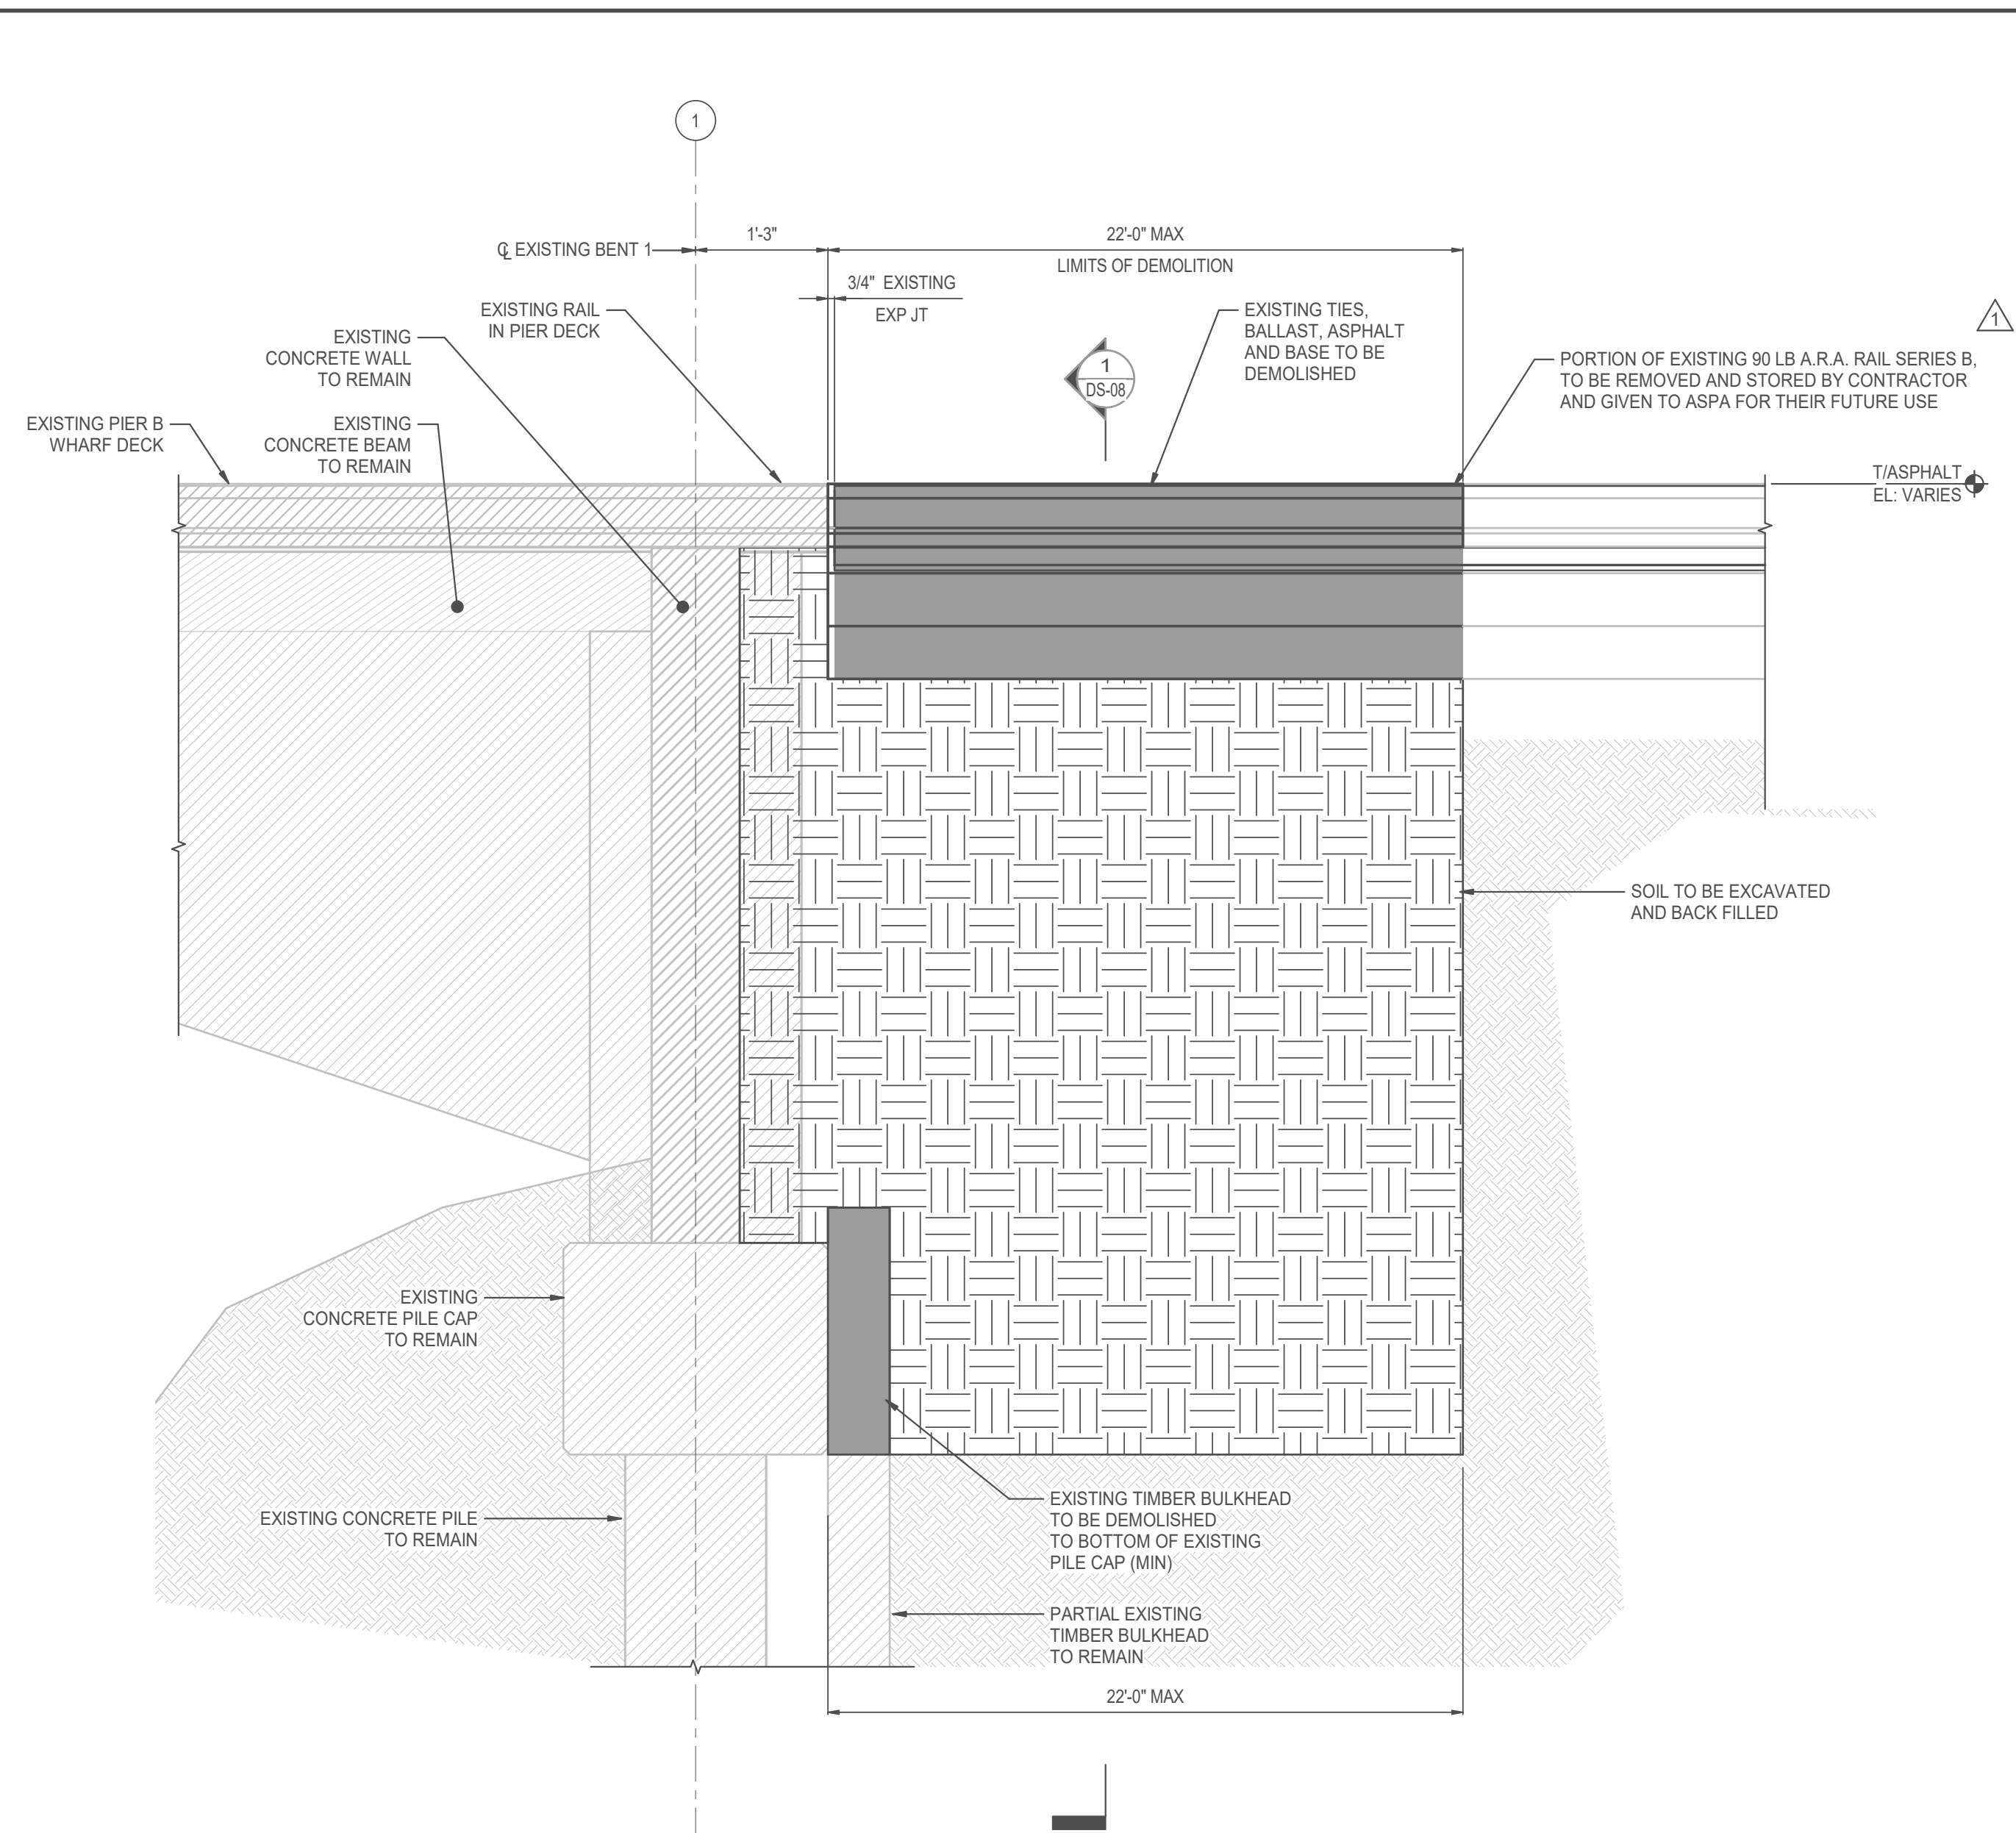

**1** DEMOLITION DETAIL AT RAIL TRACK EXISTING BENT 1  
 DS-07 3/4" = 1'-0"

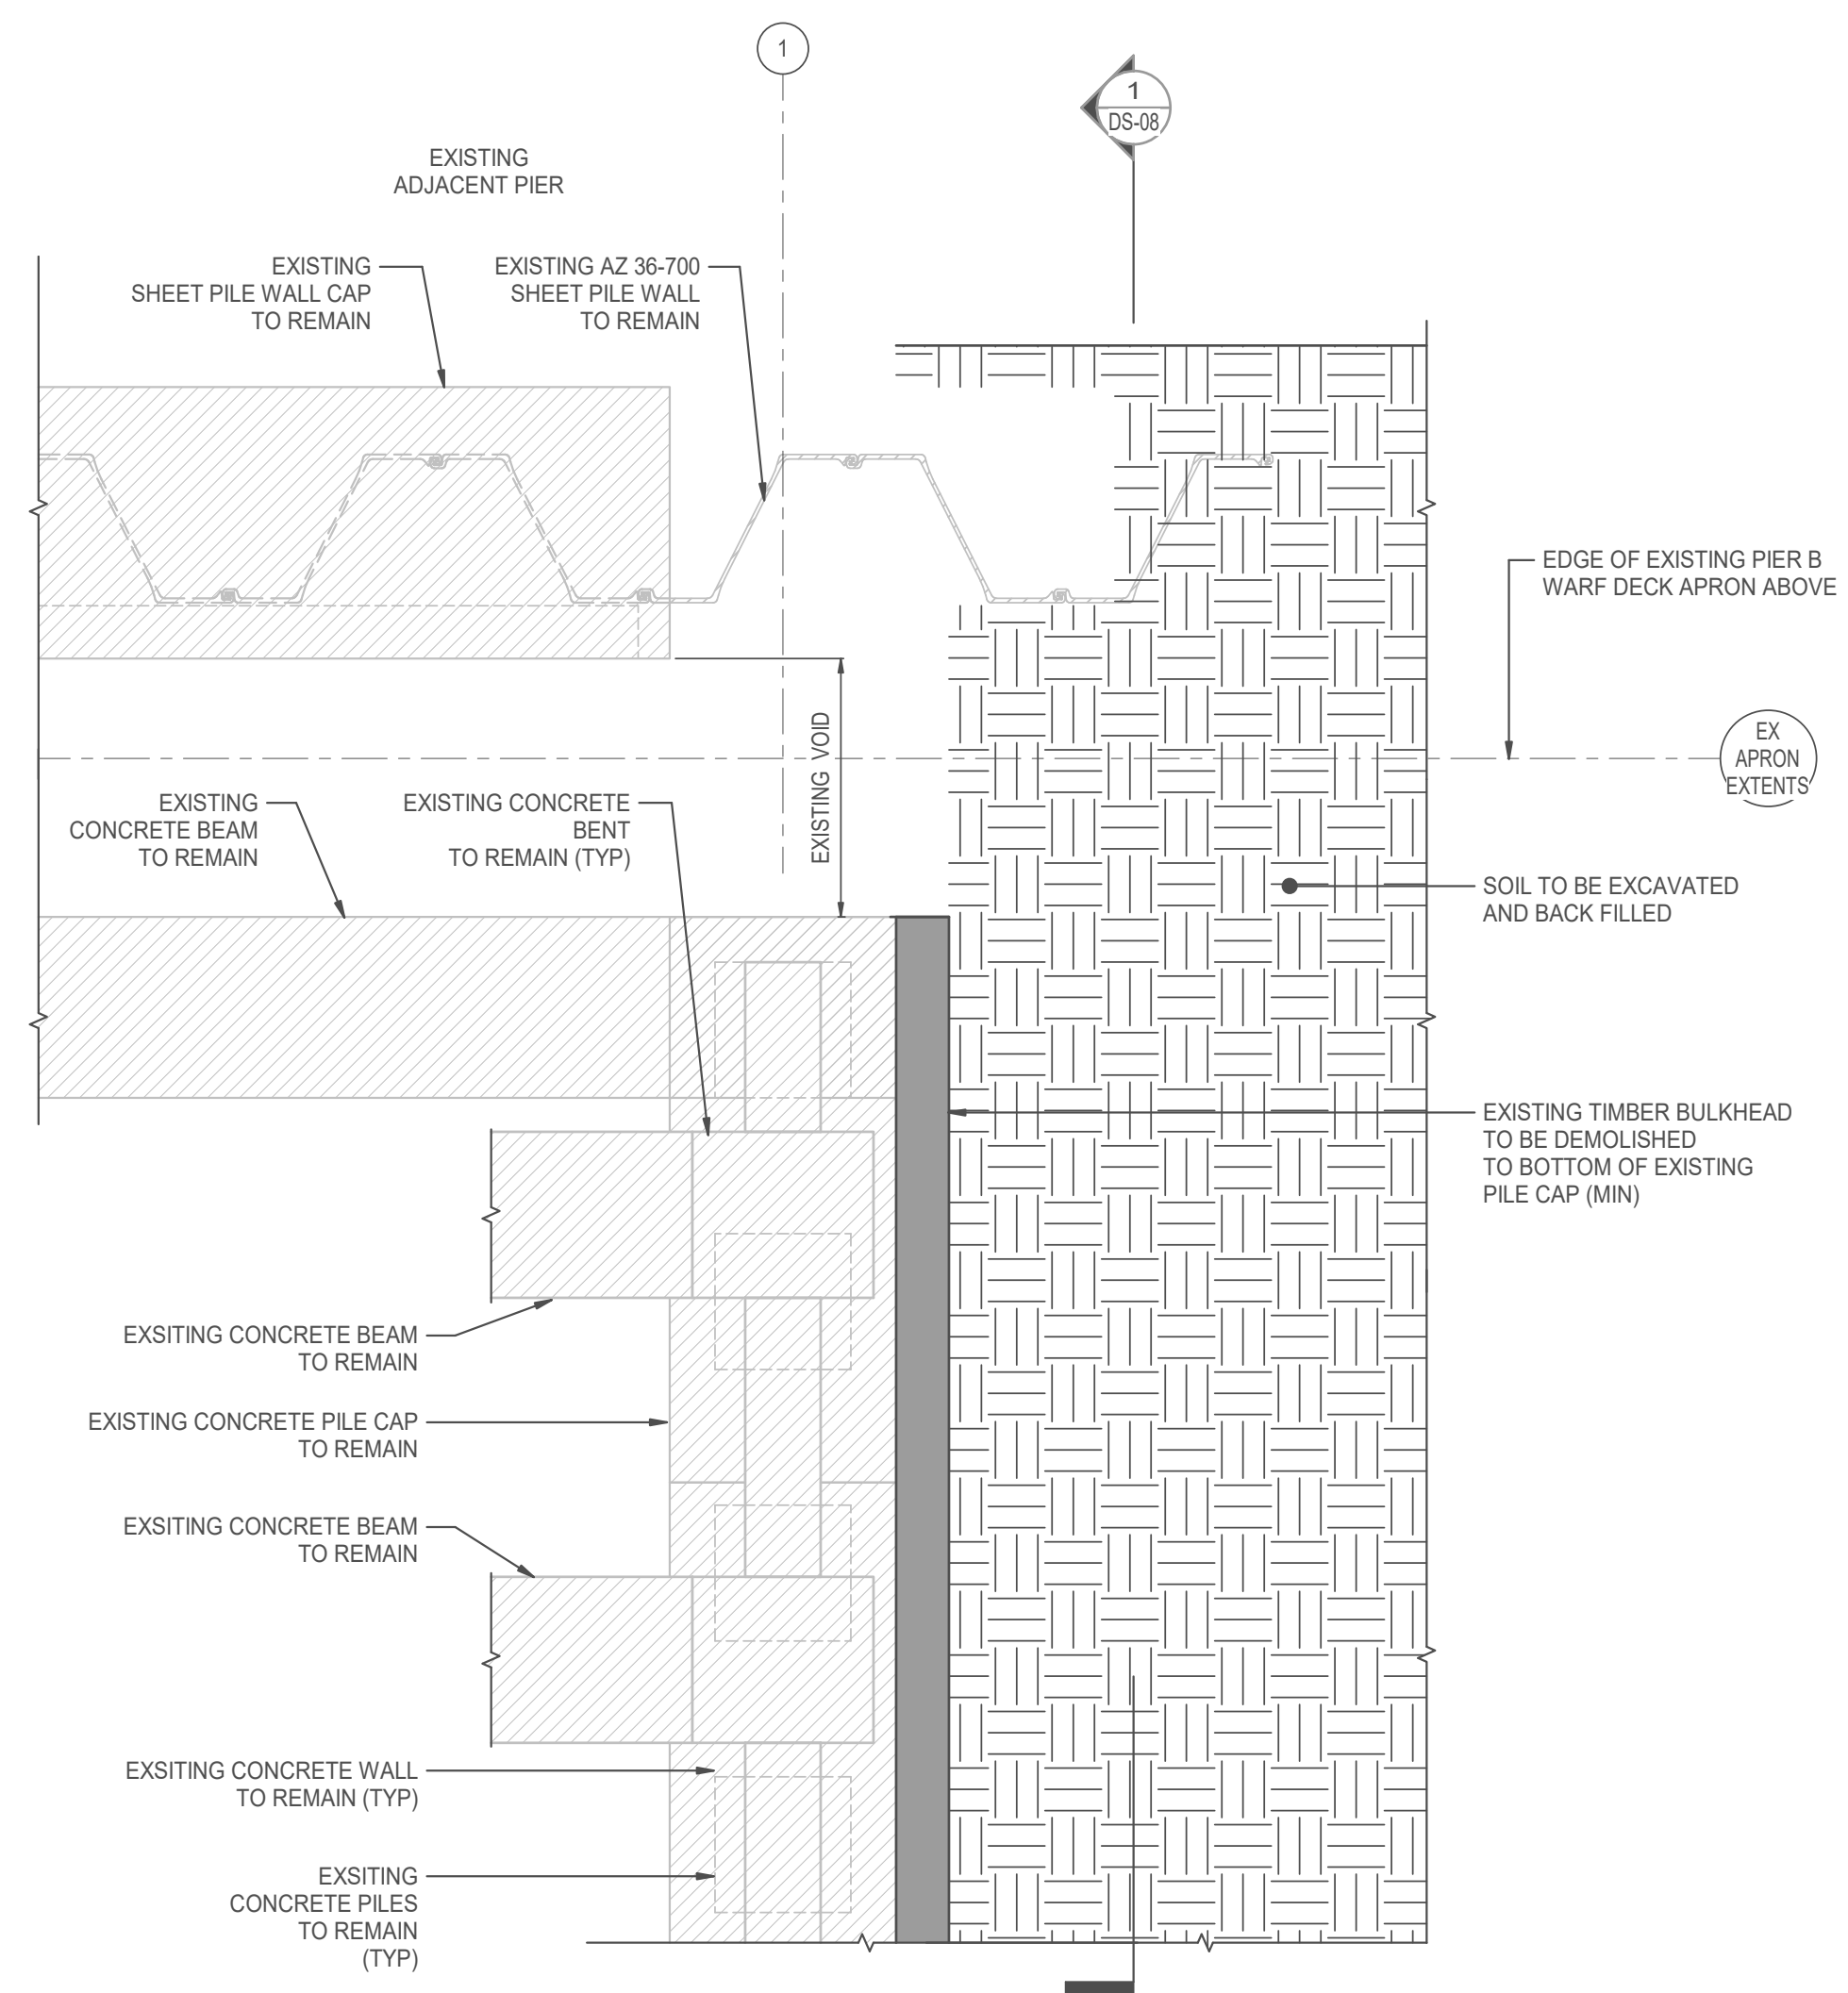


**2** DEMOLITION PARTIAL PLAN EXISTING BENT 1  
 DS-07 1/2" = 1'-0"

**DEMOLITION LEGEND**

	INDICATES LIMITS OF DEMOLITION
	INDICATES EXISTING AREA TO BE EXCAVATED
	INDICATES EXISTING STRUCTURE TO REMAIN
	EXISTING SOIL

AS-BUILT INFORMATION SHOWN ON THIS DRAWING HAS BEEN OBSERVED AND SUPPLIED BY THE CONTRACTOR. MOTT MACDONALD DOES NOT ATTEST TO THE ACCURACY OF THE CONTRACTOR'S MARK-UPS, BUT SIGNIFICANT FIELD CHANGES SHOWN ON THE DRAWINGS WERE VERIFIED BY MOTT MACDONALD FOR CONFORMANCE WITH THE ORIGINAL DESIGN INTENT.

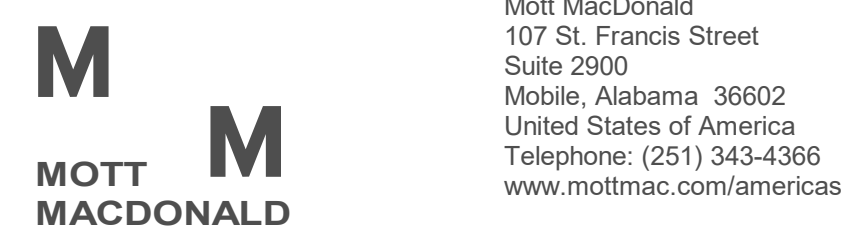


Mott MacDonald  
 107 St. Francis Street  
 Suite 2900  
 Mobile, Alabama 36602  
 United States of America  
 Telephone: (251) 343-4366  
 www.mottmac.com/america

Client  
**ALABAMA STATE PORT AUTHORITY**  
 MOBILE, ALABAMA

Rev	Date	Drawn	Description	Ch'k'd	App'd
2	07-27-23	KWD	AS-BUILT RECORD DRAWINGS	CEL	LJD
1	05-18-22	KWD	ADD 1 ISSUED FOR CONST	CEL	LJD
0	01-14-22	KWD	ISSUED FOR BID	CEL	LJD

**LOWRY J. DENTY, P.E.**  
 24892 ALABAMA - CERTIFICATION NUMBER

AS-BUILT RECORD

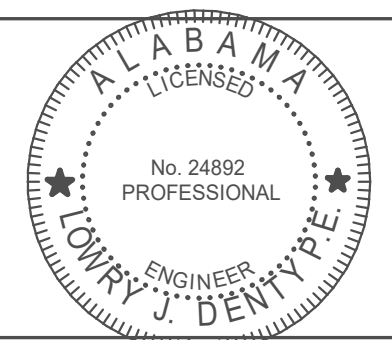

Project Number **397324** B/O Total

Designed	JQ	Eng Check	KP
Drawn	KWD	Coordination	LJD
Dwg Check	CEL	Approved	BP
Scale at ANSI D As Shown	Status IFC	Rev 1	Security STD
Drawing Number		<b>DS-07</b>	

Title  
**PIER B SOUTH**  
**DEMOLITION DETAILS**





SHEET PILE WALL REPLACEMENT

PIER B SOUTH

397324

7/31/2023 3:51:56 PM

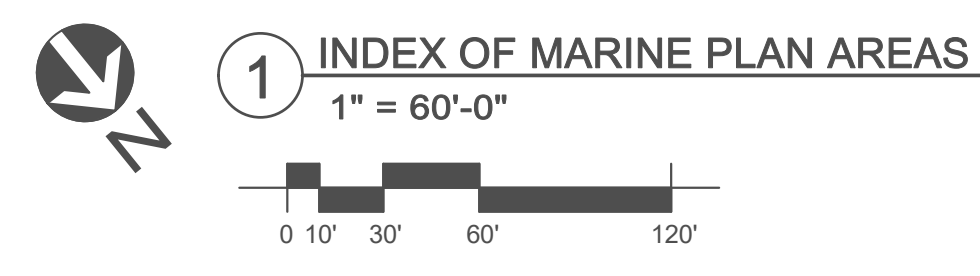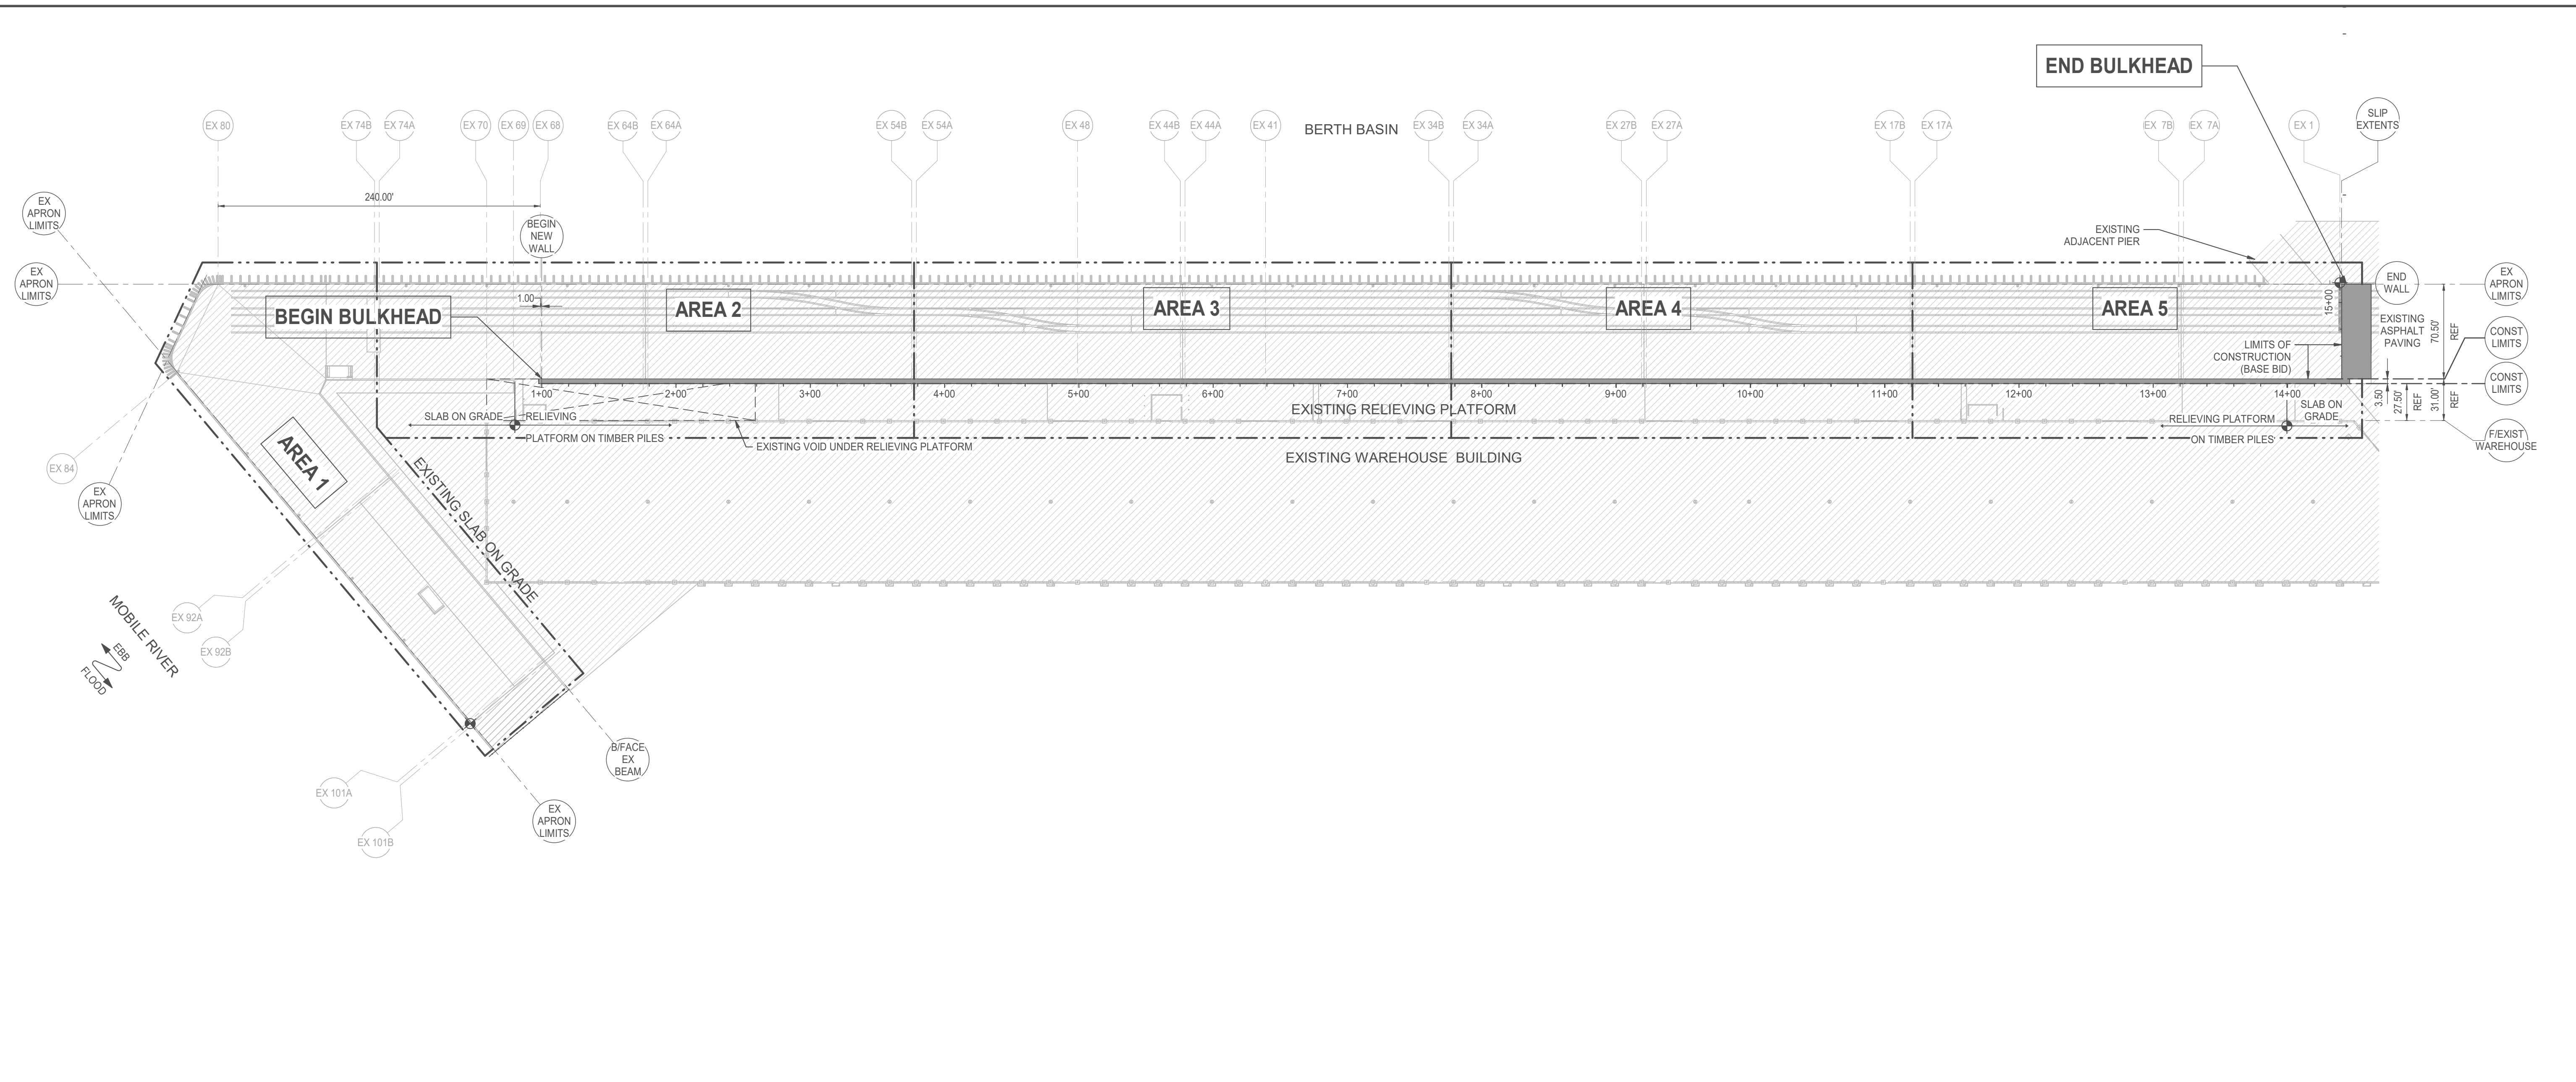

**LEGEND**

- INDICATES LIMITS OF CONSTRUCTION
- INDICATES EXISTING STRUCTURES
- EX # INDICATES EXISTING BENT REFER TO EXISTING DRAWINGS

AS-BUILT INFORMATION SHOWN ON THIS DRAWING HAS BEEN OBSERVED AND SUPPLIED BY THE CONTRACTOR. MOTT MACDONALD DOES NOT ATTEST TO THE ACCURACY OF THE CONTRACTOR'S MARK-UPS, BUT SIGNIFICANT FIELD CHANGES SHOWN ON THE DRAWINGS WERE VERIFIED BY MOTT MACDONALD FOR CONFORMANCE WITH THE ORIGINAL DESIGN INTENT.




Mott MacDonald  
107 St. Francis Street  
Suite 2900  
Mobile, Alabama 36602  
United States of America  
Telephone: (251) 343-4366  
www.mottmac.com/americas

Client  
**ALABAMA STATE  
PORT AUTHORITY**  
  
MOBILE, ALABAMA

Rev	Date	Drawn	Description	Ch'k'd	App'd
2	07-27-23	KWD	AS-BUILT RECORD DRAWINGS	CEL	LJD
1	05-18-22	KWD	ADD 1 ISSUED FOR CONST	CEL	LJD
0	01-14-22	KWD	ISSUED FOR BID	CEL	LJD

**LOWRY J. DENTY, P.E.**  
24892 ALABAMA - CERTIFICATION NUMBER  
  
**AS-BUILT  
RECORD**  
  
Project Number **397324**

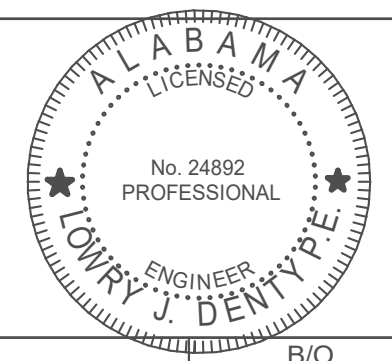

Designed	JQ	Eng Check	KP
Drawn	KWD	Coordination	LJD
Dwg Check	CEL	Approved	BP
Scale at ANSI D As Shown	Status IFC	Rev 1	Security STD
Drawing Number		<b>MA-01</b>	

Title  
**PIER B SOUTH  
NEW SHEET PILE WALL  
INDEX OF PLAN AREAS**

This drawing is the property of Mott MacDonald and may not be reproduced without written permission. This document should not be relied on or used in circumstances other than those for which it was originally prepared and for which Mott MacDonald was commissioned. Mott MacDonald accepts no responsibility for this document to any party other than the person or entity by whom it was commissioned.






SHEET PILE WALL REPLACEMENT


PIER B SOUTH

397324

7/31/2023 3:52:27 PM

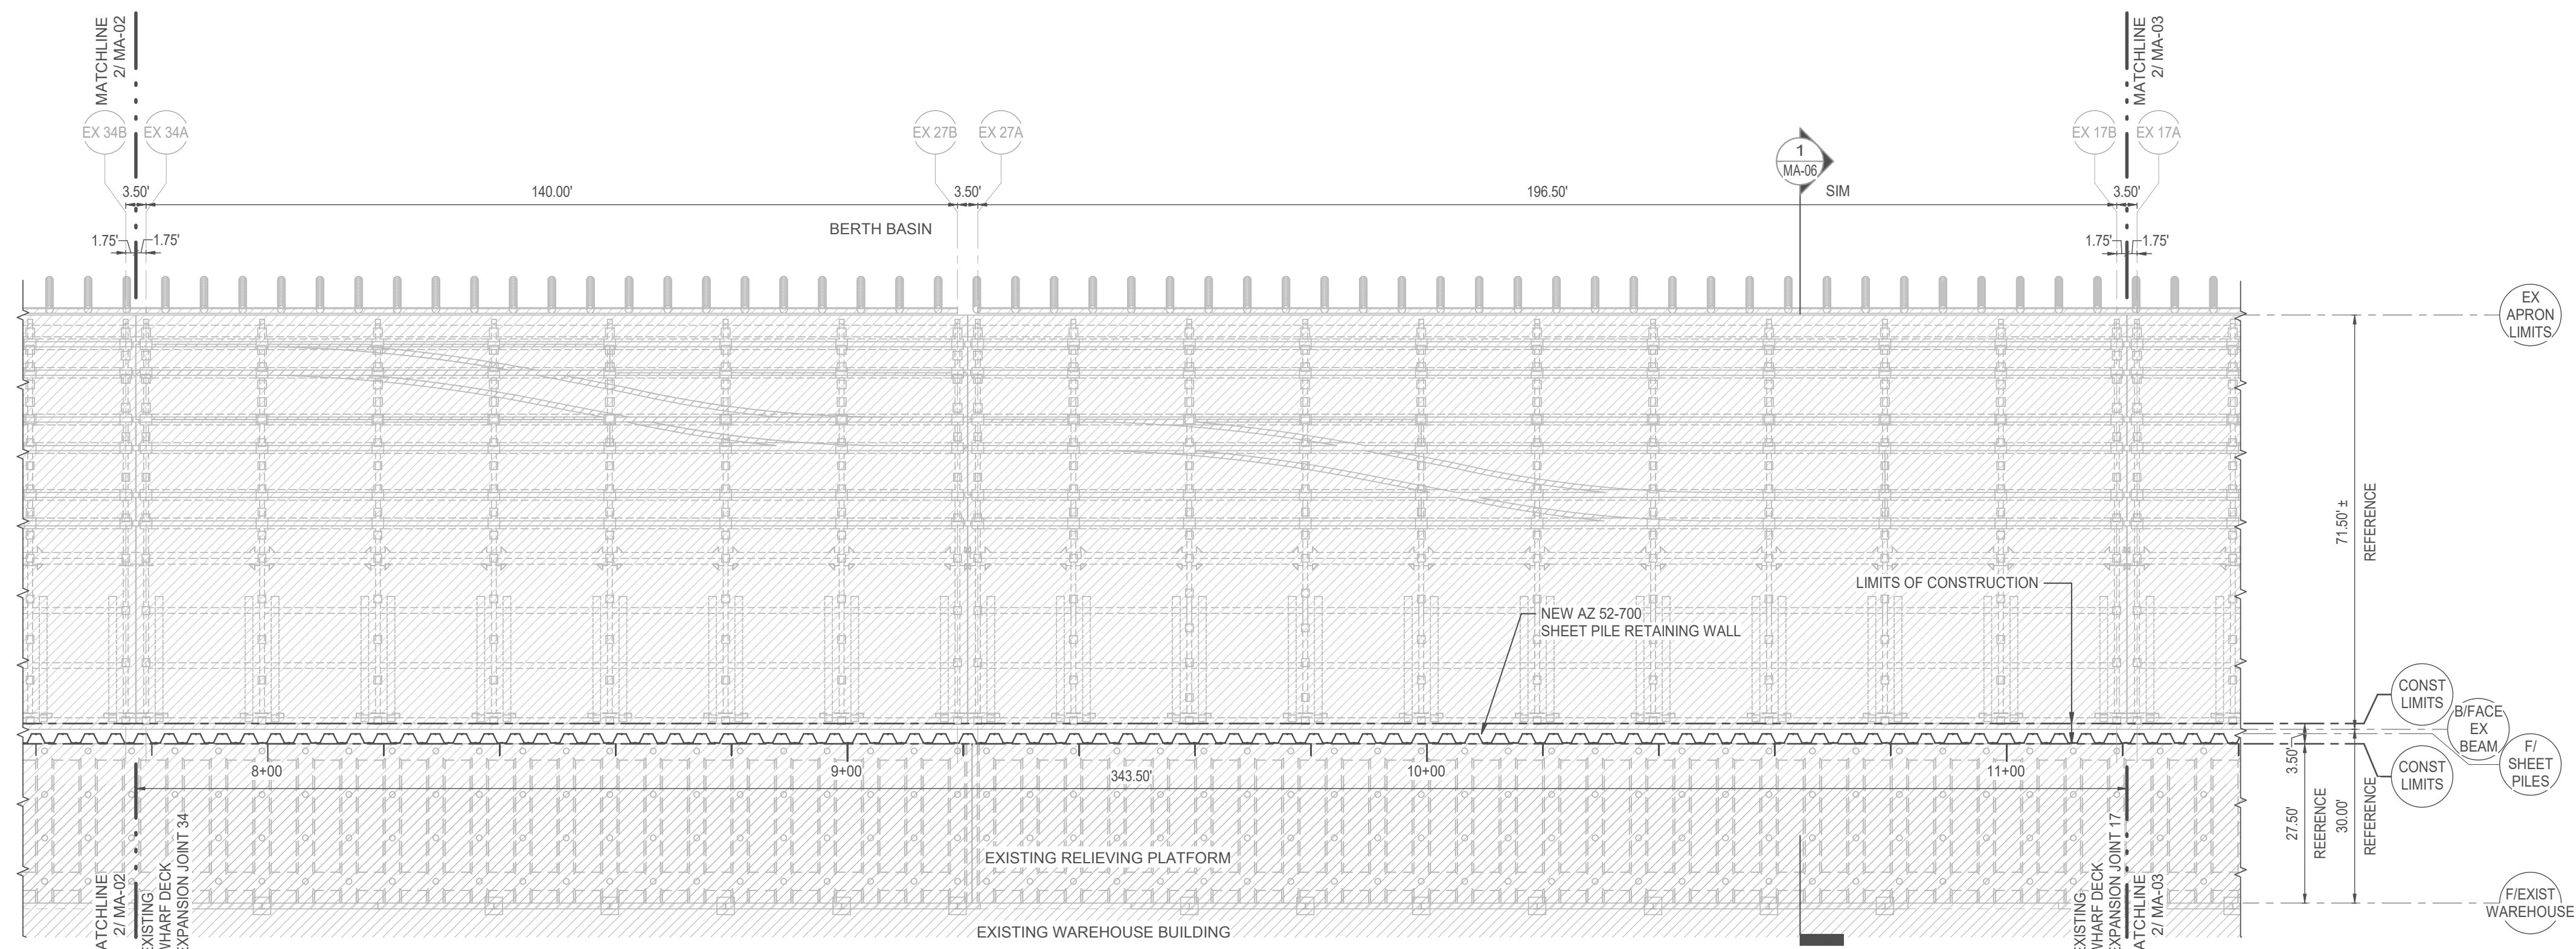


**1 AREA 4 NEW WALL LAYOUT PLAN**  
1" = 20'-0"


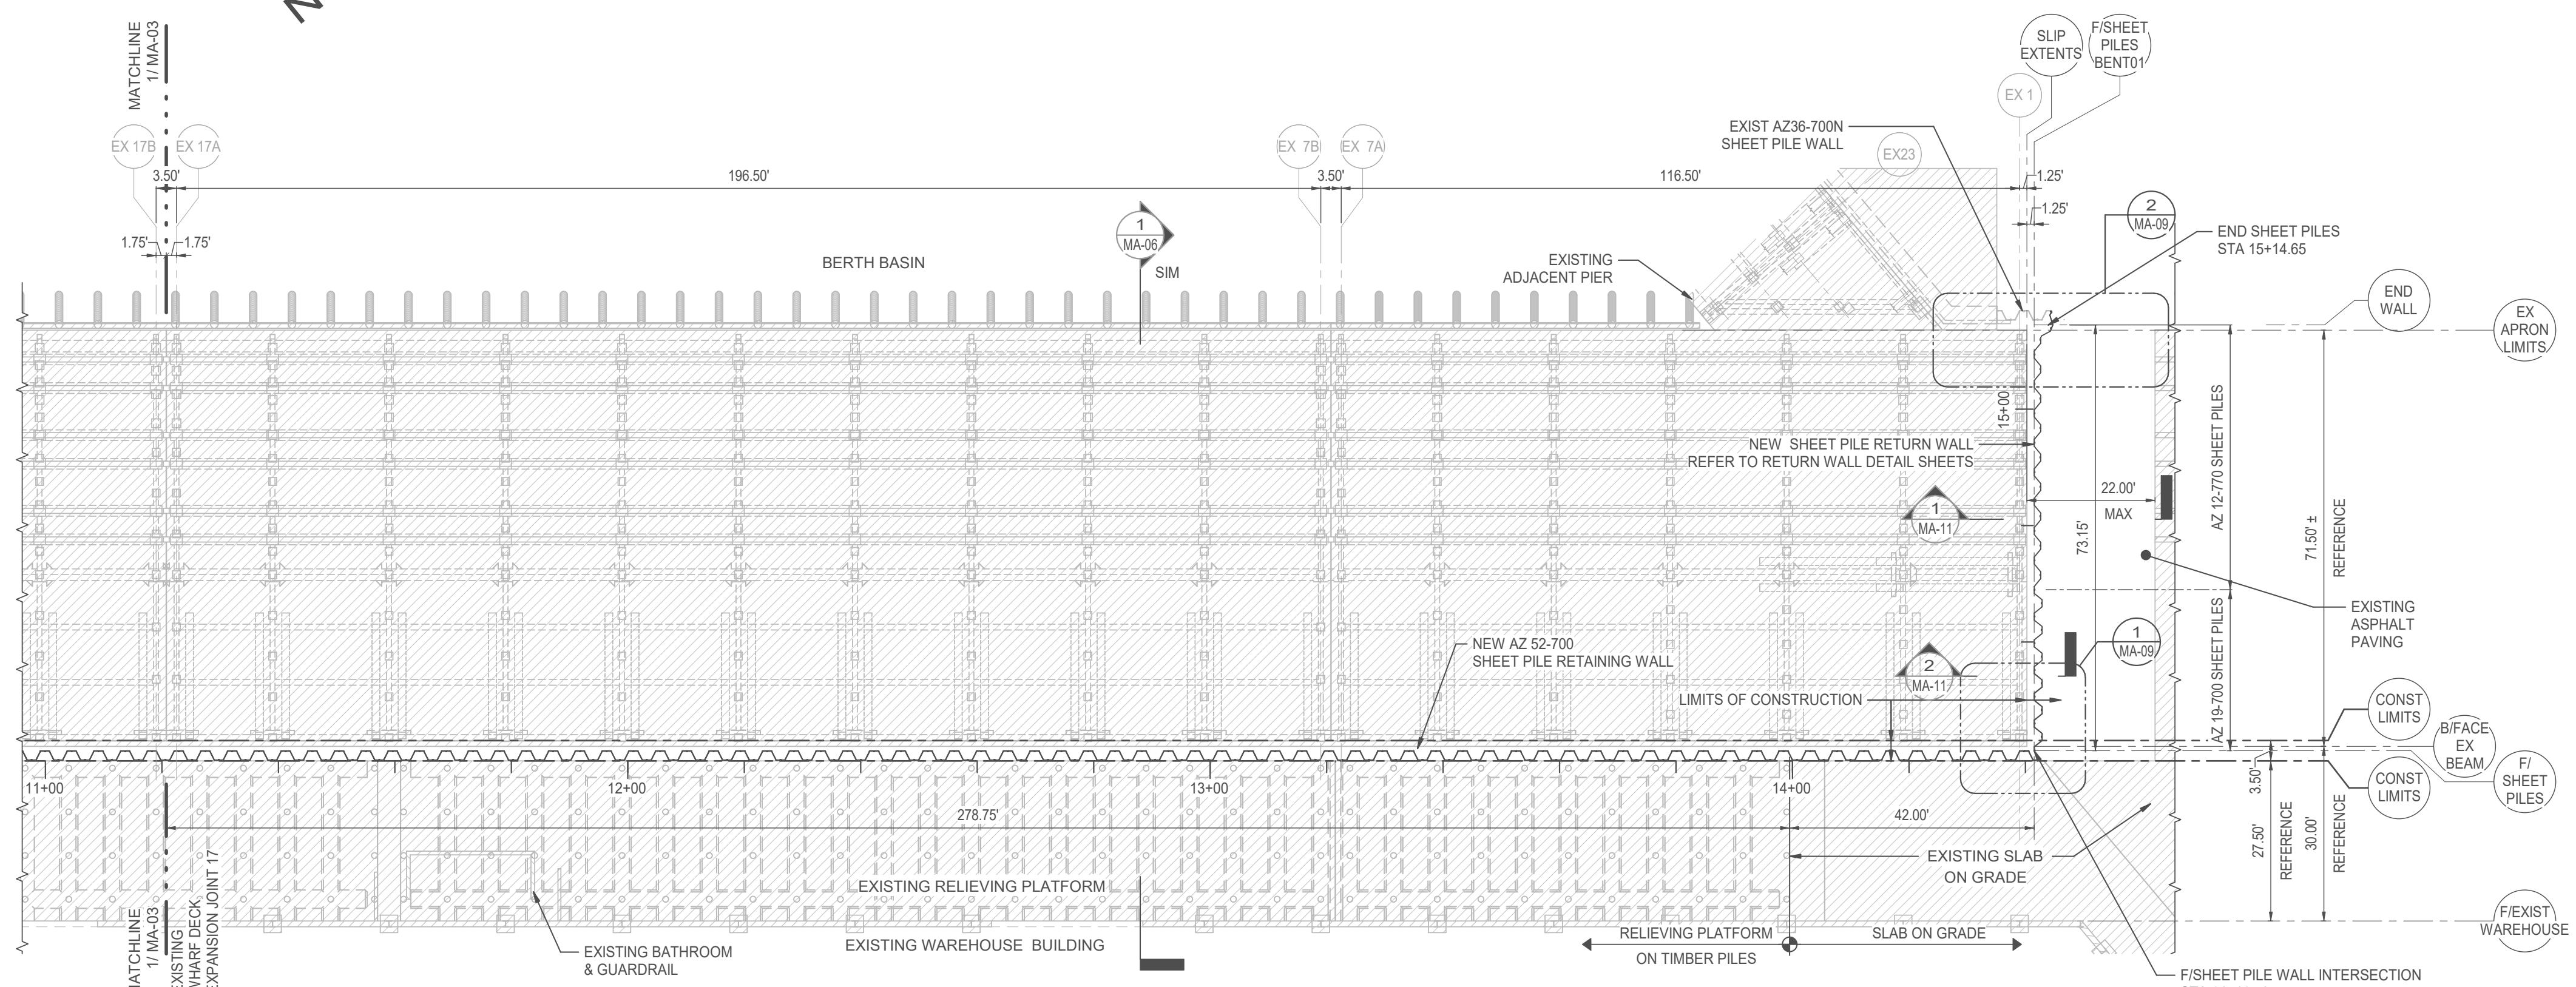


**2 AREA 5 NEW WALL LAYOUT PLAN**  
1" = 20'-0"

- LEGEND**
- INDICATES NEW AZ 52-700 SHEET PILE WALL (OR ZZ SHEET PILES OF THE SAME SIZE)
  - INDICATES NEW AZ 19-700 SHEET PILE WALL (OR ZZ SHEET PILES OF THE SAME SIZE)
  - INDICATES NEW AZ 12-770 SHEET PILE WALL (OR ZZ SHEET PILES OF THE SAME SIZE)
  - INDICATES EXISTING STRUCTURES
  - EX-# INDICATES EXISTING BENT REFER TO EXISTING DRAWINGS

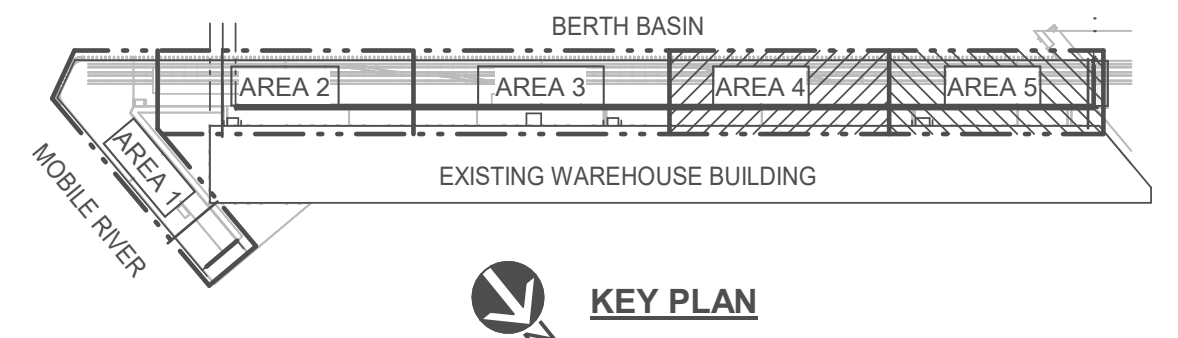


AS-BUILT INFORMATION SHOWN ON THIS DRAWING HAS BEEN OBSERVED AND SUPPLIED BY THE CONTRACTOR. MOTT MACDONALD DOES NOT ATTEST TO THE ACCURACY OF THE CONTRACTOR'S MARK-UPS, BUT SIGNIFICANT FIELD CHANGES SHOWN ON THE DRAWINGS WERE VERIFIED BY MOTT MACDONALD FOR CONFORMANCE WITH THE ORIGINAL DESIGN INTENT.

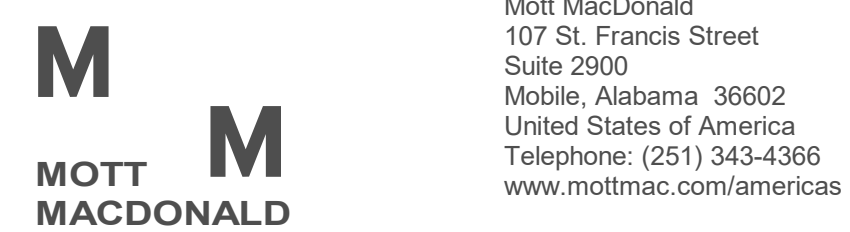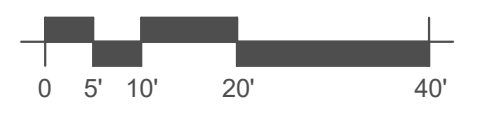

Mott MacDonald  
107 St. Francis Street  
Suite 2900  
Mobile, Alabama 36602  
United States of America  
Telephone: (251) 343-4366  
www.mottmac.com/americas

Client  
**ALABAMA STATE PORT AUTHORITY**  
MOBILE, ALABAMA

**LOWRY J. DENTY, P.E.**  
24892 ALABAMA - CERTIFICATION NUMBER

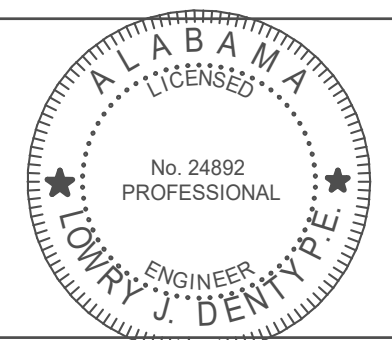

**AS-BUILT RECORD**

Rev	Date	Drawn	Description	Ch'kd	App'd
2	07-27-23	KWD	AS-BUILT RECORD DRAWINGS	CEL	LJD
1	05-18-22	KWD	ADD 1 ISSUED FOR CONST	CEL	LJD
0	01-14-22	KWD	ISSUED FOR BID	CEL	LJD

Project Number  
**397324**

Designed	JQ	Eng Check	KP
Drawn	KWD	Coordination	LJD
Dwg Check	CEL	Approved	BP
Scale at ANSI D	Status	Rev	Security
As Shown	IFC	1	STD
Drawing Number	<b>MA-03</b>		


Title  
**PIER B SOUTH**  
**NEW SHEET PILE WALL**  
**AREAS 4 & 5**  
**WALL PLANS**

This drawing is the property of Mott MacDonald and may not be reproduced without written permission. This document should not be relied on or used in circumstances other than those for which it was originally prepared and for which Mott MacDonald was commissioned. Mott MacDonald accepts no responsibility for this document to any party other than the person or entity by whom it was commissioned.


CONCRETE PILE CAP AS-BUILT ELEVATIONS

Benchmark	Northing	Easting	Elevation
2000	257597.24	1798667.44	9.721
2001	257594.03	1798665.66	9.532
2002	257643.82	1798578.86	9.423
2003	257646.84	1798580.59	9.317
2004	257696.13	1798494.63	9.302
2005	257693.14	1798493.01	9.394
2006	257743.86	1798404.62	9.323
2007	257746.79	1798406.16	9.172
2008	257794.64	1798322.76	8.963
2009	257791.62	1798321.43	9.081
2010	257841.39	1798234.79	9.239
2011	257844.34	1798236.46	9.102
2012	257894.61	1798149.04	9.250
2013	257891.51	1798147.55	9.427
2014	257940.43	1798062.31	9.339
2015	257943.55	1798063.80	9.211
2016	257992.96	1797977.59	9.408
2017	257990.00	1797975.95	9.460
2018	258041.97	1797891.90	9.176
2019	258039.16	1797890.31	9.290
2020	258096.02	1797798.09	9.483
2021	258093.94	1797797.04	9.479

NOTES:  
1. REFER TO PLANS FOR BENCHMARK LOCATIONS.


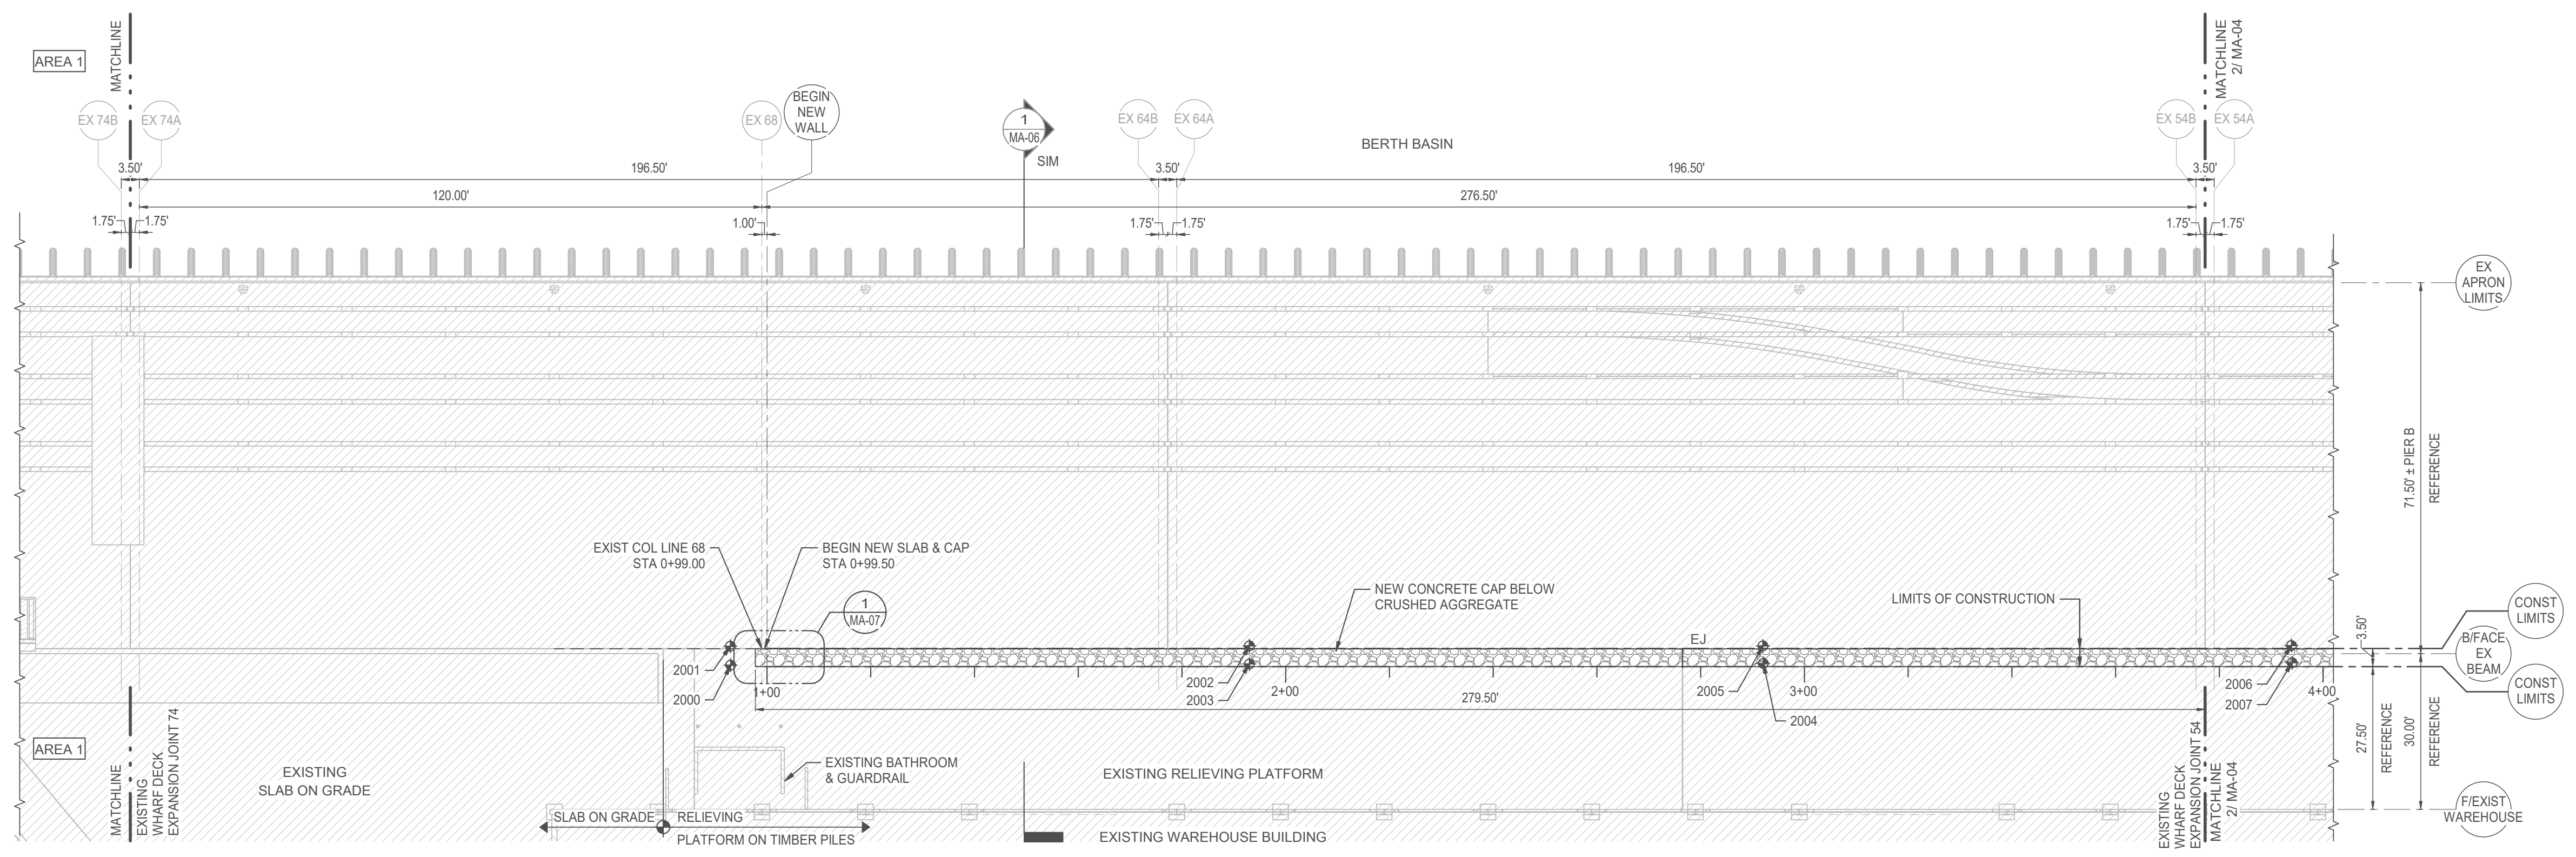


1 AREA 2 DECK PLAN  
1" = 20'-0"

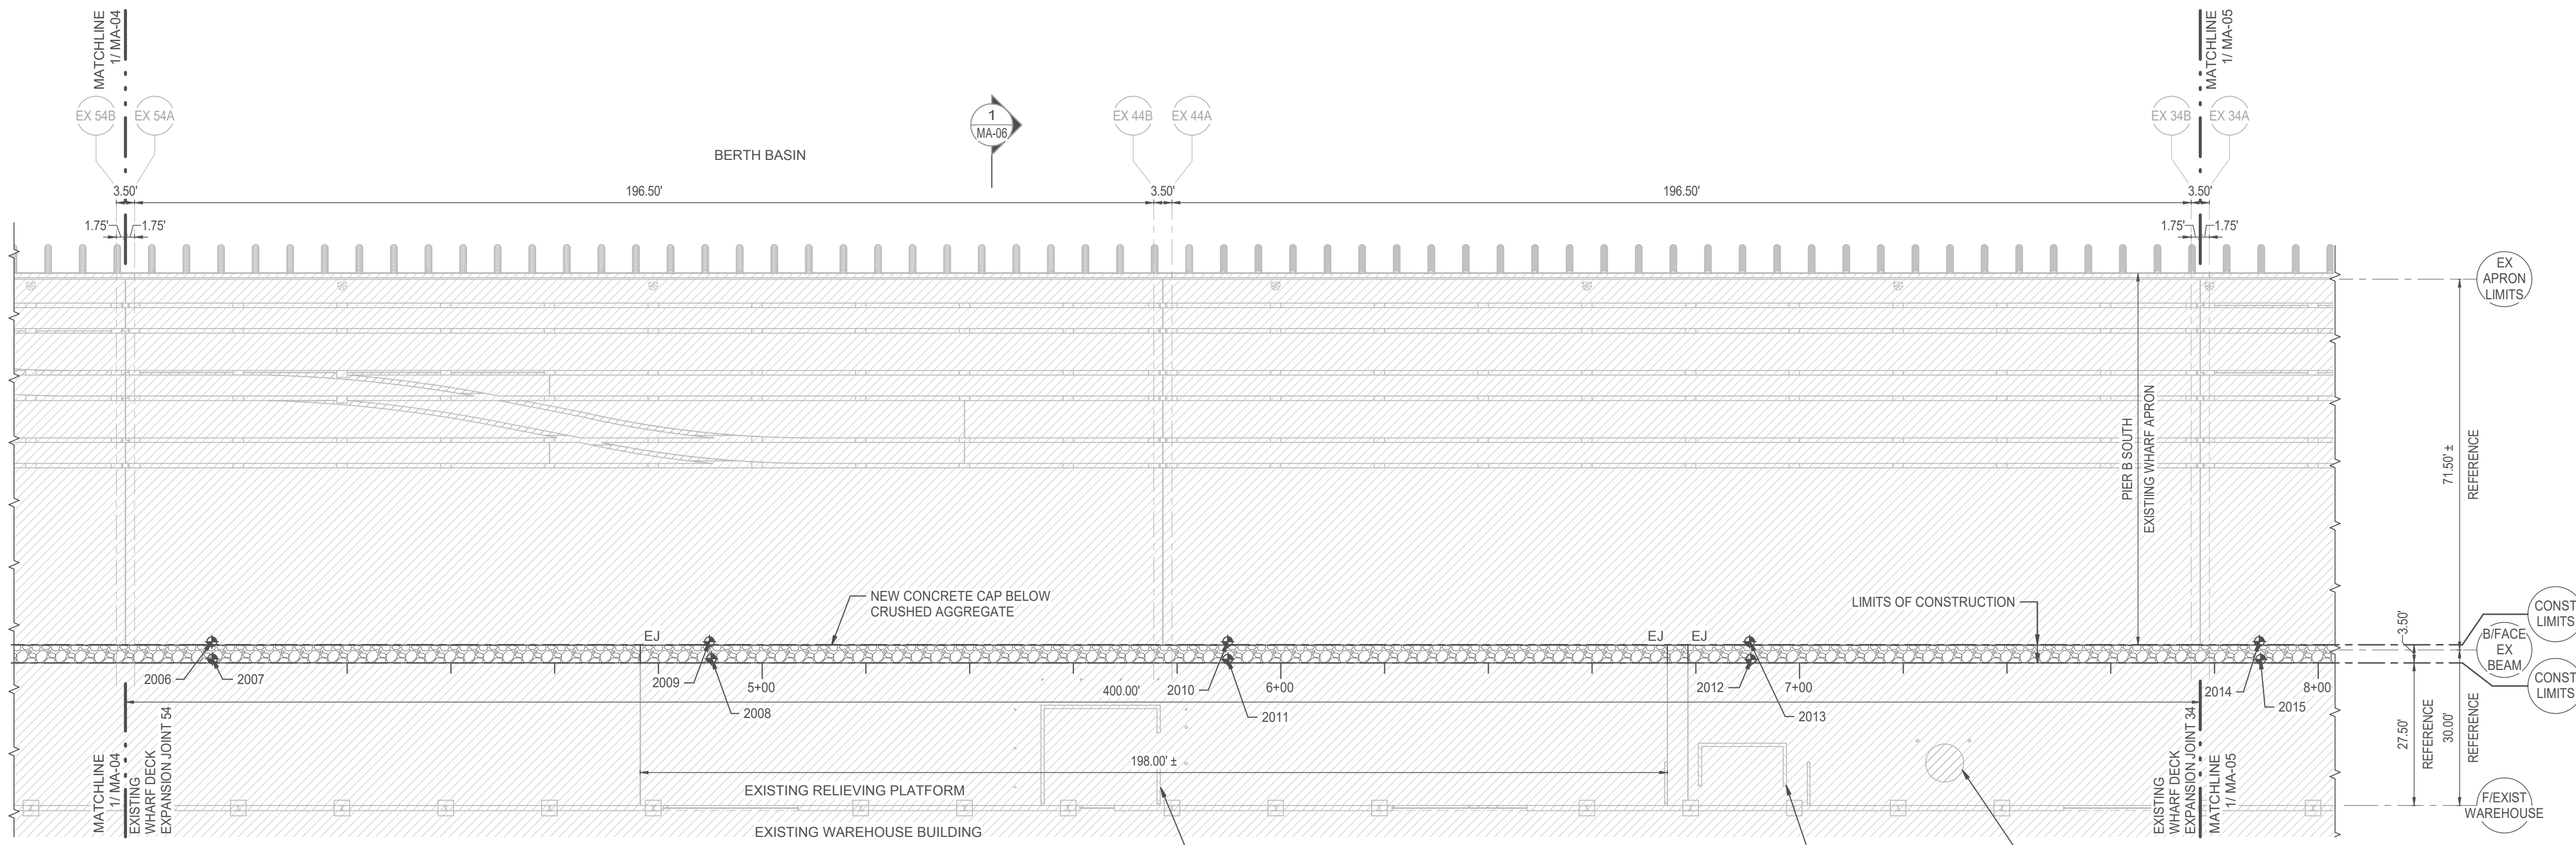

2 AREA 3 DECK PLAN  
1" = 20'-0"

- LEGEND
- INDICATES NEW CRUSHED AGGREGATE
  - INDICATES EXISTING STRUCTURES
  - EJ INDICATES EXISTING SLAB EXPANSION JOINT
  - EX# INDICATES EXISTING BENT REFER TO EXISTING DRAWINGS

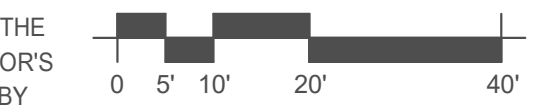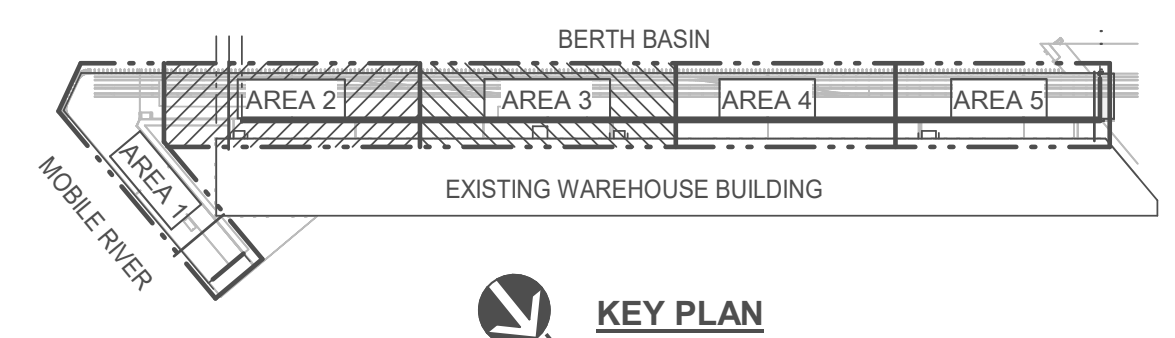

AS-BUILT INFORMATION SHOWN ON THIS DRAWING HAS BEEN OBSERVED AND SUPPLIED BY THE CONTRACTOR. MOTT MACDONALD DOES NOT ATTEST TO THE ACCURACY OF THE CONTRACTOR'S MARK-UPS, BUT SIGNIFICANT FIELD CHANGES SHOWN ON THE DRAWINGS WERE VERIFIED BY MOTT MACDONALD FOR CONFORMANCE WITH THE ORIGINAL DESIGN INTENT.

SHEET PILE WALL REPLACEMENT

PIER B SOUTH


397324

Mott MacDonald  
107 St. Francis Street  
Suite 2900  
Mobile, Alabama 36602  
United States of America  
Telephone: (251) 343-4366  
www.mottmac.com/americas

Client  
**ALABAMA STATE PORT AUTHORITY**  
MOBILE, ALABAMA

Rev	Date	Drawn	Description	Ch'kd	App'd
2	07-27-23	KWD	AS-BUILT RECORD DRAWINGS	CEL	LJD
1	05-18-22	KWD	ADD 1 ISSUED FOR CONST	CEL	LJD
0	01-14-22	KWD	ISSUED FOR BID	CEL	LJD

**LOWRY J. DENTY, P.E.**  
24892 ALABAMA - CERTIFICATION NUMBER

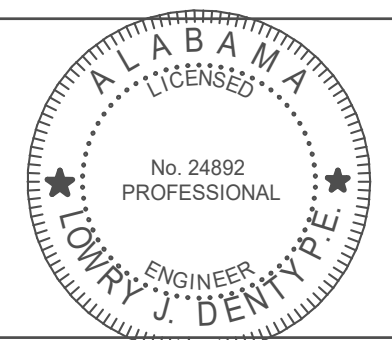

**AS-BUILT RECORD**  
Project Number **397324**

Designed	JQ	Eng Check	KP
Drawn	KWD	Coordination	LJD
Dwg Check	CEL	Approved	BP
Scale at ANST D	Status	Rev	Security
As Shown	IFC	1	STD
Drawing Number	<b>MA-04</b>		

Title  
**PIER B SOUTH**  
**NEW SHEET PILE WALL**  
**AREAS 2 & 3**  
**RELIEVING PLATFORM DECK REPAIR**  
**PLANS**


This drawing is the property of Mott MacDonald and may not be reproduced without written permission. This document should not be relied on or used in circumstances other than those for which it was originally prepared and for which Mott MacDonald was commissioned. Mott MacDonald accepts no responsibility for this document to any party other than the person or entity by whom it was commissioned.









SHEET PILE WALL REPLACEMENT

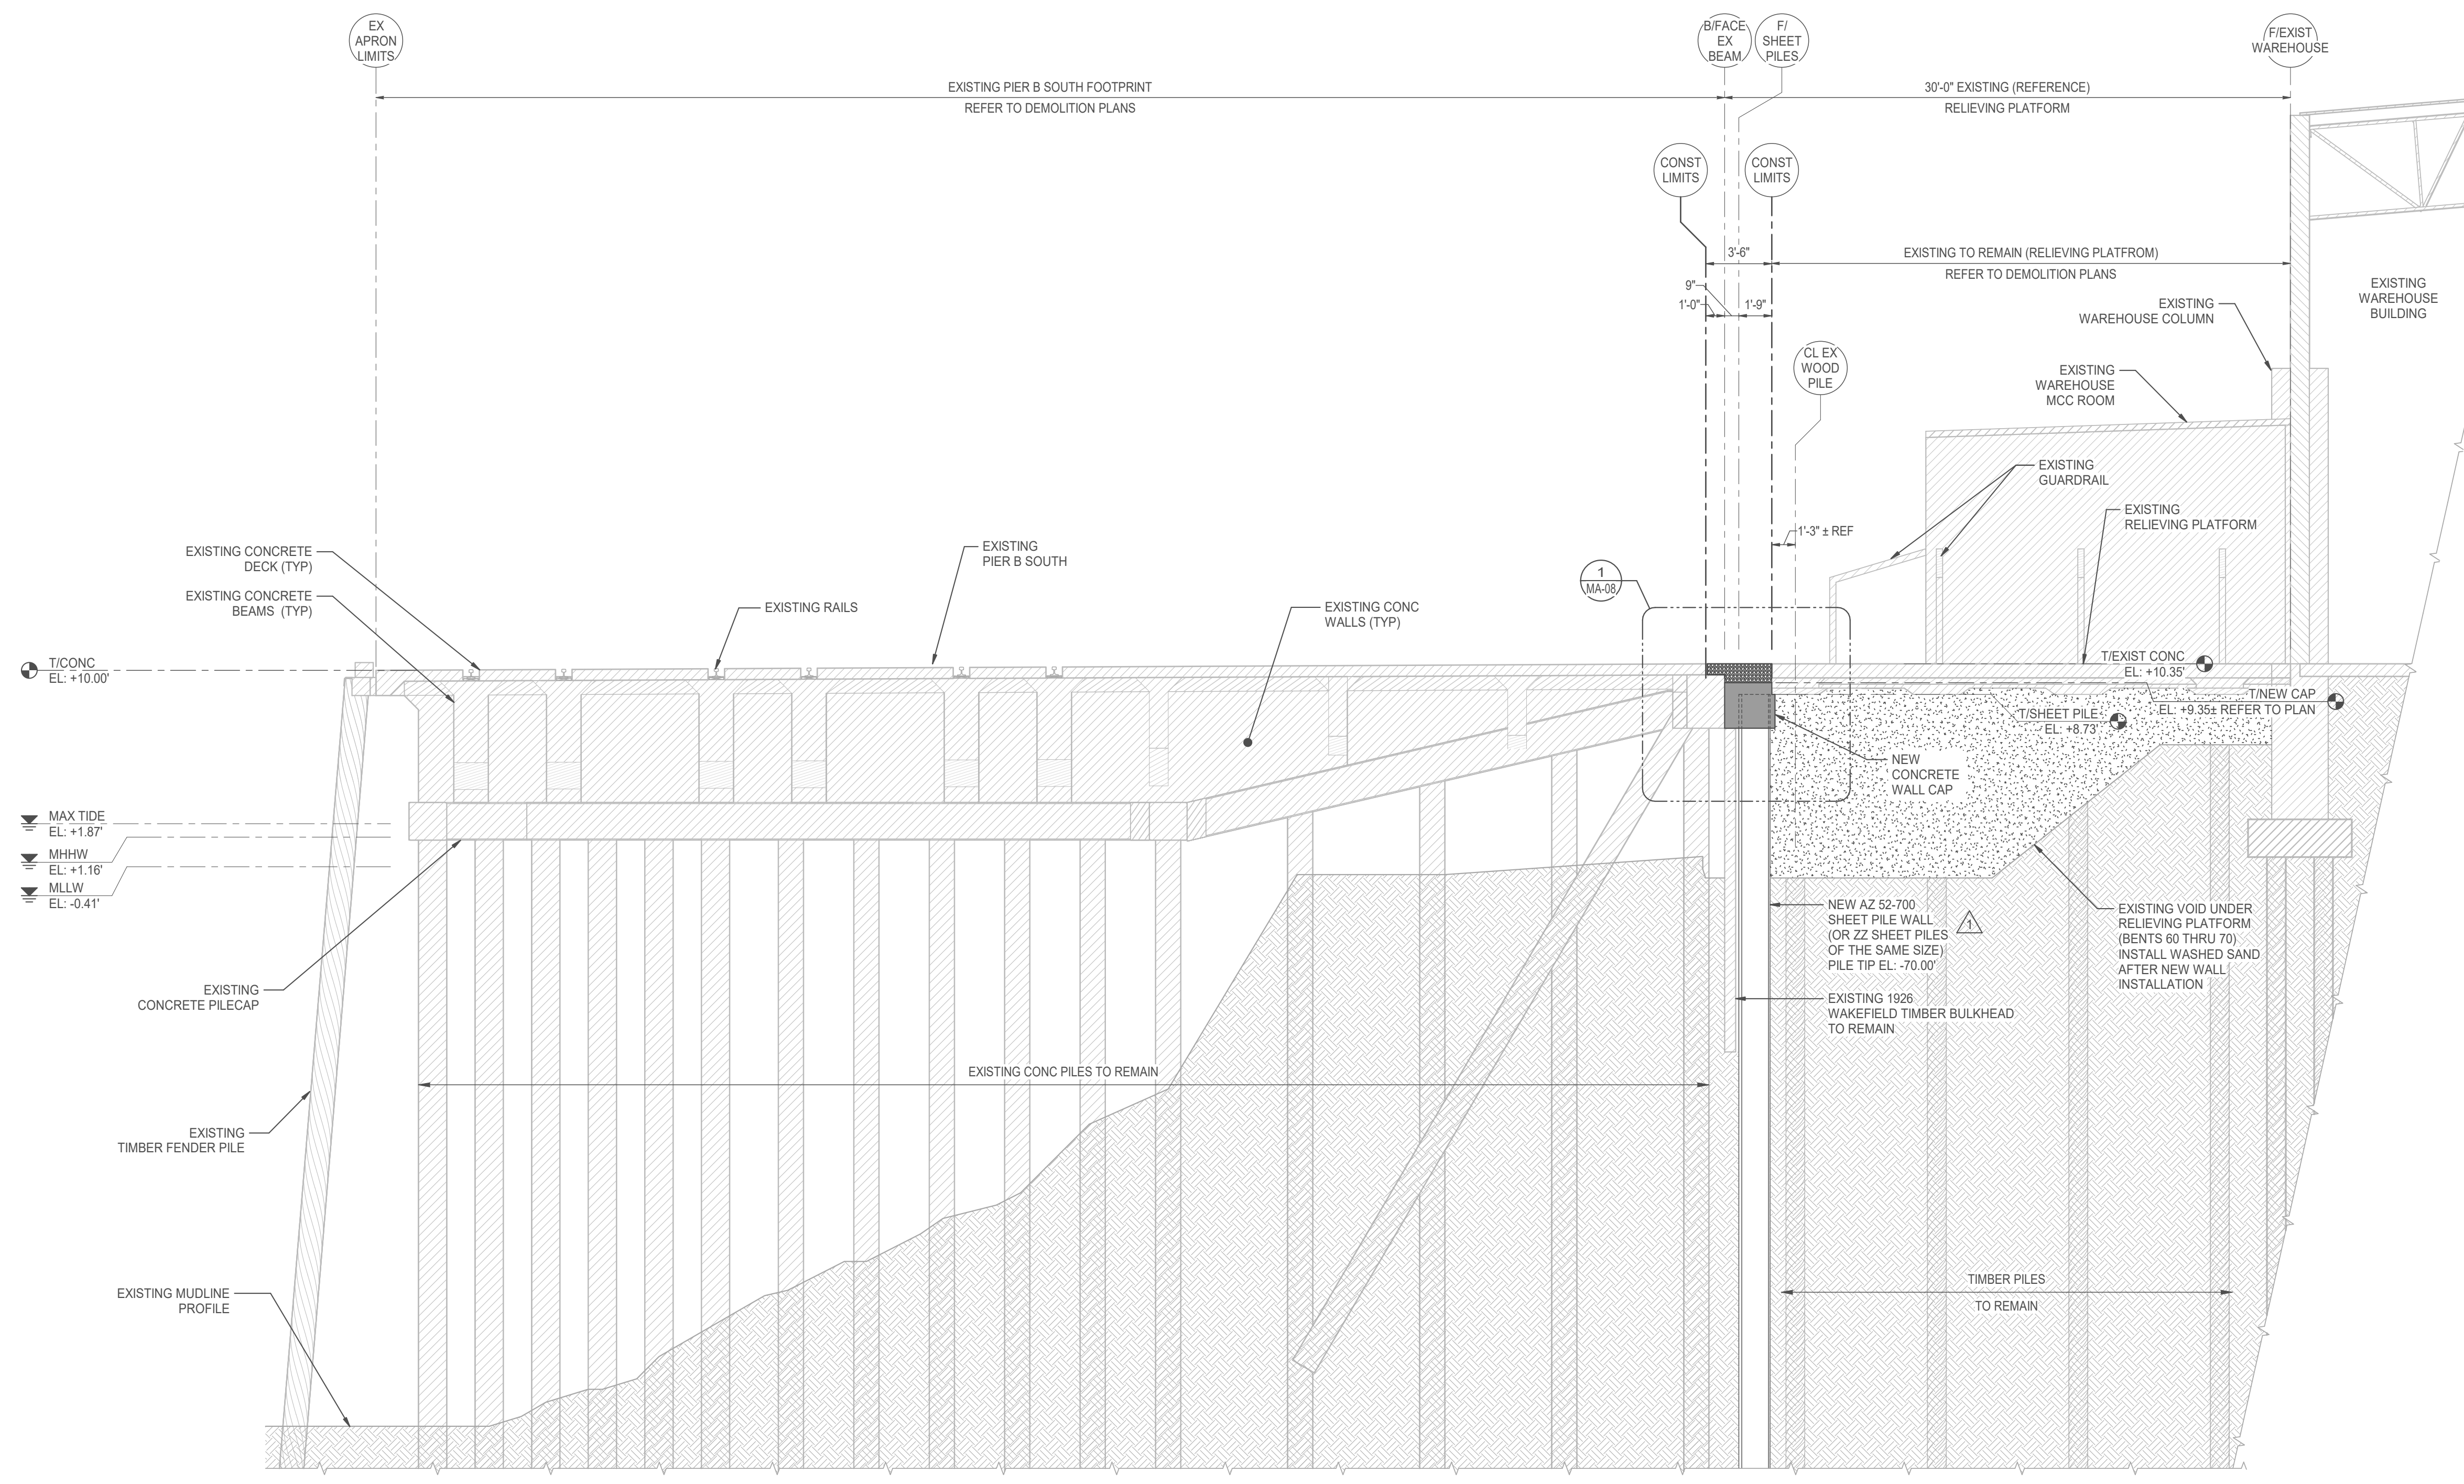PIER B SOUTH

397324

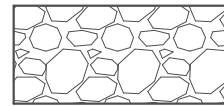

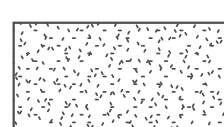**NOTE:**  
WATER LEVEL DATA IS FROM NOAA TIDE DATA WEB SITE FOR MOBILE STATE DOCKS. DATUM NAVD 88

- LEGEND**
-  INDICATES NEW CRUSHED AGGREGATE
  -  INDICATES NEW CONCRETE
  -  INDICATES EXISTING STRUCTURES
  -  INDICATES FLOWABLE FILL
  -  INDICATES EXISTING SOIL
  -  EX # INDICATES EXISTING BENT REFER TO EXISTING DRAWINGS
  - MHHW INDICATES MEAN HIGHER-HIGH WATER
  - MLLW INDICATES MEAN LOWER-LOW WATER
  - MAX TIDE INDICATES HIGHEST OBSERVED TIDE 10-08-2017

**1** TYPICAL RETAINING WALL SECTION  
3/16" = 1'-0"

AS-BUILT INFORMATION SHOWN ON THIS DRAWING HAS BEEN OBSERVED AND SUPPLIED BY THE CONTRACTOR. MOTT MACDONALD DOES NOT ATTEST TO THE ACCURACY OF THE CONTRACTOR'S MARK-UPS, BUT SIGNIFICANT FIELD CHANGES SHOWN ON THE DRAWINGS WERE VERIFIED BY MOTT MACDONALD FOR CONFORMANCE WITH THE ORIGINAL DESIGN INTENT.




Mott MacDonald  
107 St. Francis Street  
Suite 2900  
Mobile, Alabama 36602  
United States of America  
Telephone: (251) 343-4366  
www.mottmac.com/america

Client  
**ALABAMA STATE PORT AUTHORITY**  
MOBILE, ALABAMA

Rev	Date	Drawn	Description	Ch'k'd	App'd
2	07-27-23	KWD	AS-BUILT RECORD DRAWINGS	CEL	LJD
1	05-18-22	KWD	ADD 1 ISSUED FOR CONST	CEL	LJD
0	01-14-22	KWD	ISSUED FOR BID	CEL	LJD

**LOWRY J. DENTY, P.E.**  
24892 ALABAMA - CERTIFICATION NUMBER

AS-BUILT RECORD

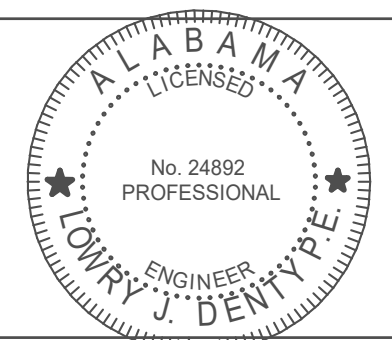

Project Number  
**397324**

Designed	JQ	Eng Check	KP
Drawn	KWD	Coordination	LJD
Dwg Check	CEL	Approved	BP
Scale at ANSI D As Shown	Status IFC	Rev 1	Security STD
Drawing Number <b>MA-06</b>			


Title  
**PIER B SOUTH**  
**NEW SHEET PILE WALL AREAS 2, 3, 4, & 5 TYPICAL SECTION THRU NEW WALL**

SHEET PILE WALL REPLACEMENT

PIER B SOUTH

397324



7/31/2023 3:53:08 PM

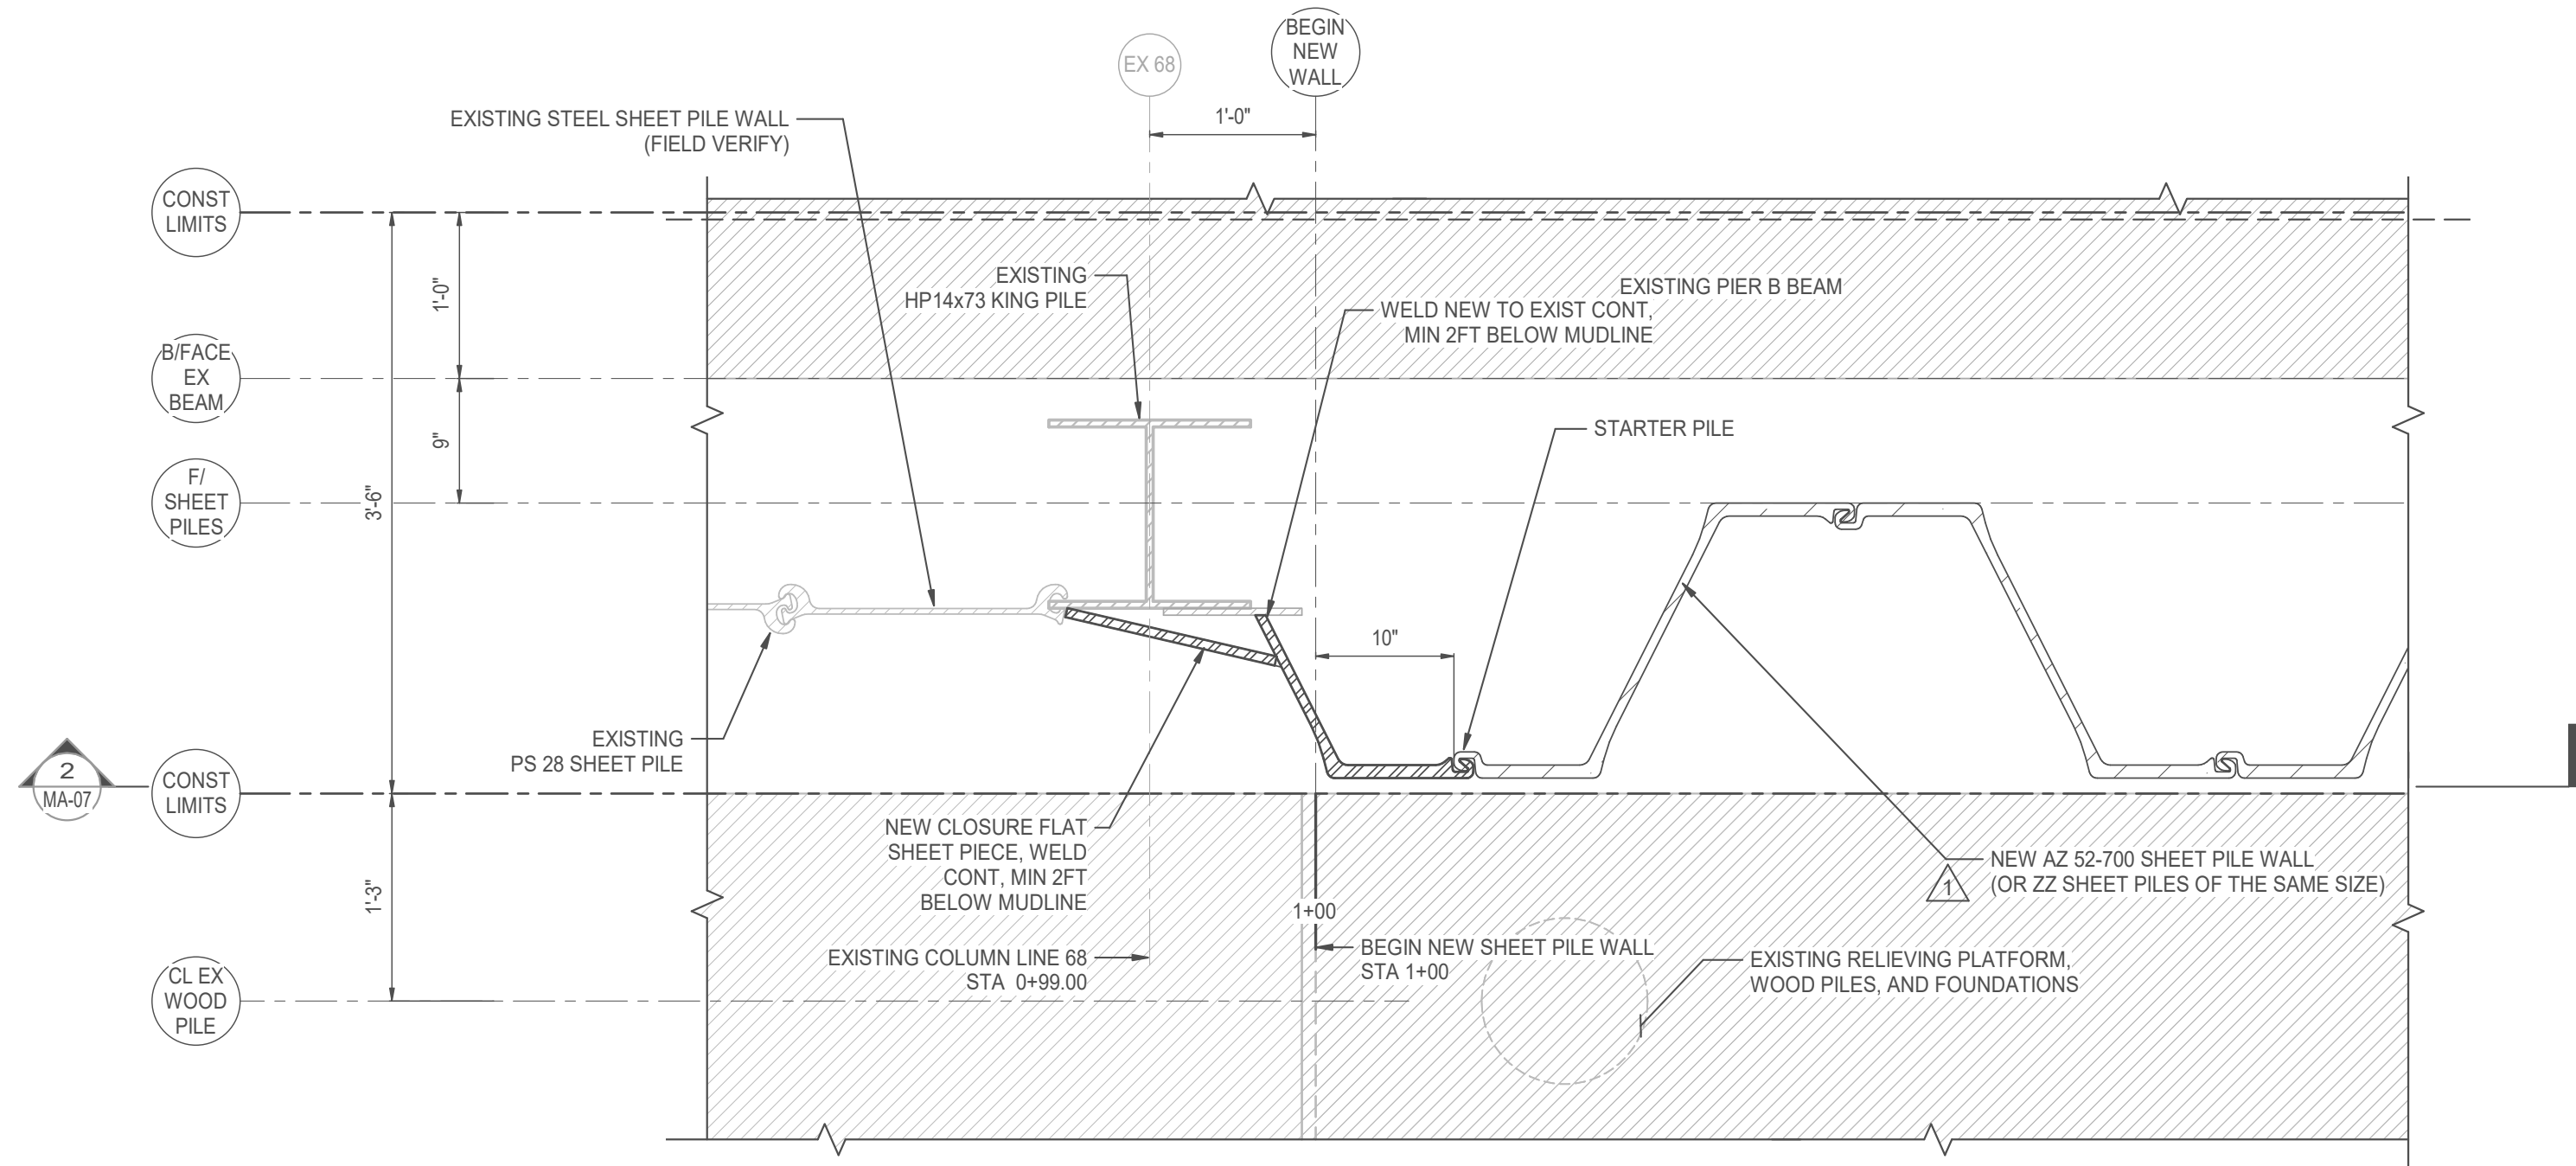

NOTE:  
CONTRACTOR SHALL VERIFY EXISTING STEEL WALL  
CONDITIONS PRIOR TO ORDERING AND SETTING STARTER PILE



**1 PARTIAL PLAN AT EXISTING BENT 68**  
1" = 1'-0"

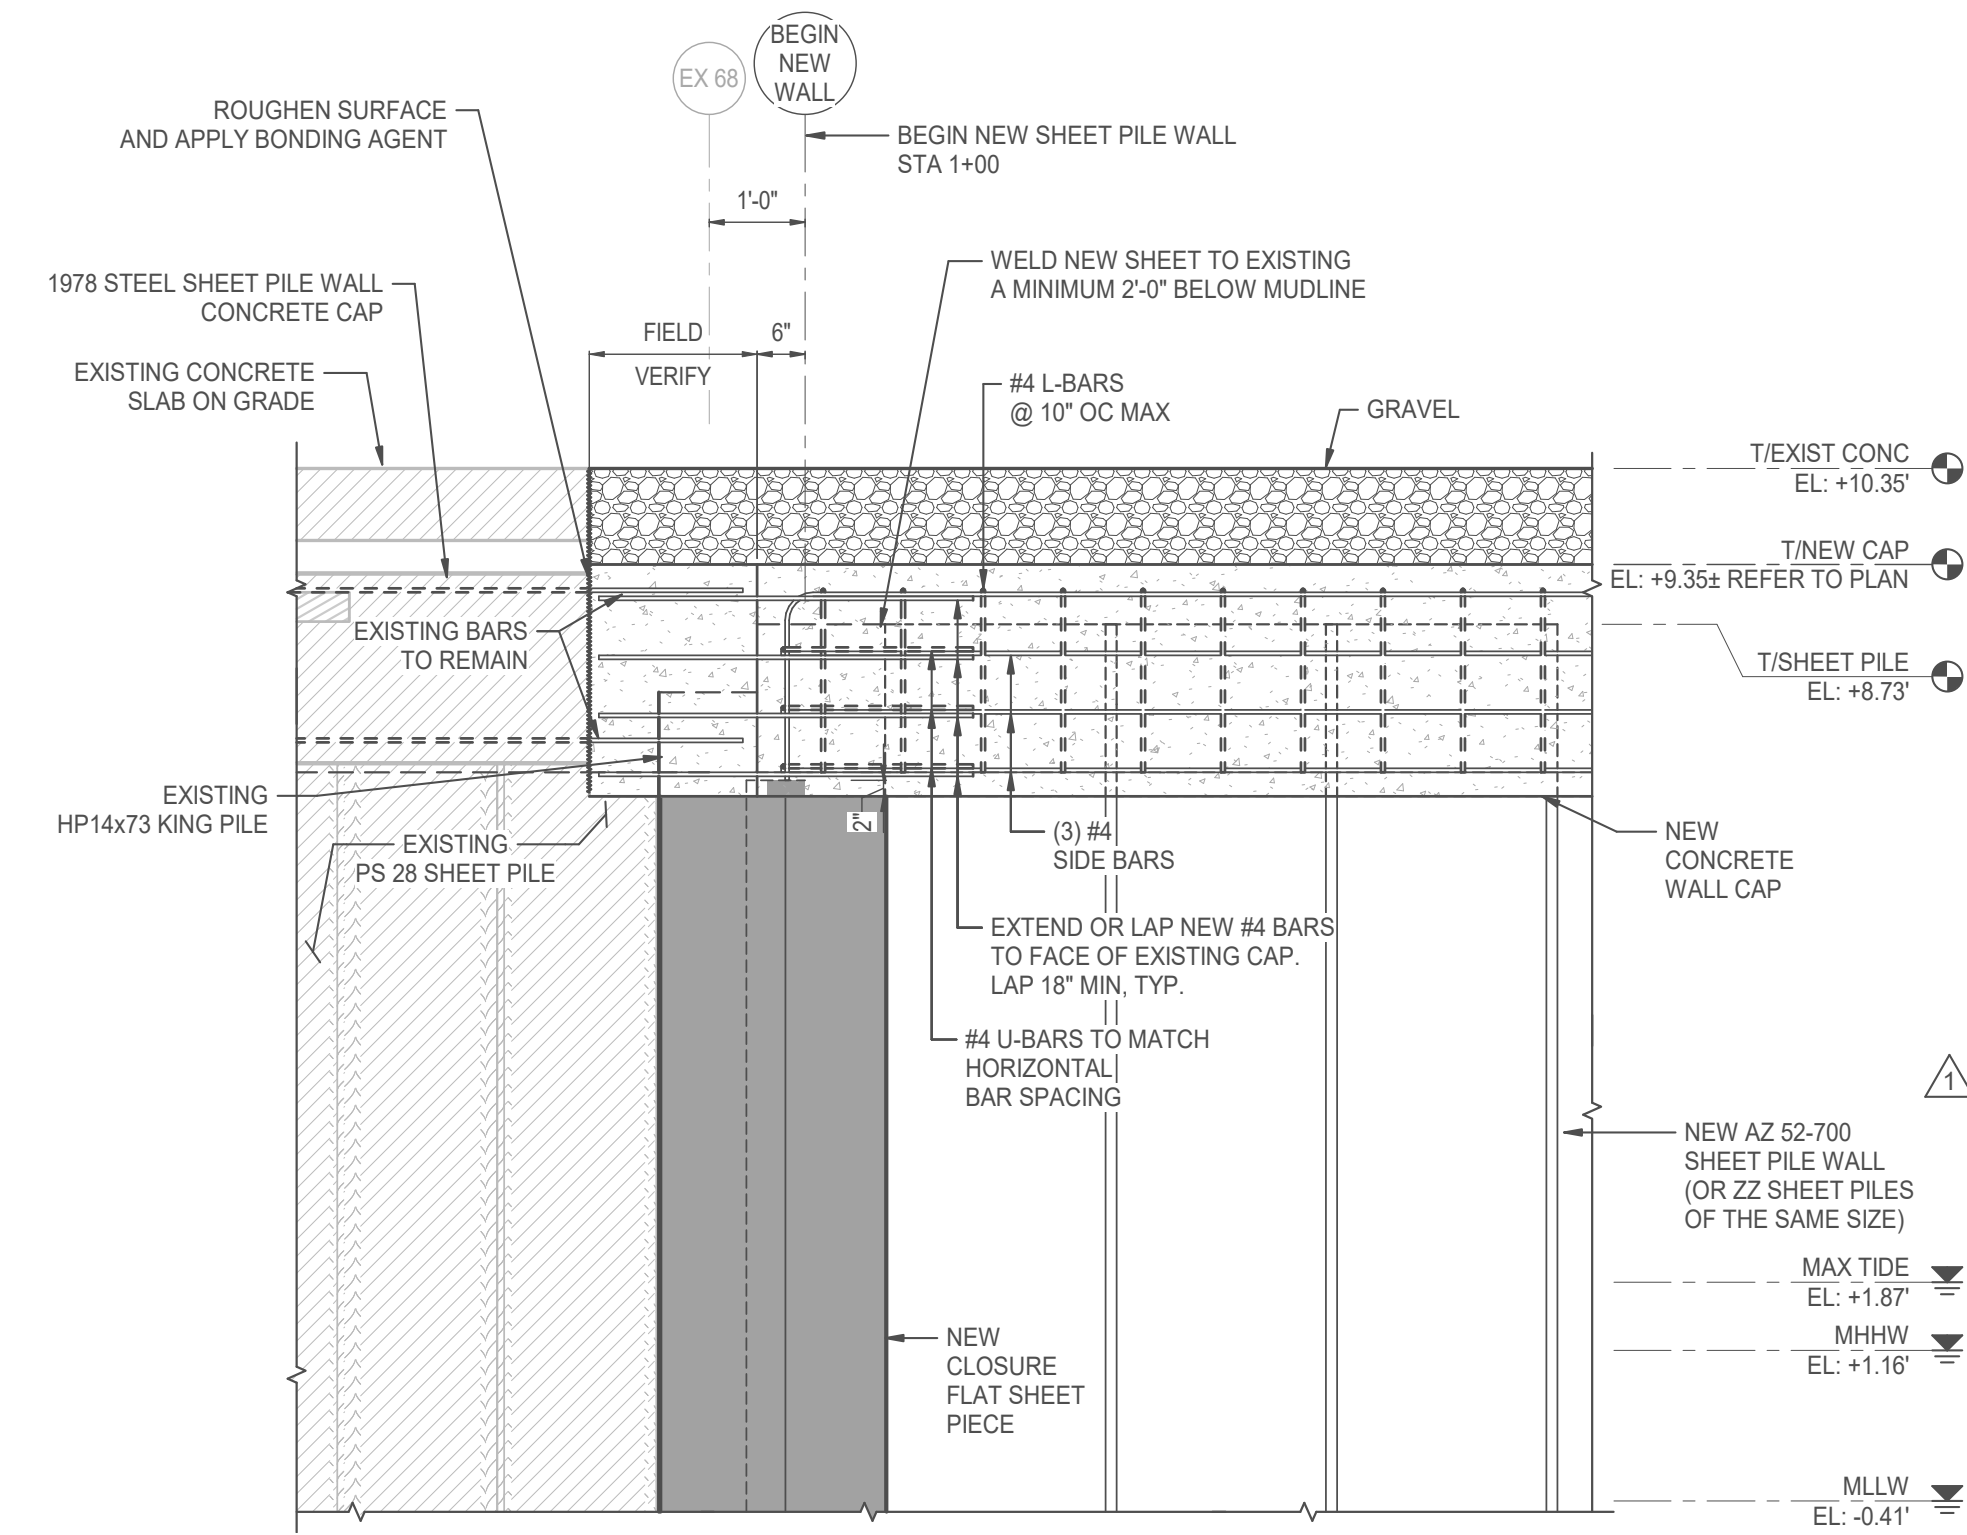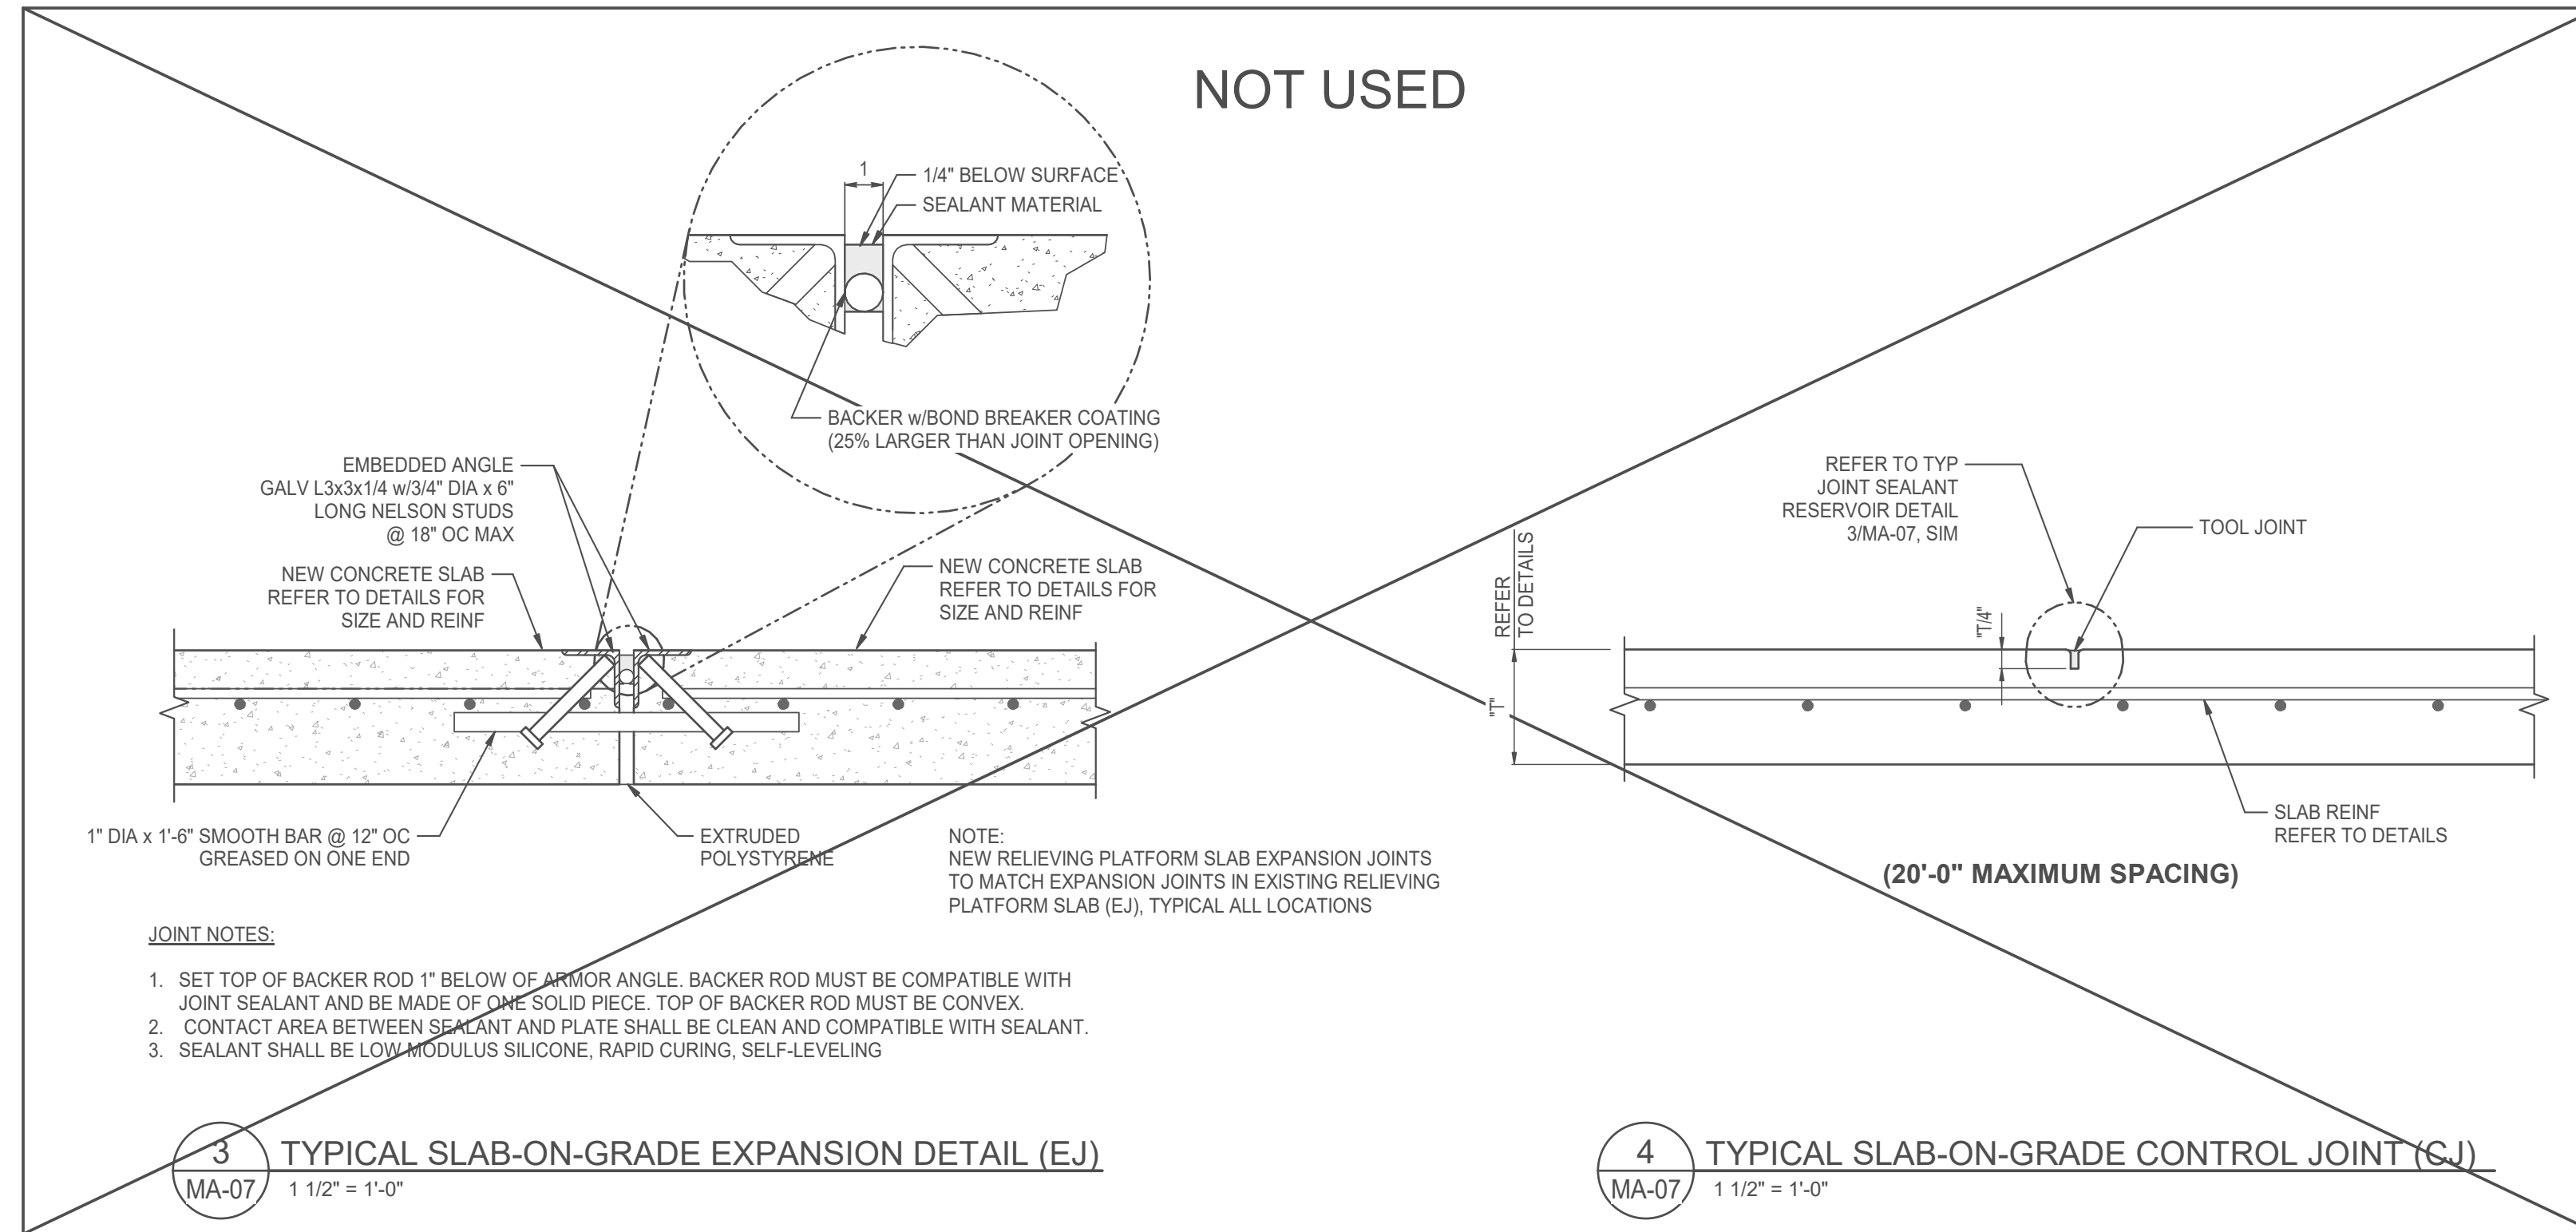

**2 ELEVATION AT EXISTING BENT 68**  
1/2" = 1'-0"

**LEGEND**

	INDICATES EXISTING STRUCTURES
	INDICATES EXISTING BENT REFER TO EXISTING DRAWINGS
MHHW	INDICATES MEAN HIGHER-HIGH WATER
MLLW	INDICATES MEAN LOWER-LOW WATER
MAX TIDE	INDICATES HIGHEST OBSERVED TIDE 10-08-2017

AS-BUILT INFORMATION SHOWN ON THIS DRAWING HAS BEEN OBSERVED AND SUPPLIED BY THE CONTRACTOR. MOTT MACDONALD DOES NOT ATTEST TO THE ACCURACY OF THE CONTRACTOR'S MARK-UPS, BUT SIGNIFICANT FIELD CHANGES SHOWN ON THE DRAWINGS WERE VERIFIED BY MOTT MACDONALD FOR CONFORMANCE WITH THE ORIGINAL DESIGN INTENT.




Mott MacDonald  
107 St. Francis Street  
Suite 2900  
Mobile, Alabama 36602  
United States of America  
Telephone: (251) 343-4366  
www.mottmac.com/america

Client  
**ALABAMA STATE  
PORT AUTHORITY**  
  
MOBILE, ALABAMA

Rev	Date	Drawn	Description	Ch'kd	App'd
2	07-27-23	KWD	AS-BUILT RECORD DRAWINGS	CEL	LJD
1	05-18-22	KWD	ADD 1 ISSUED FOR CONST	CEL	LJD
0	01-14-22	KWD	ISSUED FOR BID	CEL	LJD

**LOWRY J. DENTY, P.E.**  
24892 ALABAMA - CERTIFICATION NUMBER  
  
AS-BUILT  
RECORD

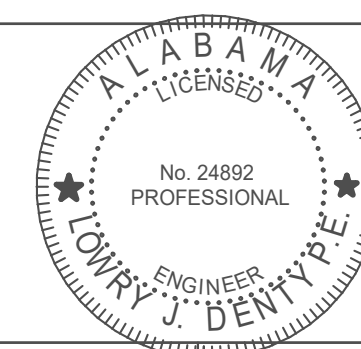

Project Number  
**397324**

Designed	JQ	Eng Check	KP
Drawn	KWD	Coordination	LJD
Dwg Check	CEL	Approved	BP
Scale at ANSI D As Shown	Status IFC	Rev 1	Security STD
Drawing Number	<b>MA-07</b>		

Title  
**PIER B SOUTH  
NEW SHEET PILE WALL  
DETAILS**



SHEET PILE WALL REPLACEMENT

PIER B SOUTH

397324

7/31/2023 3:53:16 PM



Mott MacDonald  
107 St. Francis Street  
Suite 2900  
Mobile, Alabama 36602  
United States of America  
Telephone: (251) 343-4366  
www.mottmac.com/americas


Client  
**ALABAMA STATE  
PORT AUTHORITY**

MOBILE, ALABAMA

Rev	Date	Drawn	Description	Ch'k'd	App'd
2	07-27-23	KWD	AS-BUILT RECORD DRAWINGS	CEL	LJD
1	05-18-22	KWD	ADD 1 ISSUED FOR CONST	CEL	LJD
0	01-14-22	KWD	ISSUED FOR BID	CEL	LJD

**LOWRY J. DENTY, P.E.**  
24892 ALABAMA - CERTIFICATION NUMBER

**AS-BUILT  
RECORD**

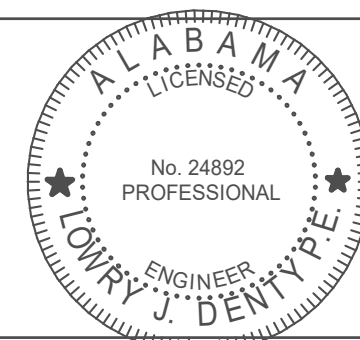

Project Number  
**397324**


B/O

Total


Designed	JQ	Eng Check	KP
Drawn	KWD	Coordination	LJD
Dwg Check	CEL	Approved	BP
Scale at ANSI D As Shown	Status IFC	Rev 1	Security STD
Drawing Number		<b>MA-09</b>	

Title  
**PIER B SOUTH  
NEW SHEET PILE WALL  
DETAILS**


AS-BUILT INFORMATION SHOWN ON THIS DRAWING HAS BEEN OBSERVED AND SUPPLIED BY THE CONTRACTOR. MOTT MACDONALD DOES NOT ATTEST TO THE ACCURACY OF THE CONTRACTOR'S MARK-UPS, BUT SIGNIFICANT FIELD CHANGES SHOWN ON THE DRAWINGS WERE VERIFIED BY MOTT MACDONALD FOR CONFORMANCE WITH THE ORIGINAL DESIGN INTENT.

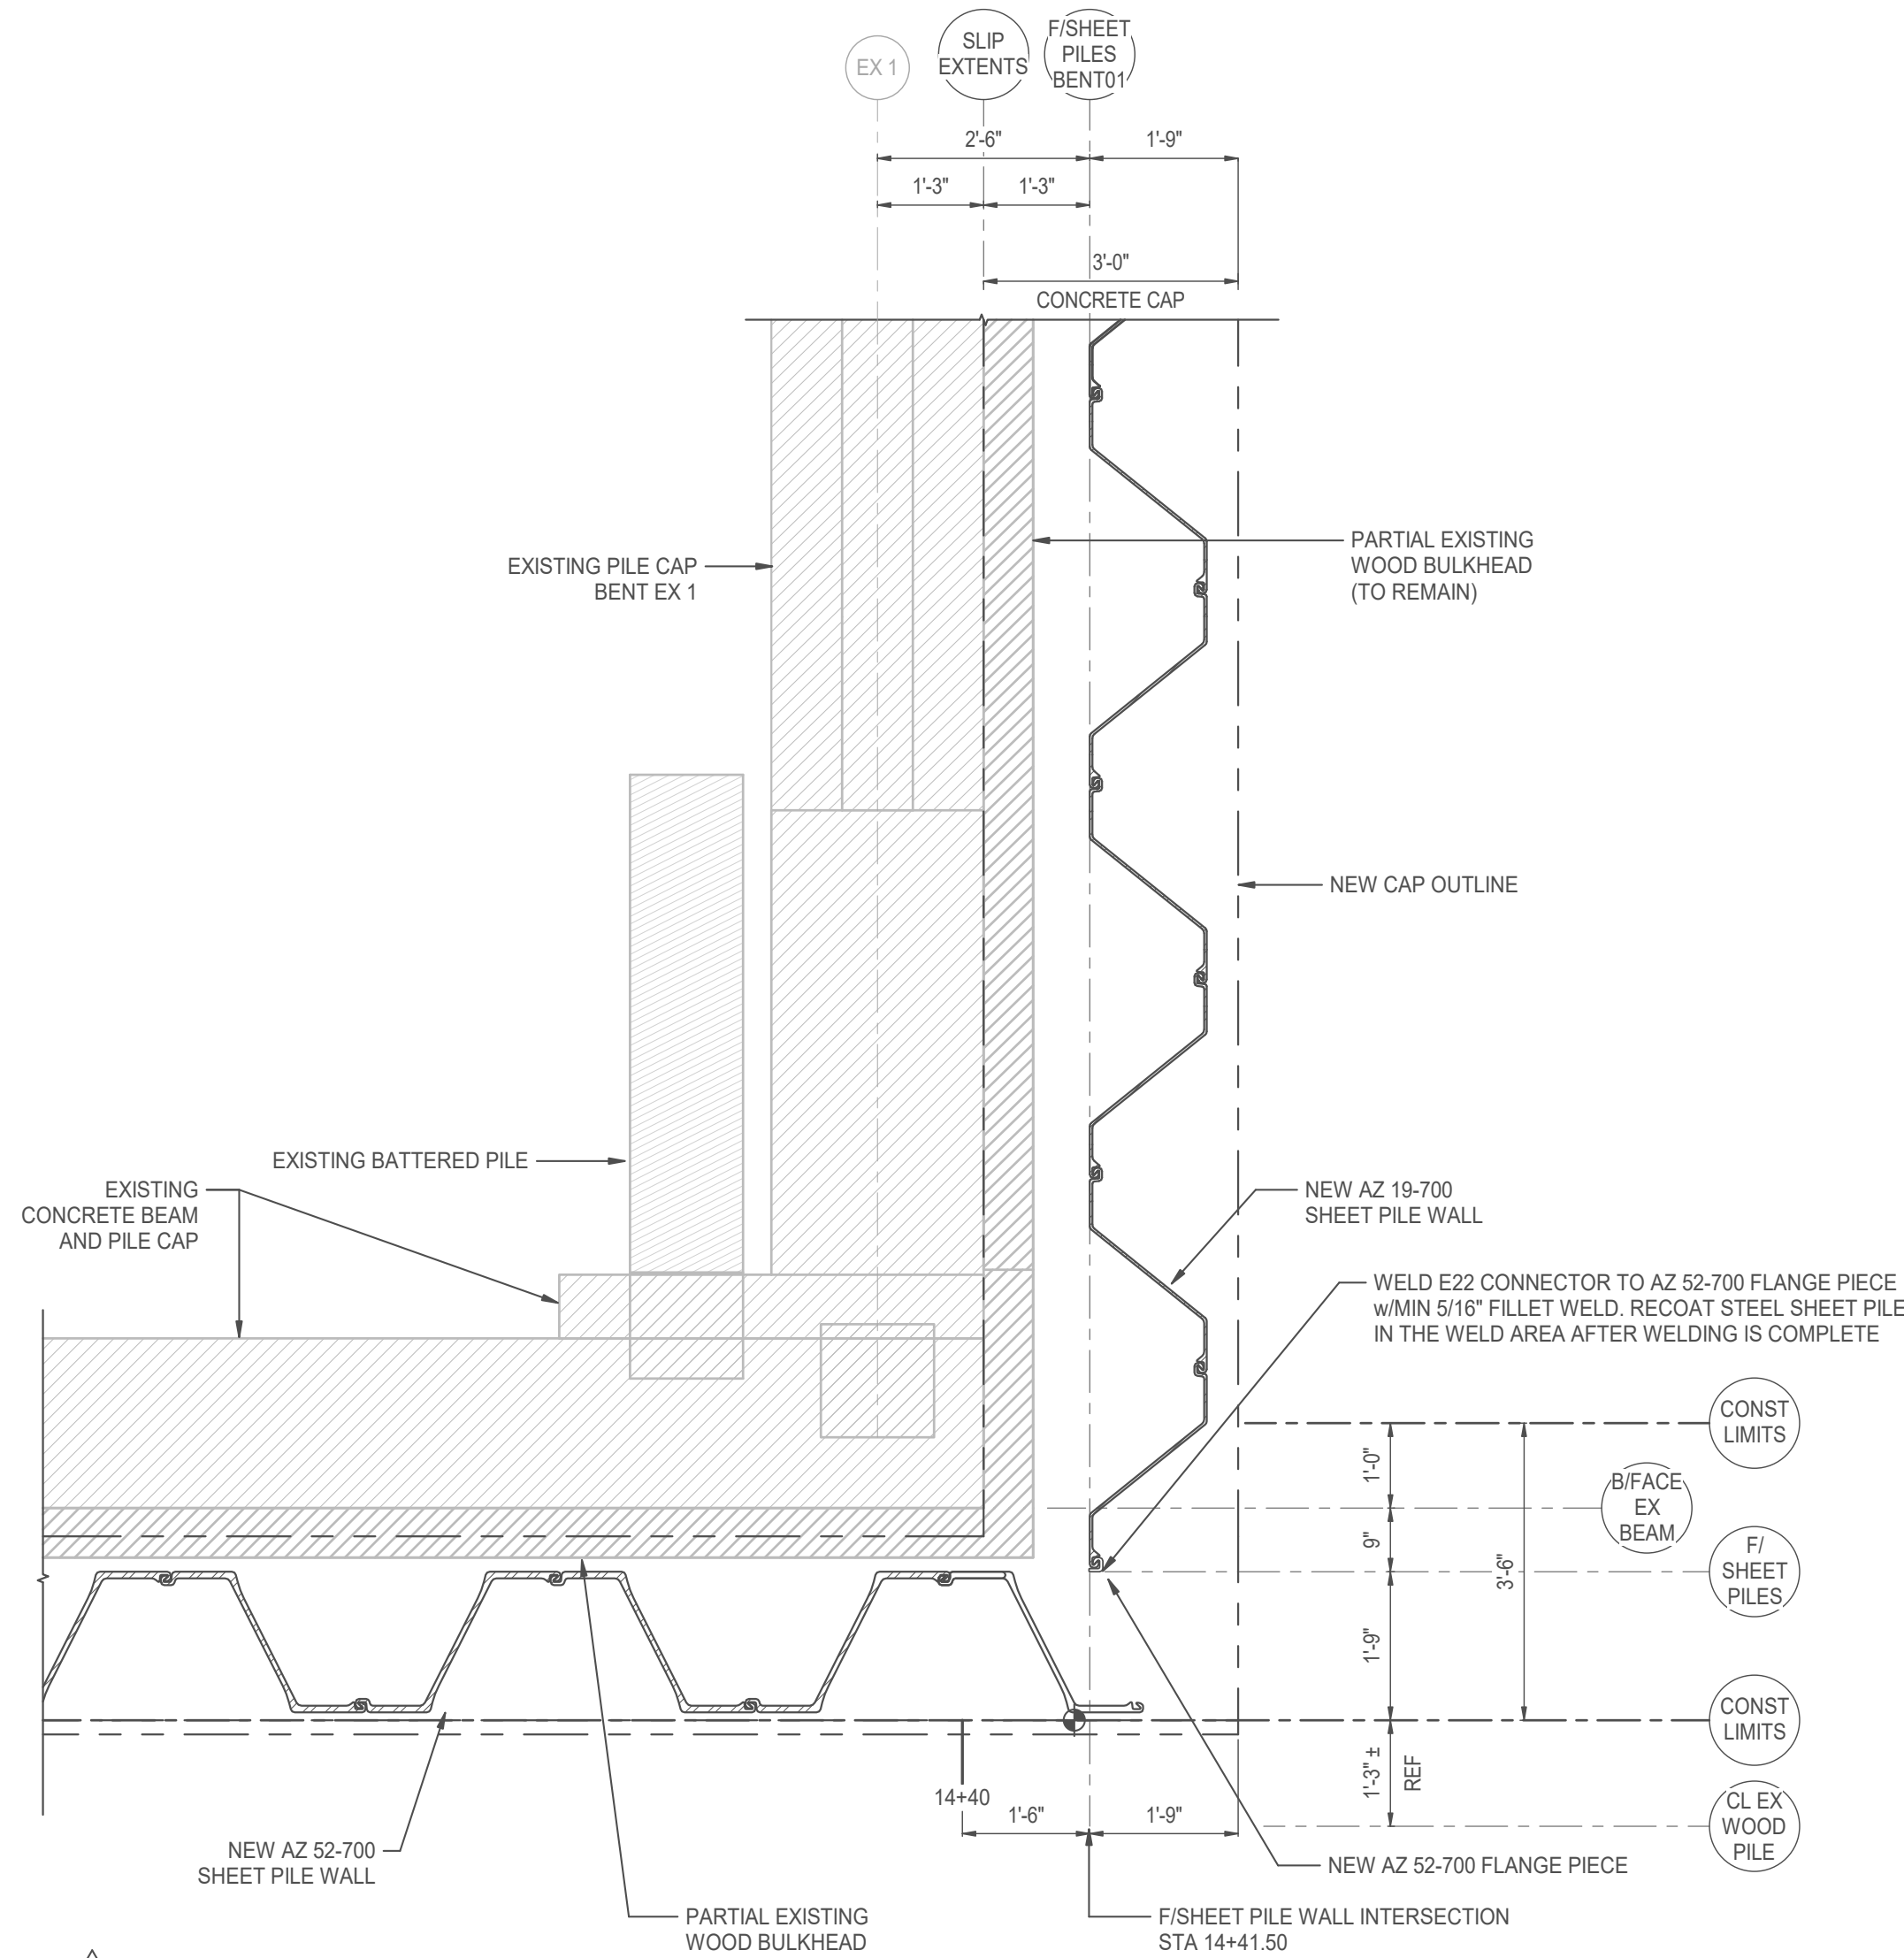

NOTE:  
ZZ SHEET PILE SECTIONS CAN BE USED IN LIEU OF AZ SHEET PILE SECTIONS OF THE SAME SIZE.

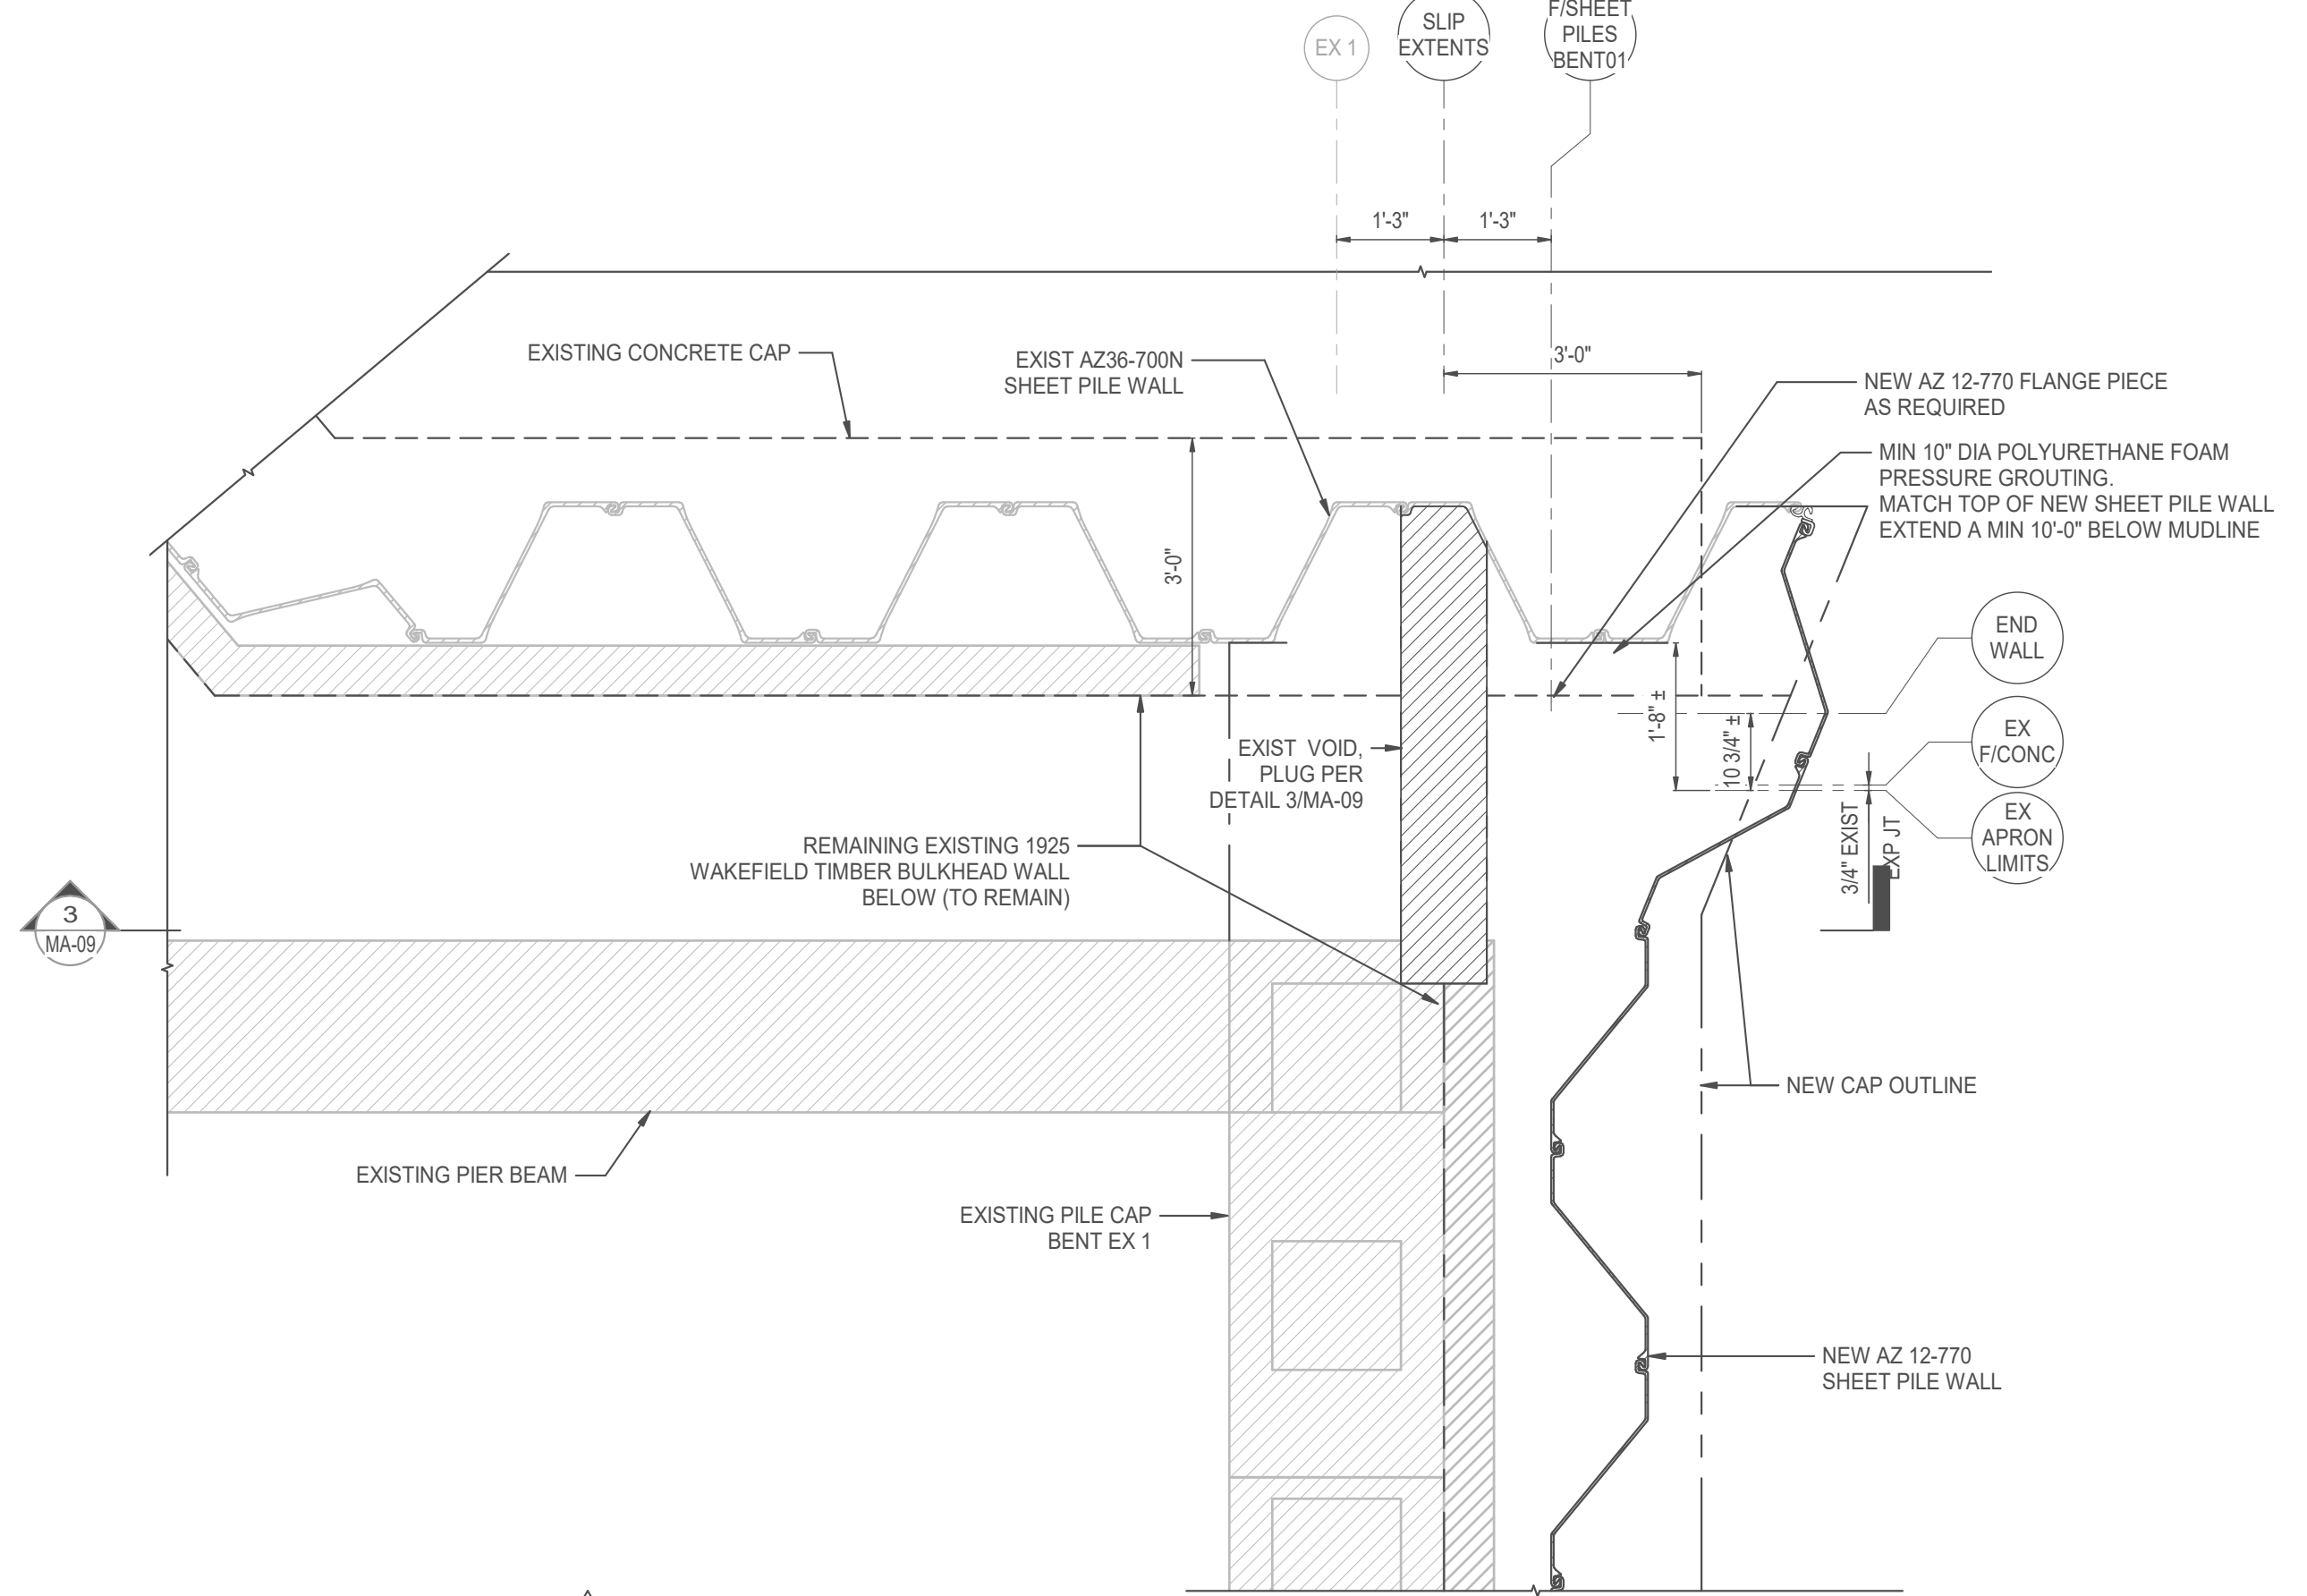

NOTE:  
ZZ SHEET PILE SECTIONS CAN BE USED IN LIEU OF AZ SHEET PILE SECTIONS OF THE SAME SIZE.

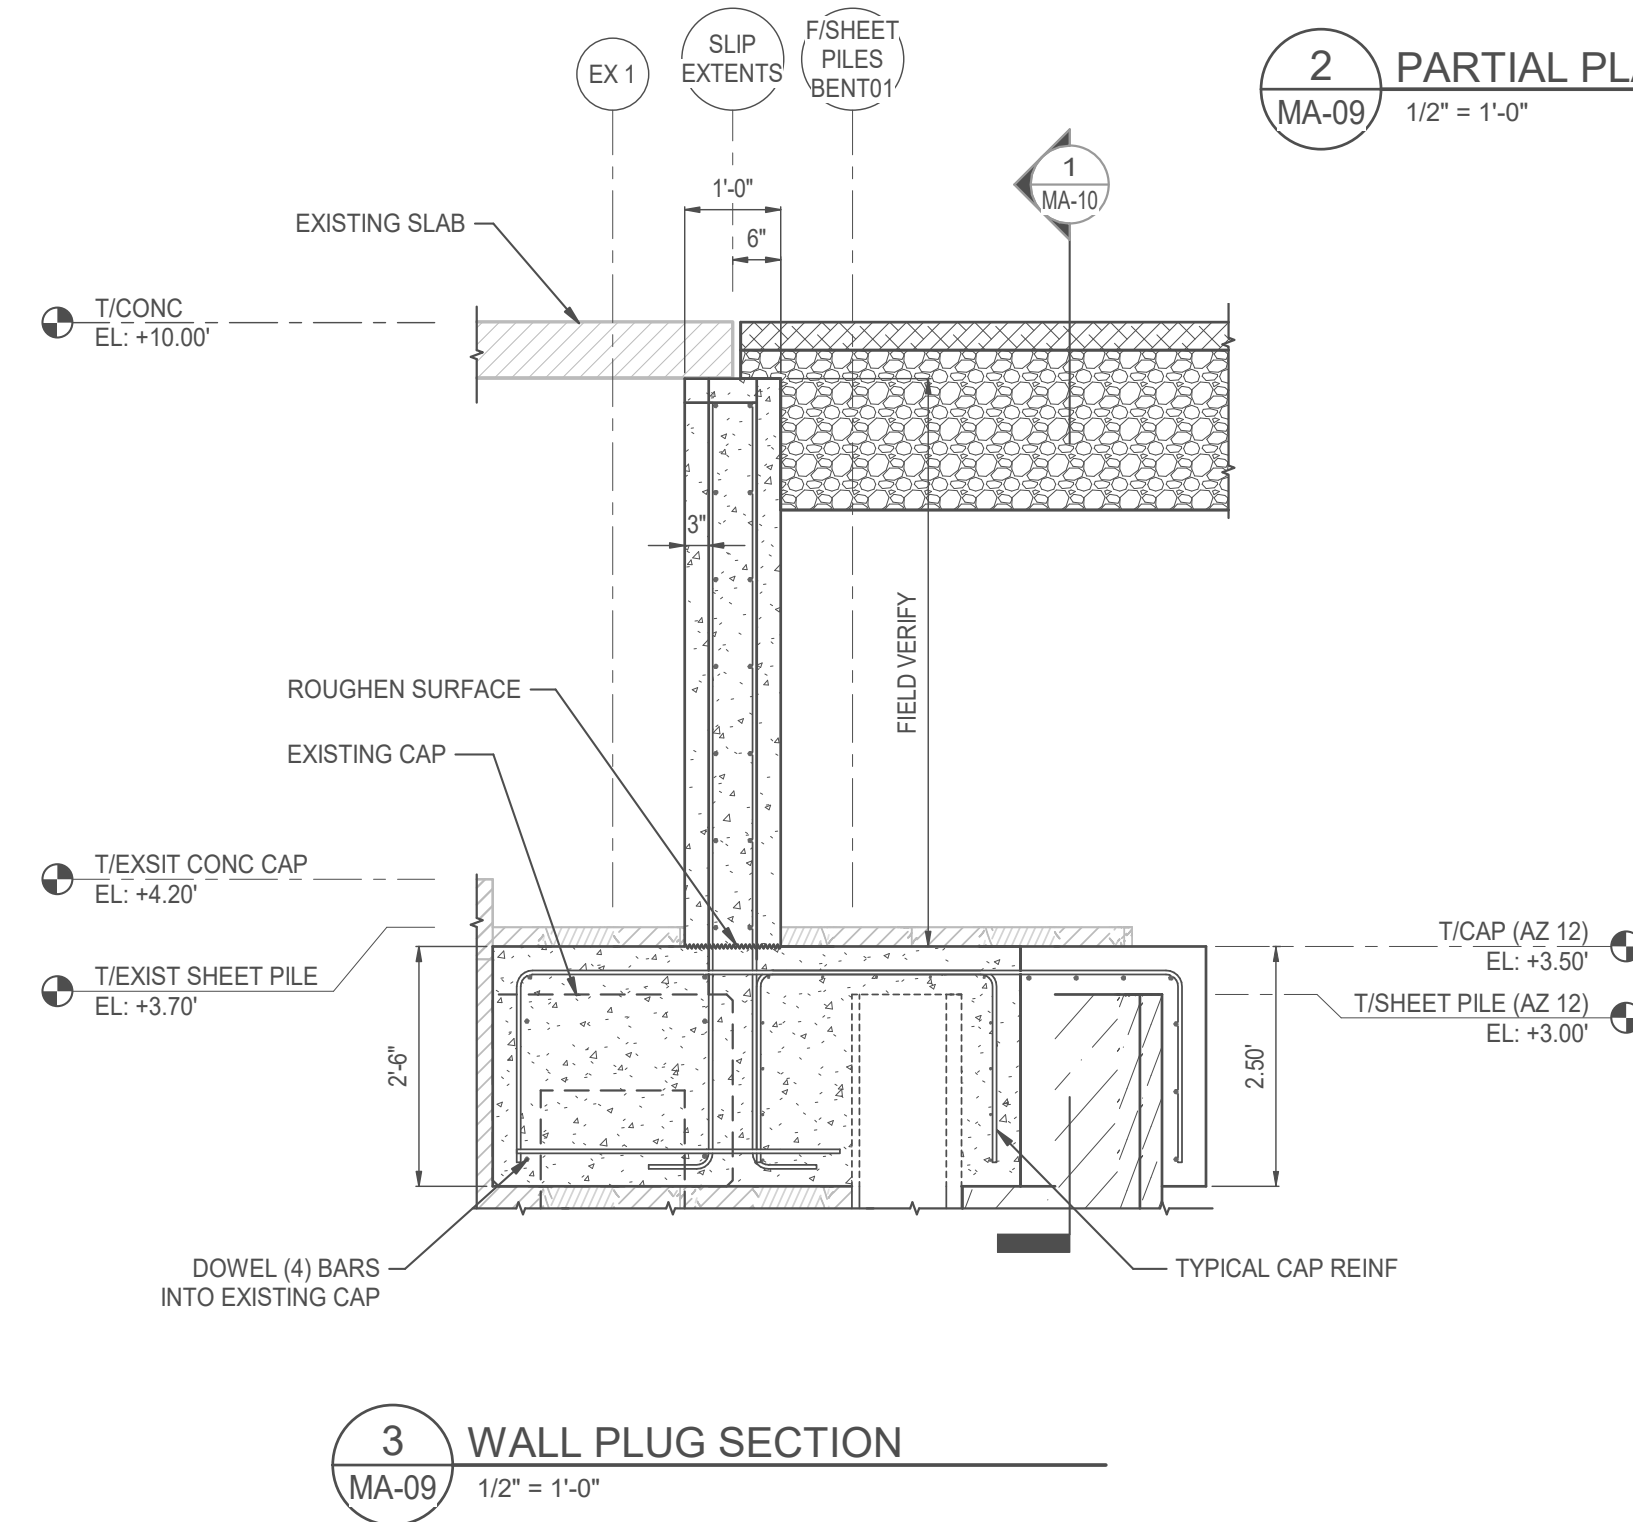




SHEET PILE WALL REPLACEMENT

PIER B SOUTH

397324

7/31/2023 3:53:19 PM

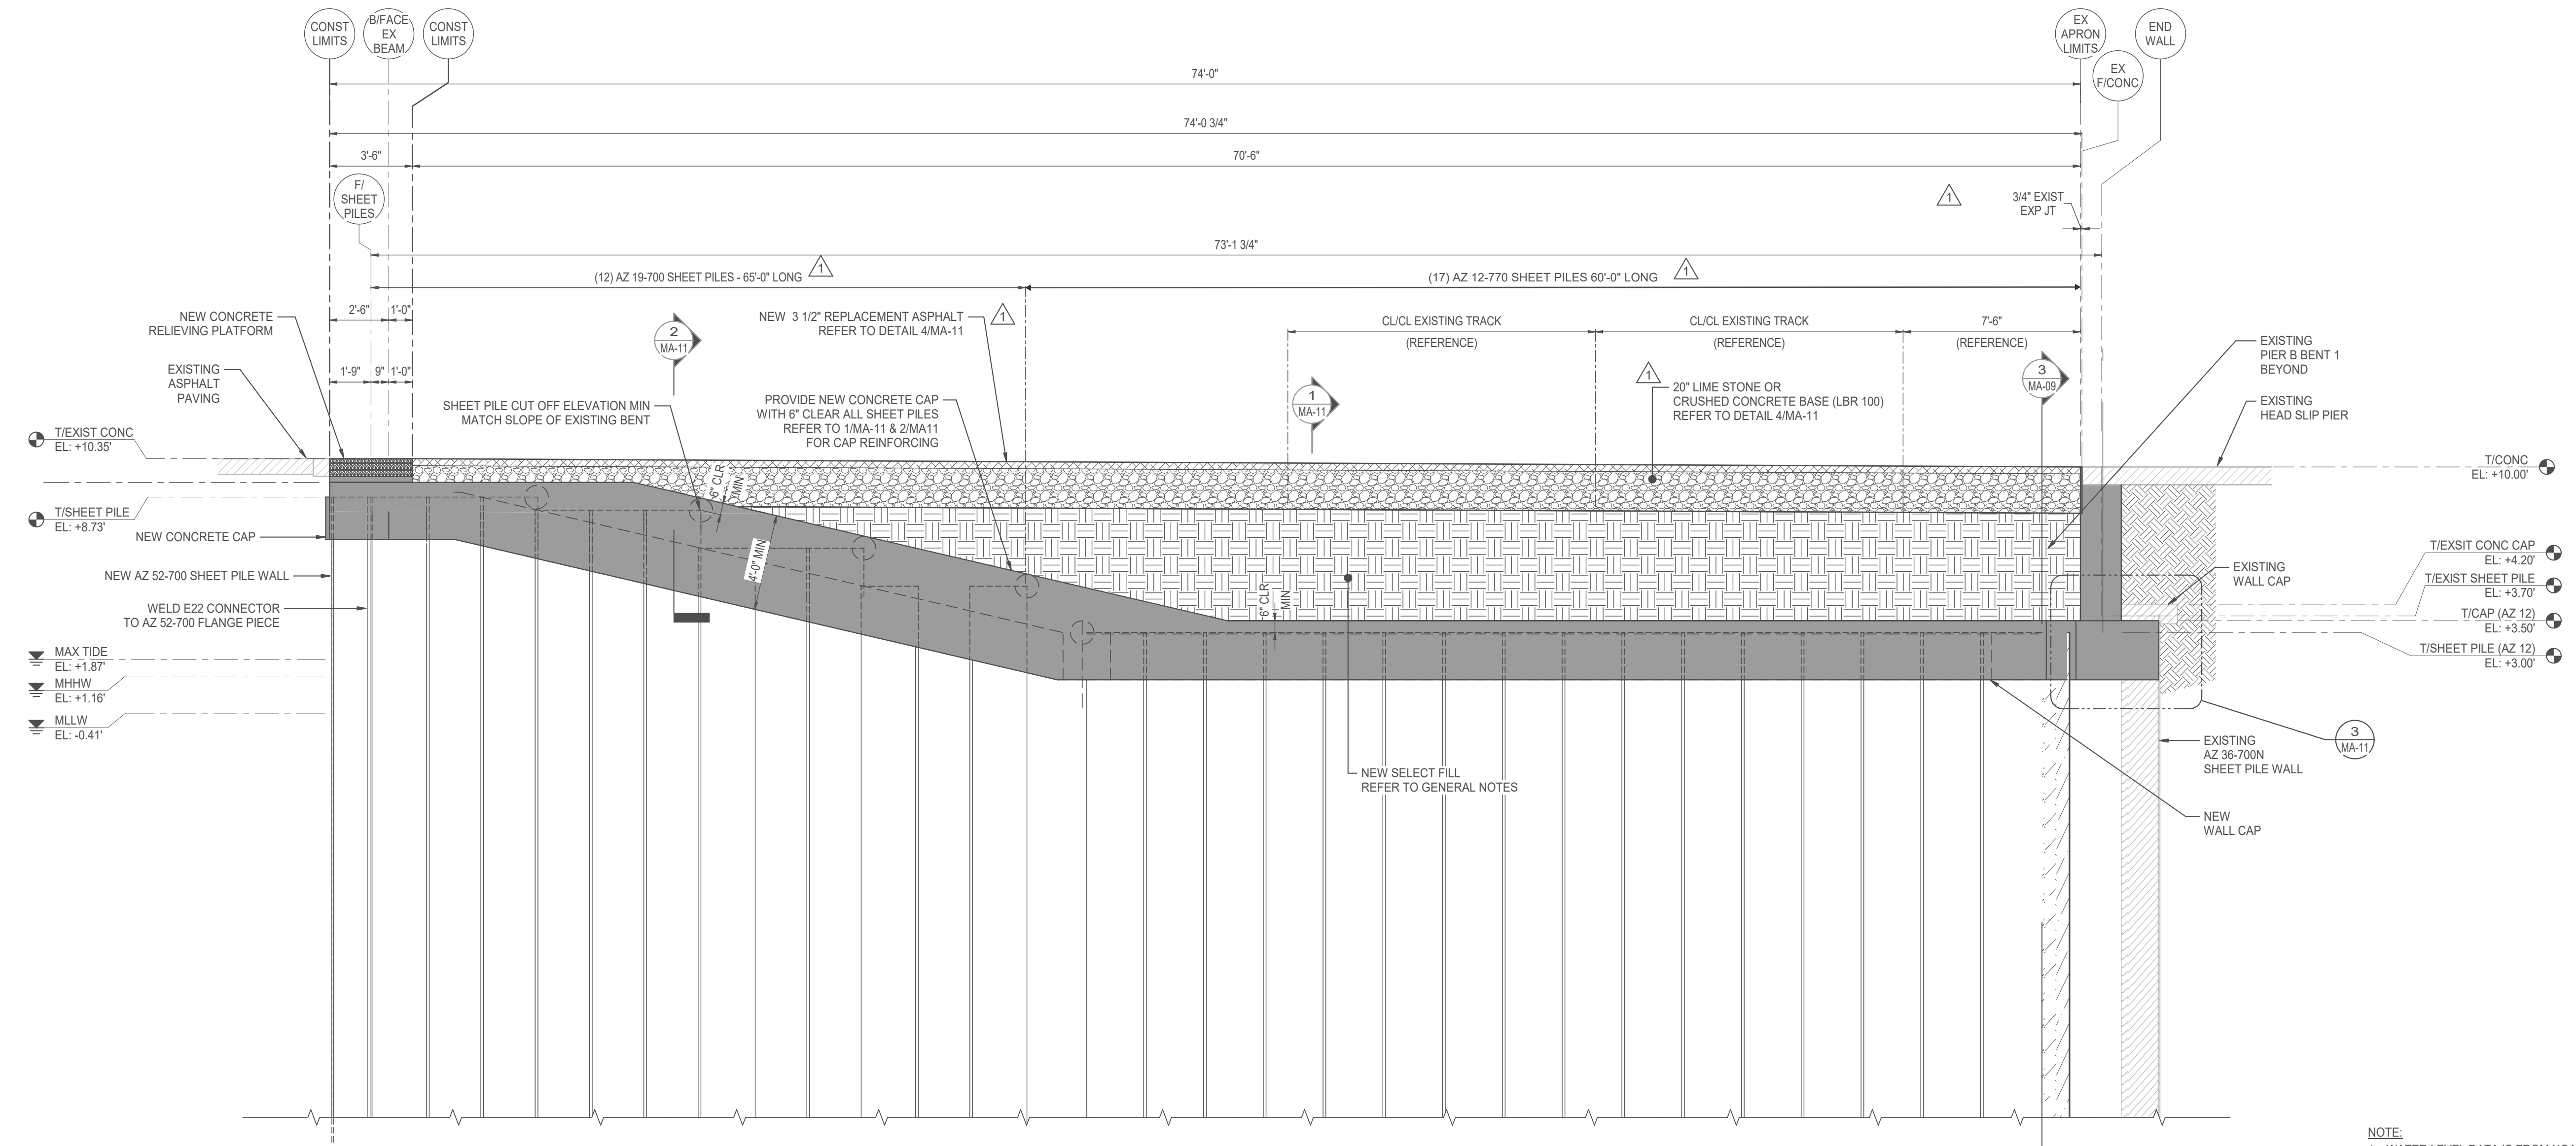

NOTE:  
ZZ SHEET PILE SECTIONS CAN BE USED IN LIEU OF AZ SHEET PILE SECTIONS OF THE SAME SIZE.

**1** SECTION AT EXISTING BENT 1 LOOKING EAST  
MA-10 1/4" = 1'-0"

NOTE:  
1. WATER LEVEL DATA IS FROM NOAA TIDE DATA WEB SITE FOR MOBILE STATE DOCKS, DATUM NAVD 88  
2. REFER TO SHEET MA-11 FOR RAIL NOTES AND DETAILS

- LEGEND**
- INDICATES NEW CONCRETE
  - INDICATES EXISTING STRUCTURES
  - MHHW INDICATES MEAN HIGHER-HIGH WATER
  - MLLW INDICATES MEAN LOWER-LOW WATER
  - MAX TIDE INDICATES HIGHEST OBSERVED TIDE 10-08-2017

AS-BUILT INFORMATION SHOWN ON THIS DRAWING HAS BEEN OBSERVED AND SUPPLIED BY THE CONTRACTOR. MOTT MACDONALD DOES NOT ATTEST TO THE ACCURACY OF THE CONTRACTOR'S MARK-UPS, BUT SIGNIFICANT FIELD CHANGES SHOWN ON THE DRAWINGS WERE VERIFIED BY MOTT MACDONALD FOR CONFORMANCE WITH THE ORIGINAL DESIGN INTENT.




Mott MacDonald  
107 St. Francis Street  
Suite 2900  
Mobile, Alabama 36602  
United States of America  
Telephone: (251) 343-4366  
www.mottmac.com/americas

Client  
**ALABAMA STATE PORT AUTHORITY**  
  
MOBILE, ALABAMA

Rev	Date	Drawn	Description	Ch'k'd	App'd
2	07-27-23	KWD	AS-BUILT RECORD DRAWINGS	CEL	LJD
1	05-18-22	KWD	ADD 1 ISSUED FOR CONST	CEL	LJD
0	01-14-22	KWD	ISSUED FOR BID	CEL	LJD

**LOWRY J. DENTY, P.E.**  
24892 ALABAMA - CERTIFICATION NUMBER  
  
**AS-BUILT RECORD**  
  
Project Number **397324**

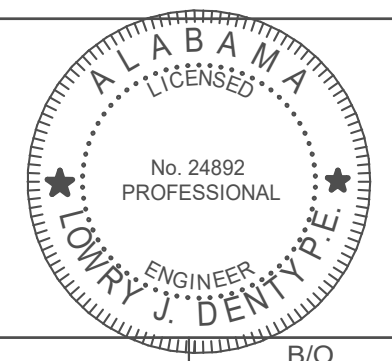

Designed	JQ	Eng Check	KP
Drawn	KWD	Coordination	LJD
Dwg Check	CEL	Approved	BP
Scale at ANSI D As Shown	Status IFC	Rev 1	Security STD
Drawing Number		<b>MA-10</b>	


Title  
**PIER B SOUTH**  
  
**NEW SHEET PILE WALL RETURN WALL ELEVATION**

SHEET PILE WALL REPLACEMENT


PIER B SOUTH

397324


7/31/2023 3:53:23 PM

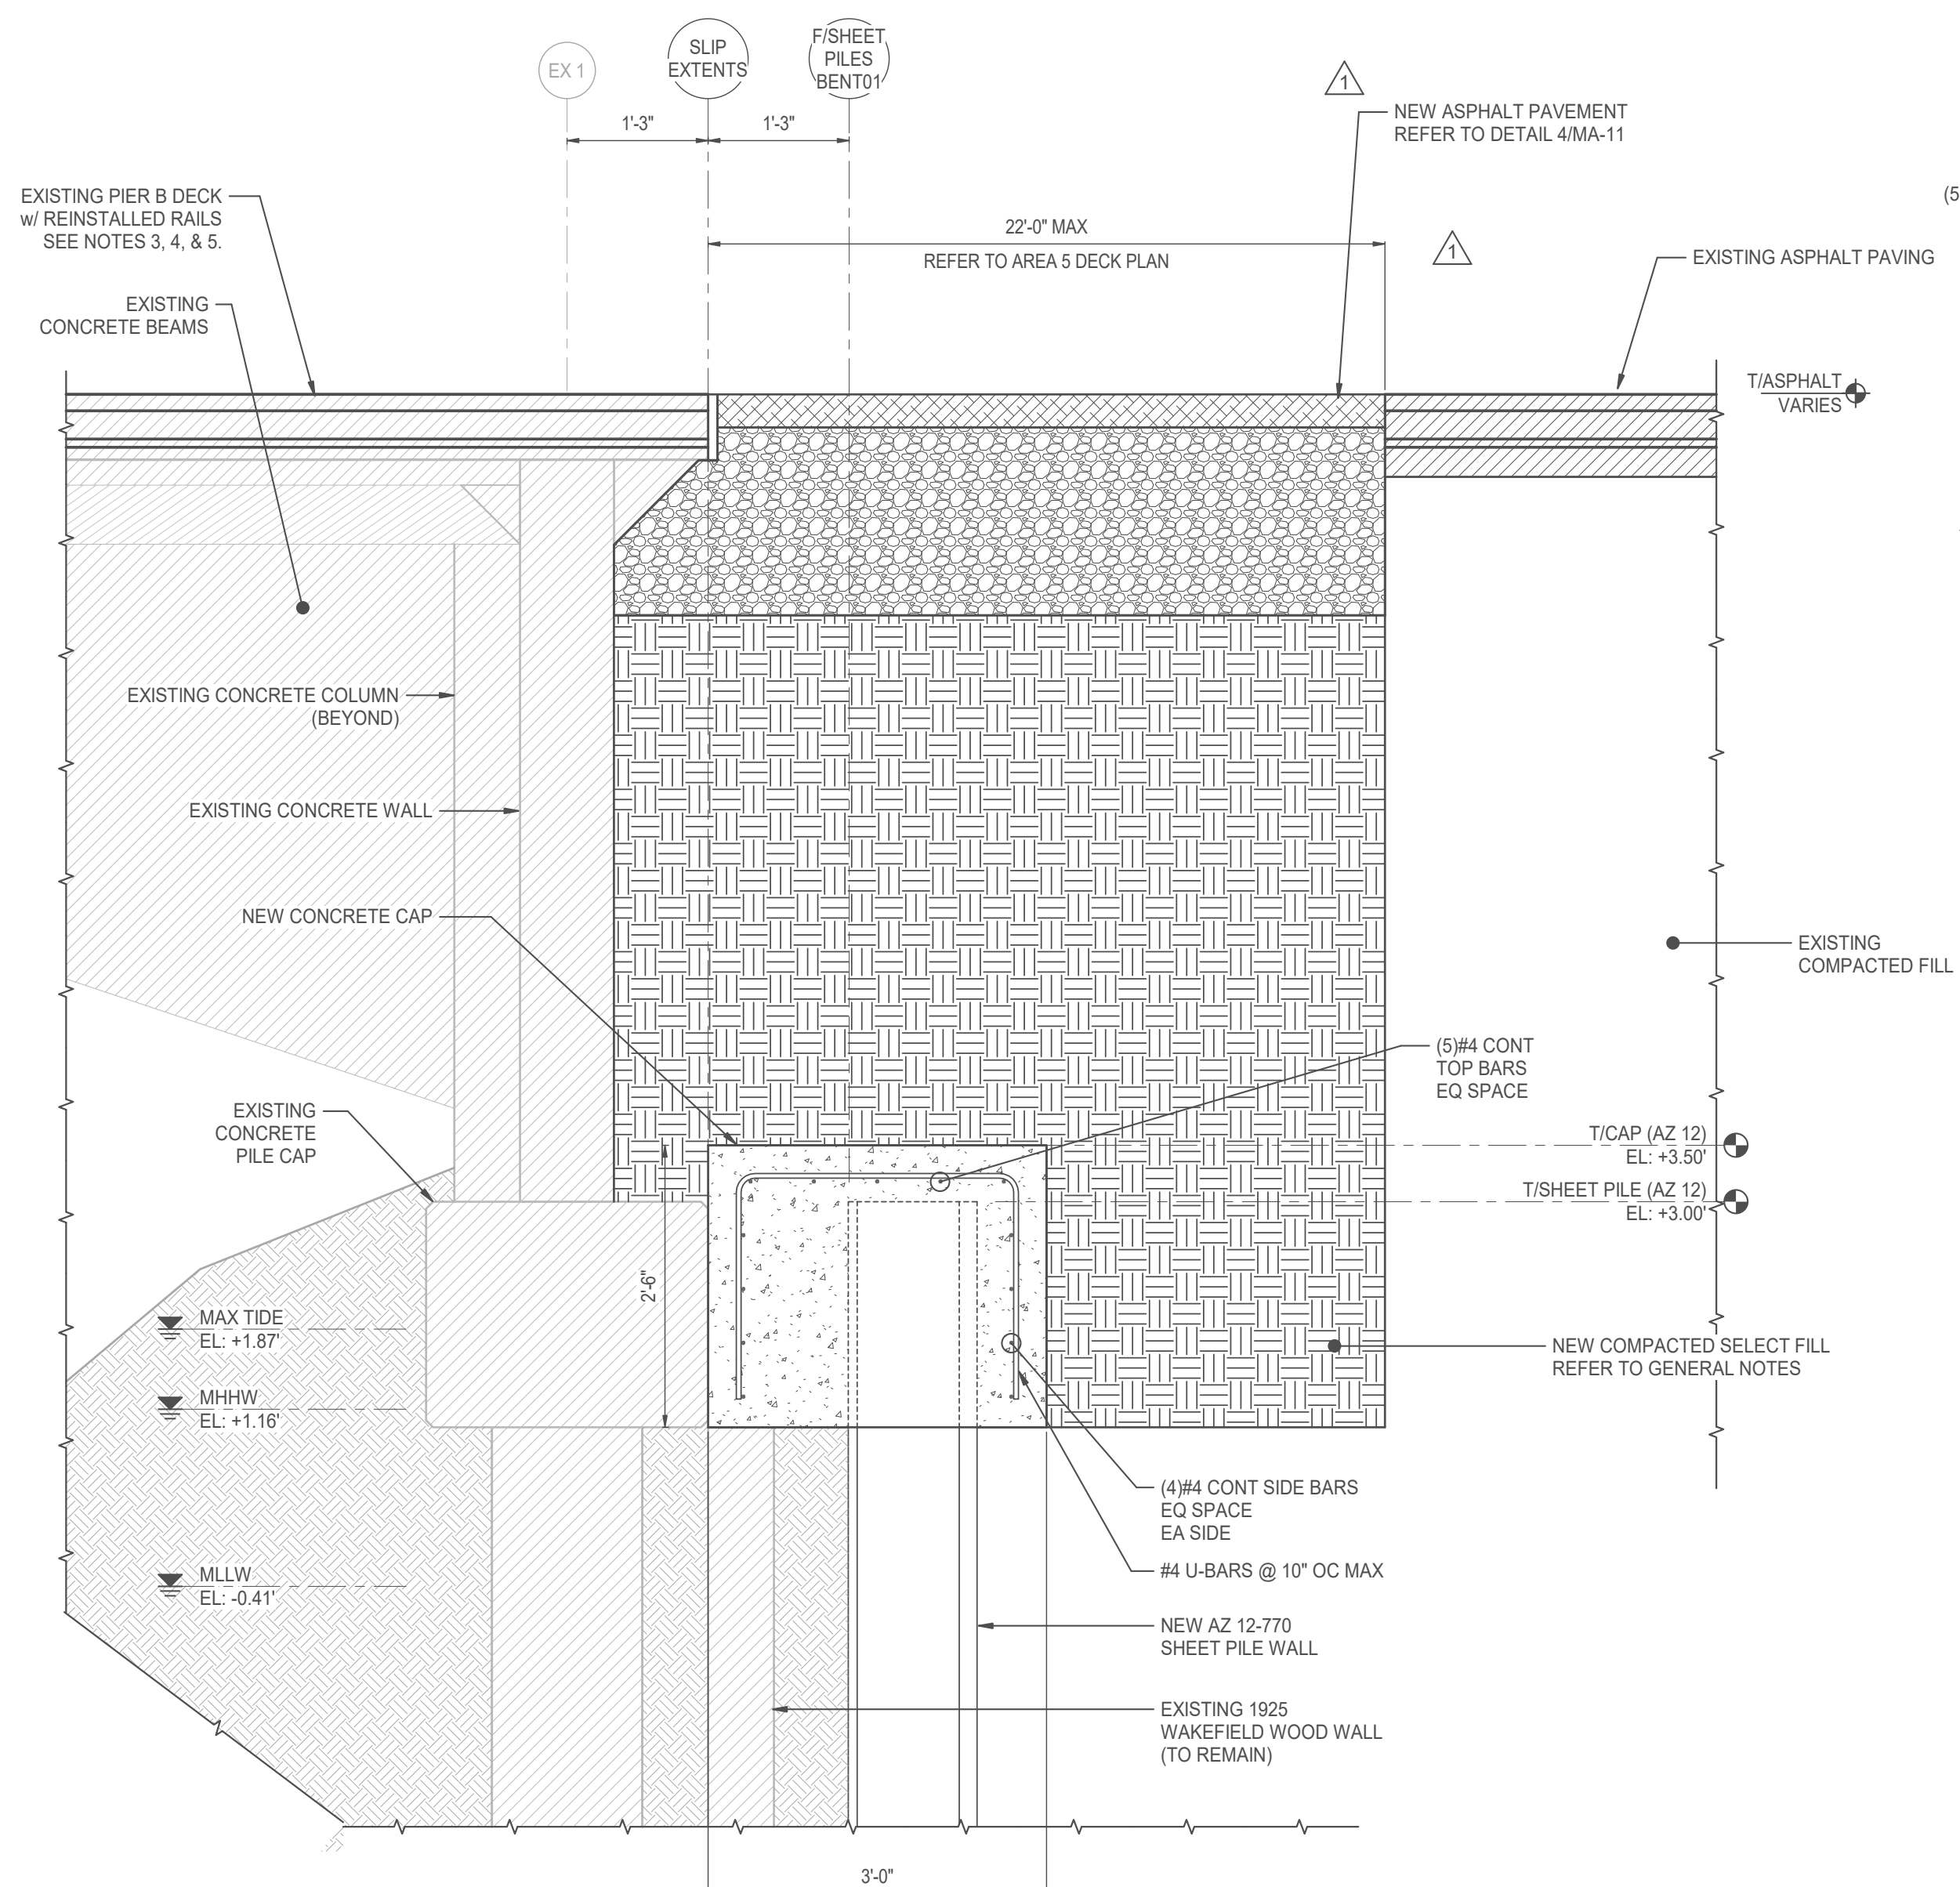


**1** SHEET PILE RETURN WALL AT EXISTING RAILS  
MA-11 3/4" = 1'-0"

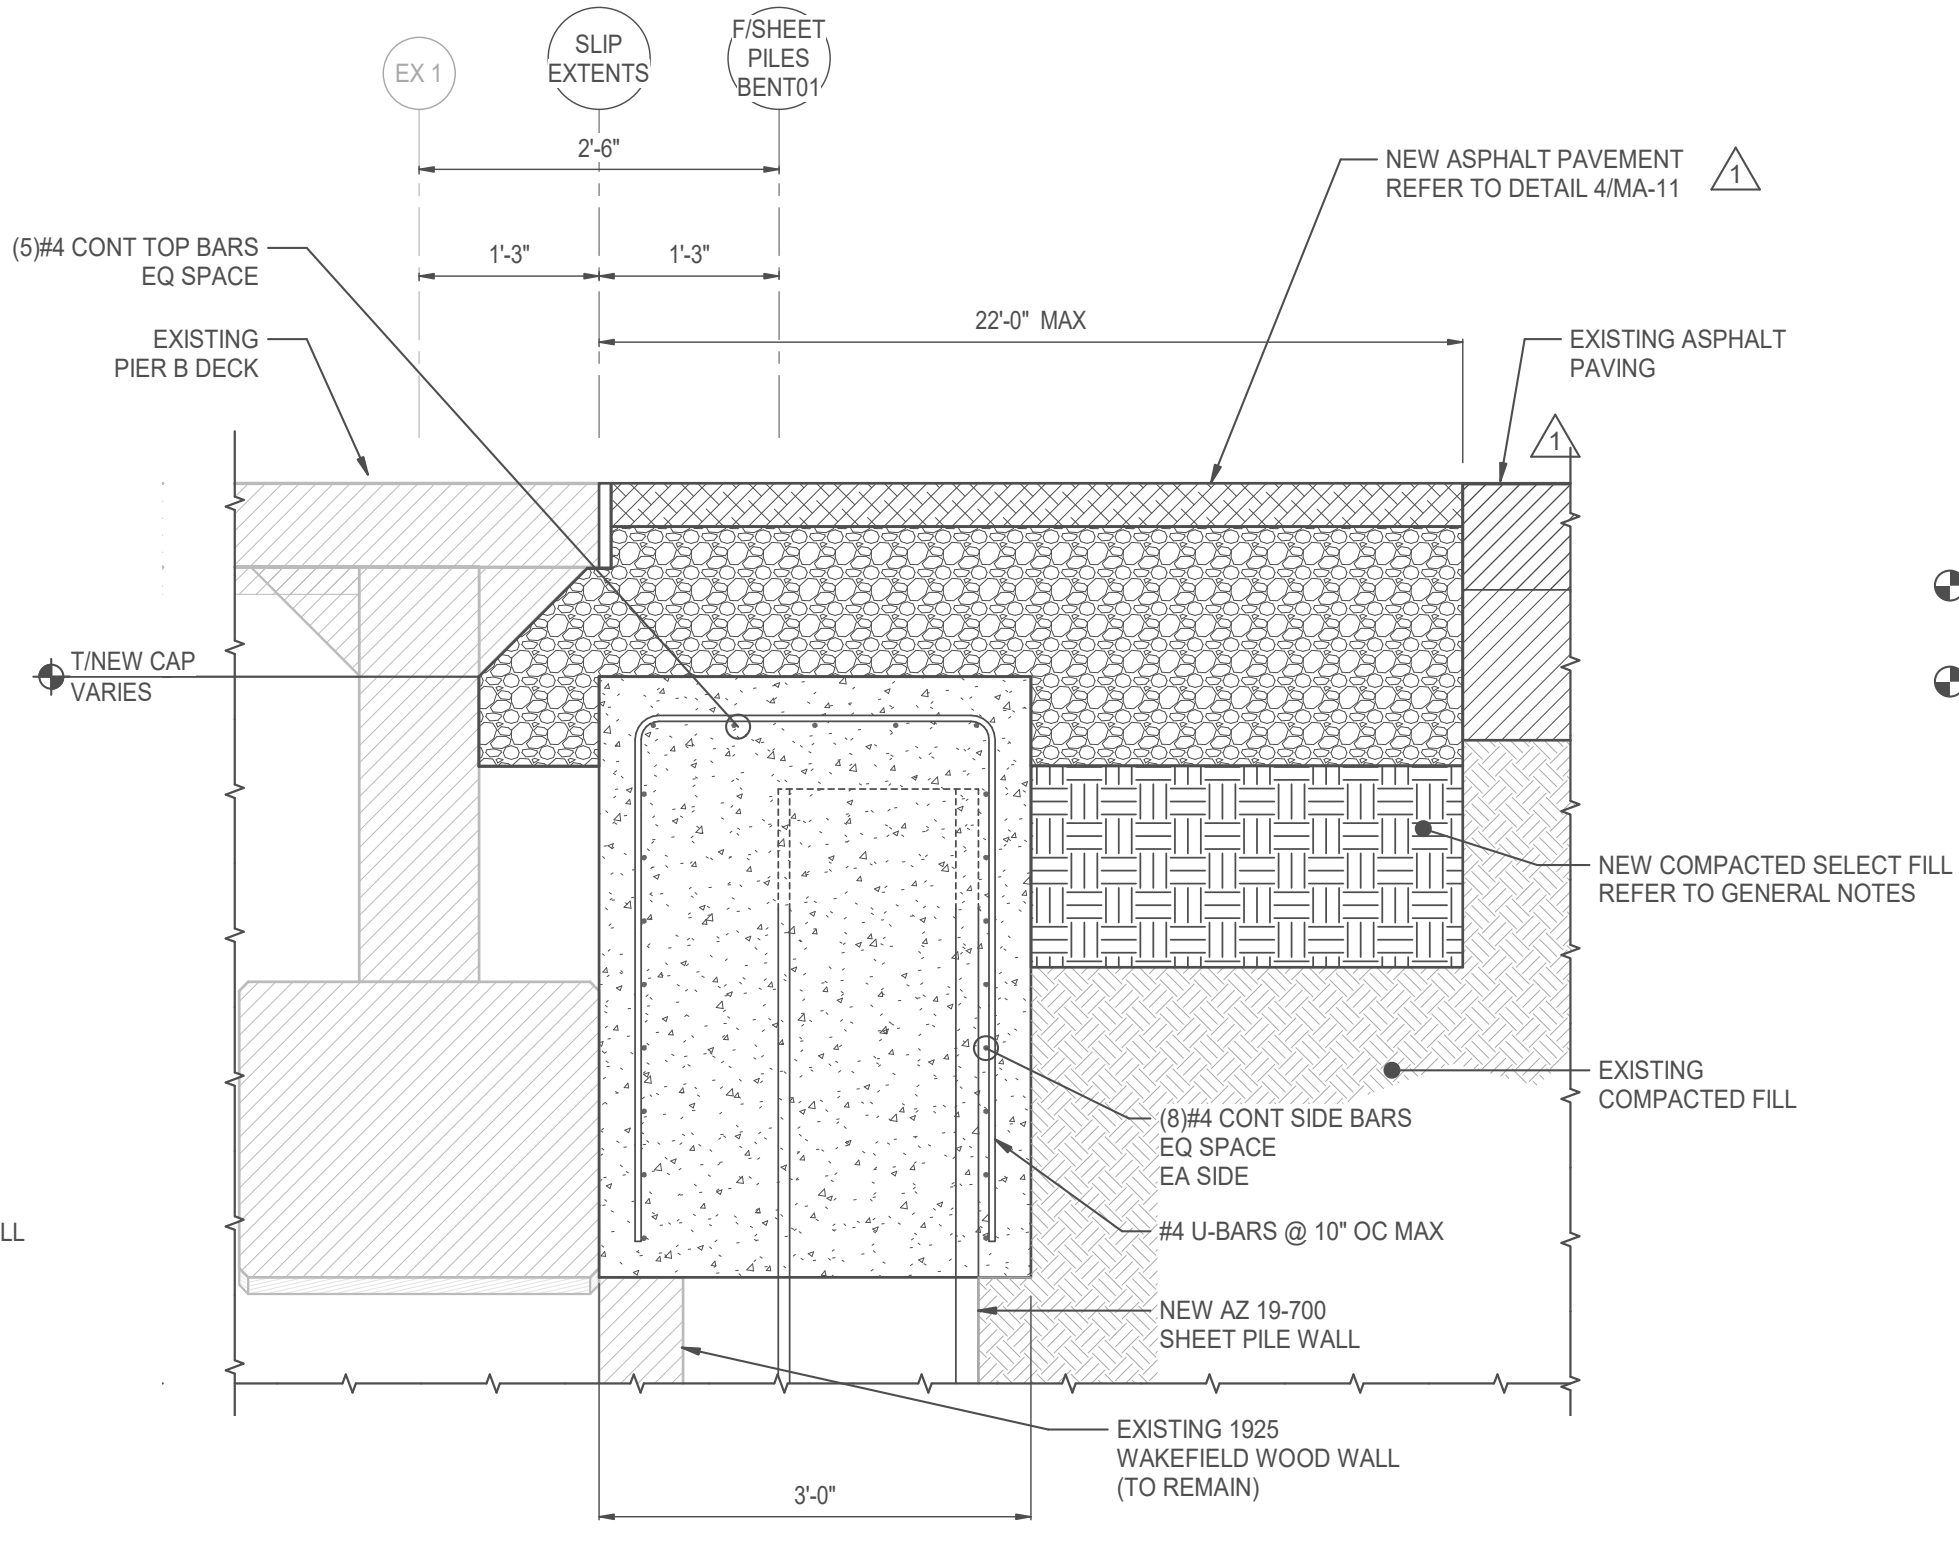

**2** SHEET PILE RETURN WALL (NO RAILS)  
MA-11 3/4" = 1'-0"

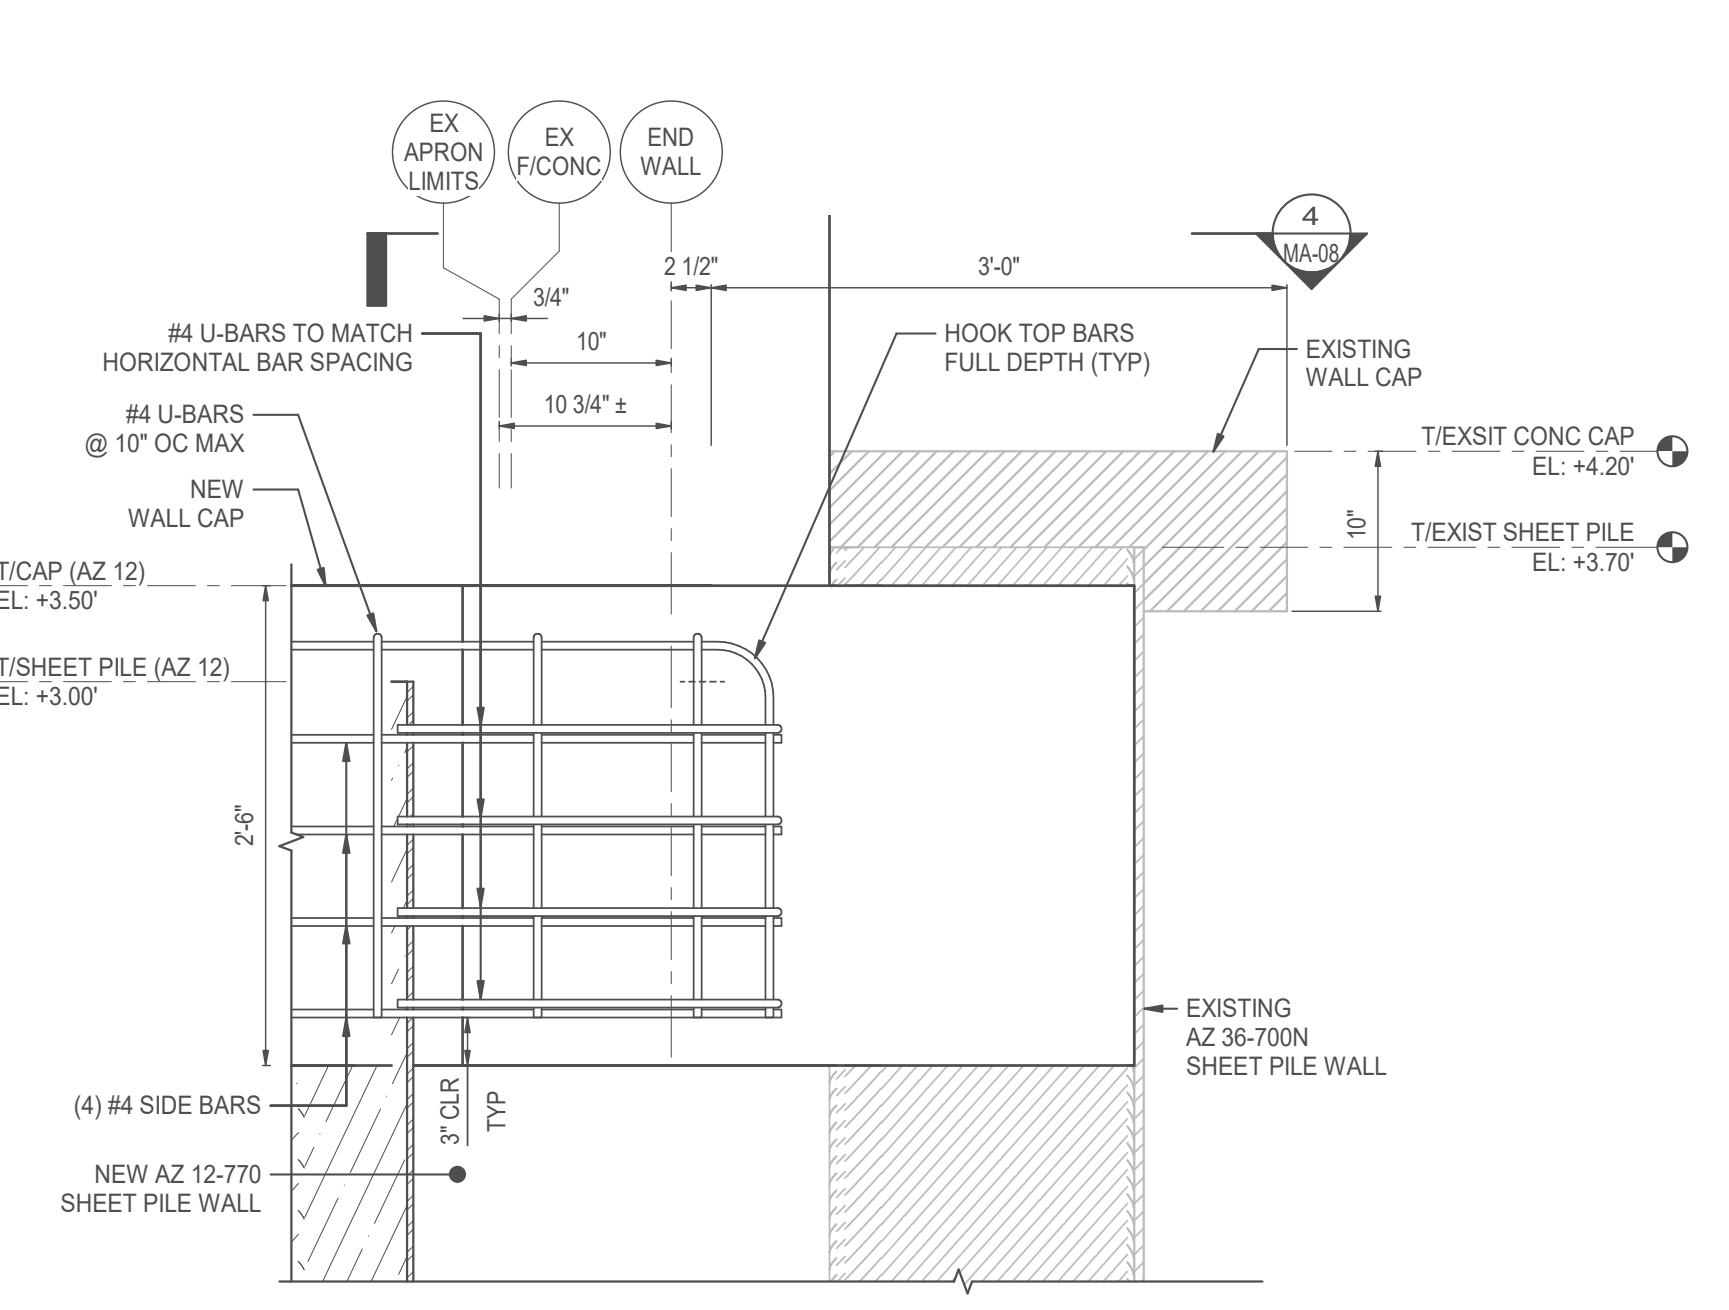

**3** RETURN WALL NEW CAP END DETAIL  
MA-11 1" = 1'-0"

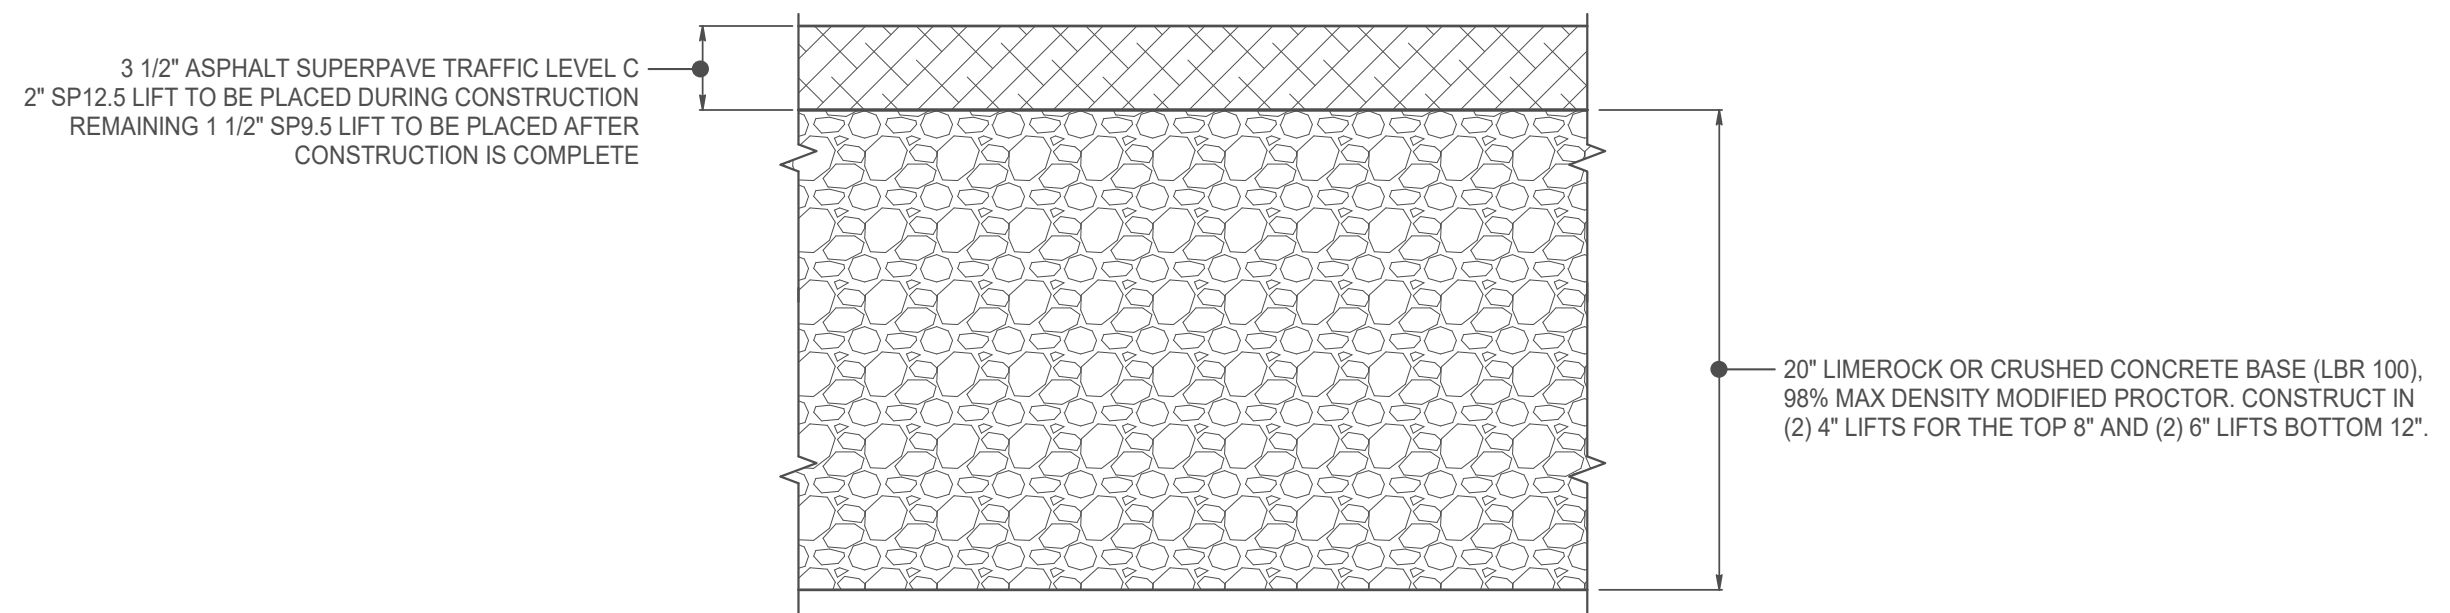

**4** HEAVY DUTY ASPHALT SECTION  
MA-11 1 1/2" = 1'-0"

- LEGEND**
- EX # INDICATES EXISTING BENT REFER TO EXISTING DRAWINGS
  - INDICATES EXISTING STRUCTURES
  - INDICATES EXISTING EARTH
  - INDICATES NEW COMPACTED FILL
  - INDICATES NEW PRECAST CONCRETE
  - INDICATES NEW CONCRETE
  - MHHW INDICATES MEAN HIGHER-HIGH WATER
  - MLLW INDICATES MEAN LOWER-LOW WATER
  - MAX TIDE INDICATES HIGHEST OBSERVED TIDE 10-08-2017

**M M**  
MOTT  
MACDONALD

Mott MacDonald  
107 St. Francis Street  
Suite 2900  
Mobile, Alabama 36602  
United States of America  
Telephone: (251) 343-4366  
www.mottmac.com/america


Client  
**ALABAMA STATE  
PORT AUTHORITY**  
  
MOBILE, ALABAMA

Rev	Date	Drawn	Description	Ch'k'd	App'd
2	07-27-23	KWD	AS-BUILT RECORD DRAWINGS	CEL	LJD
1	05-18-22	KWD	ADD 1 ISSUED FOR CONST	CEL	LJD
0	01-14-22	KWD	ISSUED FOR BID	CEL	LJD

**LOWRY J. DENTY, P.E.**  
24892 ALABAMA - CERTIFICATION NUMBER

**AS-BUILT  
RECORD**

Project Number **397324**

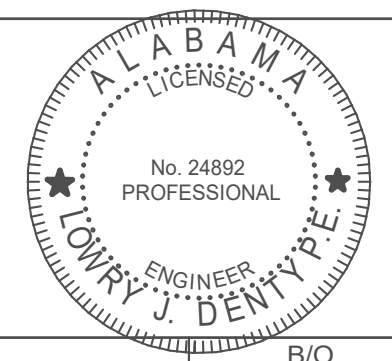

AS-BUILT INFORMATION SHOWN ON THIS DRAWING HAS BEEN OBSERVED AND SUPPLIED BY THE CONTRACTOR. MOTT MACDONALD DOES NOT ATTEST TO THE ACCURACY OF THE CONTRACTOR'S MARK-UPS, BUT SIGNIFICANT FIELD CHANGES SHOWN ON THE DRAWINGS WERE VERIFIED BY MOTT MACDONALD FOR CONFORMANCE WITH THE ORIGINAL DESIGN INTENT.

Designed	JQ	Eng Check	KP
Drawn	KWD	Coordination	LJD
Dwg Check	CEL	Approved	BP
Scale at ANSI D	Status	Rev	Security
As Shown	IFC	1	STD
Drawing Number	<b>MA-11</b>		


Title  
**PIER B SOUTH**  
**NEW SHEET PILE WALL  
RETURN WALL TYPICAL SECTIONS**

SHEET PILE WALL REPLACEMENT

PIER B SOUTH


397324

7/28/2023 10:01:11 AM

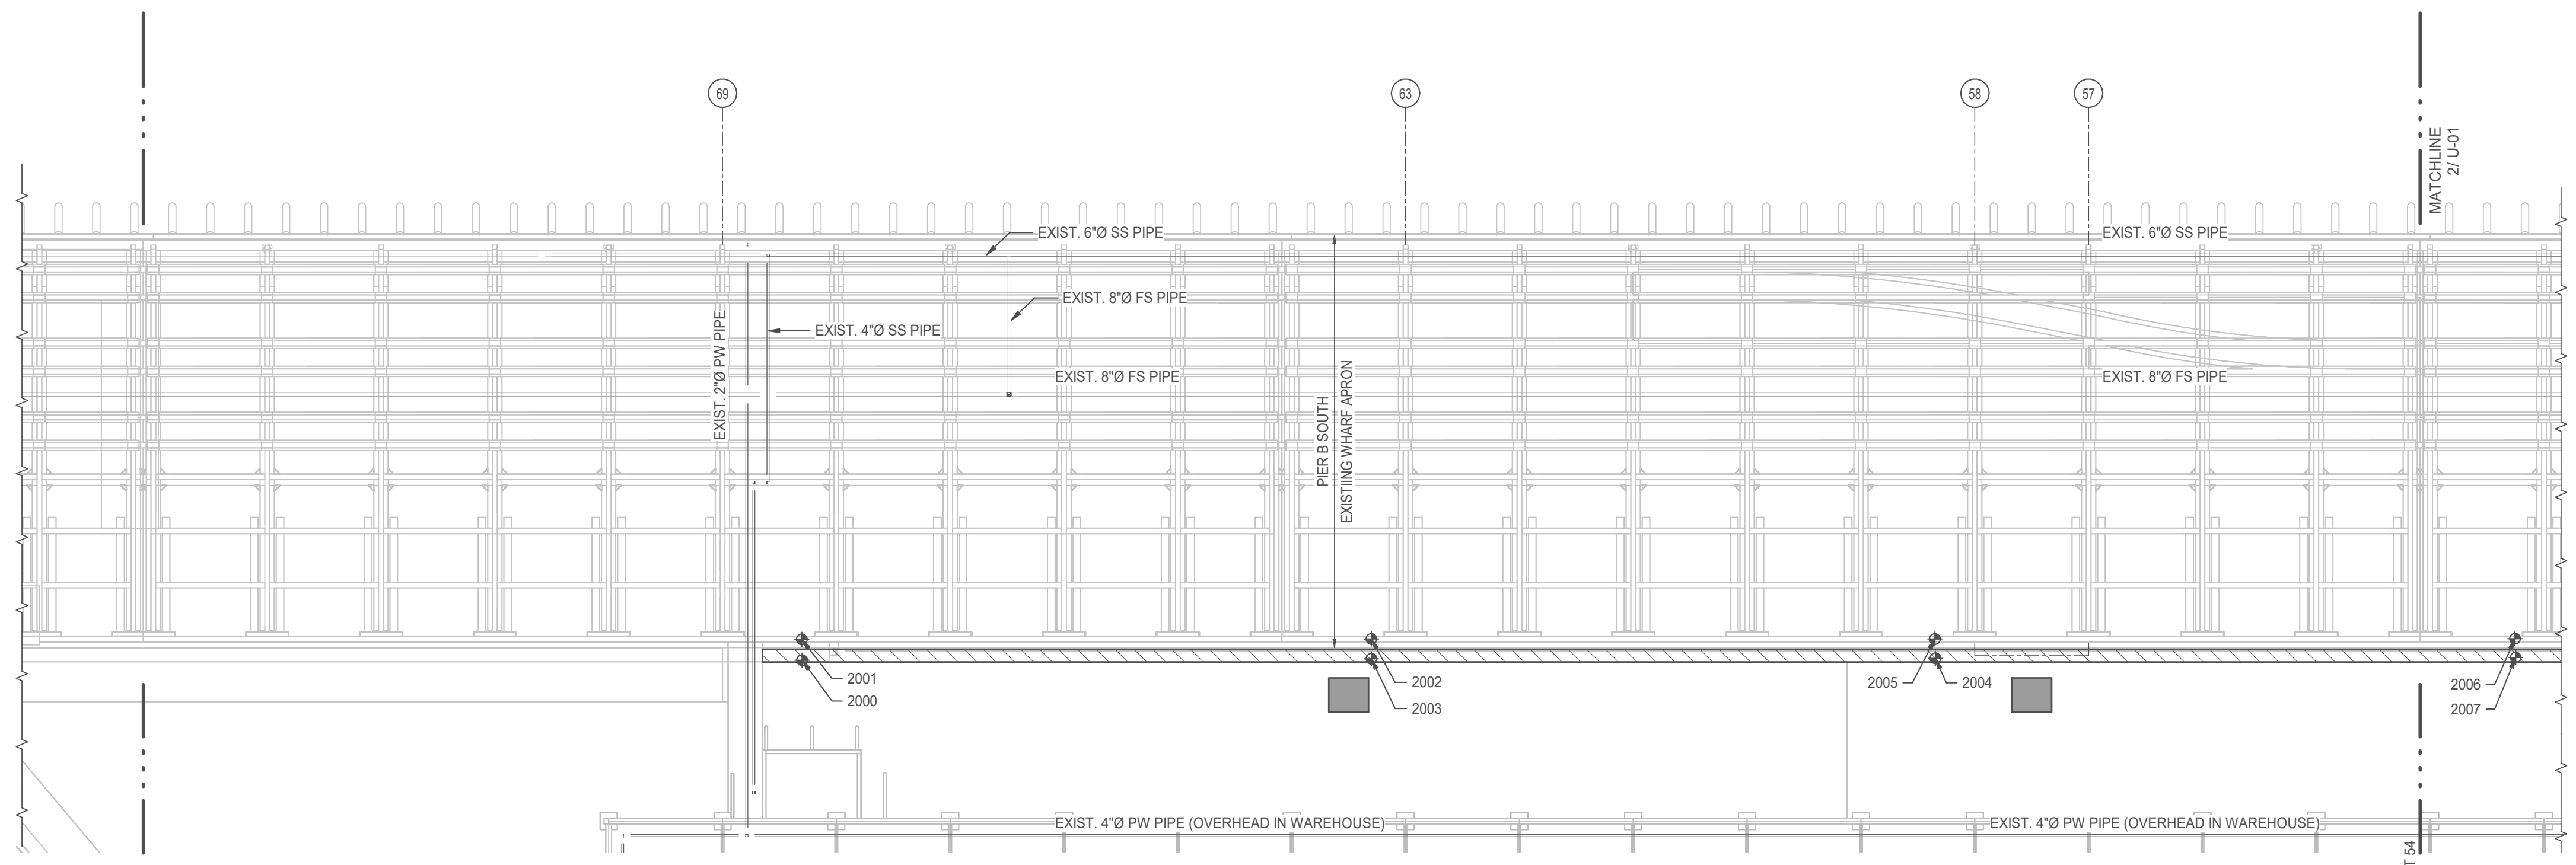


**1** AREA 2 UTILITY PLAN  
1" = 20'-0"

ALL EXISTING UTILITIES SHALL REMAIN EXCEPT WHERE PENETRATING THE NEW SHEET PILE WALL. A 6'-0" SECTION OF EXISTING PIPING SHALL BE DEMOLISHED AND REPLACED AT THE SHEET PILE INTERSECTION. REFER TO 1/U-03 FOR SPLICE DETAILS.

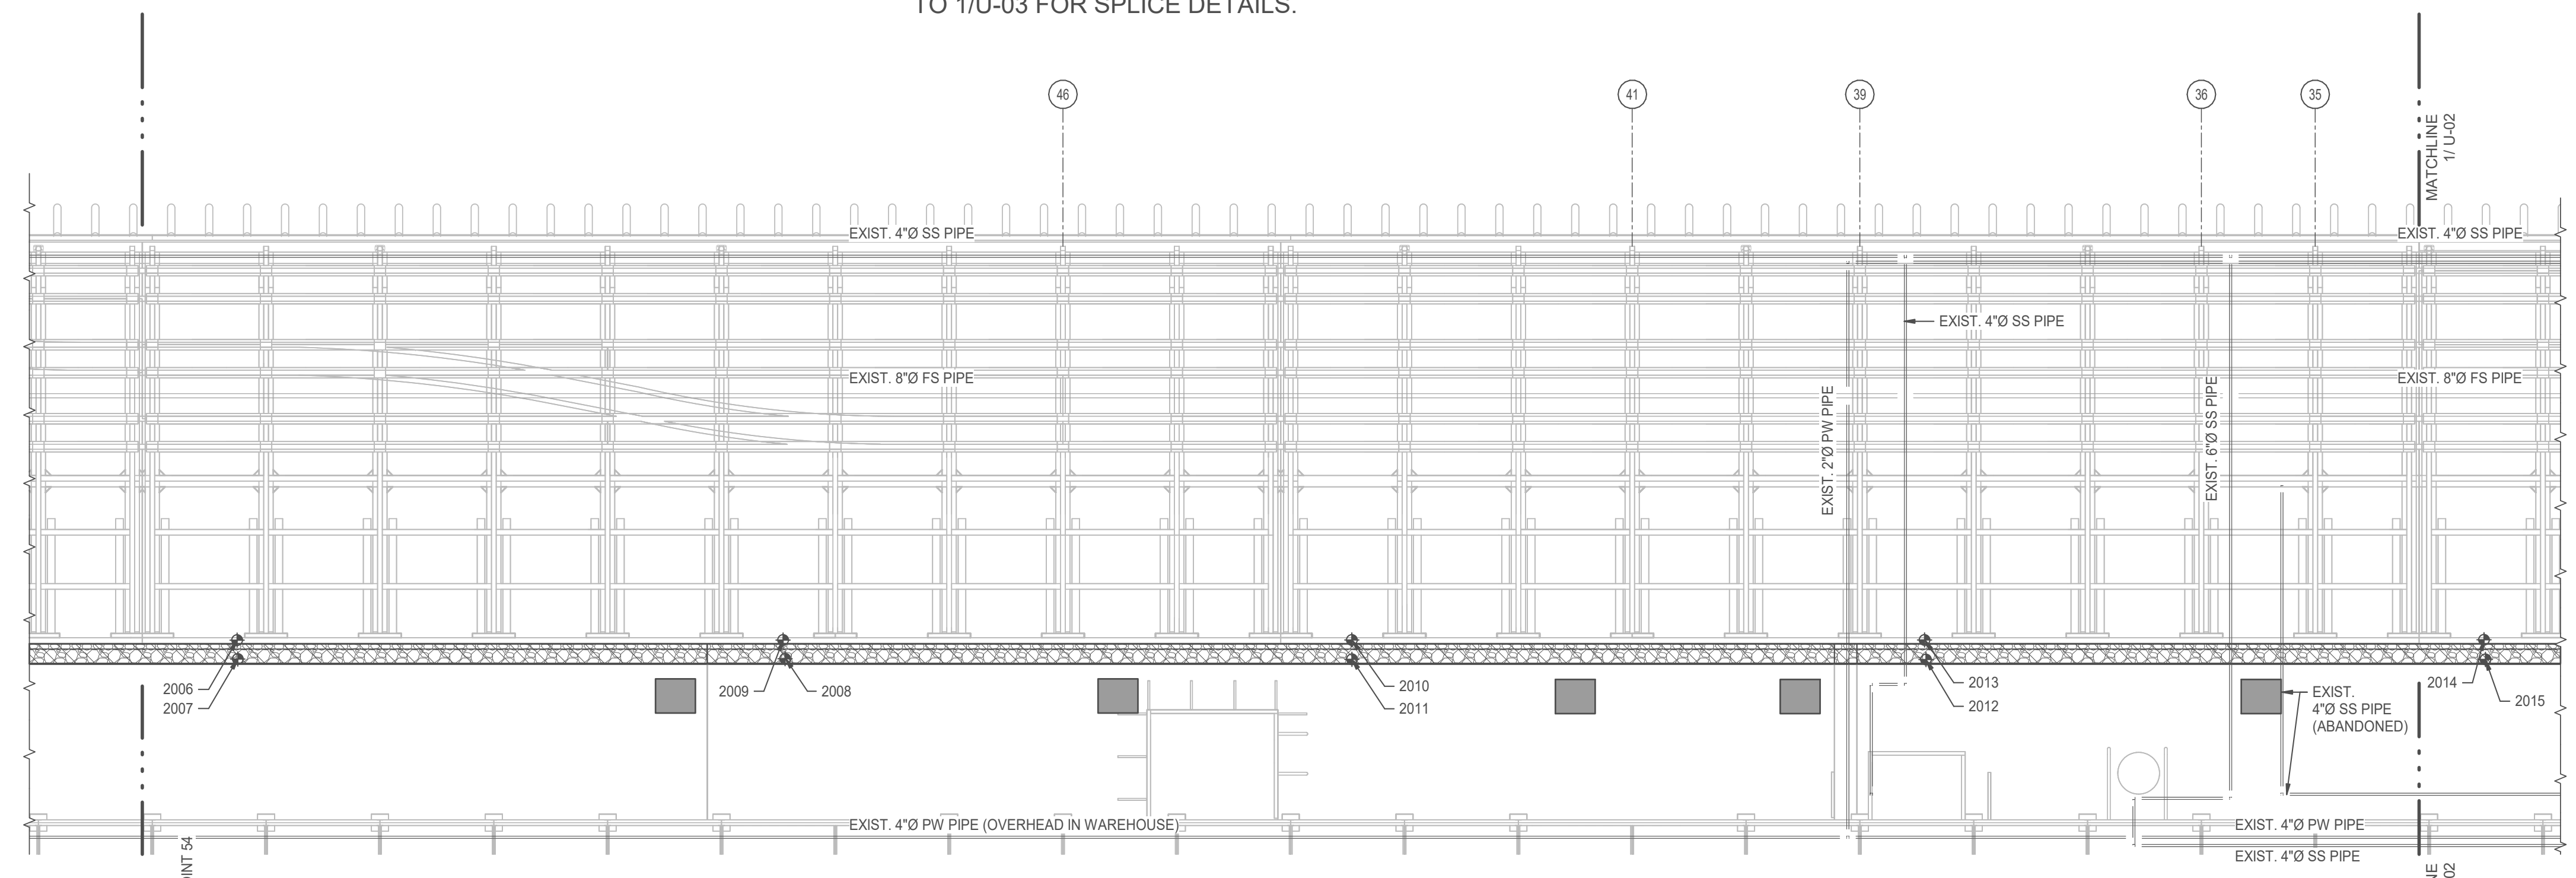

**2** AREA 3 UTILITY PLAN  
1" = 20'-0"

ALL EXISTING UTILITIES SHALL REMAIN EXCEPT WHERE PENETRATING THE NEW SHEET PILE WALL. A 6'-0" SECTION OF EXISTING PIPING SHALL BE DEMOLISHED AND REPLACED AT THE SHEET PILE INTERSECTION. REFER TO 1/U-03 FOR SPLICE DETAILS.

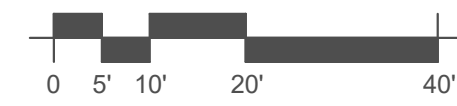

- UTILITY NOTES:**
- THE UTILITY LOCATIONS SHOWN ON THESE PLANS ARE APPROXIMATE. IT IS THE CONTRACTOR'S RESPONSIBILITY TO DETERMINE THE EXACT LOCATION OF ALL UTILITIES AND THEIR ISOLATION / SHUT OFF VALVES PRIOR TO CONSTRUCTION IN THEIR VICINITY.
  - THE CONTRACTOR SHALL LOCATE ALL UTILITIES BY HAND EXCAVATION BEFORE USE OF MACHINERY.
  - THE PROPOSED SEWER AND WATER LINES SHALL BE INSTALLED AT THE SAME ELEVATION AS THE EXISTING WATER LINE.
  - THERE WILL BE NO DIRECT PAYMENT FOR BENDS REQUIRED TO SHIFT THE UTILITY LINES TO AVOID THE SHEET PILE SEAMS.
  - NEW TWO (2) INCH WATER LINES SHALL BE SCHEDULE 80 316 STAINLESS STEEL PIPE WELDED EACH END. BURIED SECTIONS OF TWO (2) INCH WATER LINES SHALL BE WRAPPED IN POLYETHYLENE SHEATH.
  - NEW FOUR (4) INCH WATER LINES SHALL BE NEW CEMENT LINED PRESSURE CLASS 350 DUCTILE IRON PIPE WITH A MEGALUG SERIES 1100 MECHANICAL JOINT RESTRAINTS AND FLANGED ENDS. WORKING PRESSURE SHALL BE A MINIMUM OF 150 PSI. EXPOSED FOUR (4) INCH DUCTILE IRON WATER LINES SHALL BE COATED WITH 1/4 INCH BITUMASTIC COATING ON ALL SURFACES.
  - NEW SIX (6) INCH FIRE WATER LINES SHALL BE NEW CEMENT LINED PRESSURE CLASS 350 DUCTILE IRON PIPE WITH A MEGALUG SERIES 1100 MECHANICAL JOINT RESTRAINT AND FLANGED ENDS. WORKING PRESSURE SHALL BE A MINIMUM OF 150 PSI. EXPOSED SIX (6) INCH DUCTILE IRON WATER LINES SHALL BE COATED WITH 1/4 INCH BITUMASTIC COATING ON ALL SURFACES.
  - ALL SECTIONS OF NEW SEWER LINES TO BE NEW DUCTILE IRON PIPE CONFORMING TO ASTM A746. MINIMUM WALL THICKNESS SHALL BE AS SPECIFIED IN ASTM A746 TABLE 2 FOR NOMINAL WALL THICKNESSES FOR STANDARD PRESSURE CLASSES OF DUCTILE IRON PIPE. EACH END OF THE DUCTILE IRON PIPE SHALL HAVE MEGALUG SERIES 1100 MECHANICAL JOINT RESTRAINTS AND FLANGED ENDS AND SHALL BE COATED WITH A 1/4" BITUMASTIC COATING ON ALL SURFACES.
  - ALL NEW BURIED PIPES SHALL BE WRAPPED IN POLYETHYLENE SHEATH.
  - CONTRACTOR IS TO CONFIRM ALL EXISTING PIPE SIZES AND GRADES IN THE FIELD PRIOR TO ORDERING NEW MATERIAL.
  - DUCTILE IRON PIPING, FITTINGS AND CONNECTIONS SHALL FOLLOW THE AWWA CRITERIA AND SPECIFICATIONS.
- ANS1 A21.50 (AWWA C150)  
ANS1 A21.51 (AWWA C151)  
ANS1 A21.53 (AWWA C153)  
ANS1 A21.40 (AWWA C104)  
ANS1 A21.50 (AWWA C105)  
ANS1 A21.10 (AWWA C110)  
ANS1 A21.15 (AWWA C115)
- INTERIOR LINING OF ALL DUCTILE IRON PIPE AND FITTINGS FOR RAW SEWAGE SHALL BE FURNISHED WITH AN APPROVED AMINE CURED NOVALAC EPOXY COATING. ACCEPTABLE COATINGS INCLUDE PROTECTO 401 CERAMIC EPOXY, SP 2000 CERAMIC EPOXY, POLY BOND PLUS, PERMOX CTF, OR ENGINEER APPROVED EQUAL.
  - MECHANICAL JOINT MANUFACTURERS' EQUIVALENT TO EBAA IRON, INC.:

- THE FORD METER BOX CO., INC.
- STAR PIPE PRODUCTS, INC.
- ROMAC INDUSTRIES
- JCM INDUSTRIES
- SMITH-BLAIR/XYLEM, INC

**LEGEND:**

PW: POTABLE WATER  
SS: SANITARY SEWER  
FS: FIRE/SPRINKLER

ABANDONED 72" x 84" SCALE PIT LOCATIONS SHOWN ON PLANS SHALL BE CONSIDERED APPROXIMATE. IF ENCOUNTERED DURING SHEET PILE INSTALLATION, CONTRACTOR SHALL PARTIALLY DEMOLISH TO ALL FOR SHEET INSTALLATION.

NEW SHEET PILE WALL

**KEY PLAN**

AS-BUILT INFORMATION SHOWN ON THIS DRAWING HAS BEEN OBSERVED AND SUPPLIED BY THE CONTRACTOR. MOTT MACDONALD DOES NOT ATTEST TO THE ACCURACY OF THE CONTRACTOR'S MARK-UPS, BUT SIGNIFICANT FIELD CHANGES SHOWN ON THE DRAWINGS WERE VERIFIED BY MOTT MACDONALD FOR CONFORMANCE WITH THE ORIGINAL DESIGN INTENT.

**M M**  
MOTT MACDONALD

Mott MacDonald  
107 St. Francis Street  
Suite 2900  
Mobile, Alabama 36602  
United States of America  
Telephone: (251) 343-4366  
www.mottmac.com/america

Client  
**ALABAMA STATE PORT AUTHORITY**  
MOBILE, ALABAMA

Rev	Date	Drawn	Description	Ch'k'd	App'd
2	07-27-23	KWD	AS-BUILT RECORD DRAWINGS	CEL	LJD
1	05-18-22	KWD	ADD 1 ISSUED FOR CONST	CEL	LJD
0	01-14-22	KWD	ISSUED FOR BID	CEL	LJD

**CHAD EDWARD LYNER, P.E.**  
28305 ALABAMA - CERTIFICATION NUMBER

AS-BUILT RECORD

Project Number **397324**


Designed	JQ	Eng Check	KP
Drawn	MC KWD	Coordination	LJD
Dwg Check	CEL	Approved	BP
Scale at ANSI D	Status	Rev	Security
As Shown	IFC	1	STD
Drawing Number	<b>U-01</b>		

Title  
**PIER B SOUTH**  
**NEW SHEET PILE RETAINING WALL AREAS 2 & 3 UTILITY PLANS**

UTILITY AS-BUILT ELEVATION TABLE


Benchmark	Northing	Easting	Elevation	Description
1000	258238.58	1797481.93	101.822	FIRE WATER
1001	258244.53	1797536.56	102.985	4" WATER LINE
1002	258245.45	1797537.07	103.003	4" WATER LINE 90
1003	258247.87	1797533.20	105.191	4" WATER LINE 90
1004	258253.90	1797536.71	105.388	4" WATER LINE
1005	258129.03	1797735.91	102.274	2" WATER LINE
1006	258129.76	1797736.33	102.339	2" WATER LINE 90
1007	258129.35	1797737.06	105.182	2" WATER LINE 90
1008	258127.19	1797741.81	103.681	2" WATER LINE 90
1009	258132.24	1797744.83	104.443	2" WATER LINE

NOTES:  
1. REFER TO PLANS FOR BENCHMARK LOCATIONS.

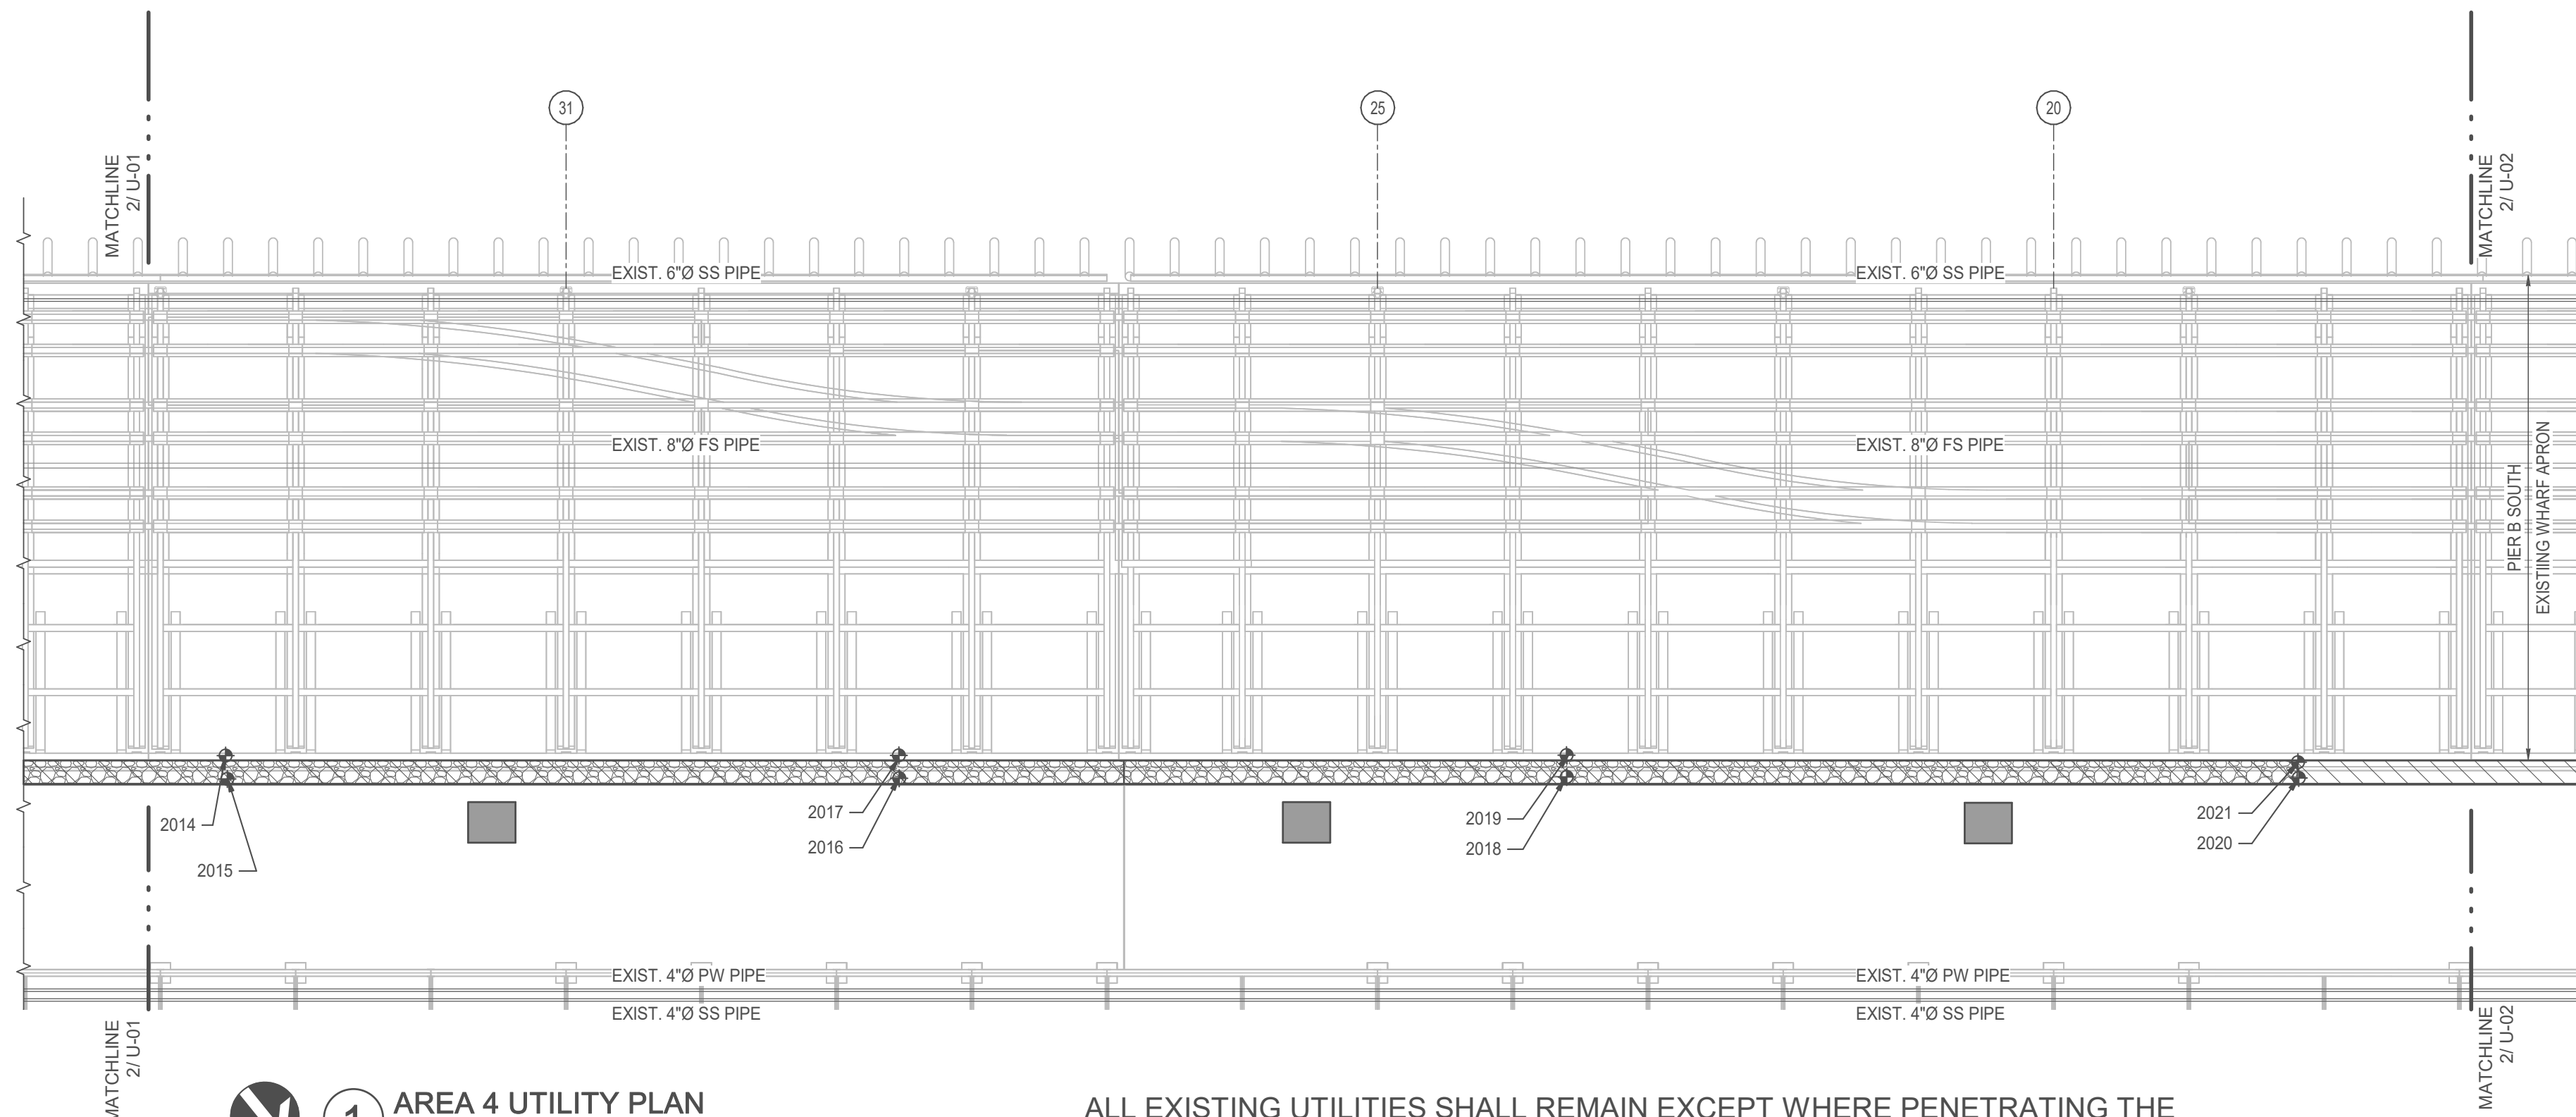

**1** AREA 4 UTILITY PLAN  
1" = 20'-0"




ALL EXISTING UTILITIES SHALL REMAIN EXCEPT WHERE PENETRATING THE NEW SHEET PILE WALL. A 6'-0" SECTION OF EXISTING PIPING SHALL BE DEMOLISHED AND REPLACED AT THE SHEET PILE INTERSECTION. REFER TO 1/U-03 FOR SPLICE DETAILS.

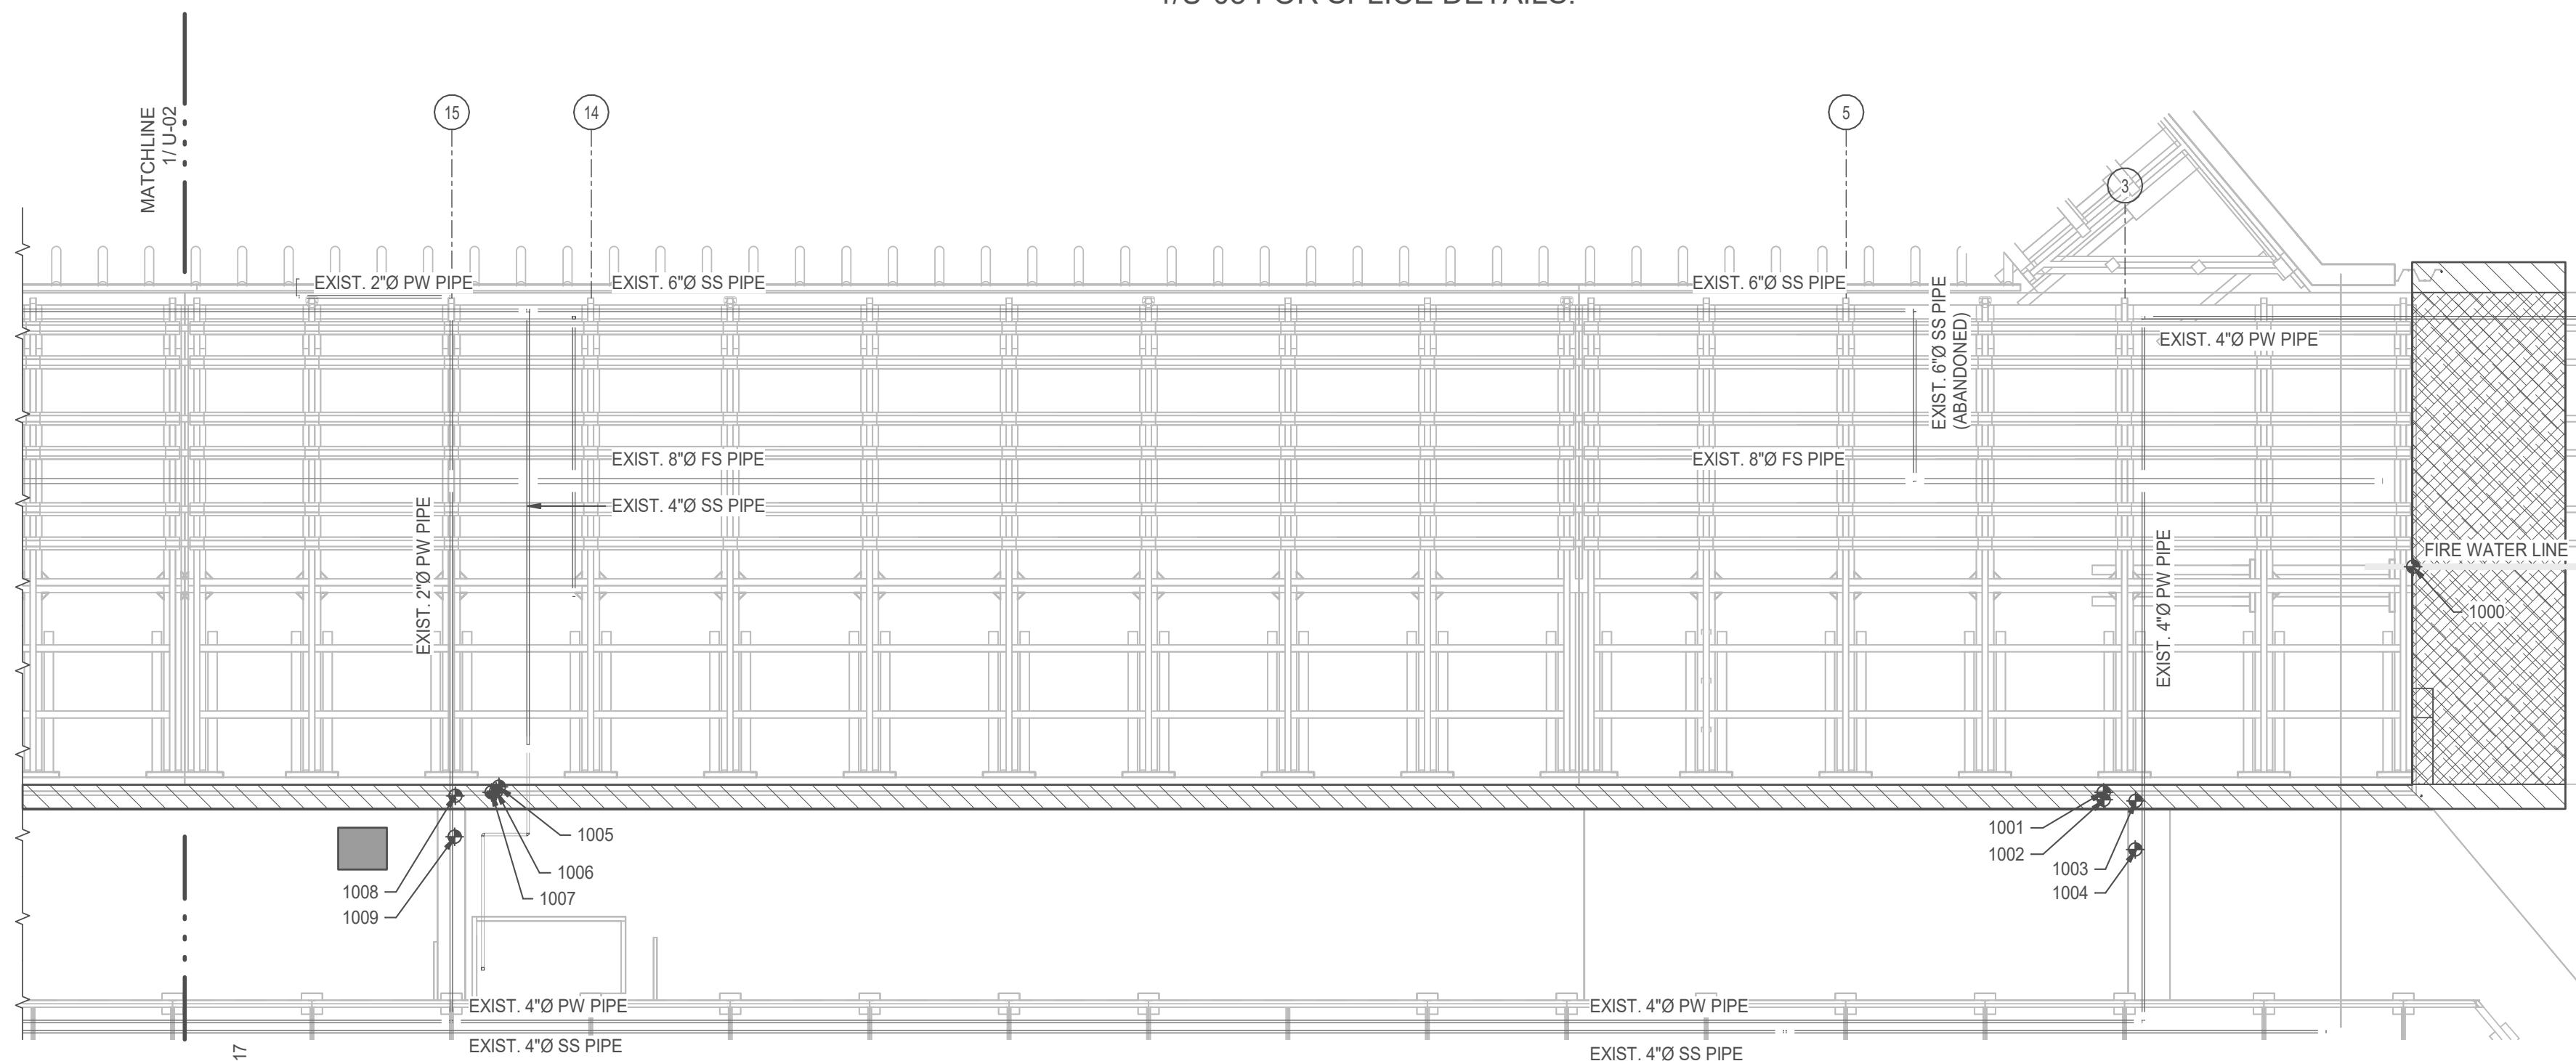


**2** AREA 5 UTILITY PLAN  
1" = 20'-0"

ALL EXISTING UTILITIES SHALL REMAIN EXCEPT WHERE PENETRATING THE NEW SHEET PILE WALL. A 6'-0" SECTION OF EXISTING PIPING SHALL BE DEMOLISHED AND REPLACED AT THE SHEET PILE INTERSECTION. REFER TO 1/U-03 FOR SPLICE DETAILS.

LEGEND:  
PW: POTABLE WATER  
SS: SANITARY SEWER  
FS: FIRE/SPRINKLER

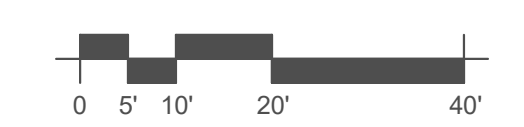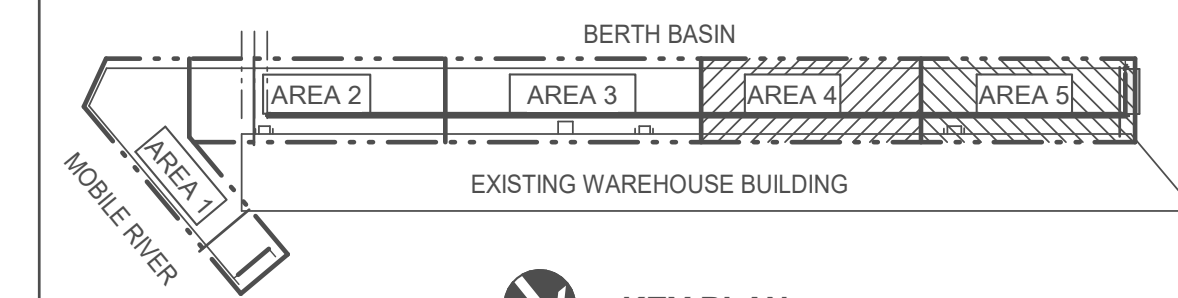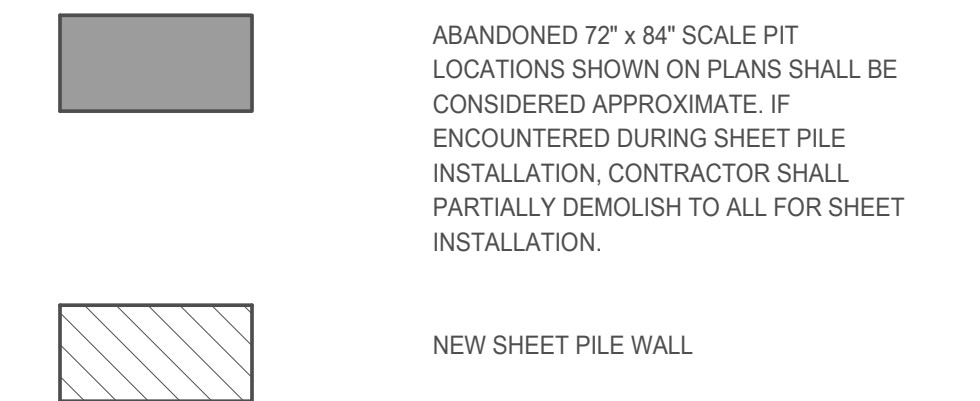


AS-BUILT INFORMATION SHOWN ON THIS DRAWING HAS BEEN OBSERVED AND SUPPLIED BY THE CONTRACTOR. MOTT MACDONALD DOES NOT ATTEST TO THE ACCURACY OF THE CONTRACTOR'S MARK-UPS, BUT SIGNIFICANT FIELD CHANGES SHOWN ON THE DRAWINGS WERE VERIFIED BY MOTT MACDONALD FOR CONFORMANCE WITH THE ORIGINAL DESIGN INTENT.

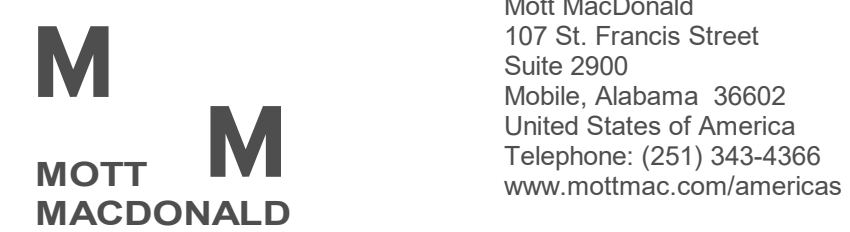

Client  
**ALABAMA STATE PORT AUTHORITY**  
MOBILE, ALABAMA

**CHAD EDWARD LYNER, P.E.**  
28305 ALABAMA - CERTIFICATION NUMBER

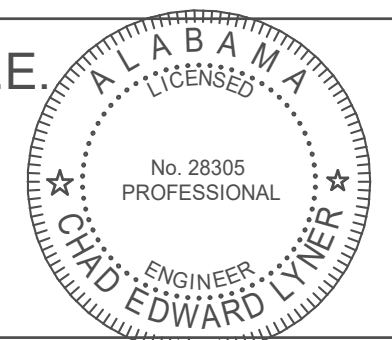

AS-BUILT RECORD

Rev	Date	Drawn	Description	Ch'k'd	App'd
2	07-27-23	KWD	AS-BUILT RECORD DRAWINGS	CEL	LJD
1	05-18-22	KWD	ADD 1 ISSUED FOR CONST	CEL	LJD
0	01-14-22	KWD	ISSUED FOR BID	CEL	LJD

Project Number **397324**

Designed	JQ	Eng Check	KP
Drawn	MC	Coordination	LJD
Dwg Check	CEL	Approved	BP
Scale at ANSI D	Status	Rev	Security
As Shown	IFC	1	STD
Drawing Number	<b>U-02</b>		


Title  
**PIER B SOUTH**  
**NEW SHEET PILE RETAINING WALL**  
**AREAS 4 & 5**  
**UTILITY PLANS**

SHEET PILE WALL REPLACEMENT

PIER B SOUTH

397324

7/28/2023 10:01:20 AM

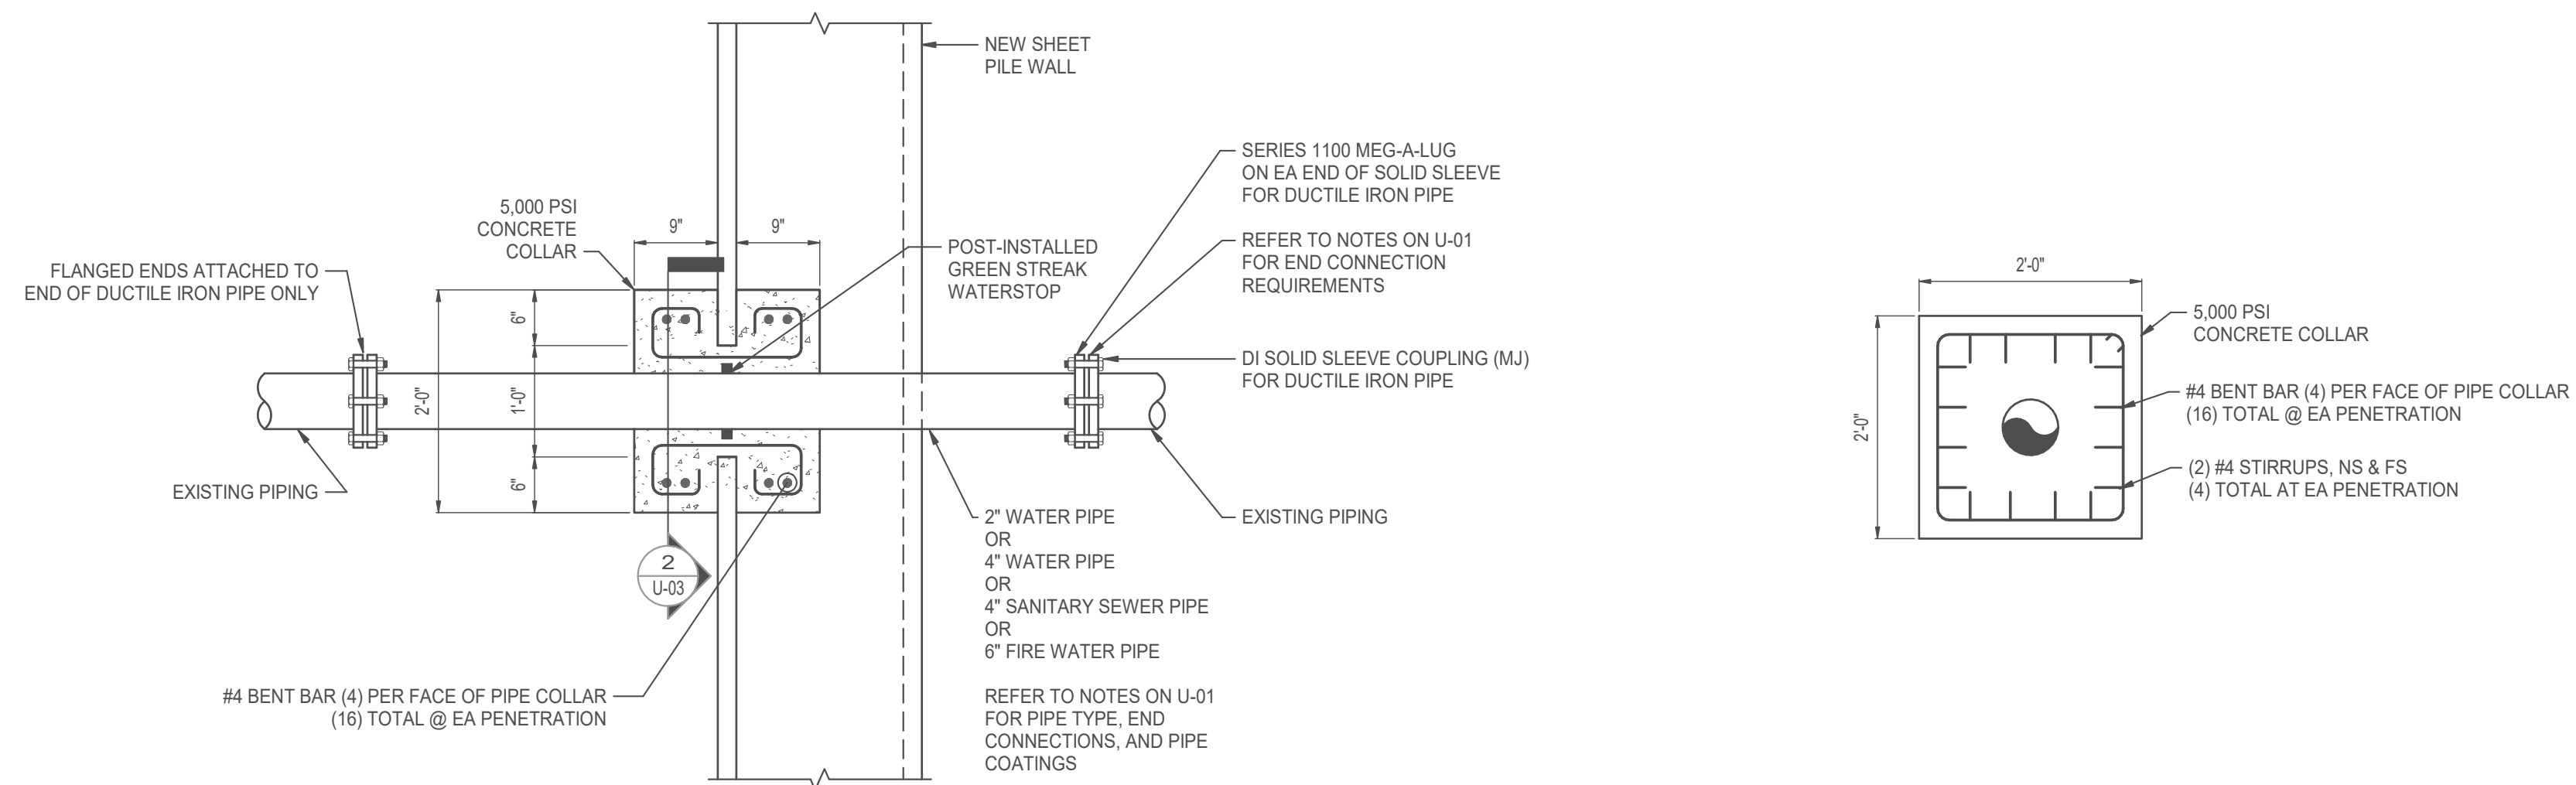


**1** WALL PENETRATION SECTION  
U-03 3/4" = 1'-0"

**2** WALL PENETRATION ELEVATION  
U-03 3/4" = 1'-0"



AS-BUILT INFORMATION SHOWN ON THIS DRAWING HAS BEEN OBSERVED AND SUPPLIED BY THE CONTRACTOR. MOTT MACDONALD DOES NOT ATTEST TO THE ACCURACY OF THE CONTRACTOR'S MARK-UPS, BUT SIGNIFICANT FIELD CHANGES SHOWN ON THE DRAWINGS WERE VERIFIED BY MOTT MACDONALD FOR CONFORMANCE WITH THE ORIGINAL DESIGN INTENT.

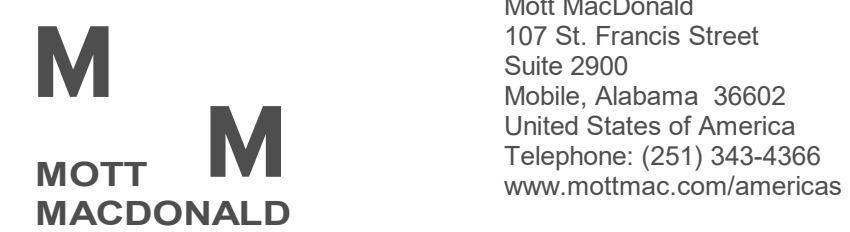


Mott MacDonald  
107 St. Francis Street  
Suite 2900  
Mobile, Alabama 36602  
United States of America  
Telephone: (251) 343-4366  
www.mottmac.com/americas

Client  
**ALABAMA STATE PORT AUTHORITY**  
  
MOBILE, ALABAMA

Rev	Date	Drawn	Description	Ch'k'd	App'd
2	07-27-23	KWD	AS-BUILT RECORD DRAWINGS	CEL	LJD
1	05-18-22	KWD	ADD 1 ISSUED FOR CONST	CEL	LJD
0	01-14-22	KWD	ISSUED FOR BID	CEL	LJD

**CHAD EDWARD LYNER, P.E.**  
28305 ALABAMA - CERTIFICATION NUMBER

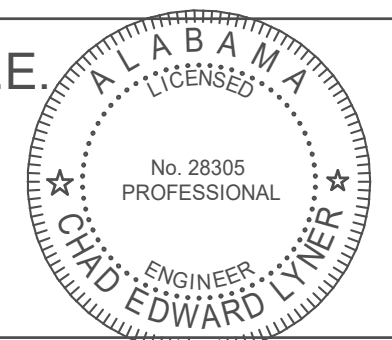


AS-BUILT RECORD

Project Number **397324** B/O Total

Designed	JQ	Eng Check	KP
Drawn	MC	Coordination	LJD
Dwg Check	CEL	Approved	BP
Scale at ANSI D As Shown	Status IFC	Rev 1	Security STD

Title  
**PIER B SOUTH**  
  
**NEW SHEET PILE RETAINING WALL UTILITY DETAILS**

Drawing Number **U-03**

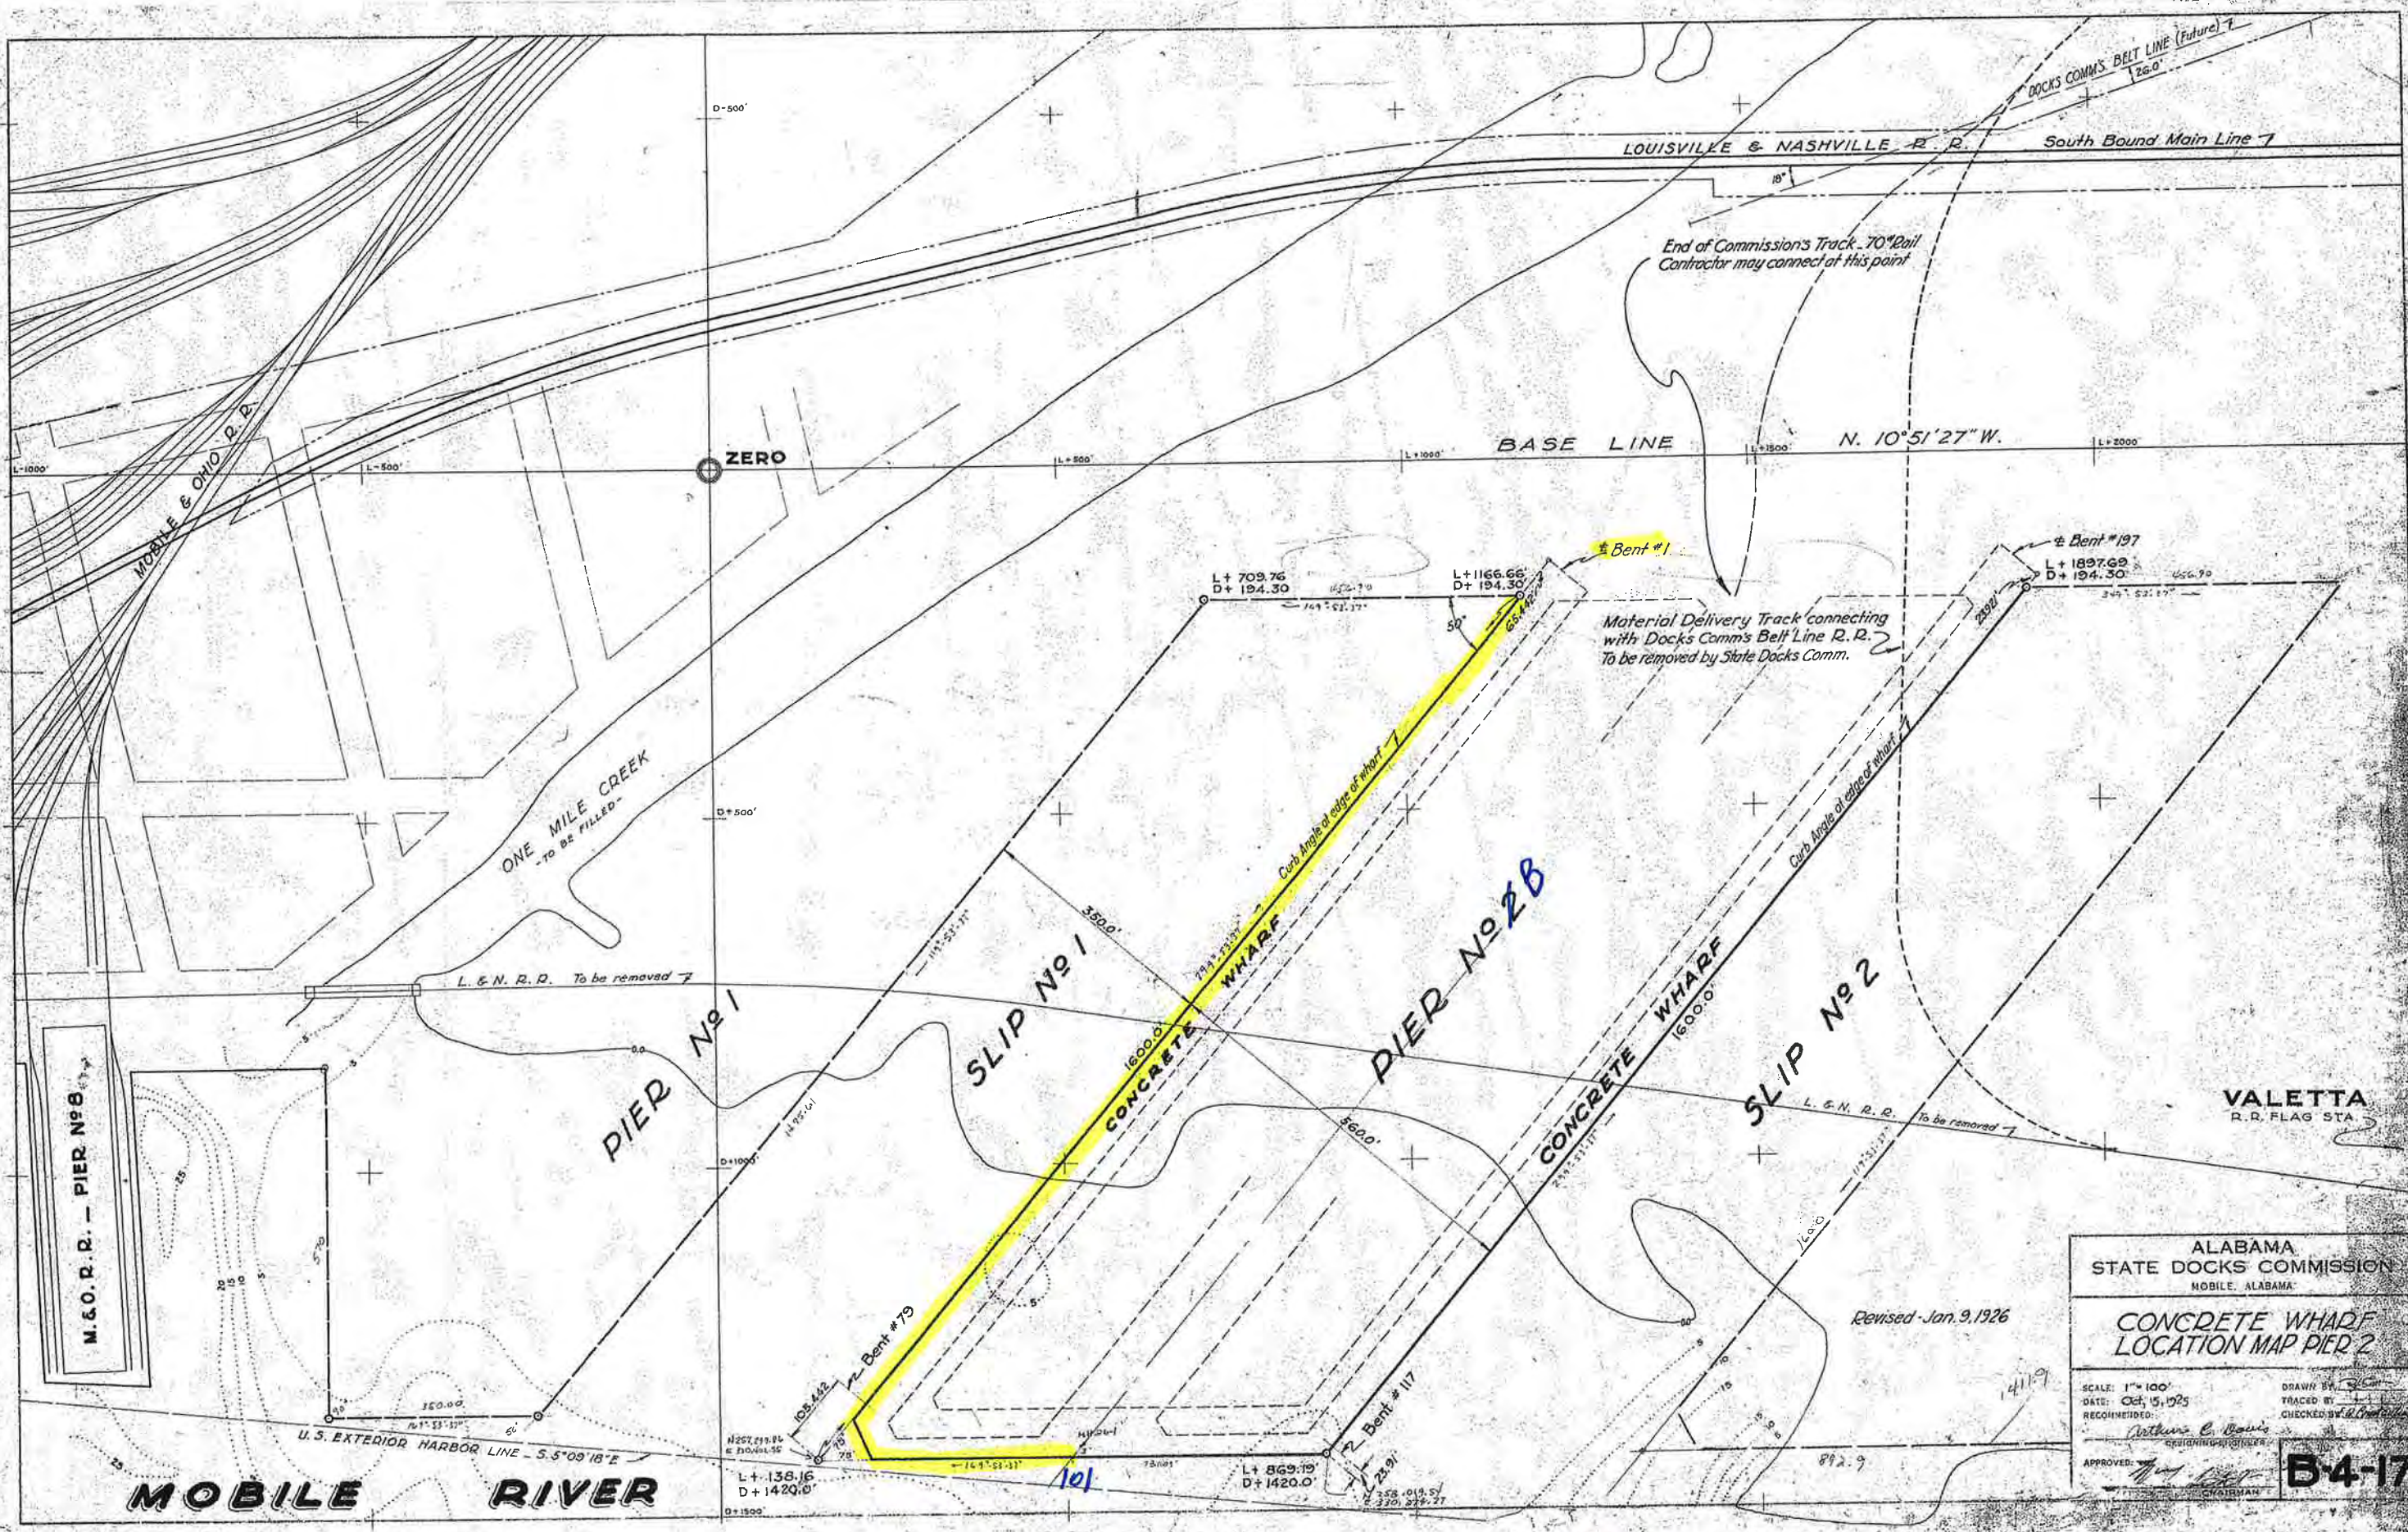

ALABAMA  
 STATE DOCKS COMMISSION  
 MOBILE, ALABAMA


Revised - Jan. 9, 1926

**CONCRETE WHARF  
 LOCATION MAP PIER 2**


SCALE: 1" = 100'  
 DATE: Oct. 15, 1925  
 RECOMMENDED: [Signature]  
 APPROVED: [Signature]  
 DESIGNING ENGINEER  
 CHAIRMAN

DRAWN BY: [Signature]  
 TRACED BY: [Signature]  
 CHECKED BY: [Signature]


**B4-17**

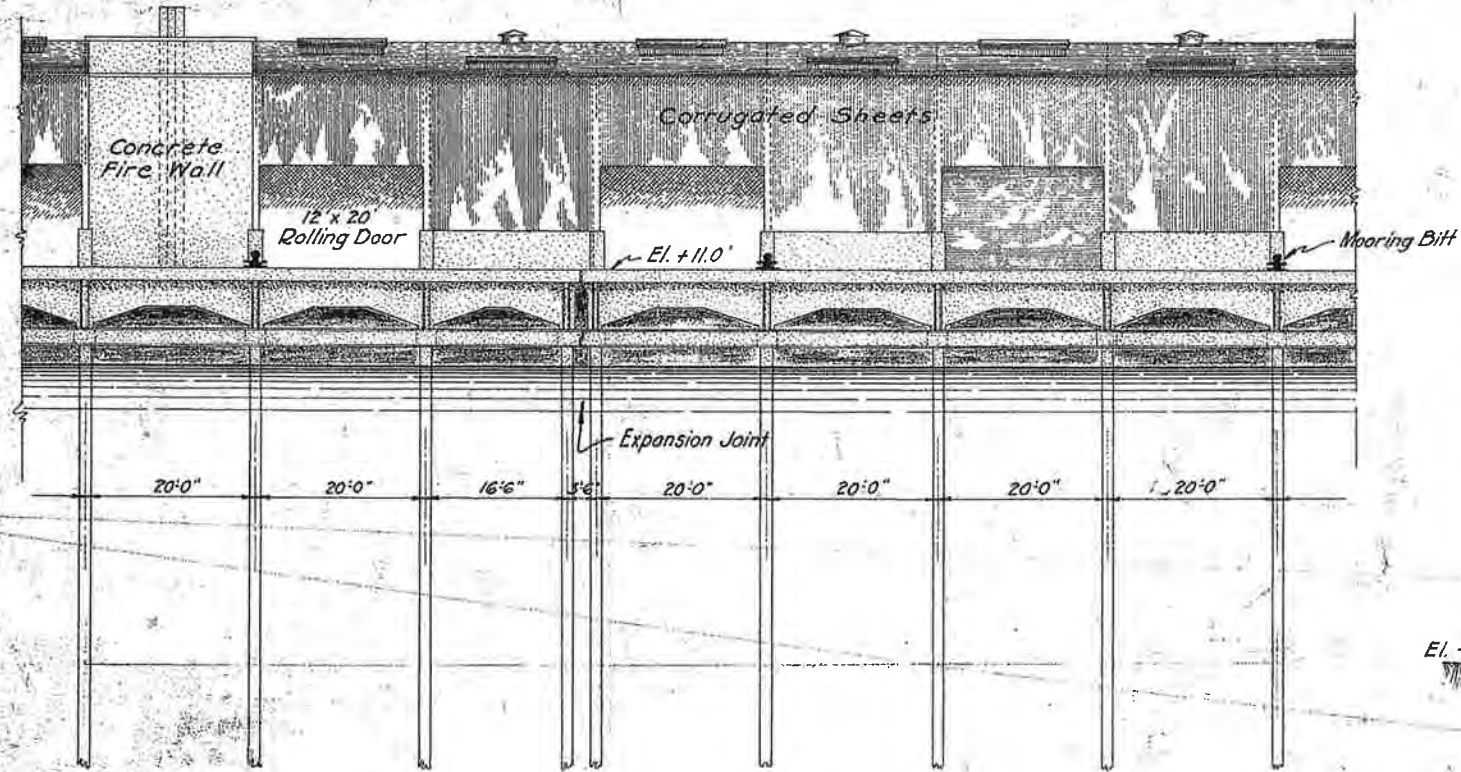

FRONT ELEVATION A-A

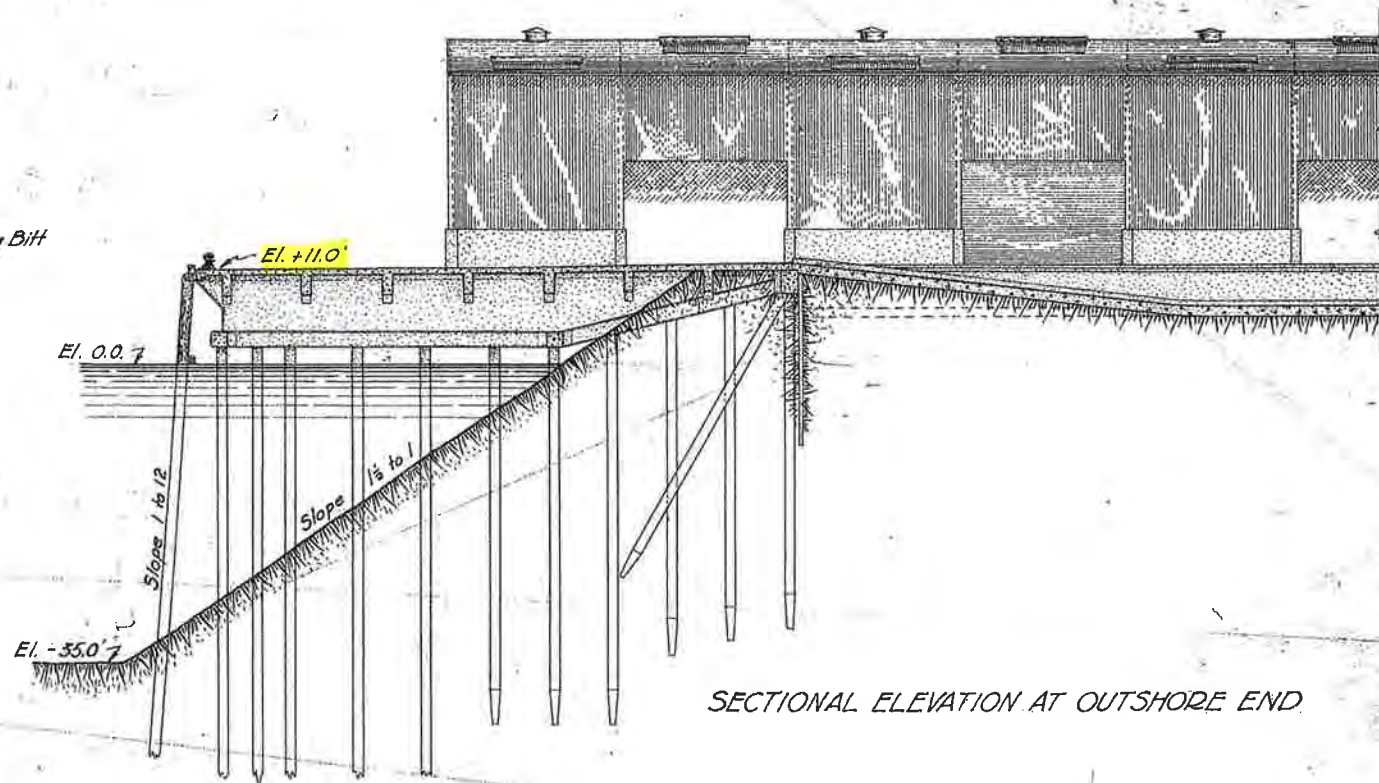


SECTIONAL ELEVATION AT OFFSHORE END

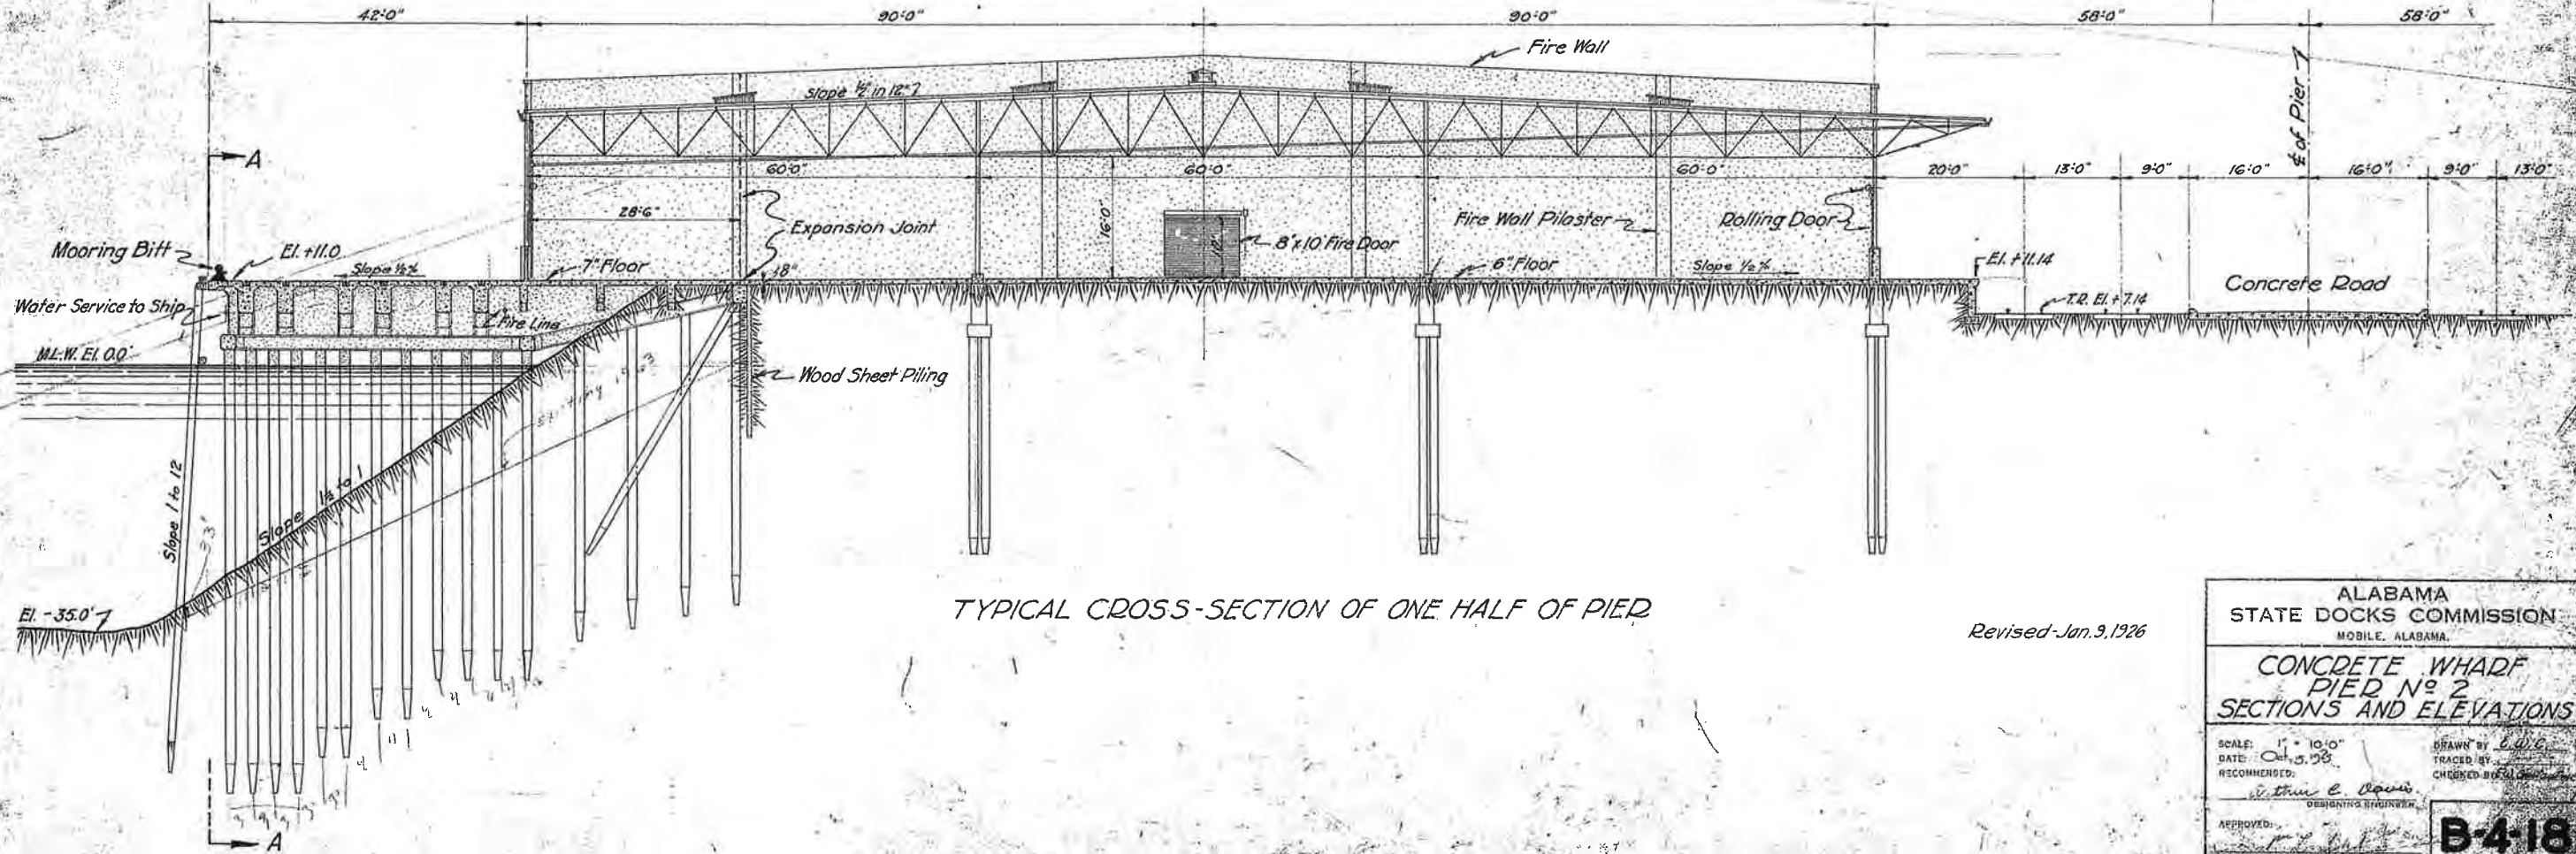

TYPICAL CROSS-SECTION OF ONE HALF OF PIER

Revised-Jan. 9, 1926

ALABAMA STATE DOCKS COMMISSION MOBILE, ALABAMA.	
CONCRETE WHARF PIER NO. 2 SECTIONS AND ELEVATIONS	
SCALE: 1" = 10'-0"	DRAWN BY: E.D.C.
DATE: Oct. 5, 1925	TRACED BY:
RECOMMENDED:	CHECKED BY:
APPROVED:	DESIGNING ENGINEER:
	CHAIRMAN:
	<b>B-4-18</b>

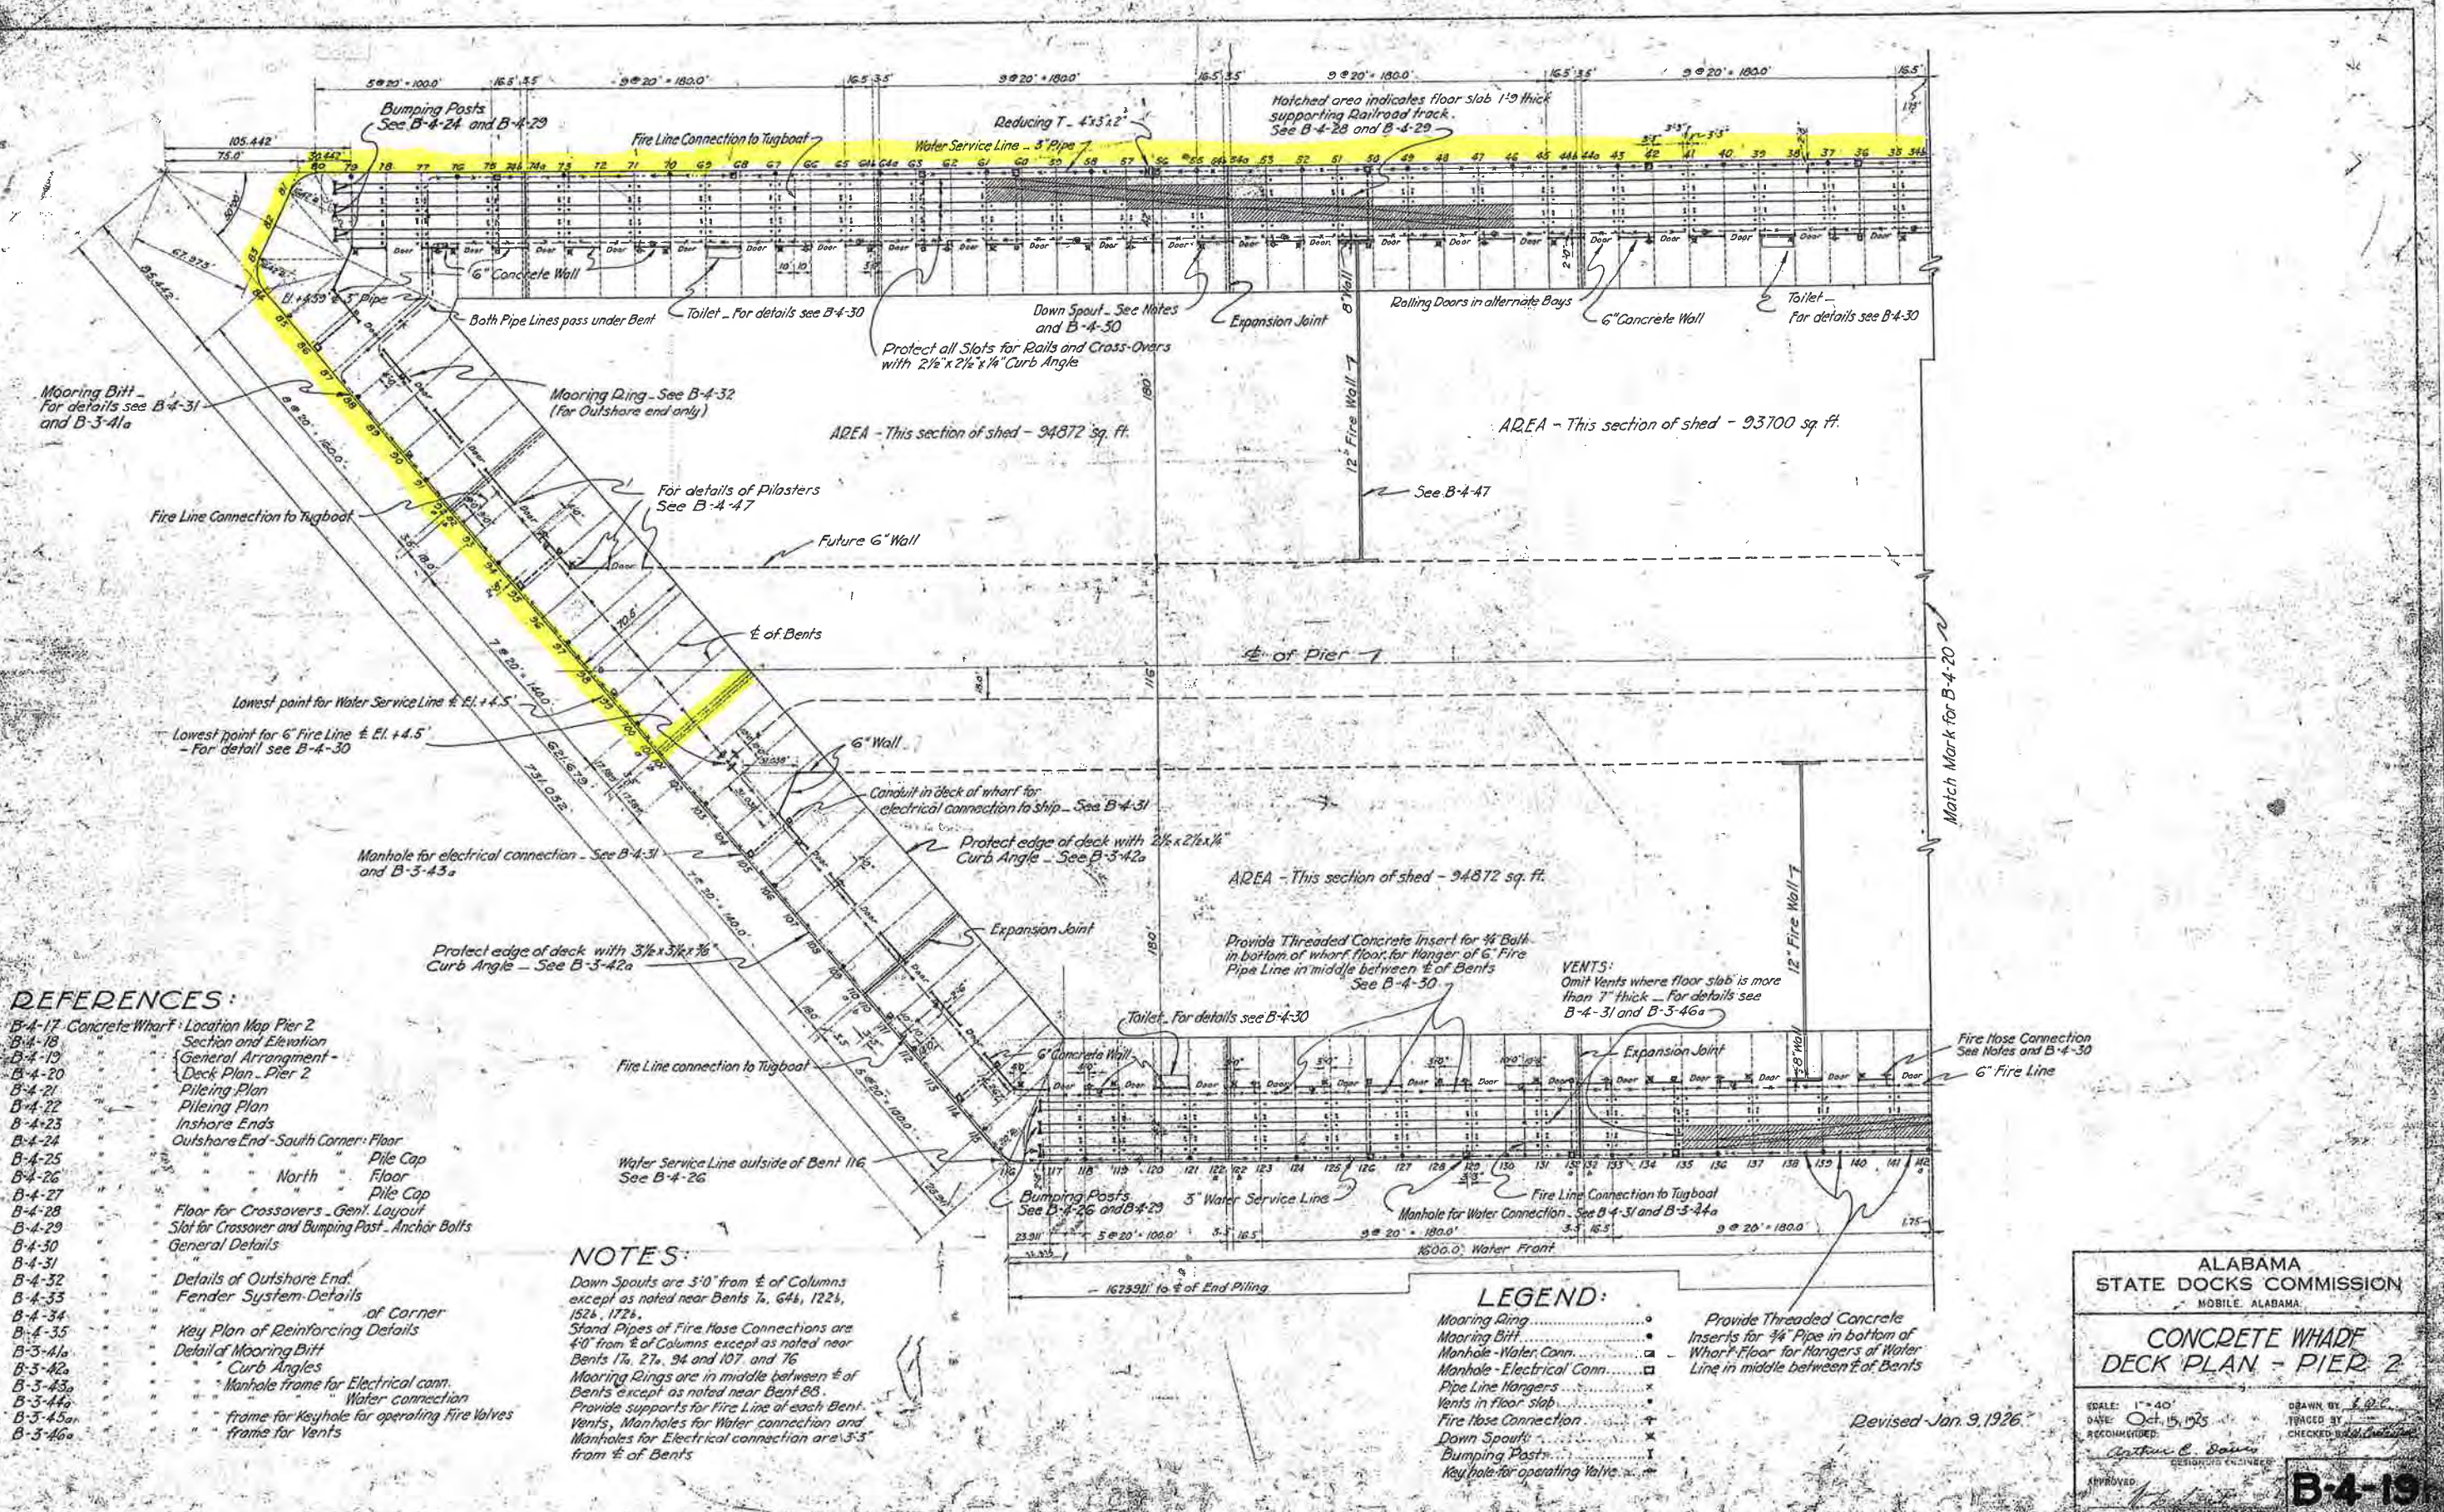

- REFERENCES:**
- B-4-17 Concrete Wharf - Location Map Pier 2
  - B-4-18 Section and Elevation
  - B-4-19 General Arrangement - Deck Plan - Pier 2
  - B-4-20 Piling Plan
  - B-4-21 Piling Plan
  - B-4-22 Inshore Ends
  - B-4-23 Outshore End - South Corner - Floor
  - B-4-24 Pile Cap
  - B-4-25 North Floor
  - B-4-26 Pile Cap
  - B-4-27 Floor for Crossovers - Genl. Layout
  - B-4-28 Slot for Crossover and Bumping Post - Anchor Bolts
  - B-4-29 General Details
  - B-4-30 Details of Outshore End
  - B-4-31 Fender System - Details
  - B-4-32 of Corner
  - B-4-33 Key Plan of Reinforcing Details
  - B-4-34 Detail of Mooring Bitt
  - B-4-35 Curb Angles
  - B-3-41a Manhole frame for Electrical conn.
  - B-3-42a Water connection
  - B-3-43a Manhole for operating Fire Valves
  - B-3-44a frames for Vents
  - B-3-45a
  - B-3-46a

- NOTES:**
- Down Spouts are 5'-0" from  $\epsilon$  of Columns except as noted near Bents 76, 64b, 122b, 152b, 172b.
  - Stand Pipes of Fire Hose Connections are 4'-0" from  $\epsilon$  of Columns except as noted near Bents 116, 276, 94 and 107 and 76
  - Mooring Rings are in middle between  $\epsilon$  of Bents except as noted near Bent 83.
  - Provide supports for Fire Line of each Bent.
  - Vents, Manholes for Water connection and Manholes for Electrical connection are 3'-3" from  $\epsilon$  of Bents

- LEGEND:**
- Mooring Ring
  - Mooring Bitt
  - Manhole - Water Conn.
  - Manhole - Electrical Conn.
  - Pipe Line Hangers
  - Vents in floor slab
  - Fire Hose Connection
  - Down Spouts
  - Bumping Posts
  - Keyhole for operating Valve
  - Provide Threaded Concrete Inserts for  $\frac{3}{4}$ " Pipe in bottom of Wharf Floor for Hangers of Water Line in middle between  $\epsilon$  of Bents

ALABAMA  
STATE DOCKS COMMISSION  
MOBILE, ALABAMA

**CONCRETE WHARF  
DECK PLAN - PIER 2**


SCALE: 1" = 40'  
DATE: Oct. 15, 1925  
RECOMMENDED:  
APPROVED:

DRAWN BY: J.P.C.  
TRACED BY:  
CHECKED BY:

Revised - Jan. 9, 1926

**B-4-19**



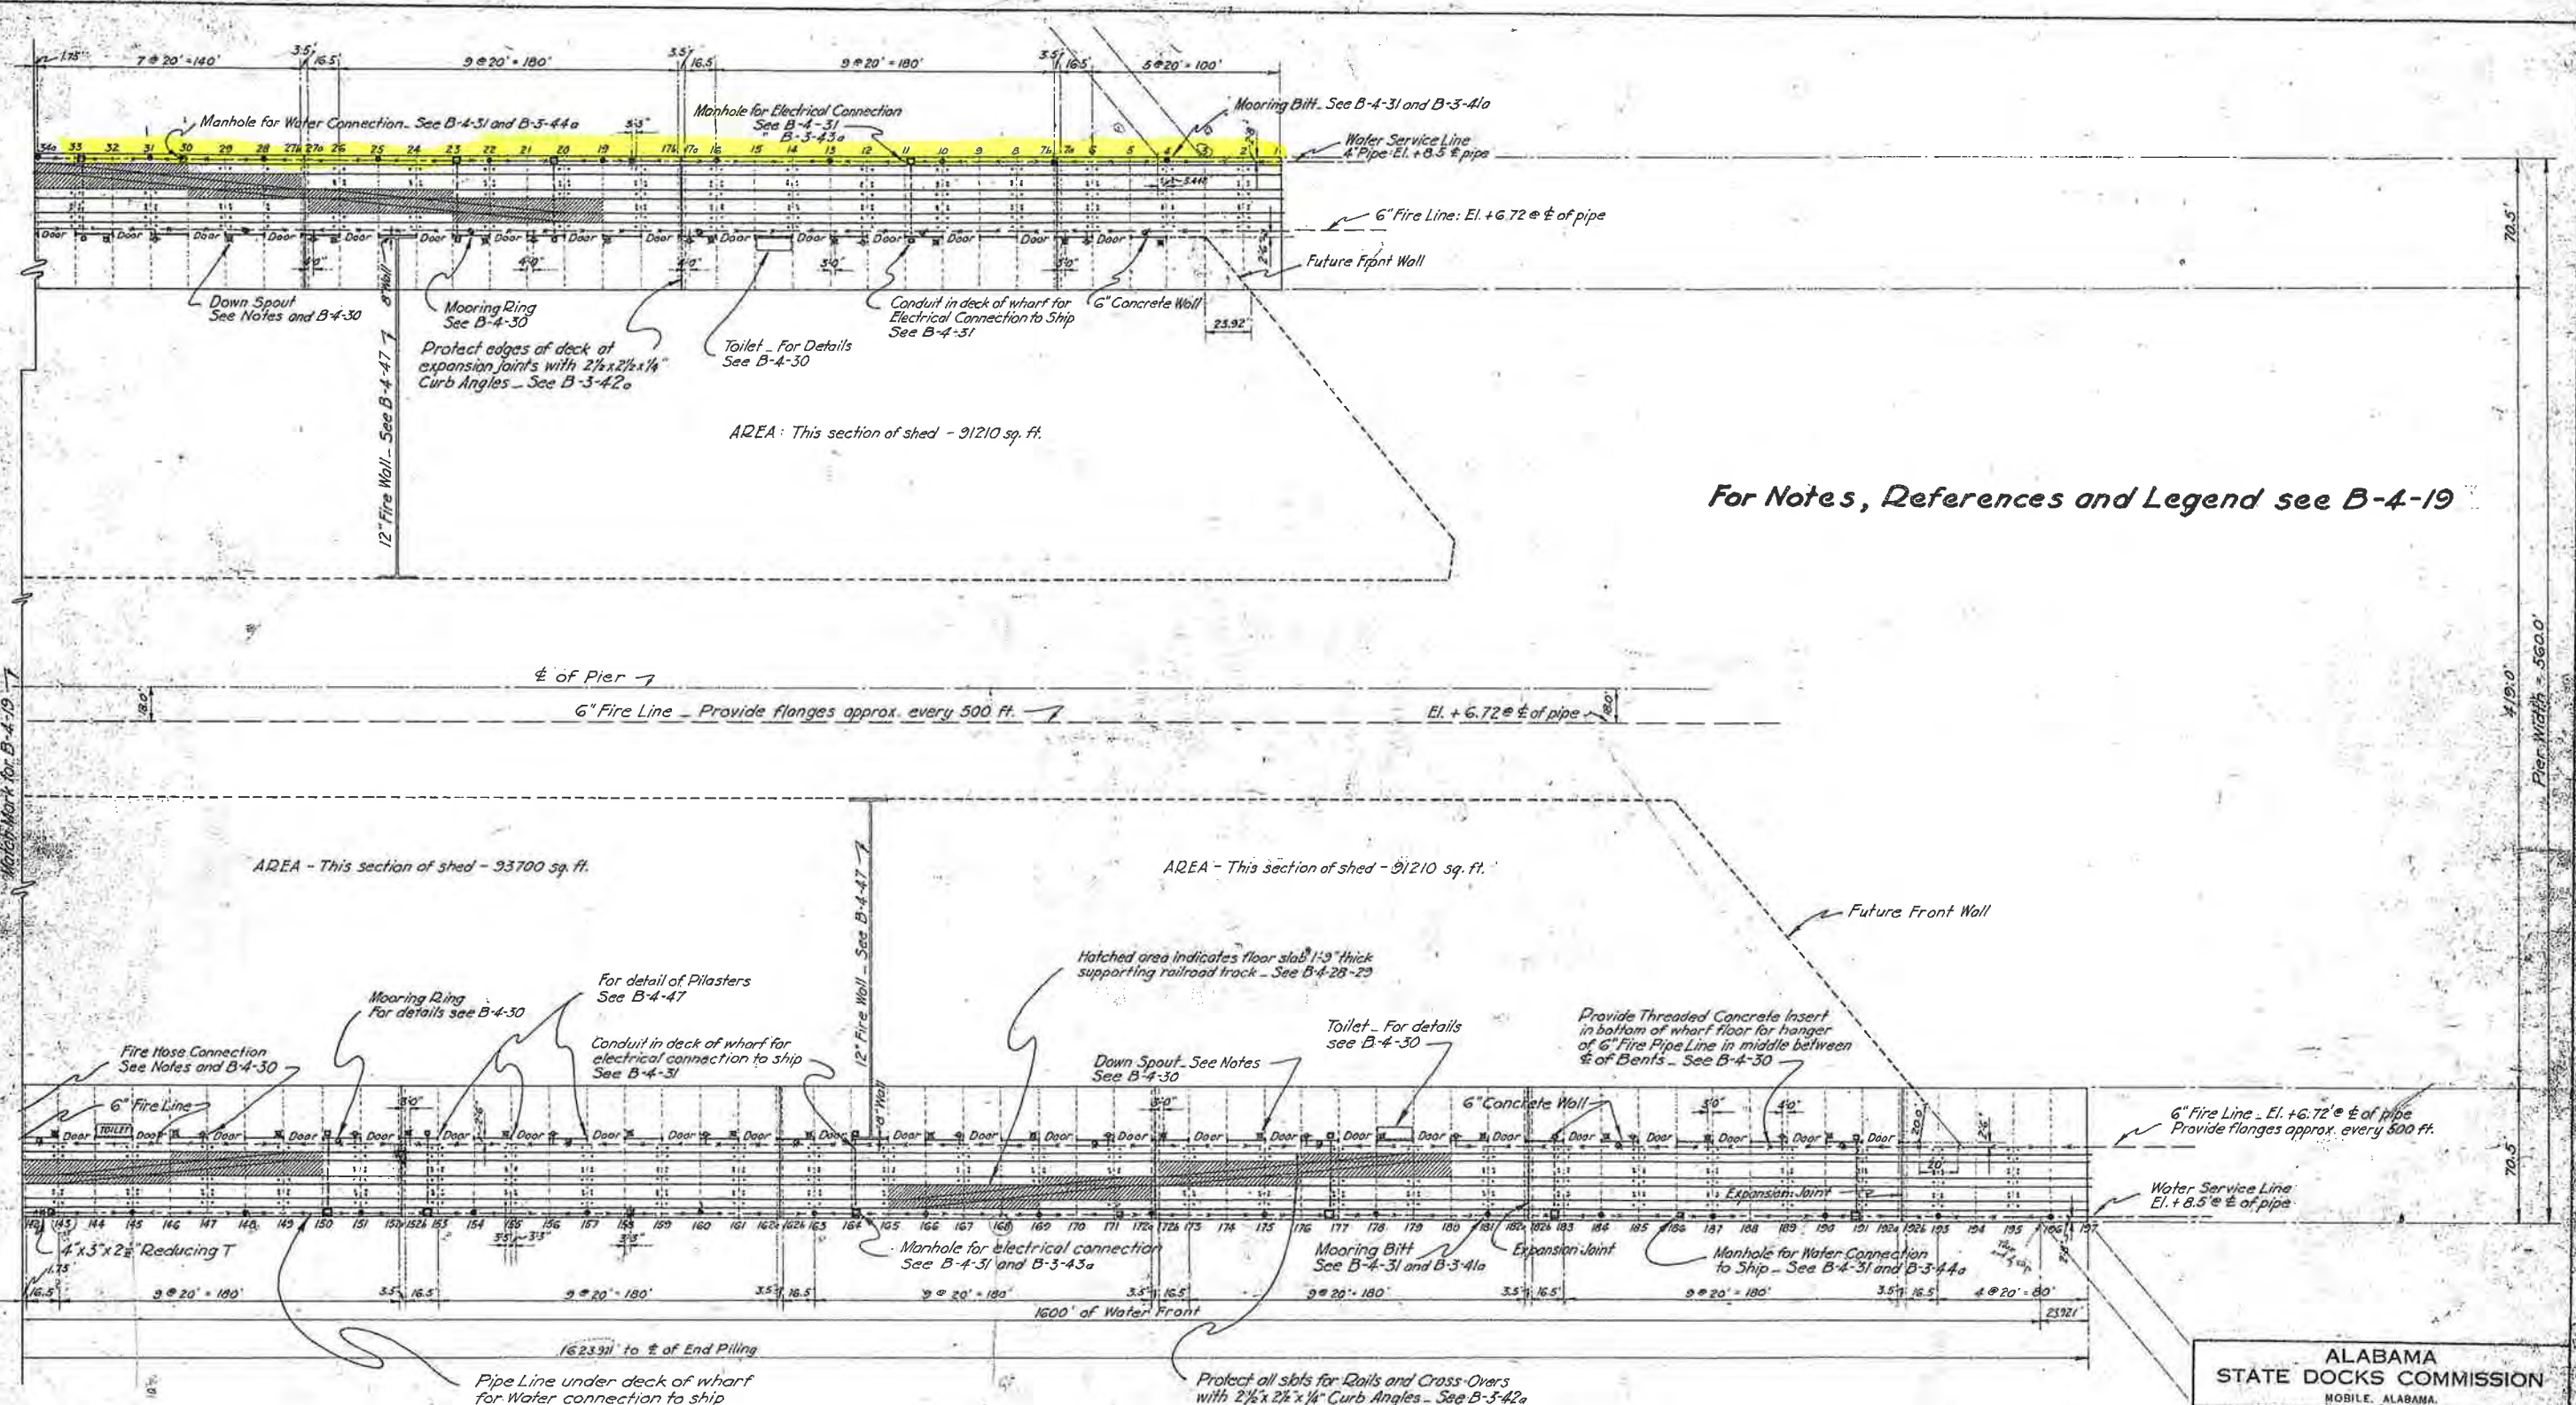


For Notes, References and Legend see B-4-19

**DECK PLAN**  
General Arrangement

Revised-Jan. 9, 1926

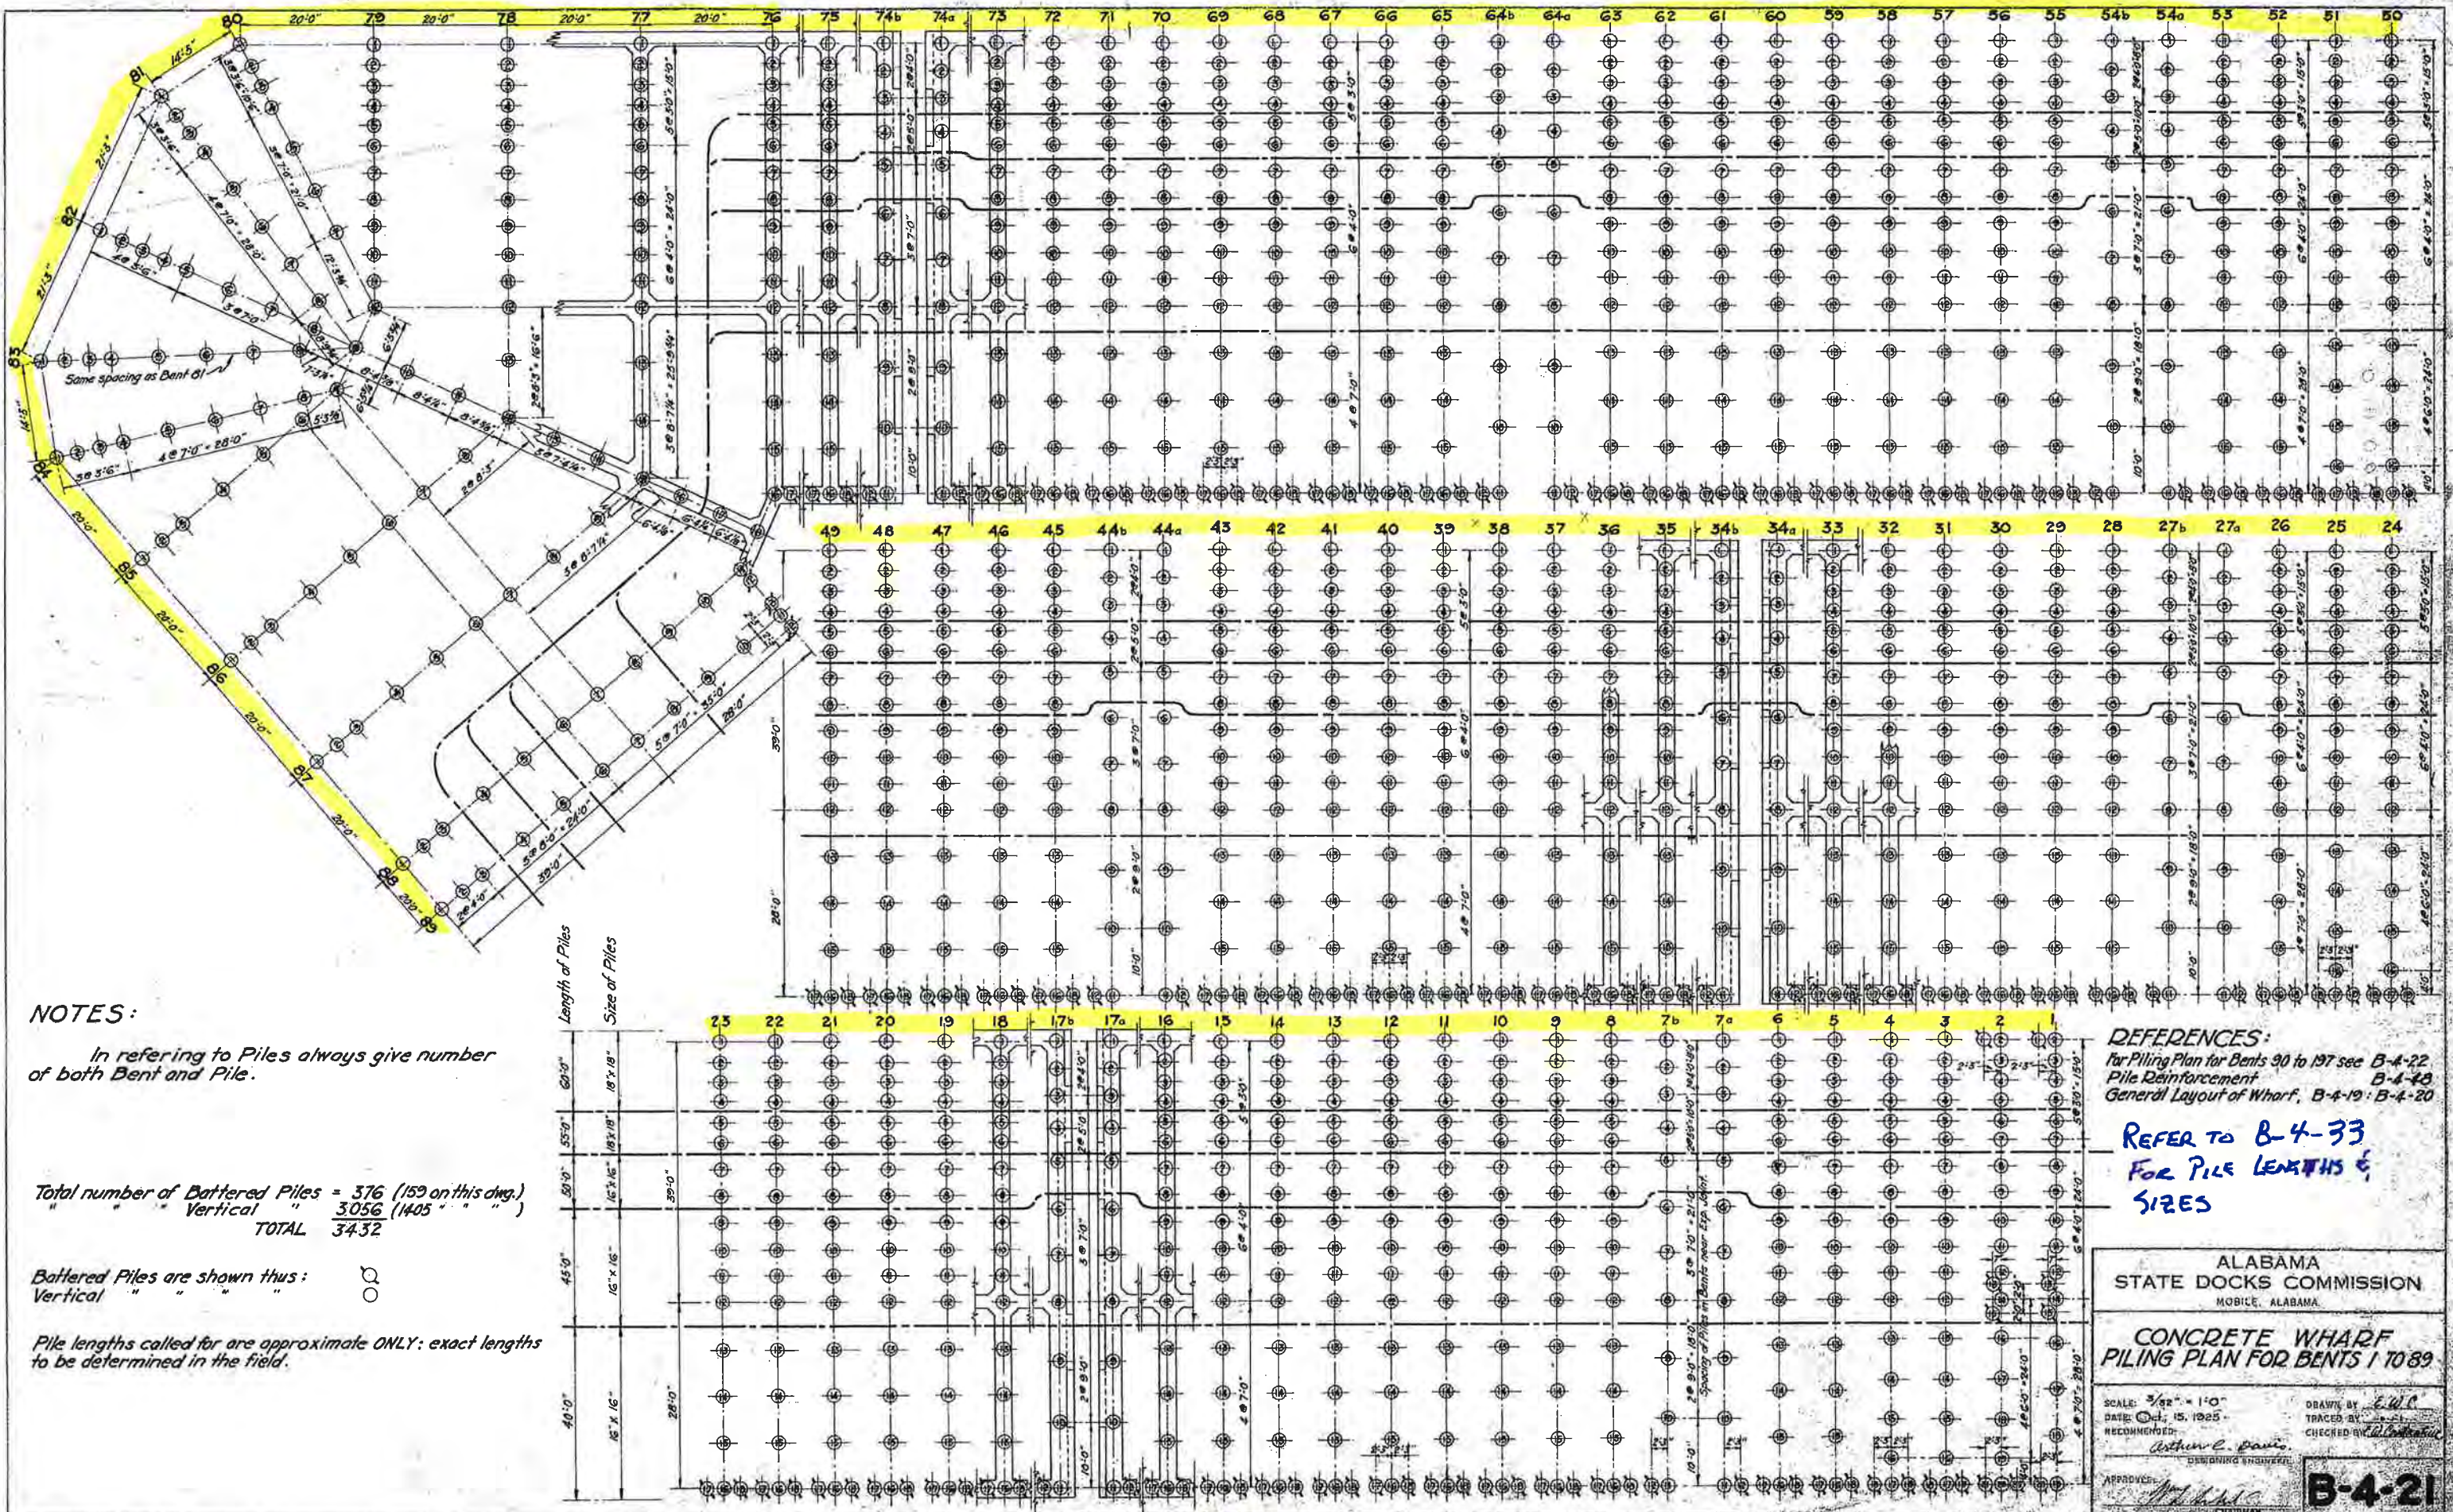

<b>ALABAMA</b> <b>STATE DOCKS COMMISSION</b> MOBILE, ALABAMA.	
<b>CONCRETE WHARF</b> <b>DECK PLAN - PIER 2</b>	
SCALE: 1" = 40' DATE: Oct. 5, 1925 RECOMMENDED:	DRAWN BY: E.M.C. TRACED BY: CHECKED BY:
APPROVED: <i>Arthur S. Davis</i> REGISTERED ENGINEER	CHAIRMAN: <i>W. H. ...</i>
<b>B-4-20</b>	



**NOTES:**

In referring to Piles always give number of both Bent and Pile.

Total number of Battered Piles = 376 (159 on this dwg.)  
 " " " " Vertical 3056 (1405 " " " " )  
 TOTAL 3432

Battered Piles are shown thus:   
 Vertical " " " " 

Pile lengths called for are approximate ONLY: exact lengths to be determined in the field.

**REFERENCES:**  
 for Piling Plan for Bents 90 to 197 see B-4-22  
 Pile Reinforcement B-4-48  
 General Layout of Wharf, B-4-19; B-4-20

**REFER TO B-4-33  
 FOR PILE LENGTHS &  
 SIZES**

ALABAMA  
 STATE DOCKS COMMISSION  
 MOBILE, ALABAMA

**CONCRETE WHARF  
 PILING PLAN FOR BENTS 1 TO 89**


SCALE: 3/32" = 1'-0"  
 DATE: Oct. 15, 1925  
 RECOMMENDED:  
 Arthur E. Davis  
 DESIGNING ENGINEER

DRAWN BY: E.W.C.  
 TRACED BY: [Signature]  
 CHECKED BY: [Signature]

APPROVED:  
 [Signature]  
 CHIEF ENGINEER

**B-4-21**

WATER

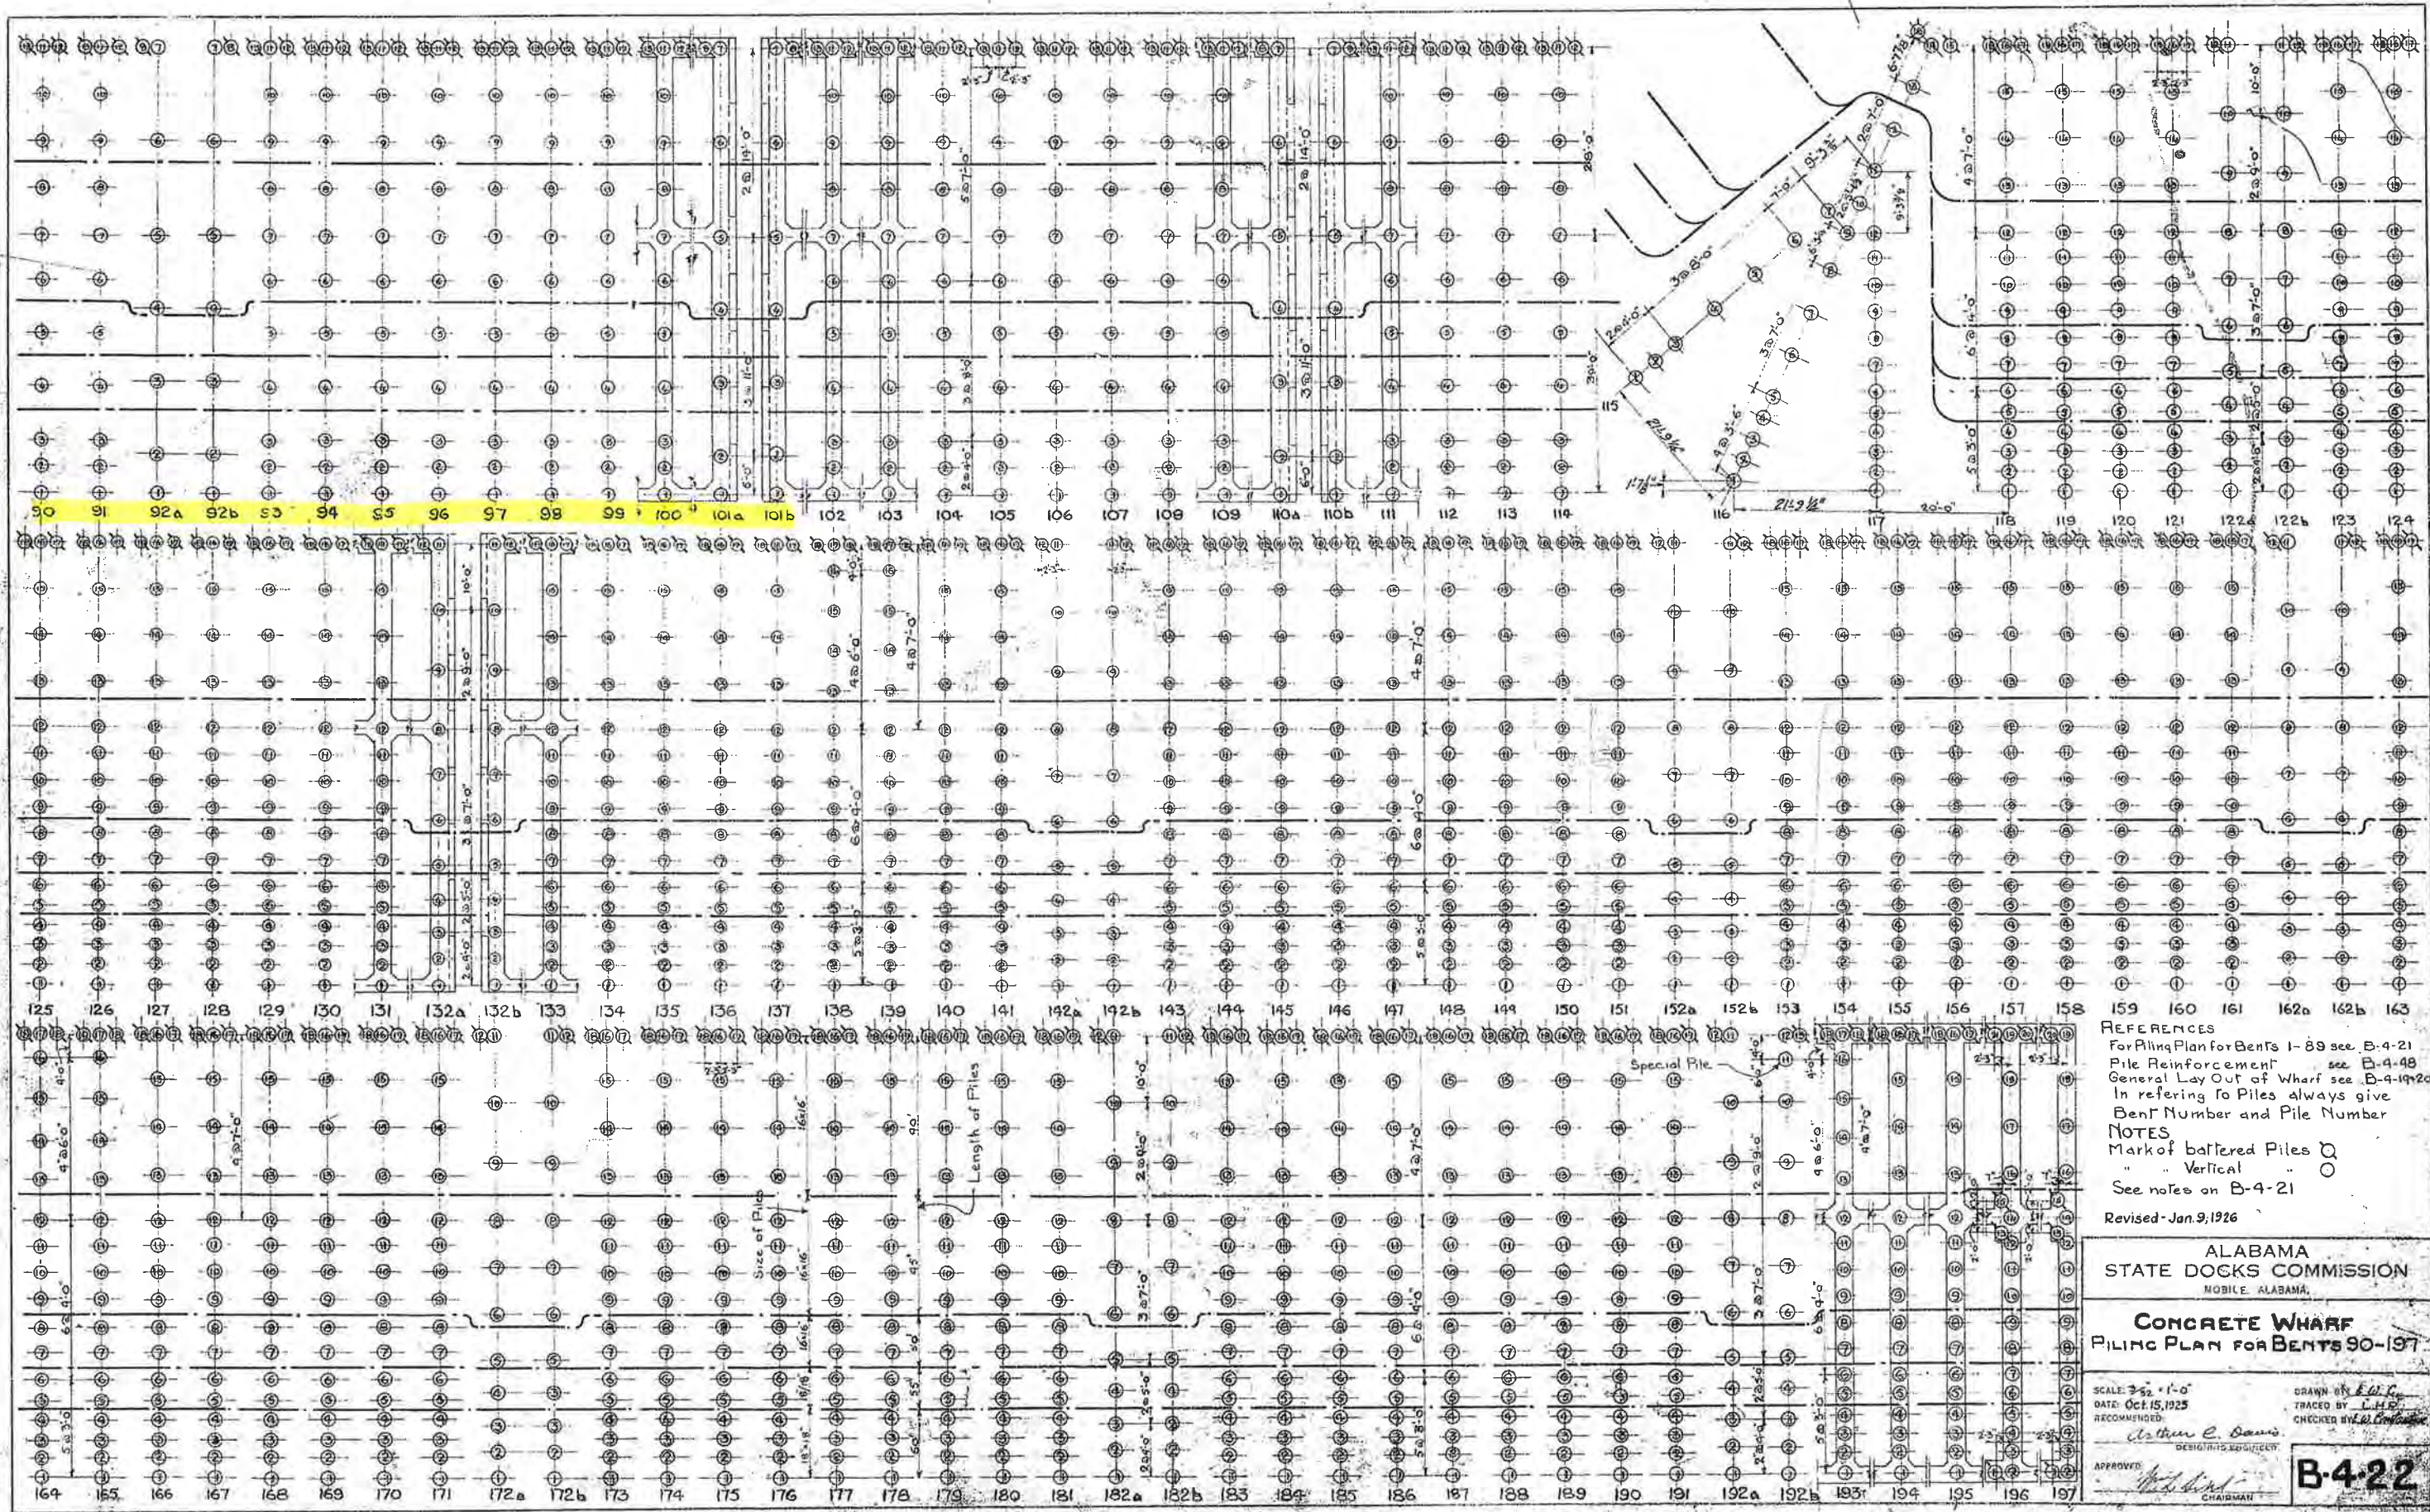

REFERENCES  
 For Piling Plan for Bents 1-89 see B-4-21  
 Pile Reinforcement see B-4-48  
 General Lay Out of Wharf see B-4-1920  
 In referring to Piles always give Bent Number and Pile Number

NOTES  
 Mark of battered Piles  $\odot$   
 " Vertical  $\circ$   
 See notes on B-4-21

Revised-Jan. 9, 1926


ALABAMA  
 STATE DOCKS COMMISSION  
 MOBILE, ALABAMA.

**CONCRETE WHARF  
 PILING PLAN FOR BENTS 90-197**

SCALE: 3/32" = 1'-0"  
 DATE: Oct. 15, 1925  
 RECOMMENDED  
 APPROVED: *Arthur E. Davis*  
 DESIGNING SUPERVISOR  
 CHAIRMAN

DRAWN BY: *E. W. C.*  
 TRACED BY: *L. H. P.*  
 CHECKED BY: *L. H. P.*

**B-4-22**

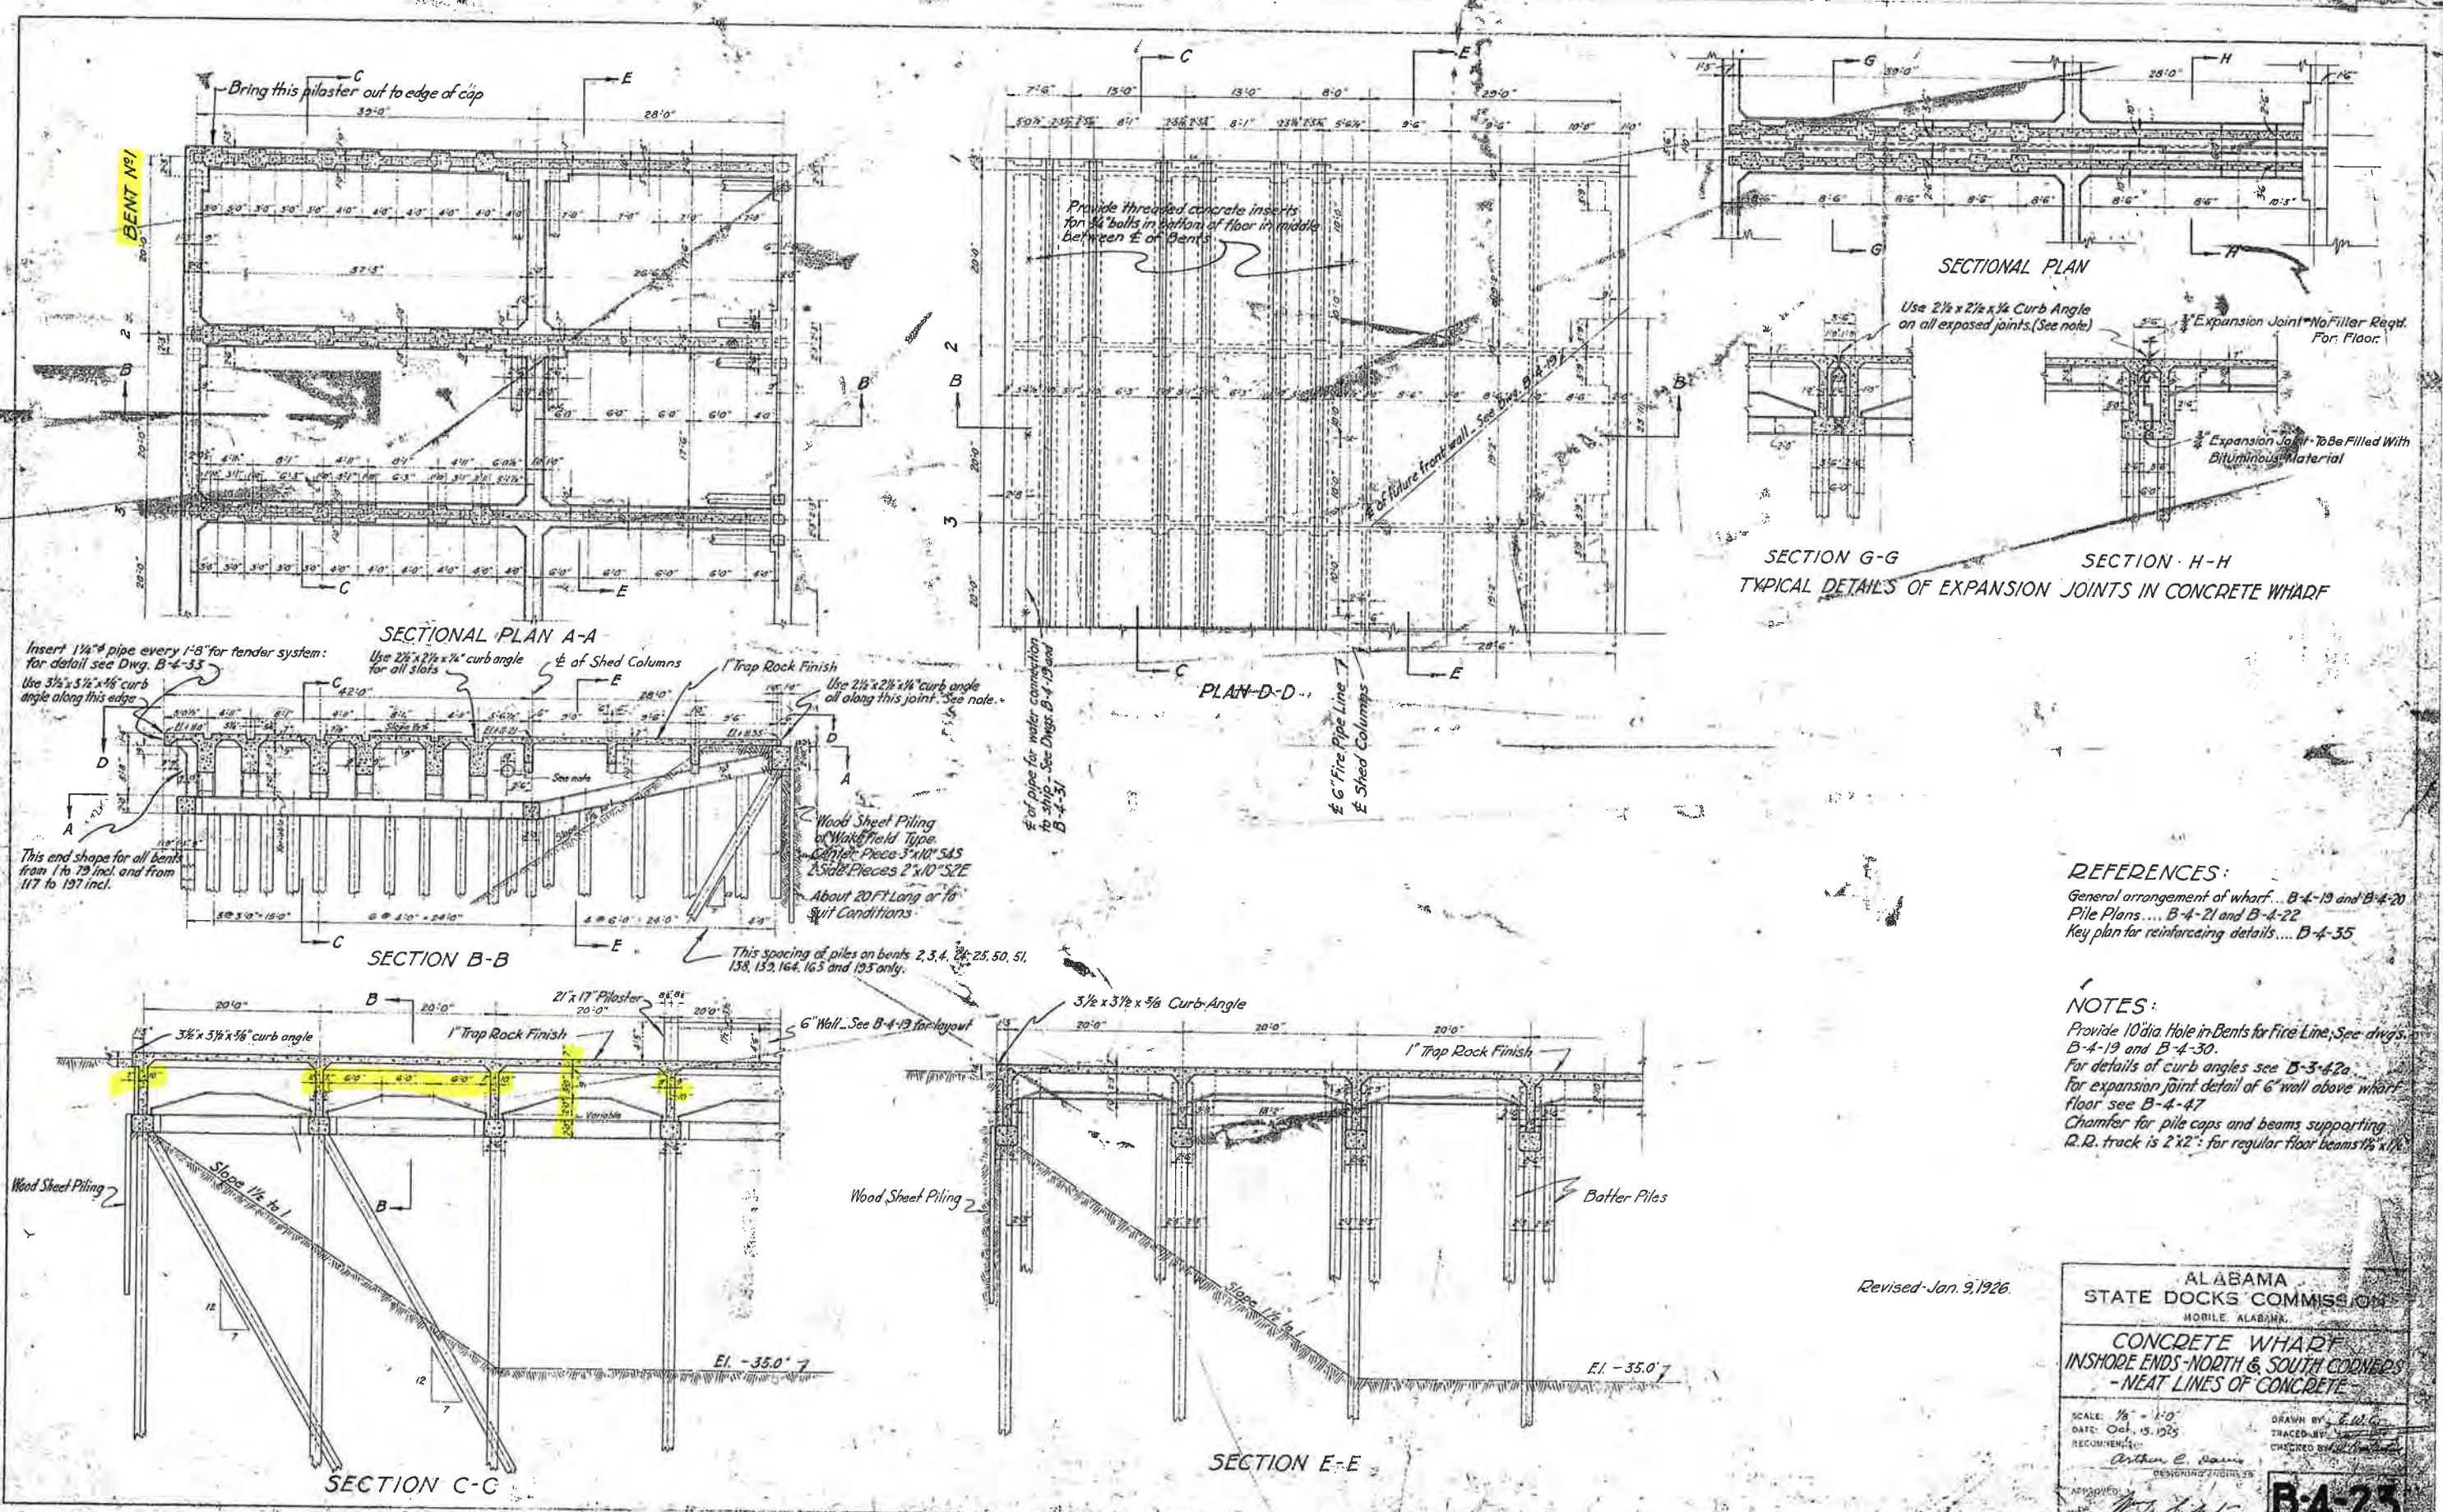


**REFERENCES:**  
 General arrangement of wharf... B-4-19 and B-4-20  
 Pile Plans... B-4-21 and B-4-22  
 Key plan for reinforcing details... B-4-35

**NOTES:**  
 Provide 10" dia Hole in Bents for Fire Line; See drgs. B-4-19 and B-4-30.  
 For details of curb angles see B-3-42a.  
 For expansion joint detail of 6" wall above wharf floor see B-4-47.  
 Chamfer for pile caps and beams supporting R.R. track is 2"x2"; for regular floor beams 1 1/2"x1 1/2"

Revised-Jan. 9, 1926.

ALABAMA STATE DOCKS COMMISSION MOBILE, ALABAMA.	
CONCRETE WHARF INSHORE ENDS-NORTH & SOUTH CORNERS -NEAT LINES OF CONCRETE-	
SCALE: 1/8" = 1'-0"	DRAWN BY: E.W.G.
DATE: Oct. 15, 1925	TRACED BY:
RECOMMENDED BY:	CHECKED BY:
Arthur C. Davis ENGINEER	
<b>B-4-25</b>	

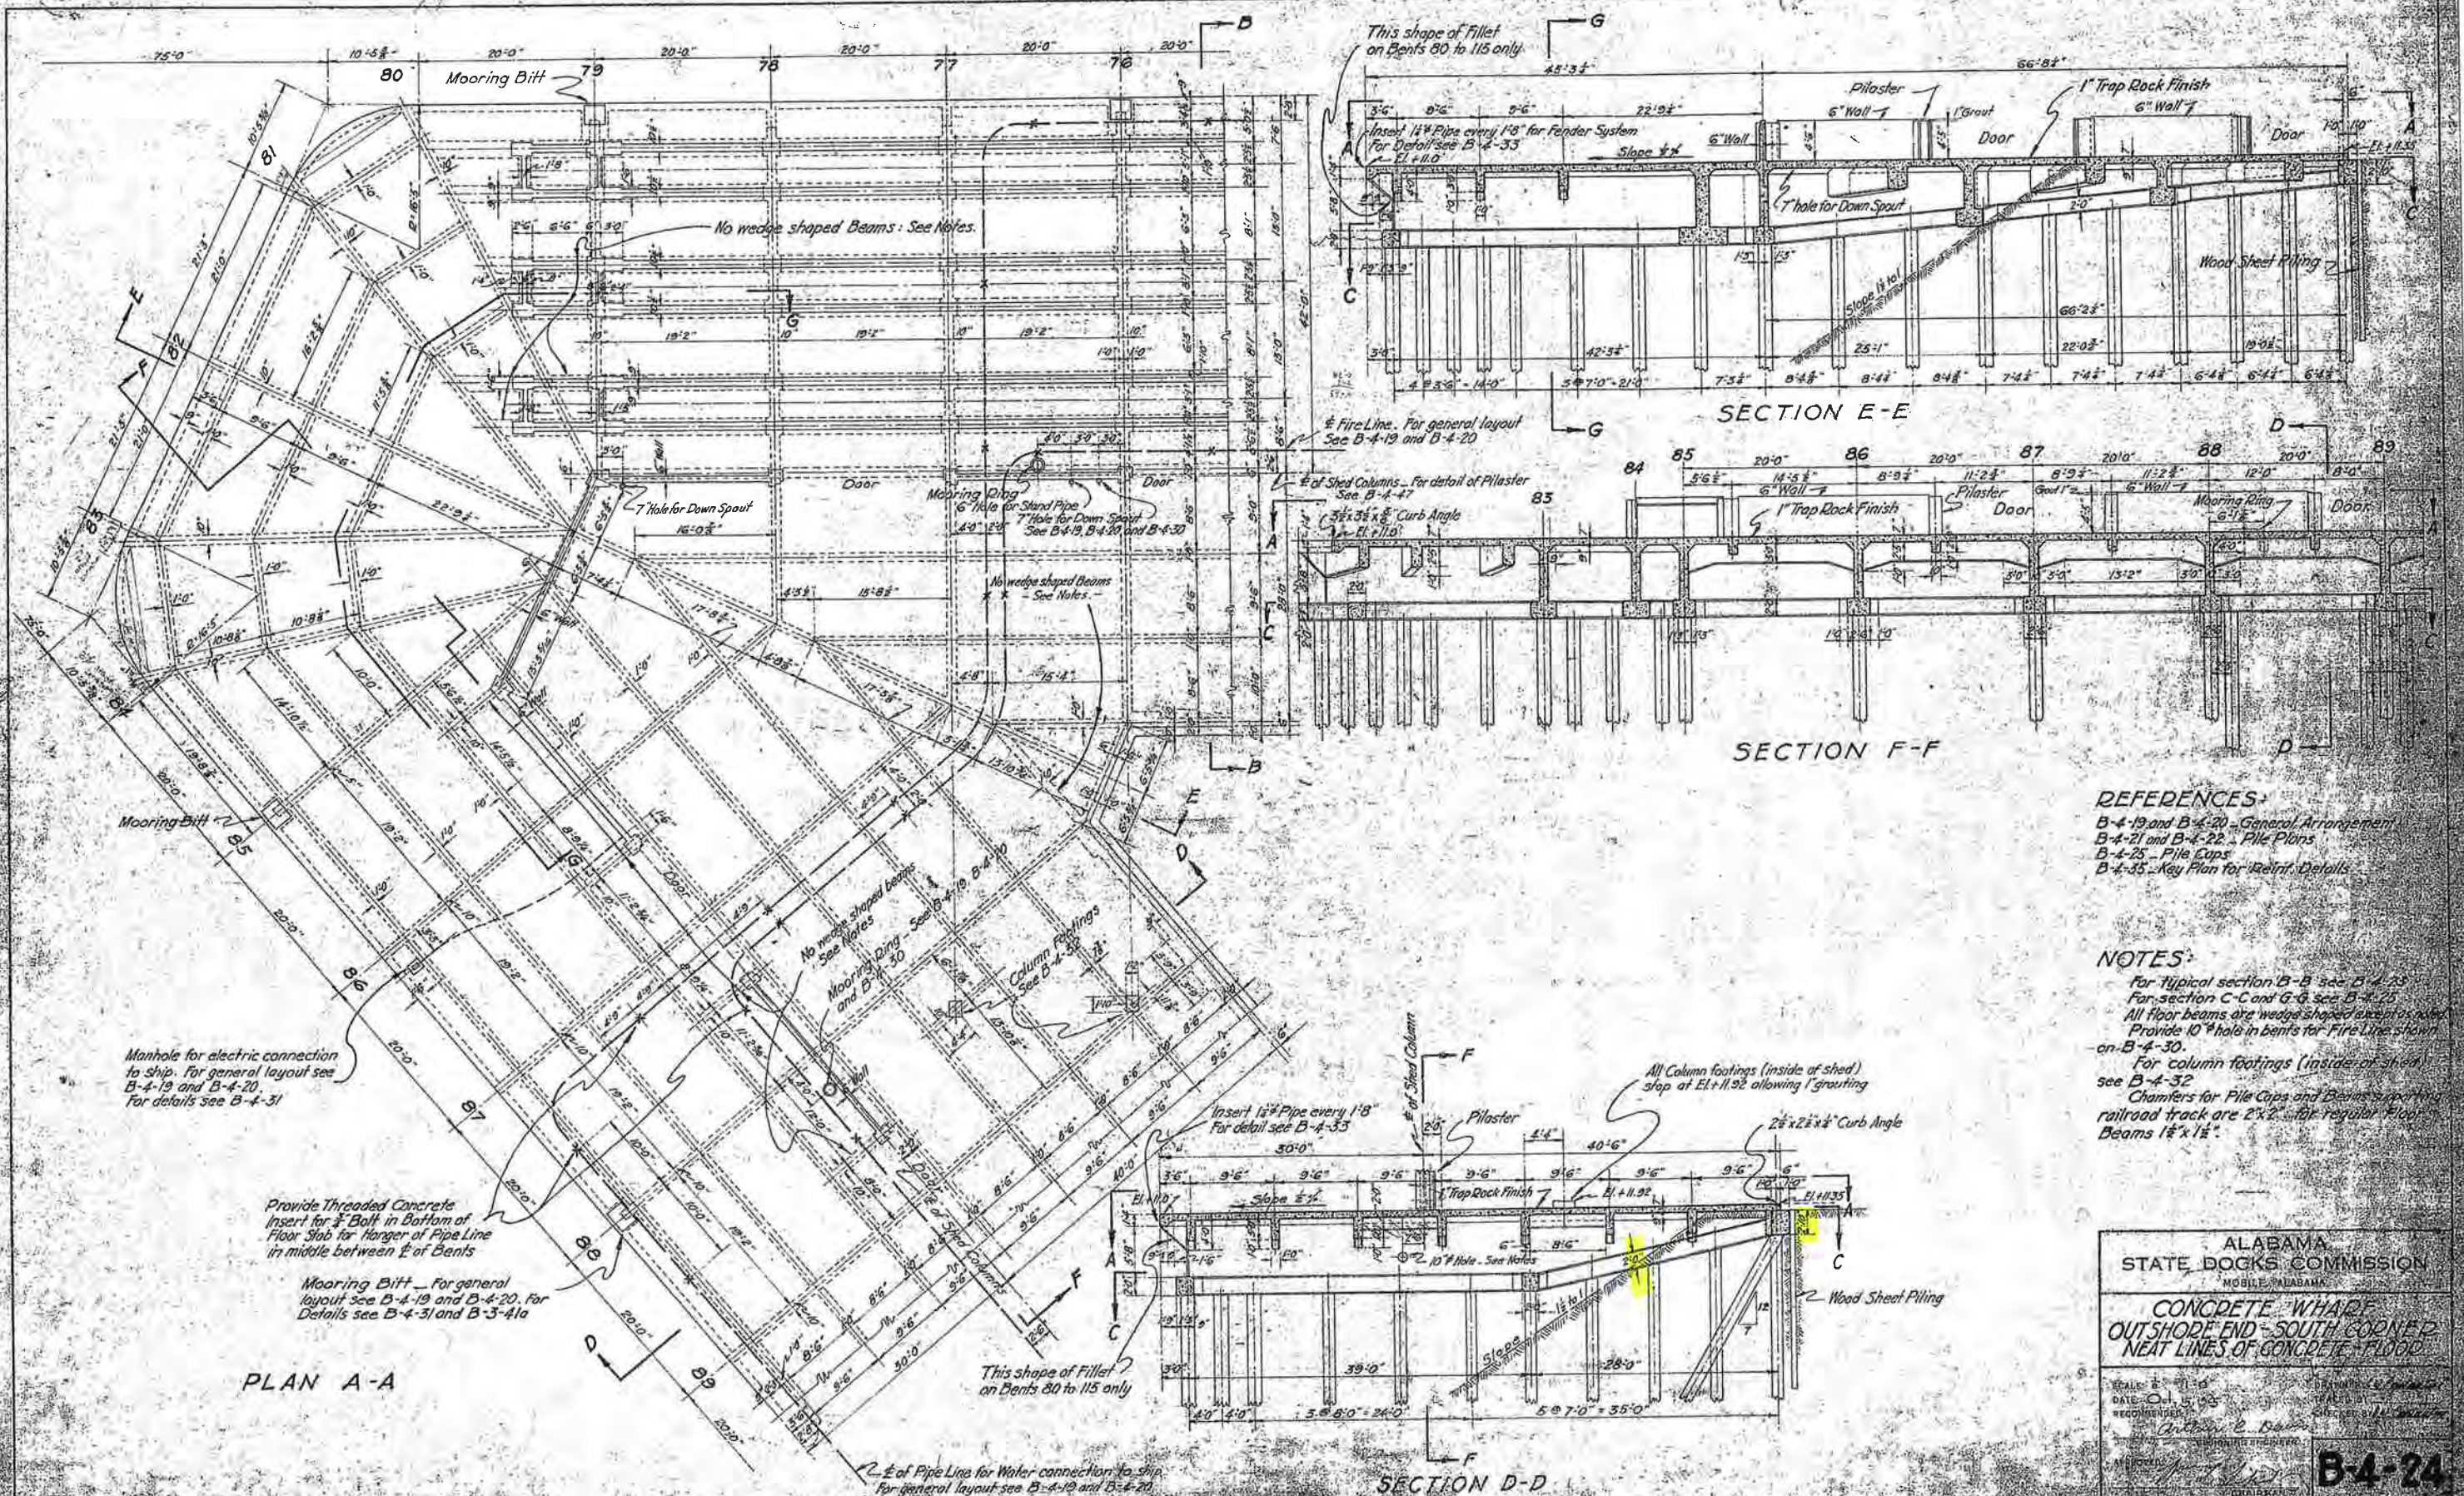

PLAN A-A

SECTION E-E

SECTION F-F

SECTION D-D

- REFERENCES:**
- B-4-19 and B-4-20 - General Arrangement
  - B-4-21 and B-4-22 - Pile Plans
  - B-4-25 - Pile Caps
  - B-4-35 - Key Plan for Reinf. Details

- NOTES:**
- For typical section B-B see B-4-23
  - For section C-C and G-G see B-4-25
  - All floor beams are wedge shaped except as noted
  - Provide 10" hole in bents for Fire Line shown on B-4-30
  - For column footings (inside of shed) see B-4-32
  - Chamfers for Pile Caps and Beams supporting railroad track are 2"x2" for regular Floor Beams 1 1/2"x1 1/2"

ALABAMA  
STATE DOCKS COMMISSION  
MOBILE, ALABAMA

**CONCRETE WHARF  
OUTSHORE END - SOUTH CORNER  
NEAT LINES OF CONCRETE FLOOR**

SCALE: 1/4" = 1'-0"  
DATE: OCT 15 1925  
REVISIONS:  
DESIGNED BY: Arthur E. Bauer  
CHECKED BY: J. H. ...

**B-4-24**

Manhole for electric connection to ship. For general layout see B-4-19 and B-4-20. For details see B-4-31

Provide Threaded Concrete. Insert for 3/4" Bolt in Bottom of Floor Slab for Hanger of Pipe Line in middle between E of Bents

Mooring Bitt - For general layout see B-4-19 and B-4-20. For details see B-4-31 and B-3-41a

E of Pipe Line for Water connection to ship. For general layout see B-4-19 and B-4-20

This shape of Fillet on Bents 80 to 115 only

No wedge shaped Beams - See Notes

Mooring Bitt - For detail see B-4-19, B-4-20 and B-4-30

No wedge shaped Beams: See Notes

This shape of Fillet on Bents 80 to 115 only

Insert 1/2" Pipe every 1'8" for Fender System. For detail see B-4-33 - El. +11.0

Fire Line. For general layout see B-4-19 and B-4-20


E of Shed Columns - For detail of Pilaster see B-4-47

3/4" x 3/4" x 8" Curb Angle - El. +11.0


All Column footings (inside of shed) stop at El. +11.92 allowing 1" grouting

Insert 1/2" Pipe every 1'8" For detail see B-4-33

This shape of Fillet on Bents 80 to 115 only

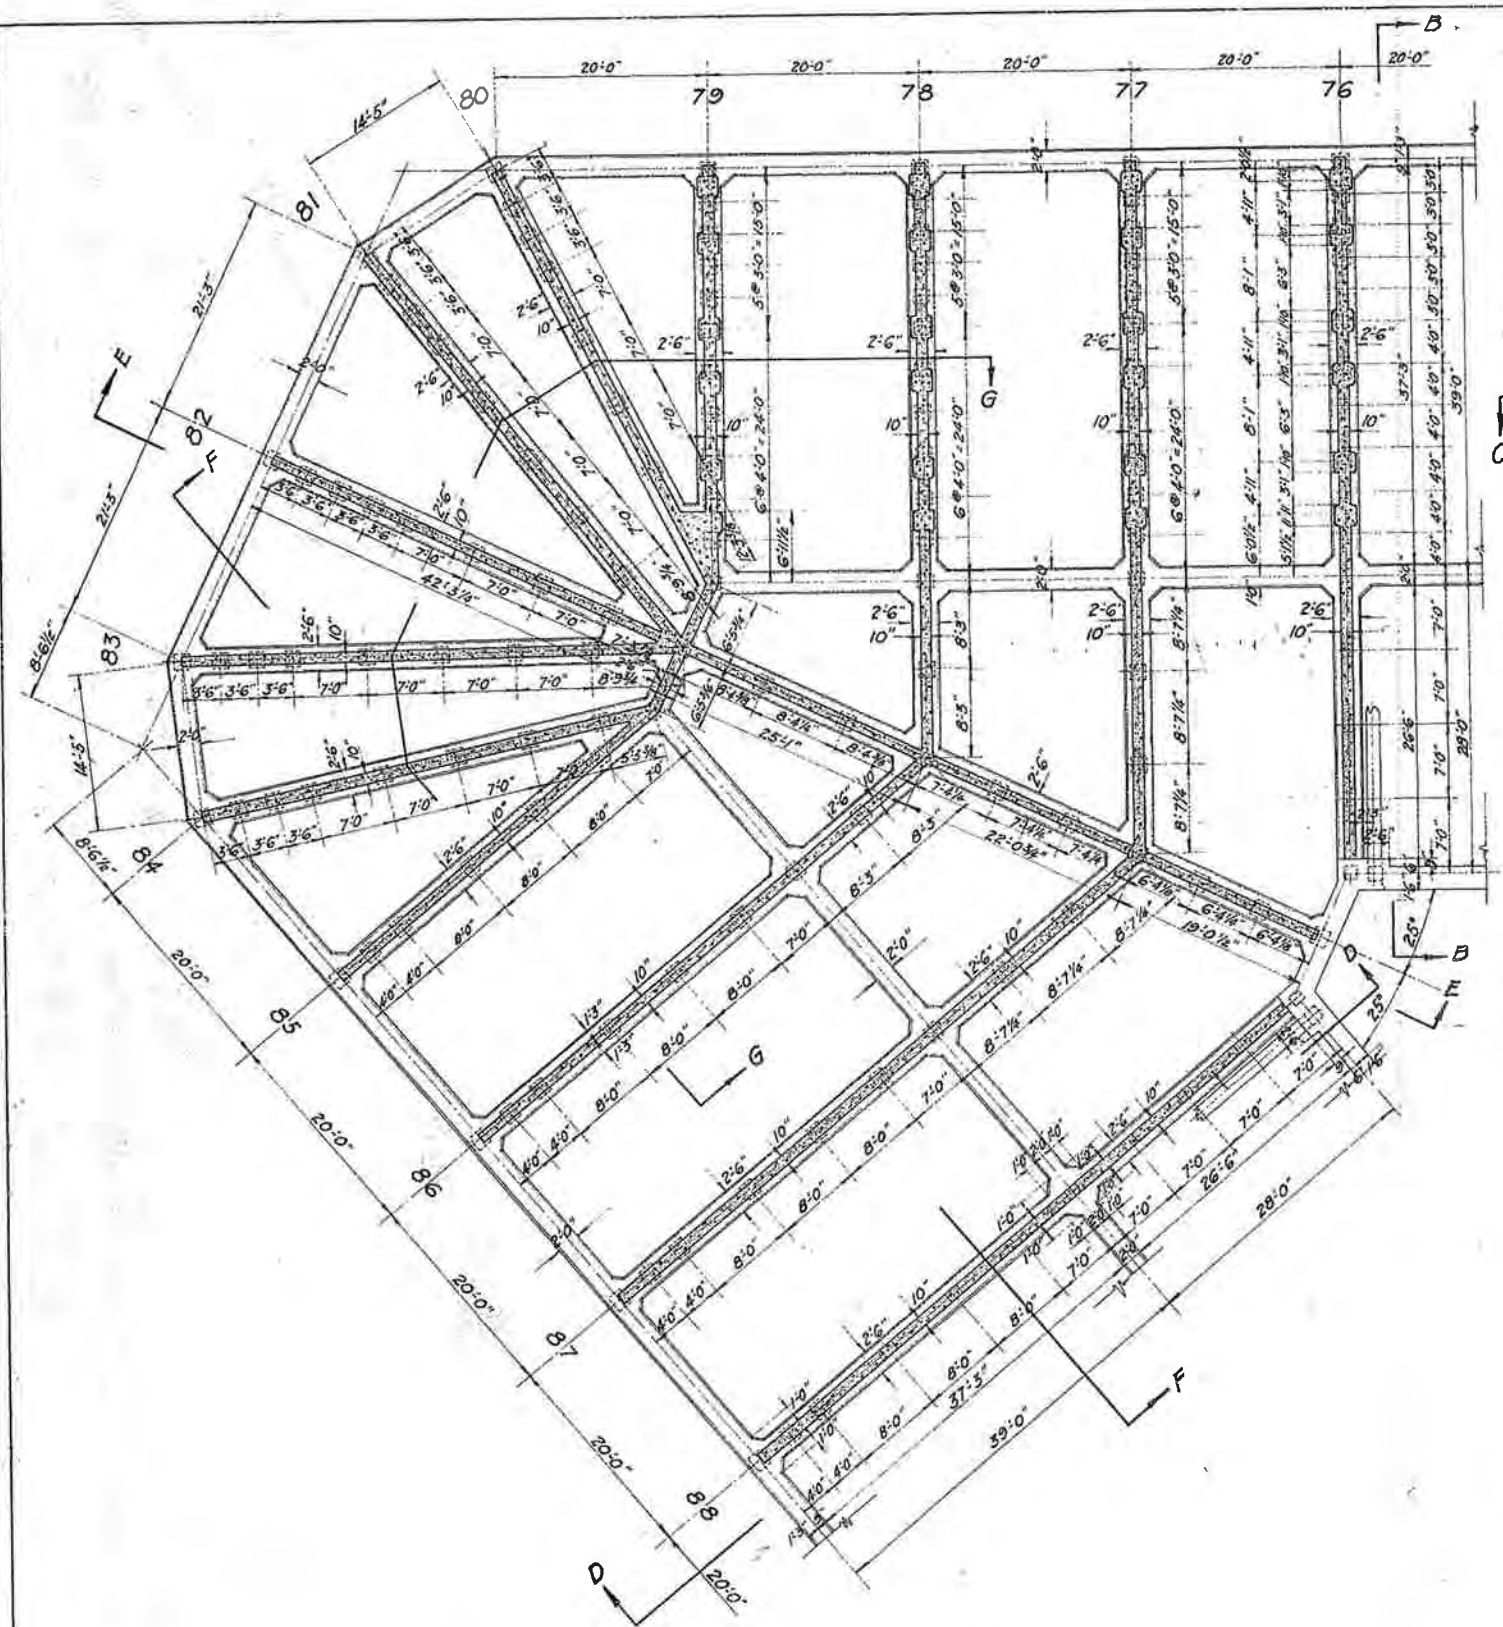

SECTIONAL PLAN C-C

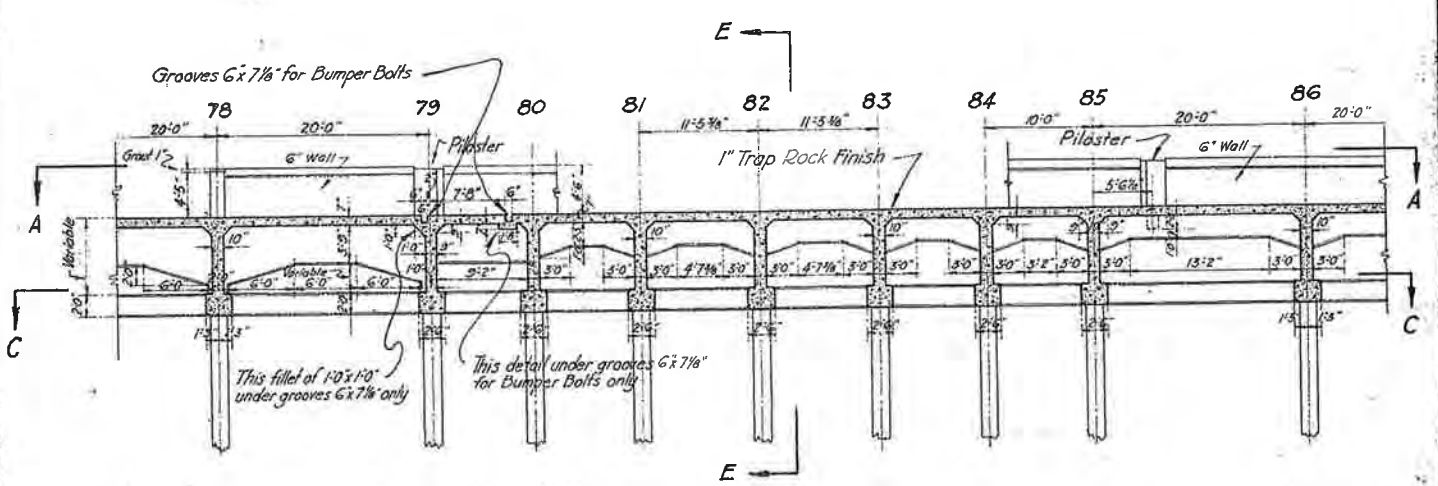

SECTION G-G


**REFERENCES:**  
 B-4-19 and B-4-20 - General Arrangement  
 B-4-21 and B-4-22 - Pile Plans  
 B-4-35 - Key Plan for Reint. details

**NOTES:**  
 For typical section B-B see B-4-23  
 For sections A-A, D-D, E-E and F-F see B-4-24  
 Chamfer for Pile Caps and Beams supporting Railroad track are 2x2"; For regular floor beams 1 1/2 x 1 1/2"

ALABAMA STATE DOCKS COMMISSION MOBILE, ALABAMA.	
<b>CONCRETE WHARF OUTSHORE END - SOUTH CORNER NEAT LINES OF CONCRETE PILE CAPS</b>	
SCALE: 1" = 1'-0"	DRAWN BY: L.W.C.
DATE: Oct. 15, 1925	TRACED BY:
RECOMMENDED:	CHECKED BY: J. B. ...
DESIGNED BY: J. B. ...	
APPROVED: [Signature]	CHAIRMAN

**B-4-25**

PLAN A-A

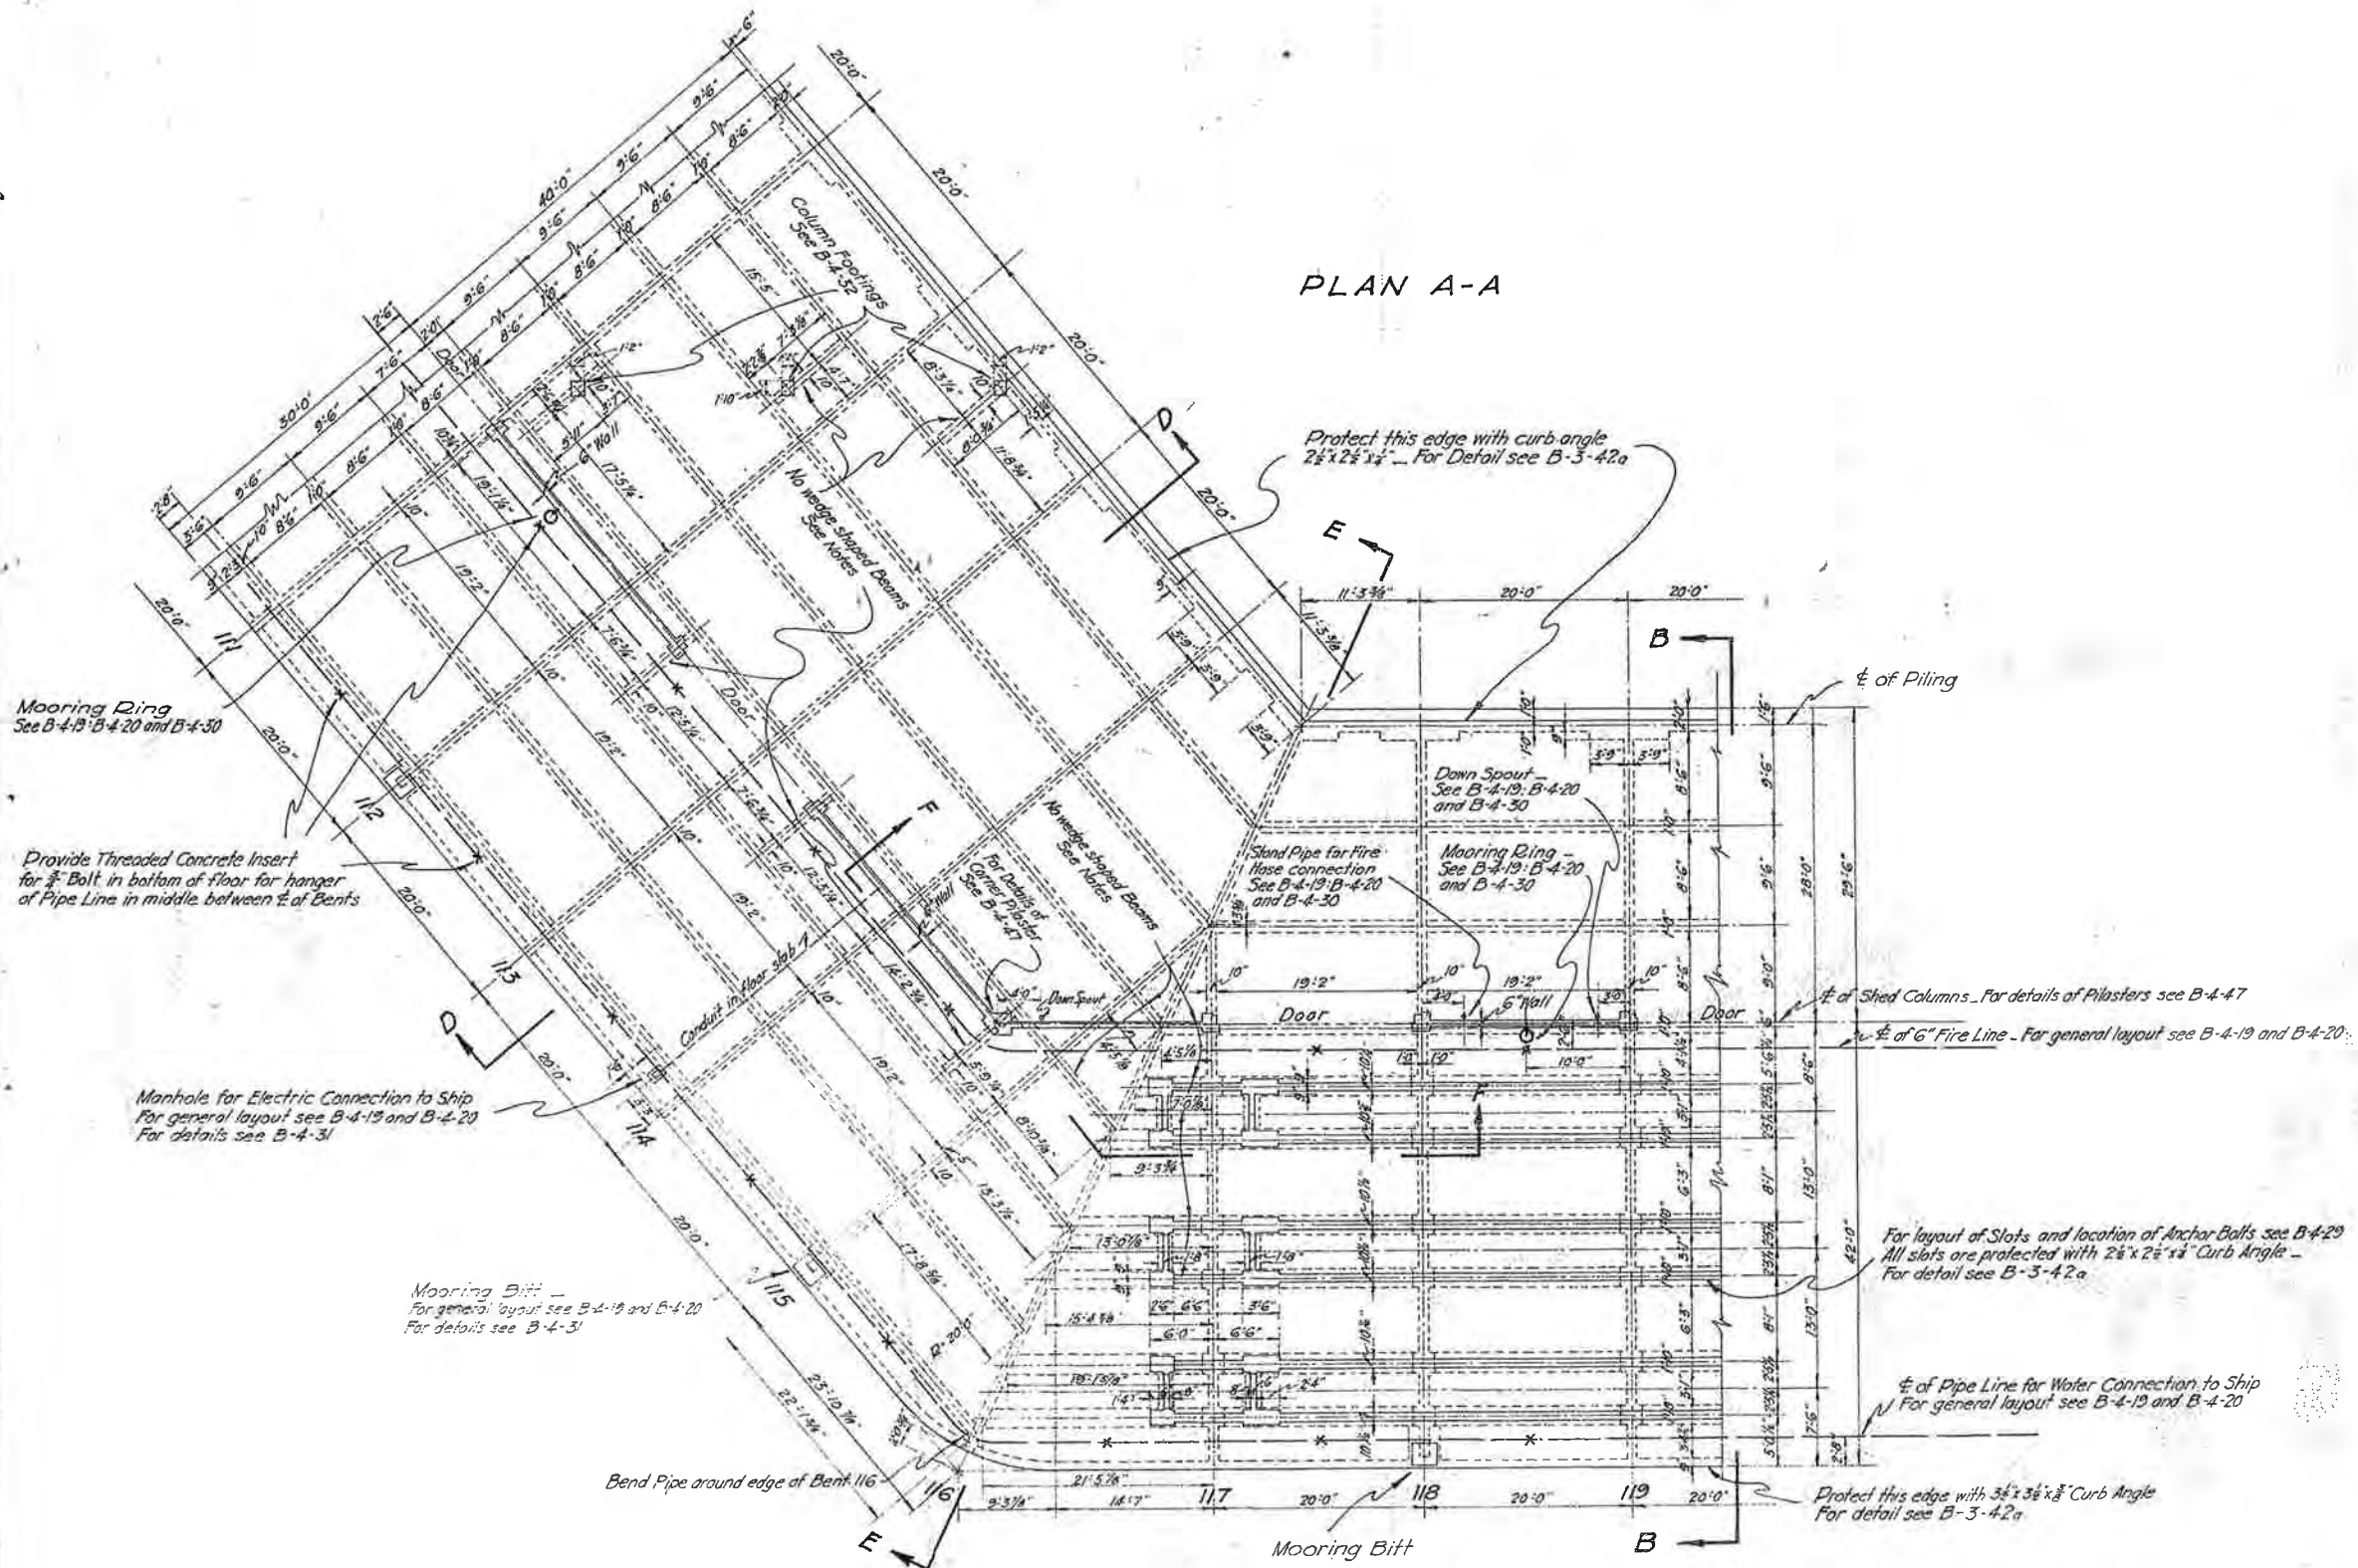


**REFERENCES:**  
 B-4-19 and B-4-20 General Arrangement  
 B-4-21 and B-4-22 Pile Plans  
 B-4-35 Key Plan for Reinf. Details

**NOTES:**  
 For Typical Section B-B See B-4-23  
 For Section D-D " B-4-24  
 " E-E and F-F " B-4-27  
 " C-C showing Pile Cap see B-4-27  
 All Floor Beams are wedge shaped except as noted  
 Chamfer for Pile Caps and Beams supporting  
 Railroad track are 2"x2"; For regular Floor  
 Beams 1 1/2"x1 1/2"


ALABAMA STATE DOCKS COMMISSION MOBILE, ALABAMA	
<b>CONCRETE WHARF OUTSHORE END-NORTH CORNER NEAT LINES OF CONCRETE-FLOOR -DECK PLAN A-A-</b>	
SCALE: 1/4" = 1'-0"	DRAWN BY: E.W.C.
DATE: Oct. 13, 1925	TRACED BY: [Signature]
RECOMMENDED: Arthur E. Bous DESIGNING ENGINEER	CHECKED BY: [Signature]
APPROVED: [Signature] CHAIRMAN	B-4-26






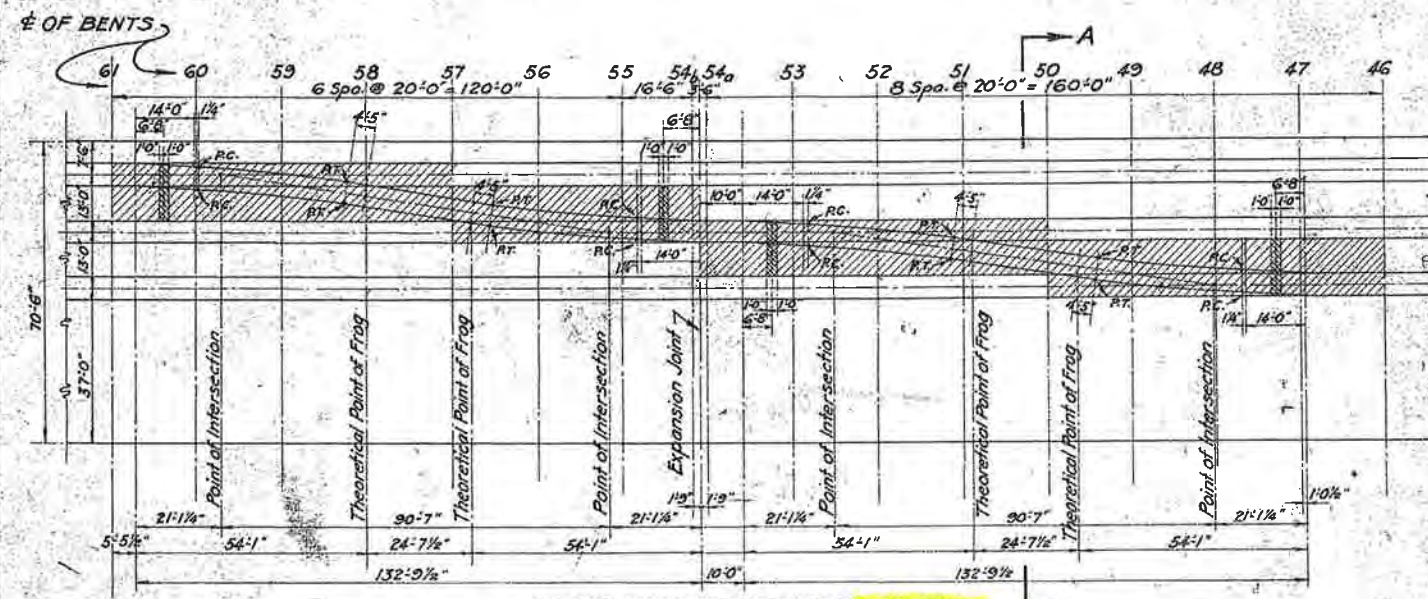


CROSS-OVER BETWEEN BENTS 46 AND 61  
ON SOUTH SIDE OF WHARF

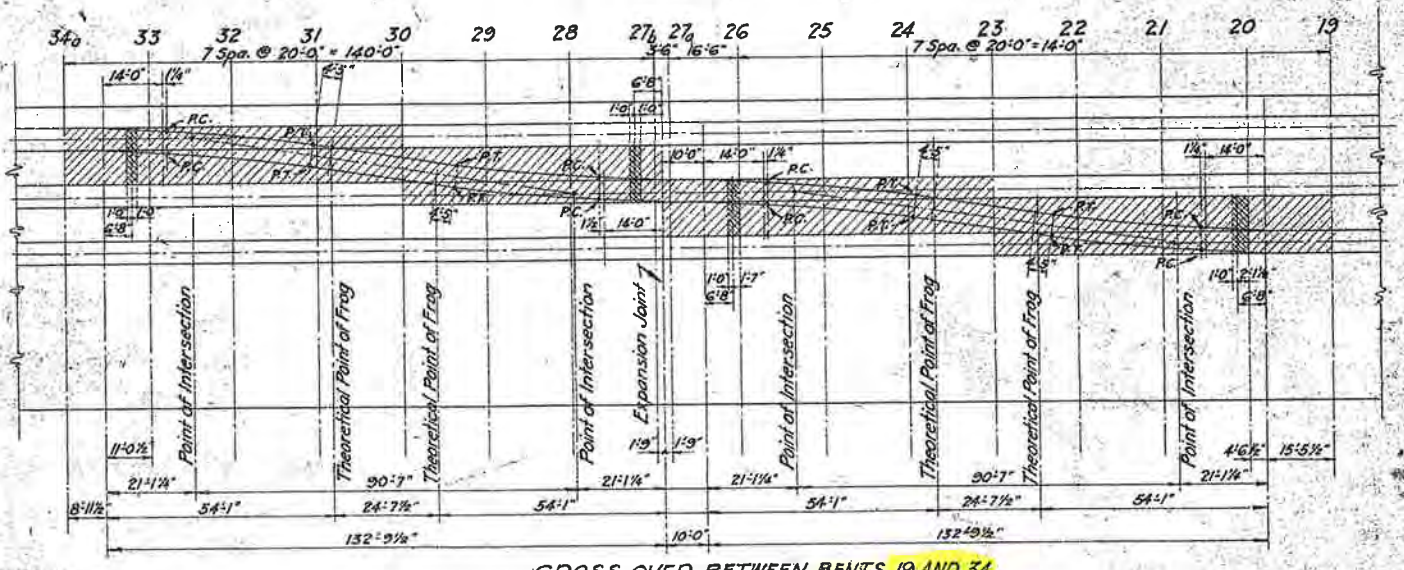

CROSS-OVER BETWEEN BENTS 19 AND 34,  
ON SOUTH SIDE OF WHARF

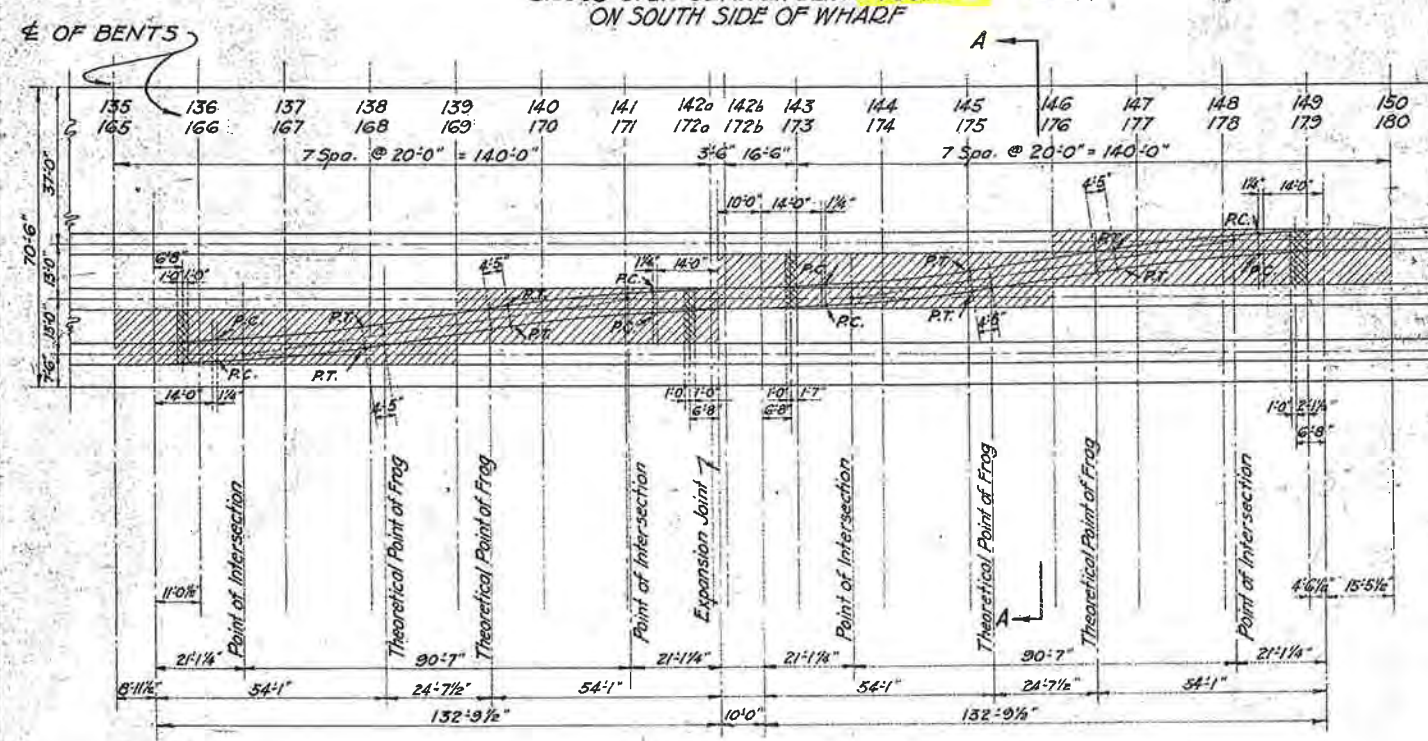

CROSS-OVERS BETWEEN BENTS 135-150 AND 165-180  
ON NORTH SIDE OF WHARF

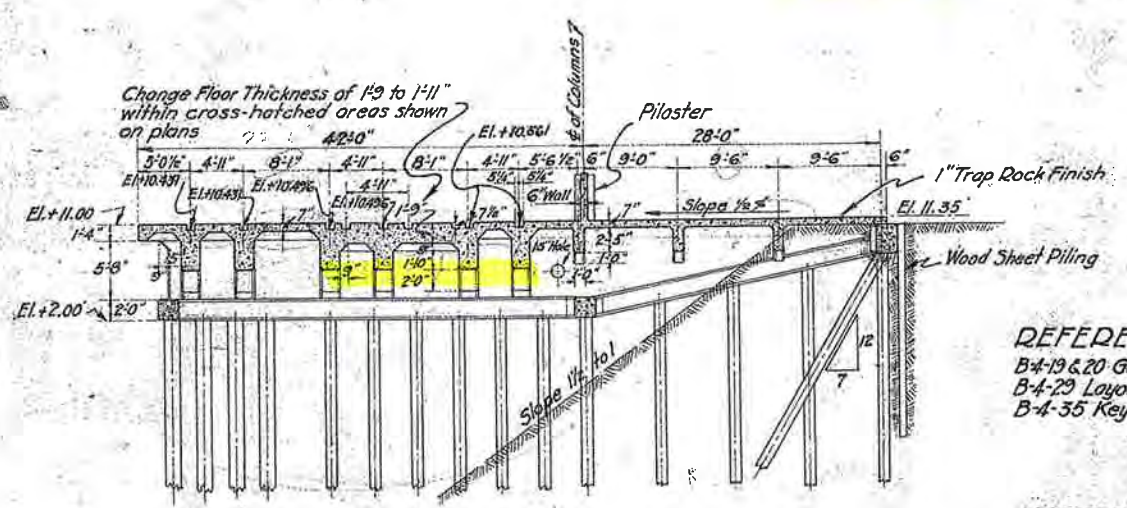

SECTION A-A  
Showing special floor under Cross-Overs  
For further Details of Bents see typical section B-B  
on B-4-23

- REFERENCES:
- B-4-19 & 20 General Arrangement of Wharf
  - B-4-29 Layout of Slots for Cross-over
  - B-4-35 Key Plan for Reinf. Detail

- NOTES:
- Spacing for Anchor Bolts for Rails on Concrete Wharf are  $\pm 1'-8"$  except as shown on B-4-29
  - Hatched areas indicate Special Floor as shown in Section A-A on this drawing
  - Cross-hatched areas indicate Special Floor of 1'-11" instead of 1'-9" as shown in Section A-A on this drawing


Revised Jan. 9, 1926.

ALABAMA  
STATE DOCKS COMMISSION  
MOBILE, ALABAMA


CONCRETE WHARF  
SPECIAL FLOOR FOR CROSS-OVER  
GENERAL LAYOUT

SCALE: 1" = 10' and 1" = 10'  
DATE: Oct. 15, 1925  
RECOMMENDED:  
ARTHUR C. ROBERTS  
ENGINEER


B-4-28

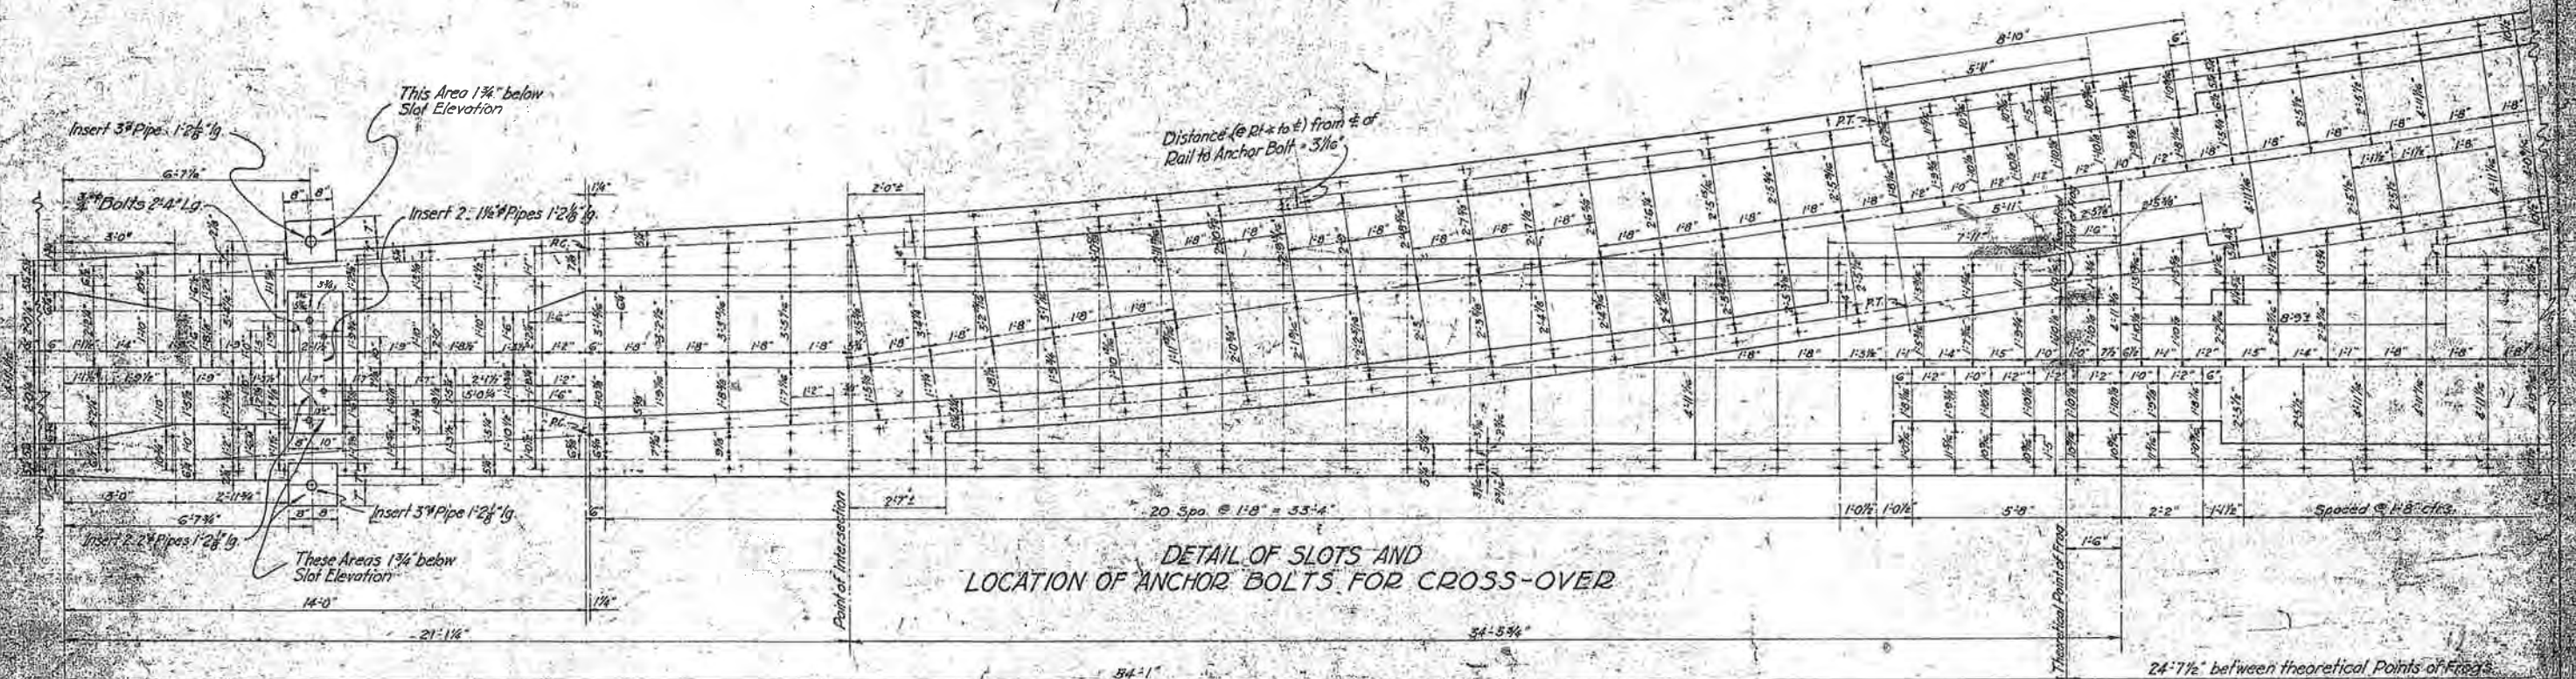

DETAIL OF SLOTS AND LOCATION OF ANCHOR BOLTS FOR CROSS-OVER

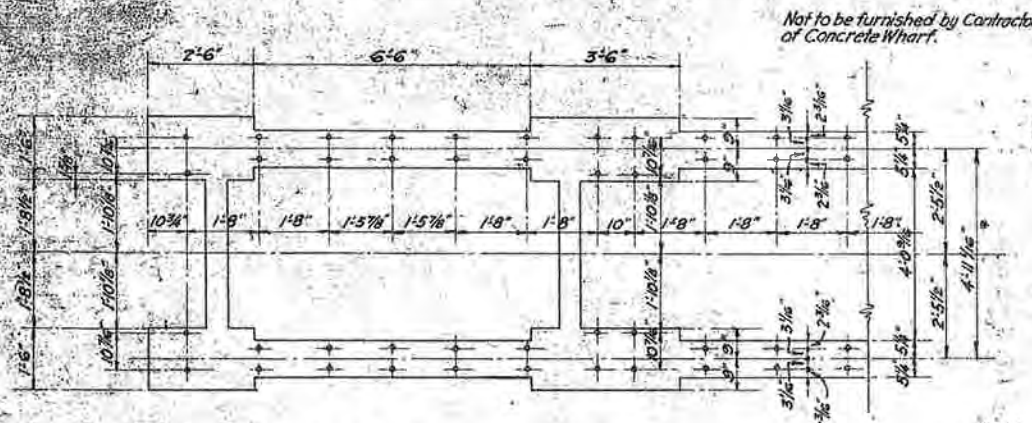

DETAIL OF SLOTS AND LOCATION OF ANCHOR BOLTS FOR BUMPING POSTS  
For Pier No. 3, see Dwg. B-5-45 and B-5-50

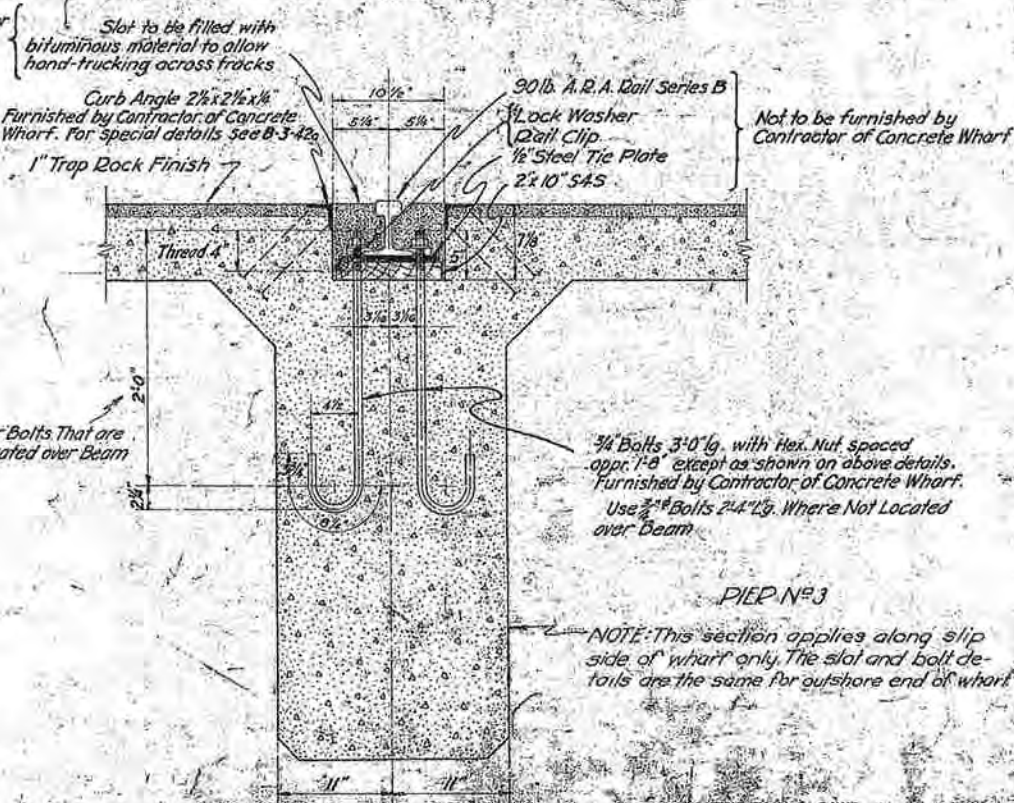


TYPICAL SECTION OF RAIL SLOT IN CONCRETE WHARF  
Scale: 1/2" = 1'-0"

**REFERENCES:**  
**PIER No. 2** { B-4-19 & 20 General Arrangement of Wharf  
 B-4-35 Key Plan for Reinf. Details  
**PIER No. 1** { B-4-187 & 188 - General Arr. of Wharf (Deck Plan)  
 B-4-190 - Key Plan for Reinf. Details  
**NOTES:** Locations of Anchor Bolts are for all turnouts alike for General Layout of Cross-overs see B-4-28  
**FOR PIER No. 2** Spacings for Anchor Bolts for Rails on Concrete Wharf are ± 1'-8" except as shown on this drawing for Elevations of Slots See Sec. A-A on B-4-28  
**FOR PIER No. 1** Same Notes as for Pier No. 2. For General Layout of Cross-overs & Elevation of Slots See Drawing No. B-4-187.  
**FOR PIER No. 3** B-5-45 General Arrangement of Wharf  
 B-5-53 Key Plan for Reinforcing Details  
 B-5-56 General Layout of Cross-over  
 Same notes as for Pier No. 2.  
 This Drawing Used for Piers No. 1 and No. 2 and No. 3


Revised - Jan. 9, 1926  
 Revised - June 30, 1926  
 Revised - Dec. 6, 1926  
 Revised - June 1, 1927

ALABAMA  
 STATE DOCKS COMMISSION  
 MOBILE, ALABAMA  
**CONCRETE WHARF**  
 SLOTS FOR CROSS-OVER AND BUMPING POST  
 LOCATION OF ANCHOR BOLTS

SCALE: 1/2" = 1'-0"  
 DATE: 1927  
 DRAWN BY: [Signature]  
 CHECKED BY: [Signature]  
 APPROVED BY: [Signature]

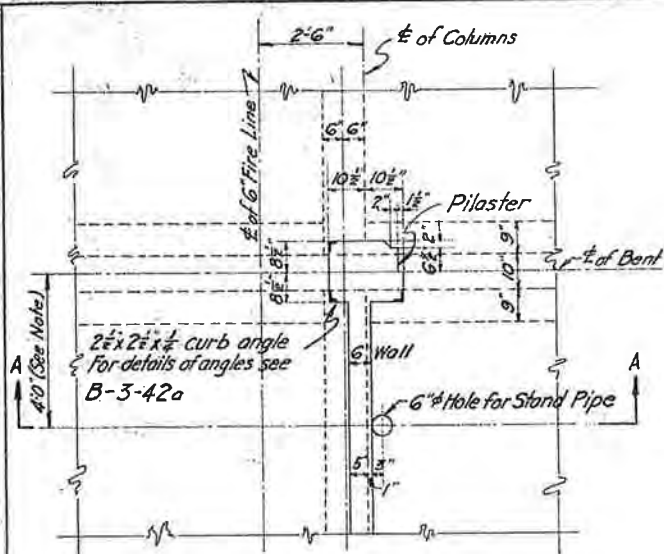

PLAN  
DETAIL SHOWING HOLES FOR STAND PIPE FOR  
FIRE HOSE CONNECTION.

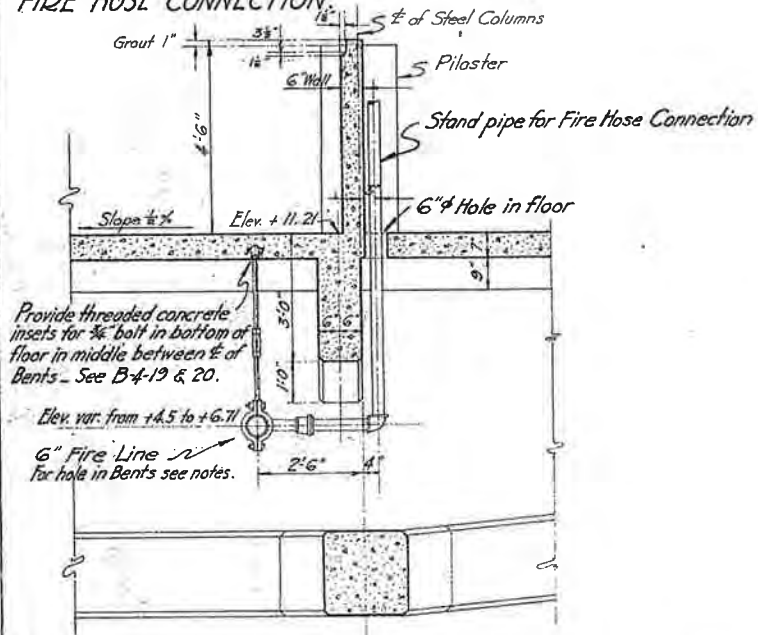


SECTION A-A

**NOTES:**


Center of 6" Fire Line varies from Elev. +4.5 to +6.71 as shown on Drawg's B-4-19 and B-4-20. Provide corresponding holes 10" in Bents. - 6" holes in floor for stand pipes of fire hose connections are 4'-0" from center of columns except as noted near Bents 17a, 27a, 34, and 107 on drawing B-4-19 and B-4-20. For detail showing Mooring Device at offshore end see B-4-32

**REFERENCES:**


See B-4-19 and B-4-20 for general arrangement of wharf. See B-4-35 for key plan of reinforcing details.

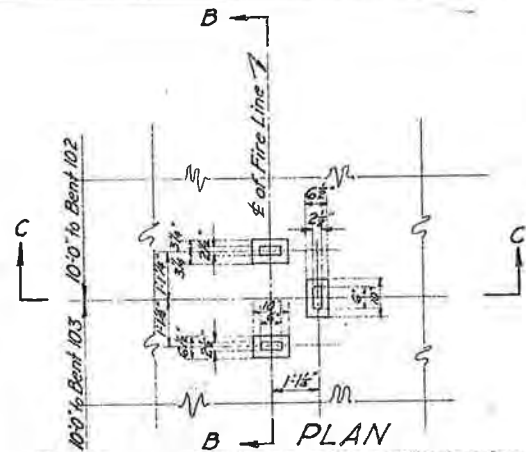


PLAN  
Details of holes allowing operation of 6" Gate Valves of Fire Line on offshore end of wharf between Bents Nos 102 and 103. See B-4-19 and B-4-20

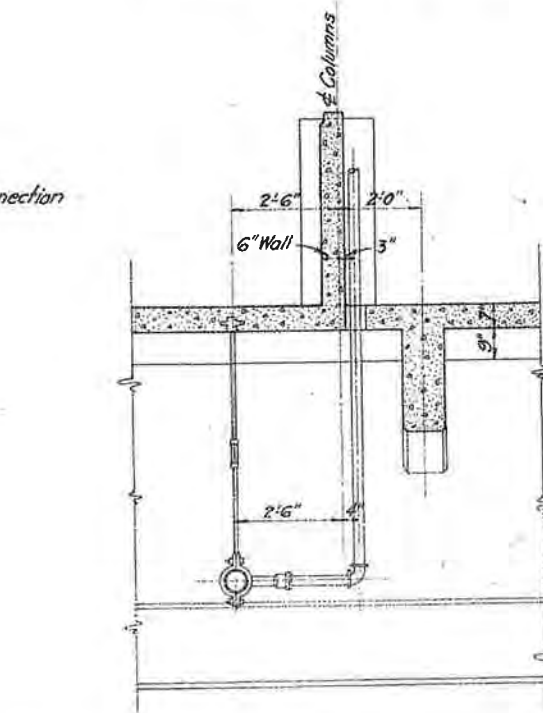


Corresponding SECTION A-A  
for offshore end of wharf

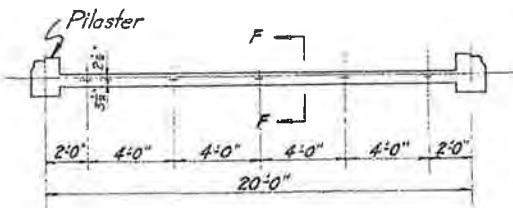


Location and Details of Bolts for Nailing Strip on Top of 6" wall

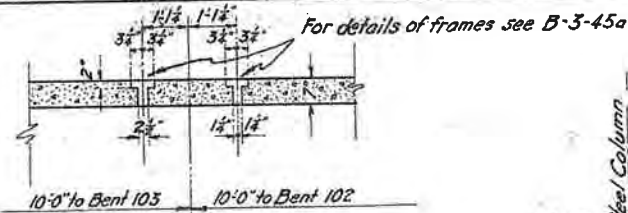


SECTION B-B

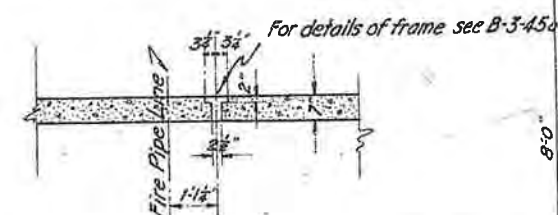


SECTION C-C

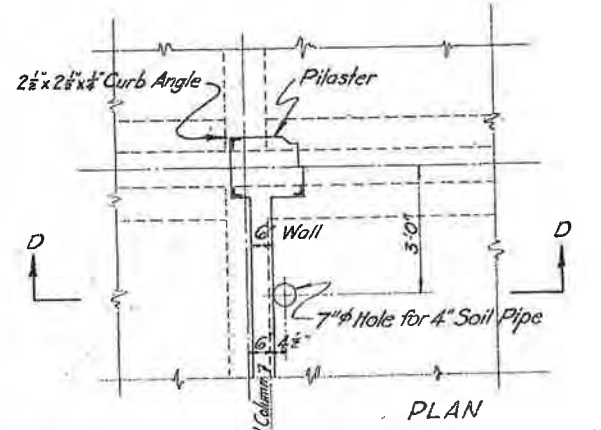


PLAN  
DETAIL SHOWING HOLE FOR  
DOWN SPOUT

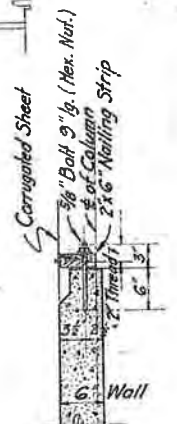

SECTION F-F

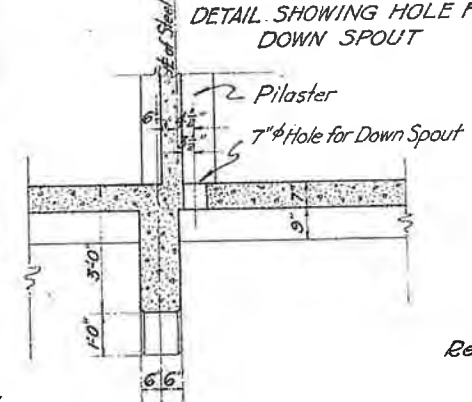


SECTION D-D

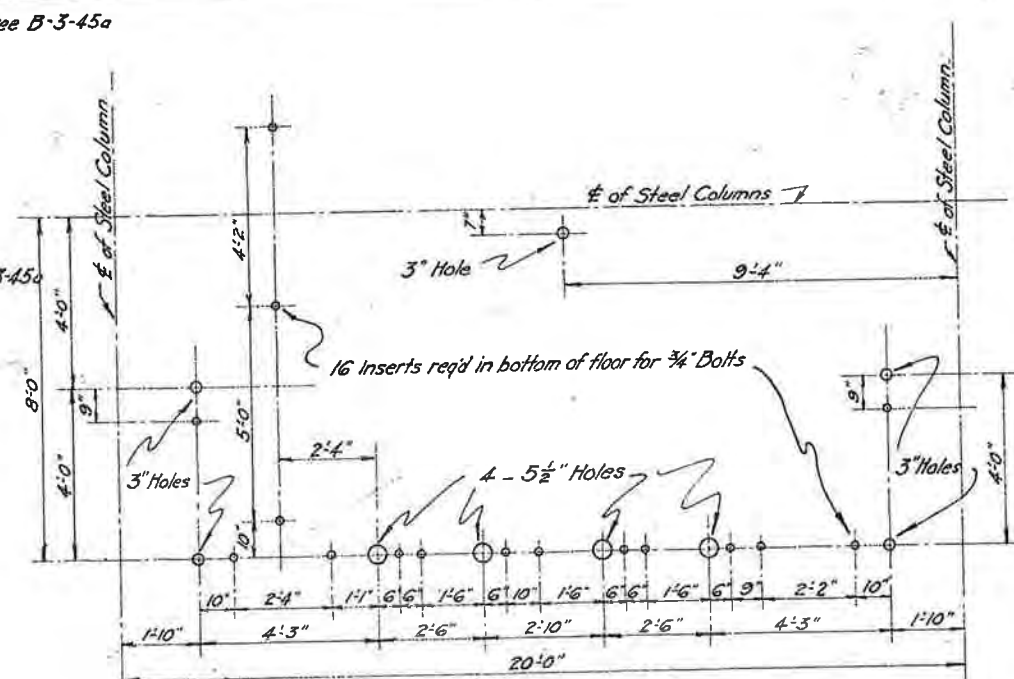

PLAN

Diagram showing location of holes for pipes and inserts for hangers for toilets. For general location of toilets see B-4-19 and B-4-20.

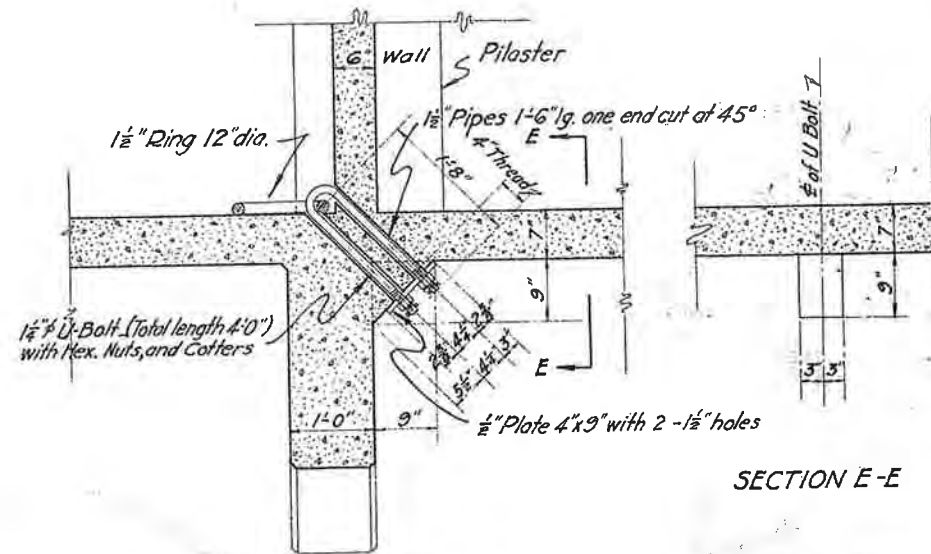


SECTION E-E

DETAILS SHOWING MOORING DEVICE NEAR SHEDS (See Notes)  
For general Location see B-4-19 and B-4-20

Revised - Jan. 9, 1926

THIS DRAWING SHOWS:  
FIRE HOSE CONNECTION - Details for holes in floor.  
FIRE LINE - Details for holes in floor for operation of 6" Gate Valves.  
TOILET - Diagram showing location of holes for pipes and inserts for hangers.  
DOWN SPOUT - Detail showing hole for 4" soil pipe.  
MOORING DEVICE NEAR SHEDS - General details  
Bolts for Nailing Strip, on top of 6" wall.

ALABAMA STATE DOCKS COMMISSION MOBILE, ALABAMA	
<b>CONCRETE WHARF GENERAL DETAILS</b>	
SCALES: 1"=1'-0" and 1/2"=1'-0" DATE: OCT. 15, 1925 ASSIGNED:	DRAWN BY: E. W. G. TRACED BY: CHECKED BY: E. W. G.
APPROVED: <i>Arthur L. Davis</i> DESIGNING ENGINEER	APPROVED: <i>W. H. Smith</i> CHAIRMAN
<b>B-4-30</b>	

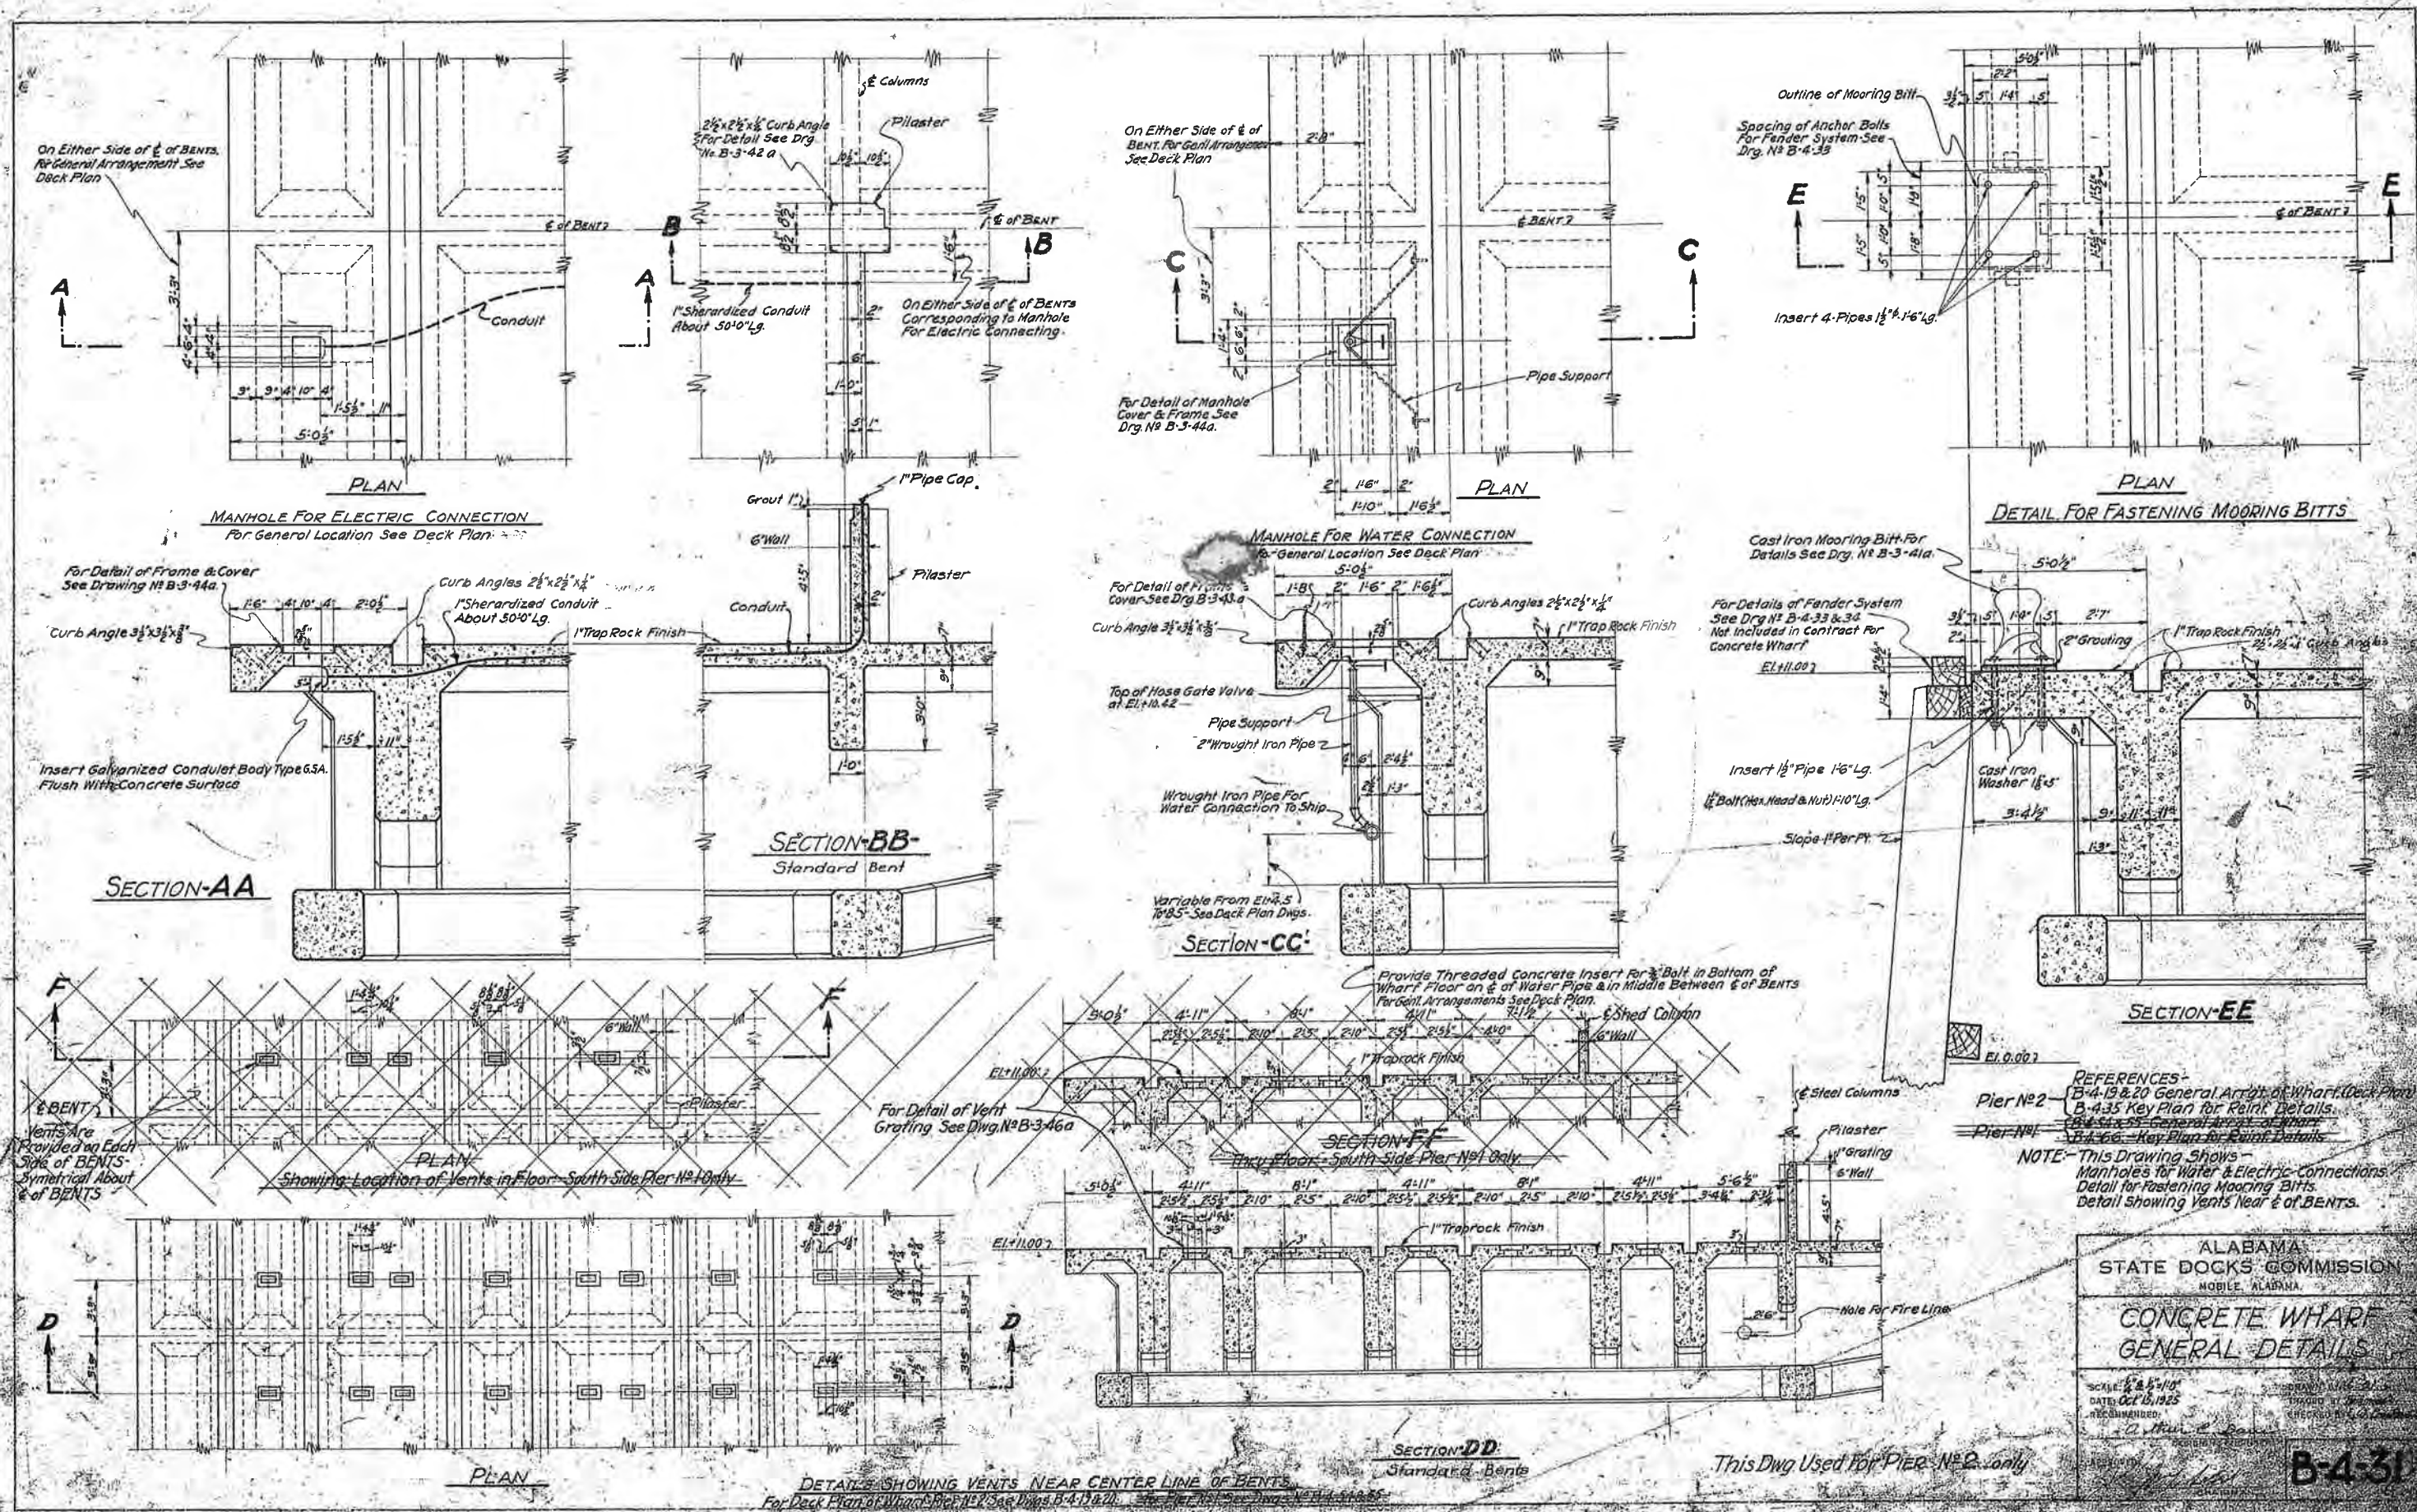

REFERENCES -  
 Pier No. 2 - B-4-19 & 20 General Arrangement of Wharf (Deck Plan)  
 B-4-35 Key Plan for Reinforcement Details  
 Pier No. 10 - B-4-55 General Arrangement of Wharf  
 B-4-66 Key Plan for Reinforcement Details

NOTE - This Drawing Shows -  
 Manholes for Water & Electric Connections  
 Detail for Fastening Mooring Bitts  
 Detail Showing Vents Near E of BENTS.


ALABAMA  
 STATE DOCKS COMMISSION  
 MOBILE, ALABAMA

**CONCRETE WHARF  
 GENERAL DETAILS**


SCALE: 1/4" = 1'-0"  
 DATE: Oct 16, 1925  
 RECOMMENDED:  
 C. W. ...  
 DRAWN BY:  
 CHECKED BY:

This Dwg Used For PIER No. 2 Only


**B-4-31**

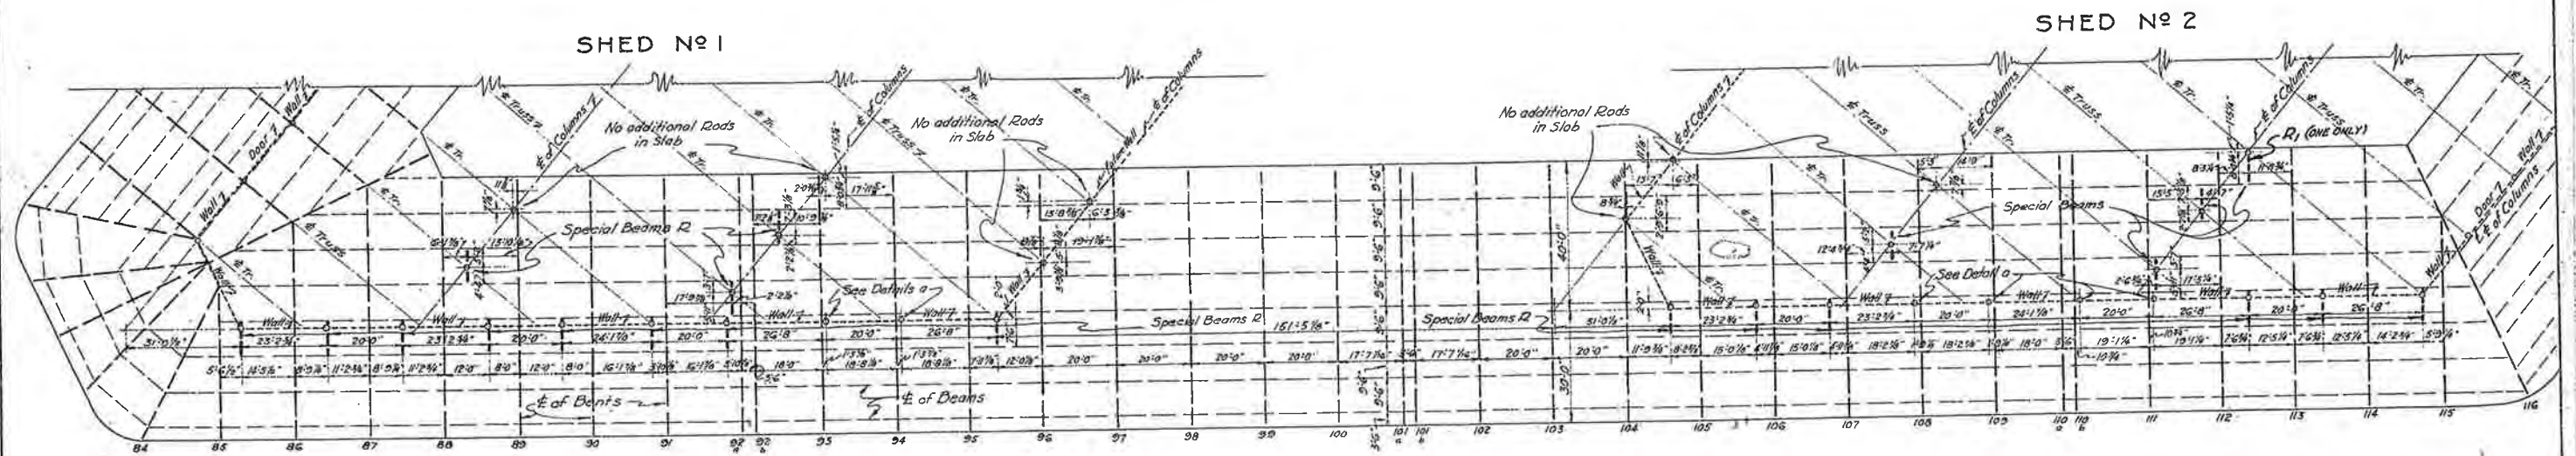


PLAN OF OUTSHORE END  
SHOWING LOCATION OF SHED COLUMN CENTERS AND BEAMS R AND R1  
Scale: 1" = 20'

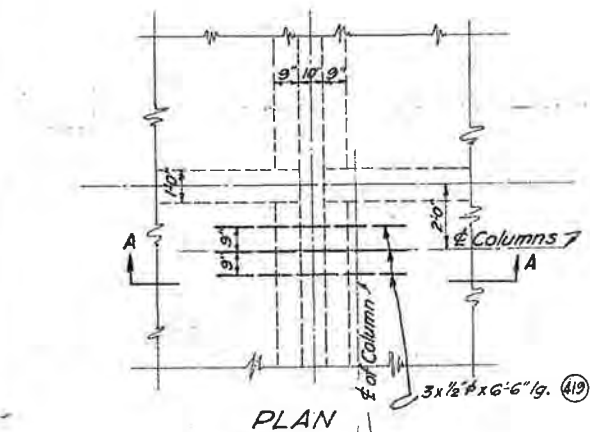


DETAILS a  
Scale 3/8" = 1'-0"  
Near Bents 93, 94, 108,  
109, 110b and 111 only

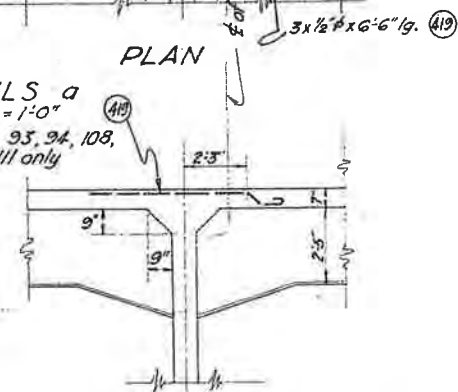

SECTION A-A


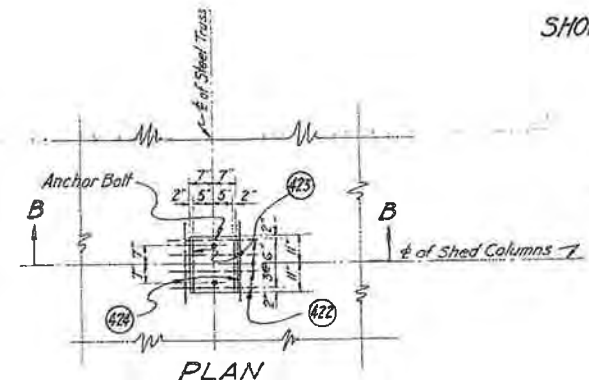


PLAN

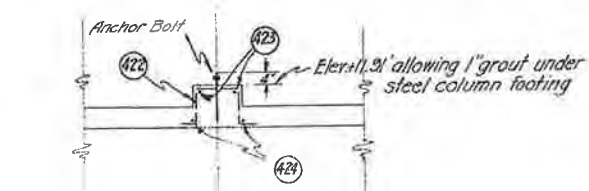

SECTION B-B

DETAILS OF INTERIOR COLUMN FOOTINGS  
(10 Column Footings on wharf for both sheds)

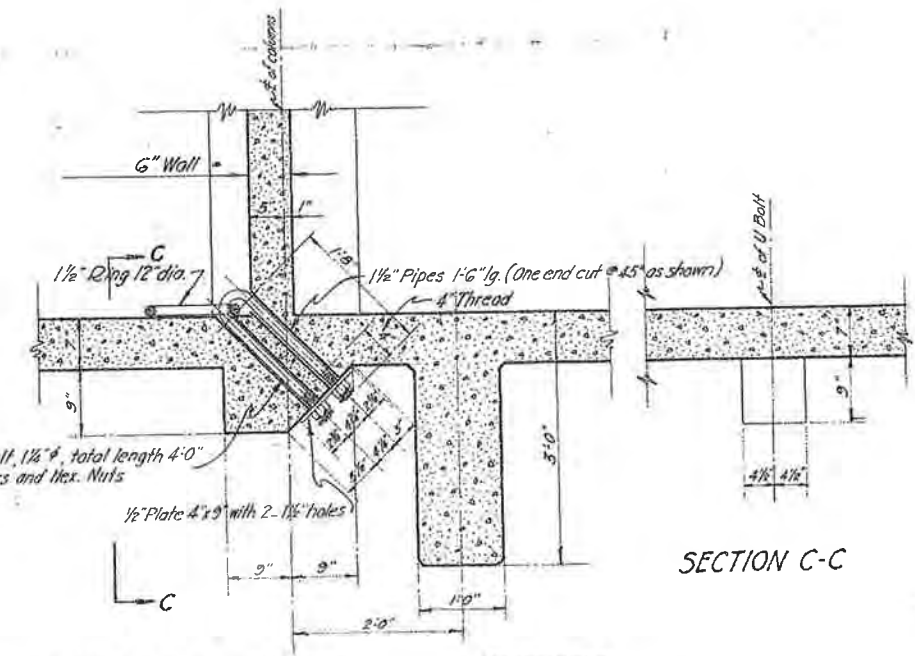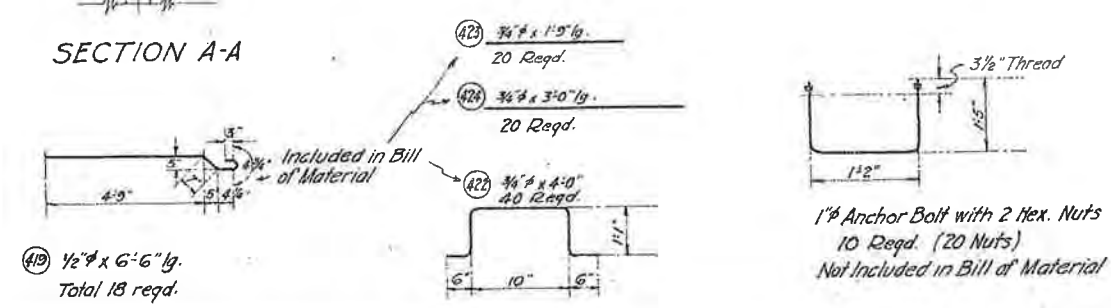

DETAIL SHOWING MOORING DEVICE AT OUTSHORE ENDS ONLY - SEE NOTES  
Scale: 1" = 1'-0"

REFERENCES:  
B-4-19 and 20 General Arrangement of Wharf  
B-4-21 and 22 Pile Plans  
B-4-35 Key Plan for Reinf. Details

NOTES:  
Total number of Beams R = 20  
R1 = 1  
For Reinf. of 6" Wall 4'-6" high (above floor)  
and Pilasters supporting Future Shed Columns  
see B-4-47.  
For detail showing Mooring Device near sheds  
at Pier Sides see B-4-30 and B-4-19 and 20.

ALABAMA  
STATE DOCKS COMMISSION  
MOBILE, ALABAMA.

CONCRETE WHARF  
DETAIL OF OUTSHORE END

SCALE: AS SHOWN  
DATE: Oct. 15, 1925  
RECOMMENDED BY:  
Arthur C. Davis  
CHAIRMAN


DRAWN BY: E.W.C.  
TRACED BY:  
CHECKED BY: J.L. [unclear]

B-4-32



SOUTH CORNER  
PIER NO 2 ONLY

SOUTH CORNER  
PIER NO 1 ONLY

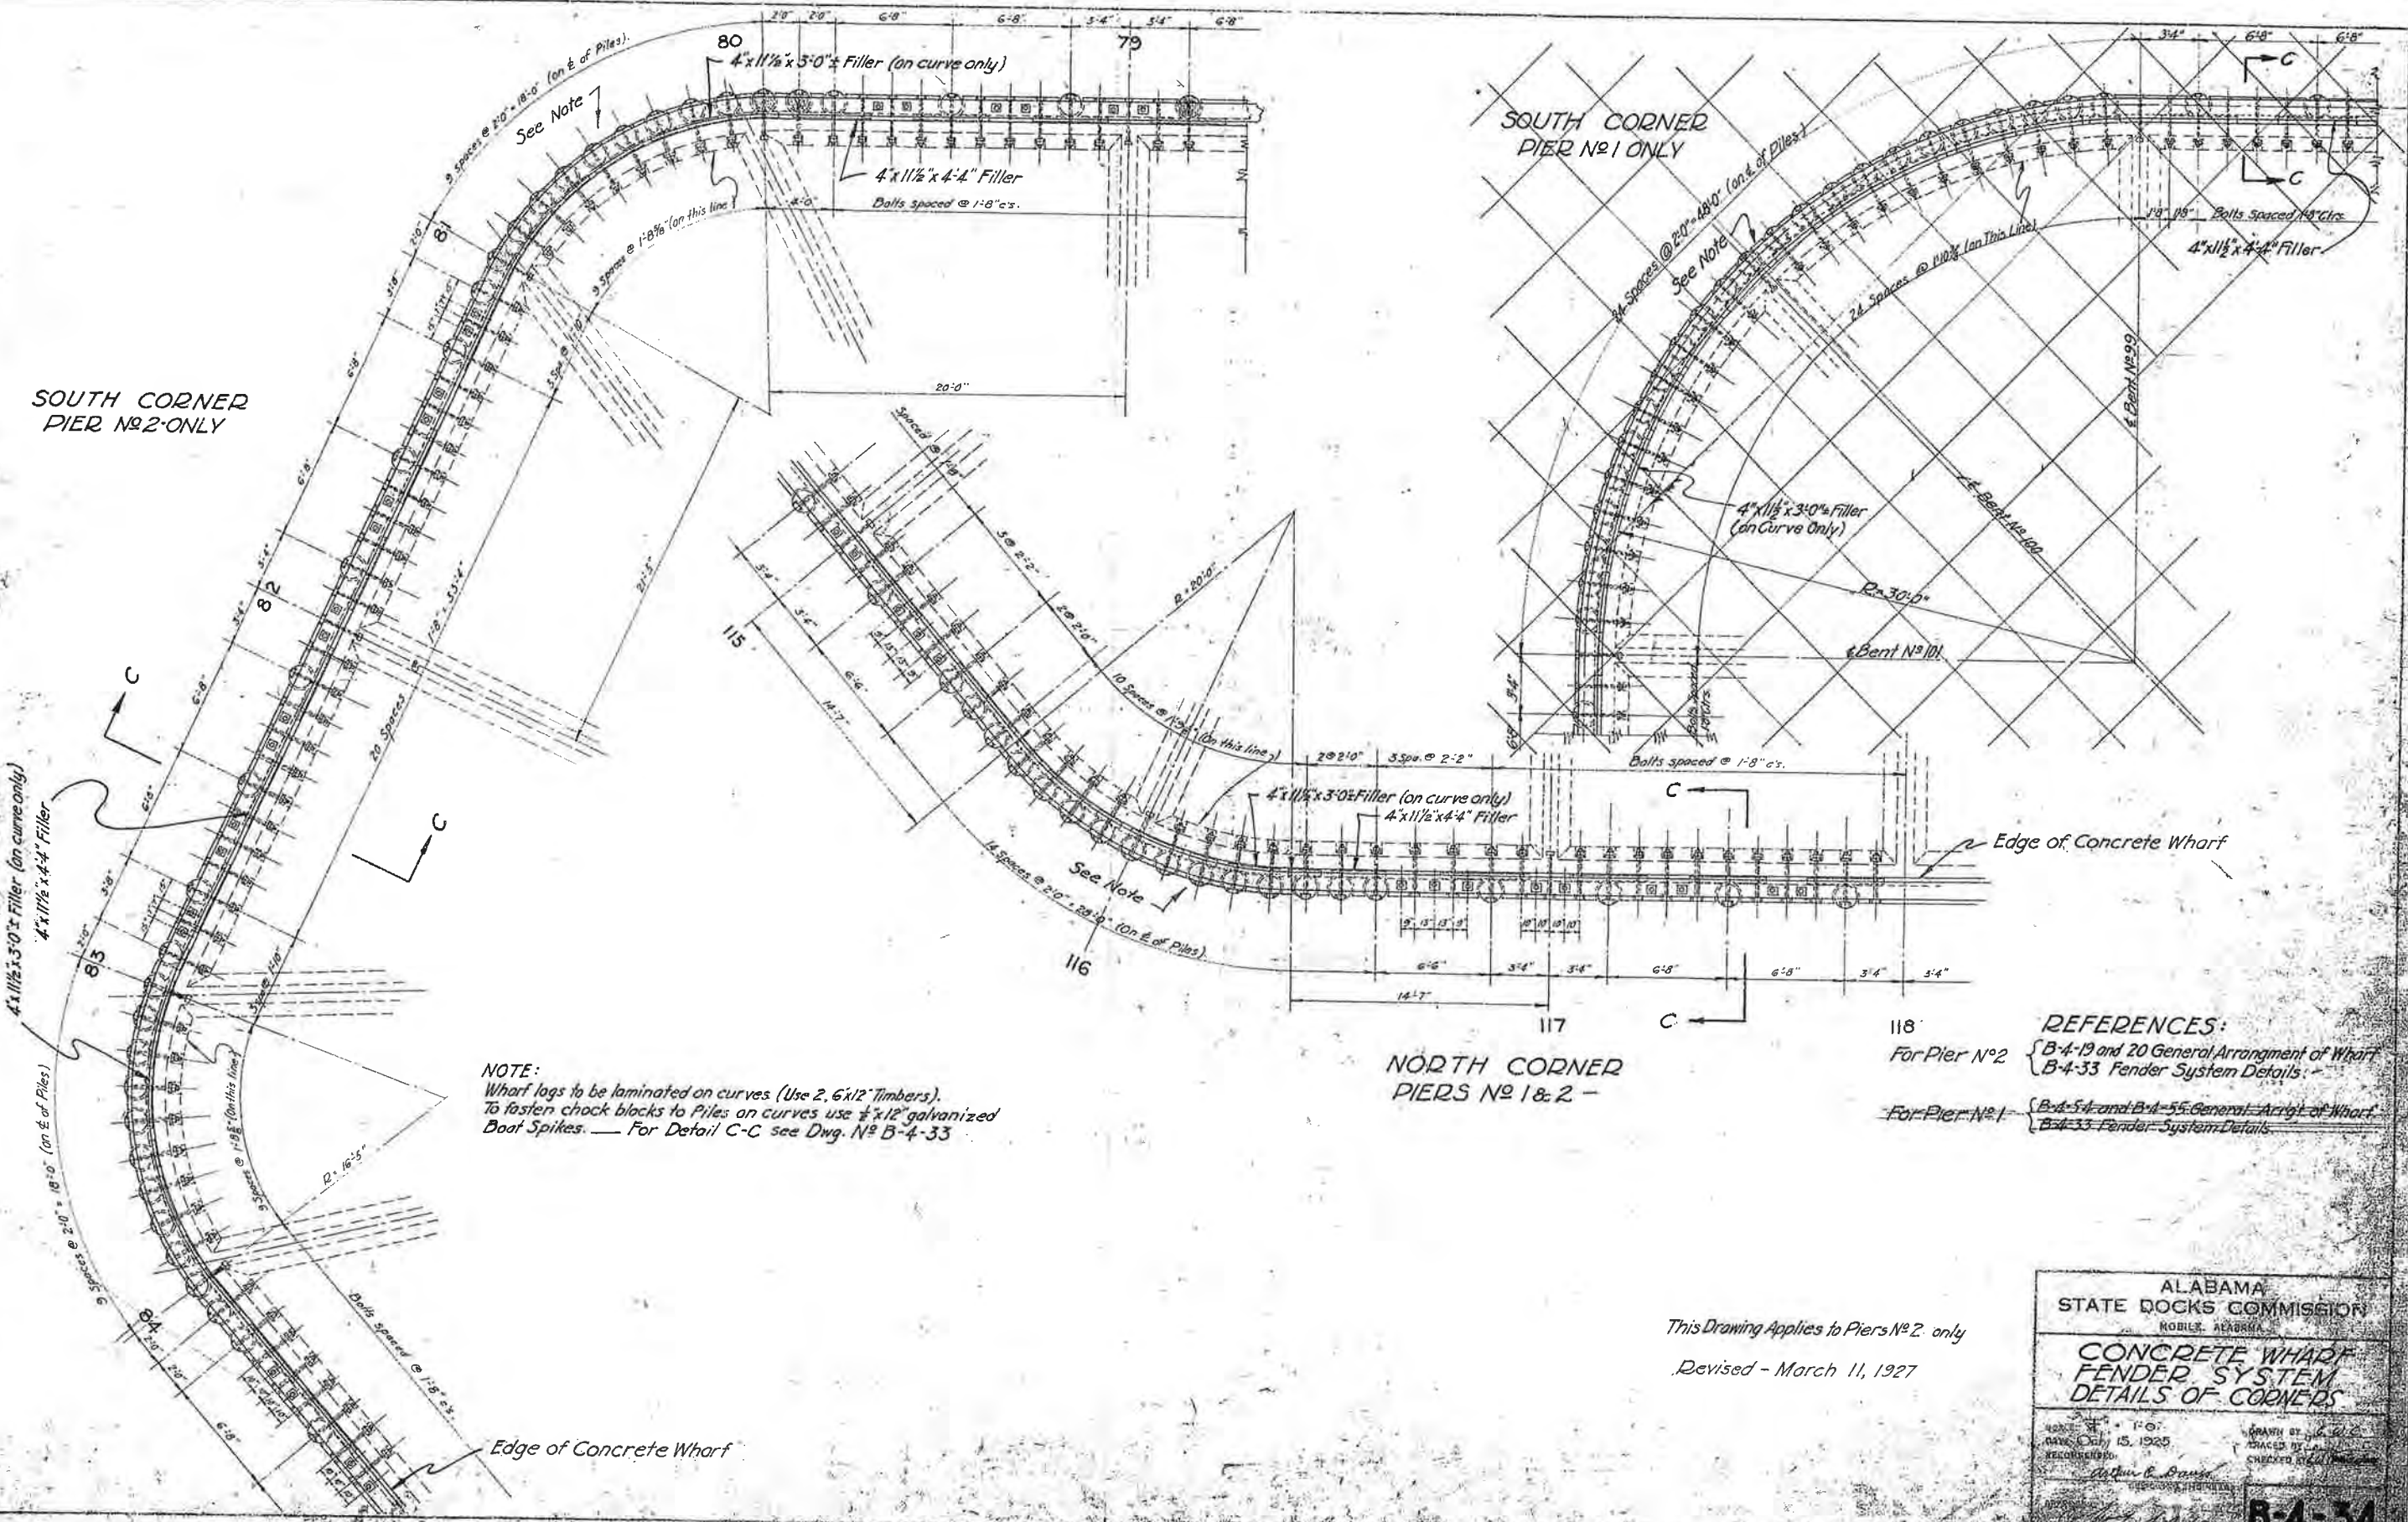

NOTE:  
Wharf logs to be laminated on curves (Use 2, 6x12 Timbers).  
To fasten chock blocks to Piles on curves use 1/2 x 12 galvanized  
Boat Spikes. — For Detail C-C see Dwg. No B-4-33

REFERENCES:  
For Pier No 2 { B-4-19 and 20 General Arrangement of Wharf  
B-4-33 Fender System Details  
For Pier No 1 { B-4-54 and B-4-55 General Arrangement of Wharf  
B-4-33 Fender System Details


This Drawing Applies to Piers No 2 only  
Revised - March 11, 1927

ALABAMA  
STATE DOCKS COMMISSION  
MOBILE, ALABAMA

CONCRETE WHARF  
FENDER SYSTEM  
DETAILS OF CORNERS

SCALE: 1" = 6'-0"  
DATE: July 15, 1925  
RECORDED:  
DRAWN BY: G.W.C.  
CHECKED BY: [Signature]  
APPROVED BY: [Signature]

B-4-34

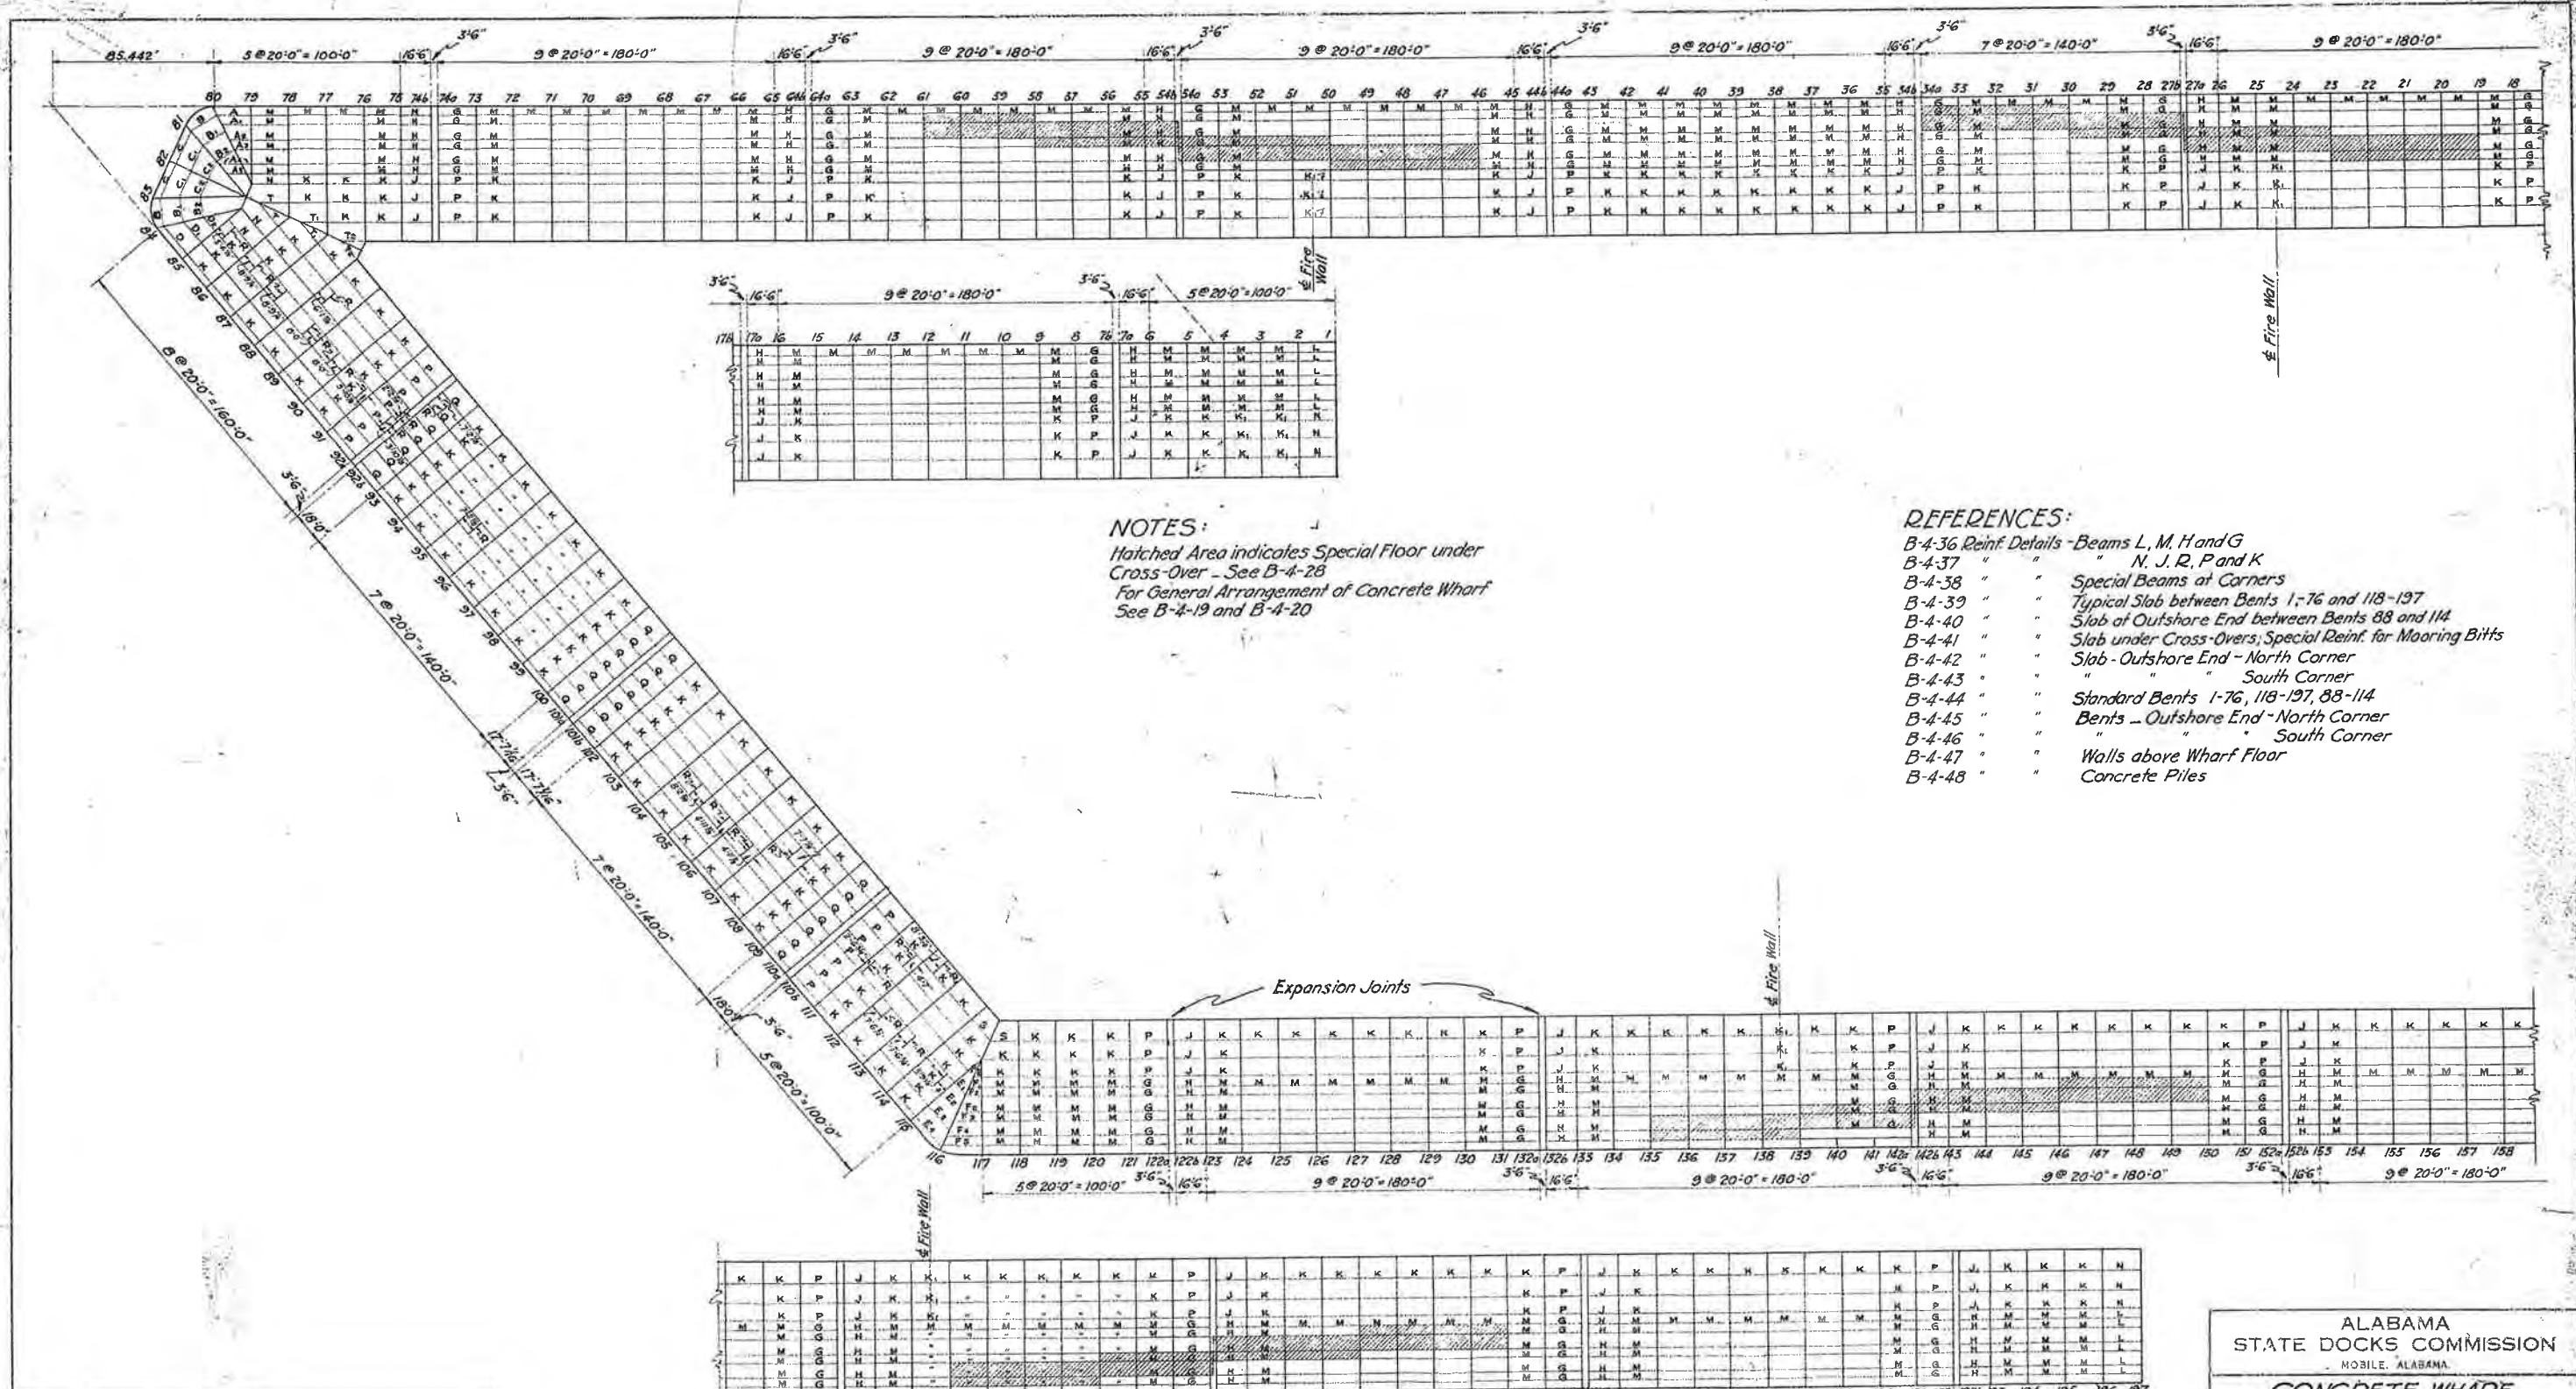

**NOTES:**  
 Hatched Area indicates Special Floor under Cross-Over - See B-4-28  
 For General Arrangement of Concrete Wharf See B-4-19 and B-4-20

- REFERENCES:**  
 B-4-36 Reinf. Details - Beams L, M, H and G  
 B-4-37 " " " " " N, J, R, P and K  
 B-4-38 " " " " " Special Beams at Corners  
 B-4-39 " " " " " Typical Slab between Bents 1-76 and 118-137  
 B-4-40 " " " " " Slab of Outshore End between Bents 88 and 114  
 B-4-41 " " " " " Slab under Cross-Overs, Special Reinf. for Mooring Bitts  
 B-4-42 " " " " " Slab - Outshore End - North Corner  
 B-4-43 " " " " " " " " " South Corner  
 B-4-44 " " " " " Standard Bents 1-76, 118-137, 88-114  
 B-4-45 " " " " " Bents - Outshore End - North Corner  
 B-4-46 " " " " " " " " " South Corner  
 B-4-47 " " " " " Walls above Wharf Floor  
 B-4-48 " " " " " Concrete Piles

TOTAL NUMBER OF BEAMS				
A = 1	C = 2	E <sub>1</sub> = 1	H = 96	Q = 28
A <sub>1</sub> = 1	C <sub>1</sub> = 2	E <sub>2</sub> = 1	J = 45	R = 20
A <sub>2</sub> = 1	C <sub>2</sub> = 2	F = 1	J <sub>1</sub> = 3	R <sub>1</sub> = 1
A <sub>3</sub> = 1	D = 1	F <sub>1</sub> = 1	K = 511	S = 2
A <sub>4</sub> = 1	D <sub>1</sub> = 1	F <sub>2</sub> = 1	K <sub>1</sub> = 18	T = 2
A <sub>5</sub> = 1	D <sub>2</sub> = 1	F <sub>3</sub> = 1	L = 12	T <sub>1</sub> = 2
B = 2	E = 2	F <sub>4</sub> = 1	M = 744	T <sub>2</sub> = 2
B <sub>1</sub> = 2	E <sub>1</sub> = 1	F <sub>5</sub> = 1	N = 9	
B <sub>2</sub> = 2	E <sub>2</sub> = 1	G = 96	P = 48	

ALABAMA  
 STATE DOCKS COMMISSION  
 MOBILE, ALABAMA



**CONCRETE WHARF  
 REINFORCING DETAILS  
 KEY PLAN OF FLOOR BEAMS**

SCALE: 1" = 40'  
 DATE: Oct. 15, 1953  
 DRAWN BY: [Signature]  
 CHECKED BY: [Signature]


APPROVED: [Signature]  
 CHAIRMAN

**B-4-35**




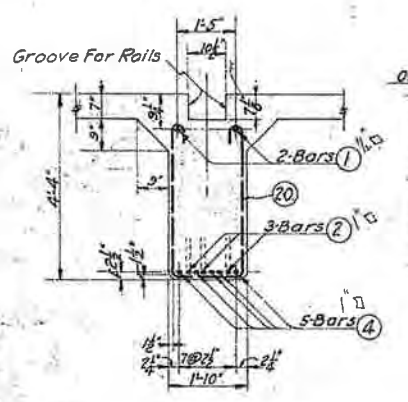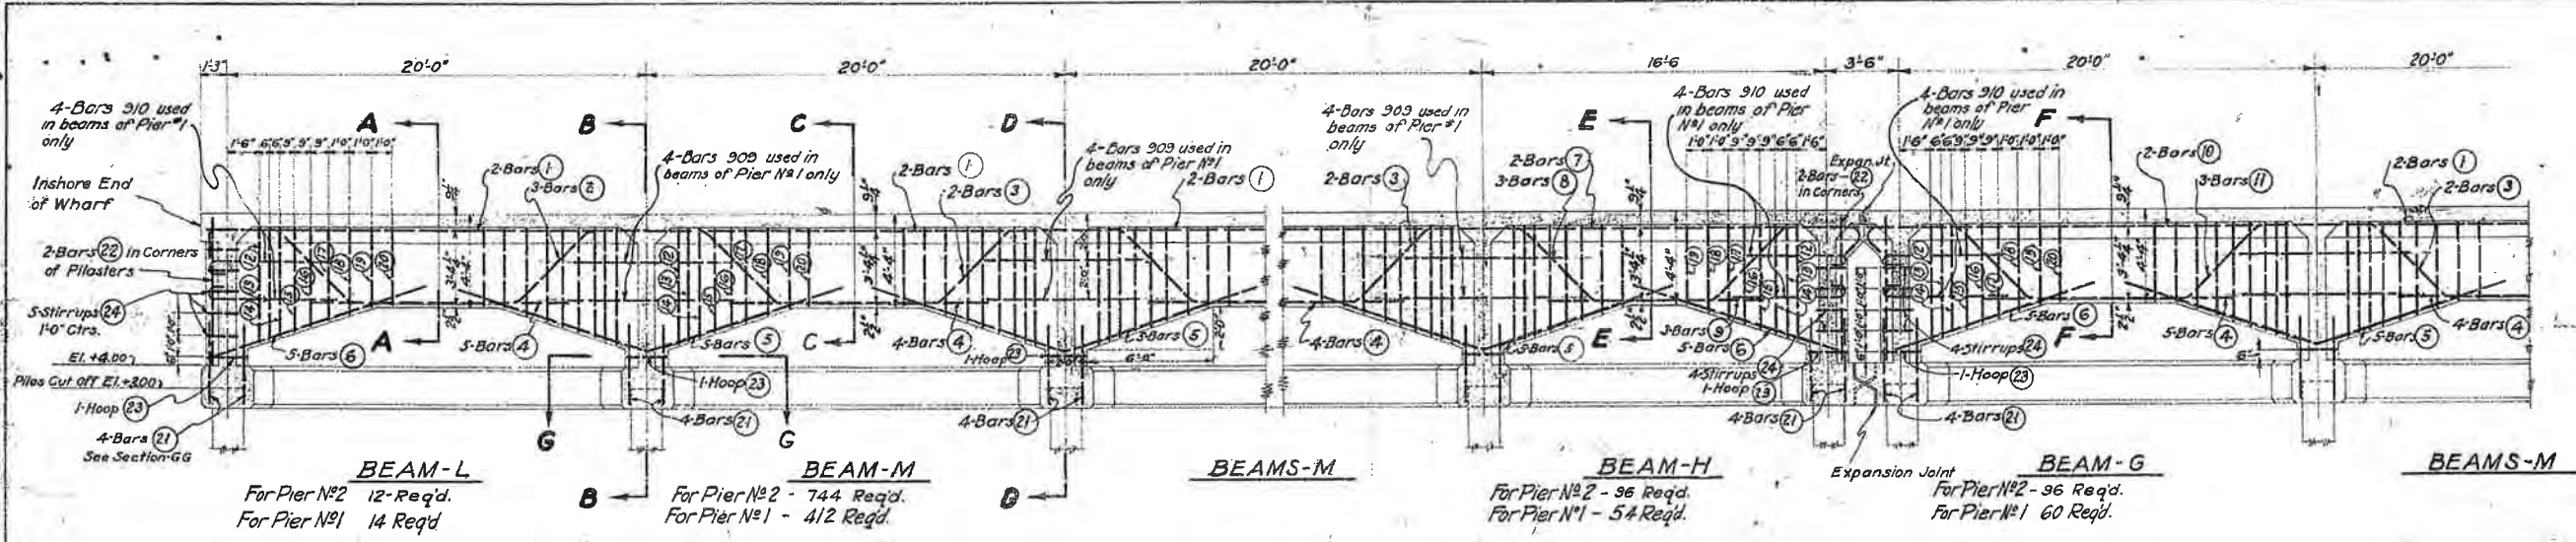


SECTION-AA  
Scale 1/2"=1'-0"

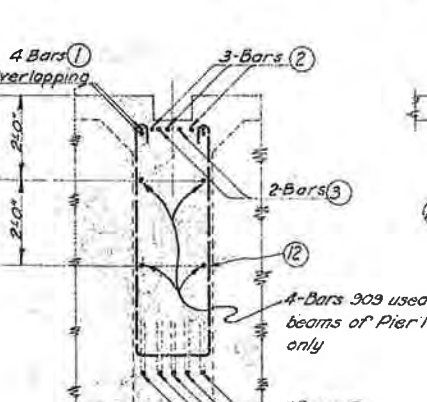


SECTION-BB  
Scale 1/2"=1'-0"

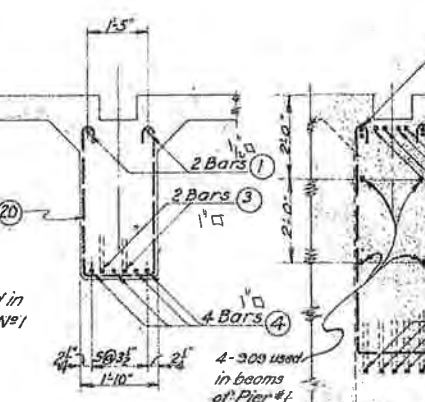


SECTION-CC  
Scale 1/2"=1'-0"

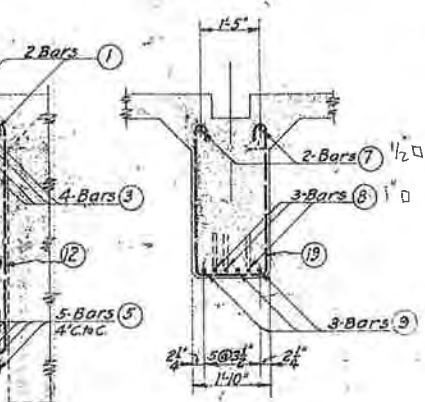


SECTION-DD  
Scale 1/2"=1'-0"

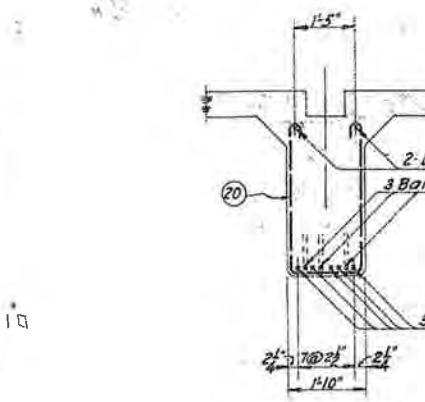

SECTION-EE  
Scale 1/2"=1'-0"


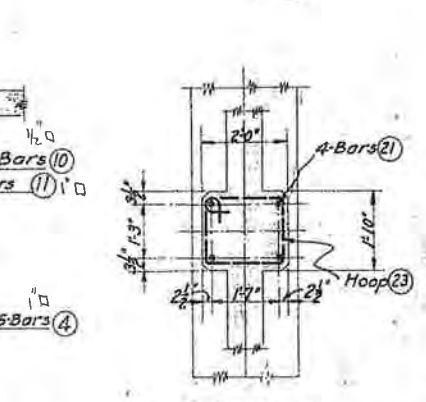


SECTION-FF  
Scale 1/2"=1'-0"

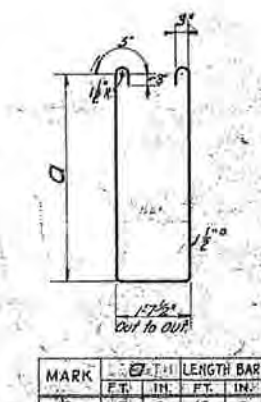

SECTION-GG  
Scale 1/2"=1'-0"  
Typical Section Thru Pilasters Supporting Beams.

MARK	FT.	IN.	LENGTH BAR
12	5	2	13 6
13	5	0	13 3
14	4	10	12 9
15	4	8	12 6
16	4	4	11 9
17	4	1	11 3
18	3	9	10 6
19	3	5	10 0
20	3	4	9 6

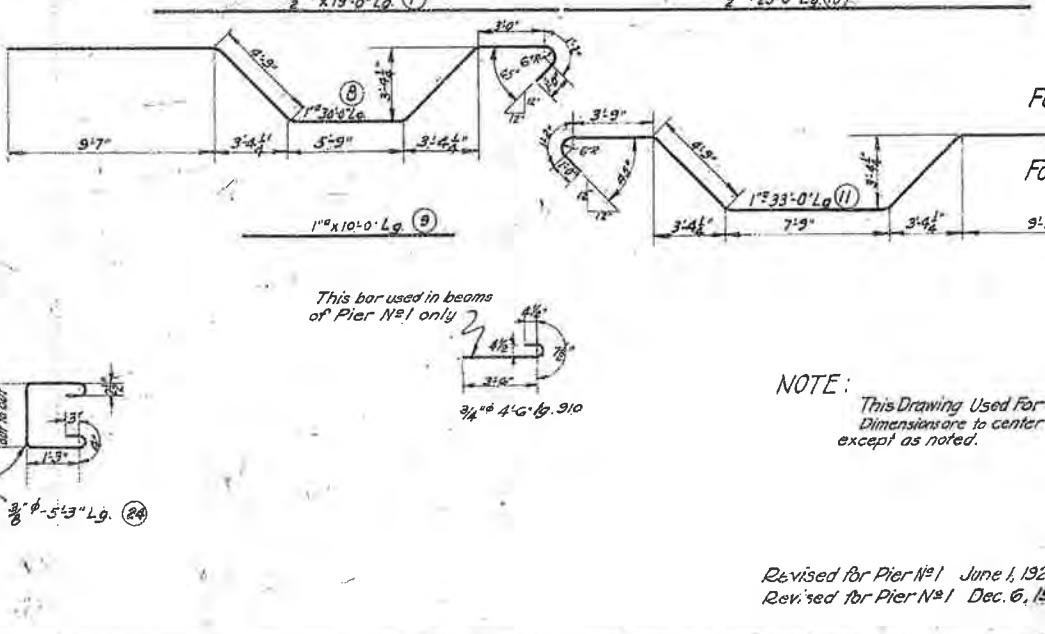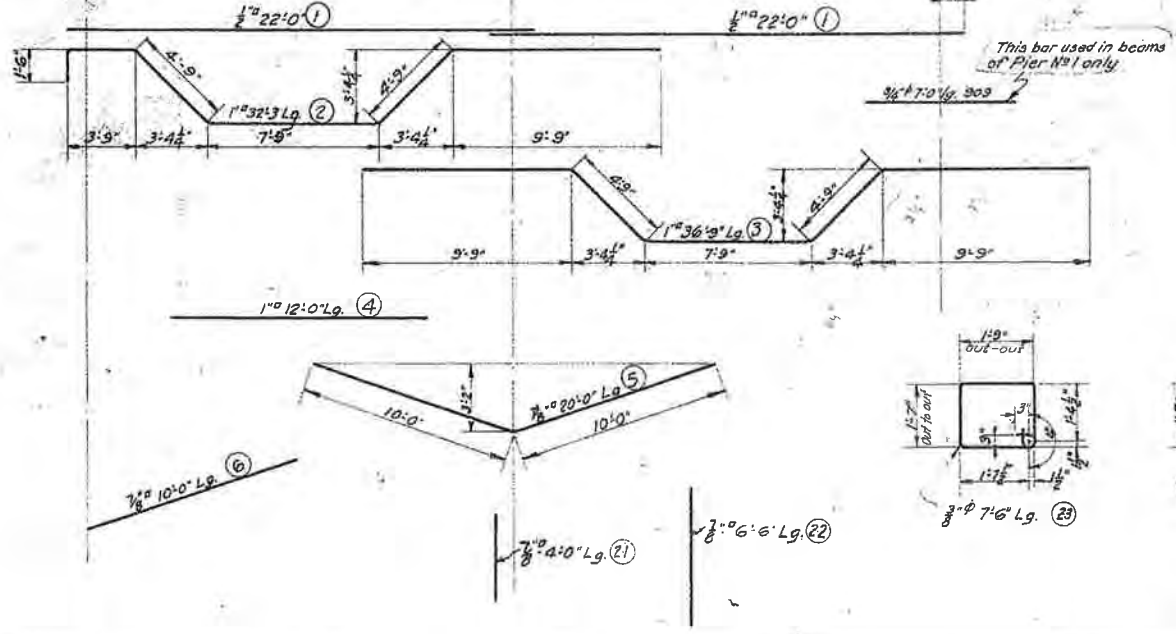

REFERENCES:  
 FOR PIER #2 B-4-35 Key Plan of Floor Beams for Reinforcing  
 B-4-23 Inshore Ends-Neat Lines of Concrete  
 B-4-38 Special Beams at Corners-Reinforcing  
 FOR PIER #1 B-4-130 Key Plan of Floor Beams for Reinforcing  
 B-4-58 Inshore Ends-Neat Lines of Concrete  
 B-4-195 Special Beams at Corners-Reinforcing  
 B-4-197

NOTE:  
 This Drawing Used For Piers #1 & 2  
 Dimensions to center lines of Bars  
 except as noted.


Revised for Pier #1 June 1, 1926.  
 Revised for Pier #2 Dec. 6, 1926.

ALABAMA  
 STATE DOCKS COMMISSION  
 MOBILE, ALABAMA

CONCRETE WHARF  
 REINFORCING DETAILS  
 BEAMS L, M, H & G SUPPORTING R.R. TRACKS

SCALE: 1/2" = 1'-0"  
 DATE: Oct. 15, 1925  
 RECOMMENDED:  
 APPROVED:  
 DRAWN BY: Hammond  
 TRACED BY:  
 CHECKED BY: J. P. ...

B-4-36

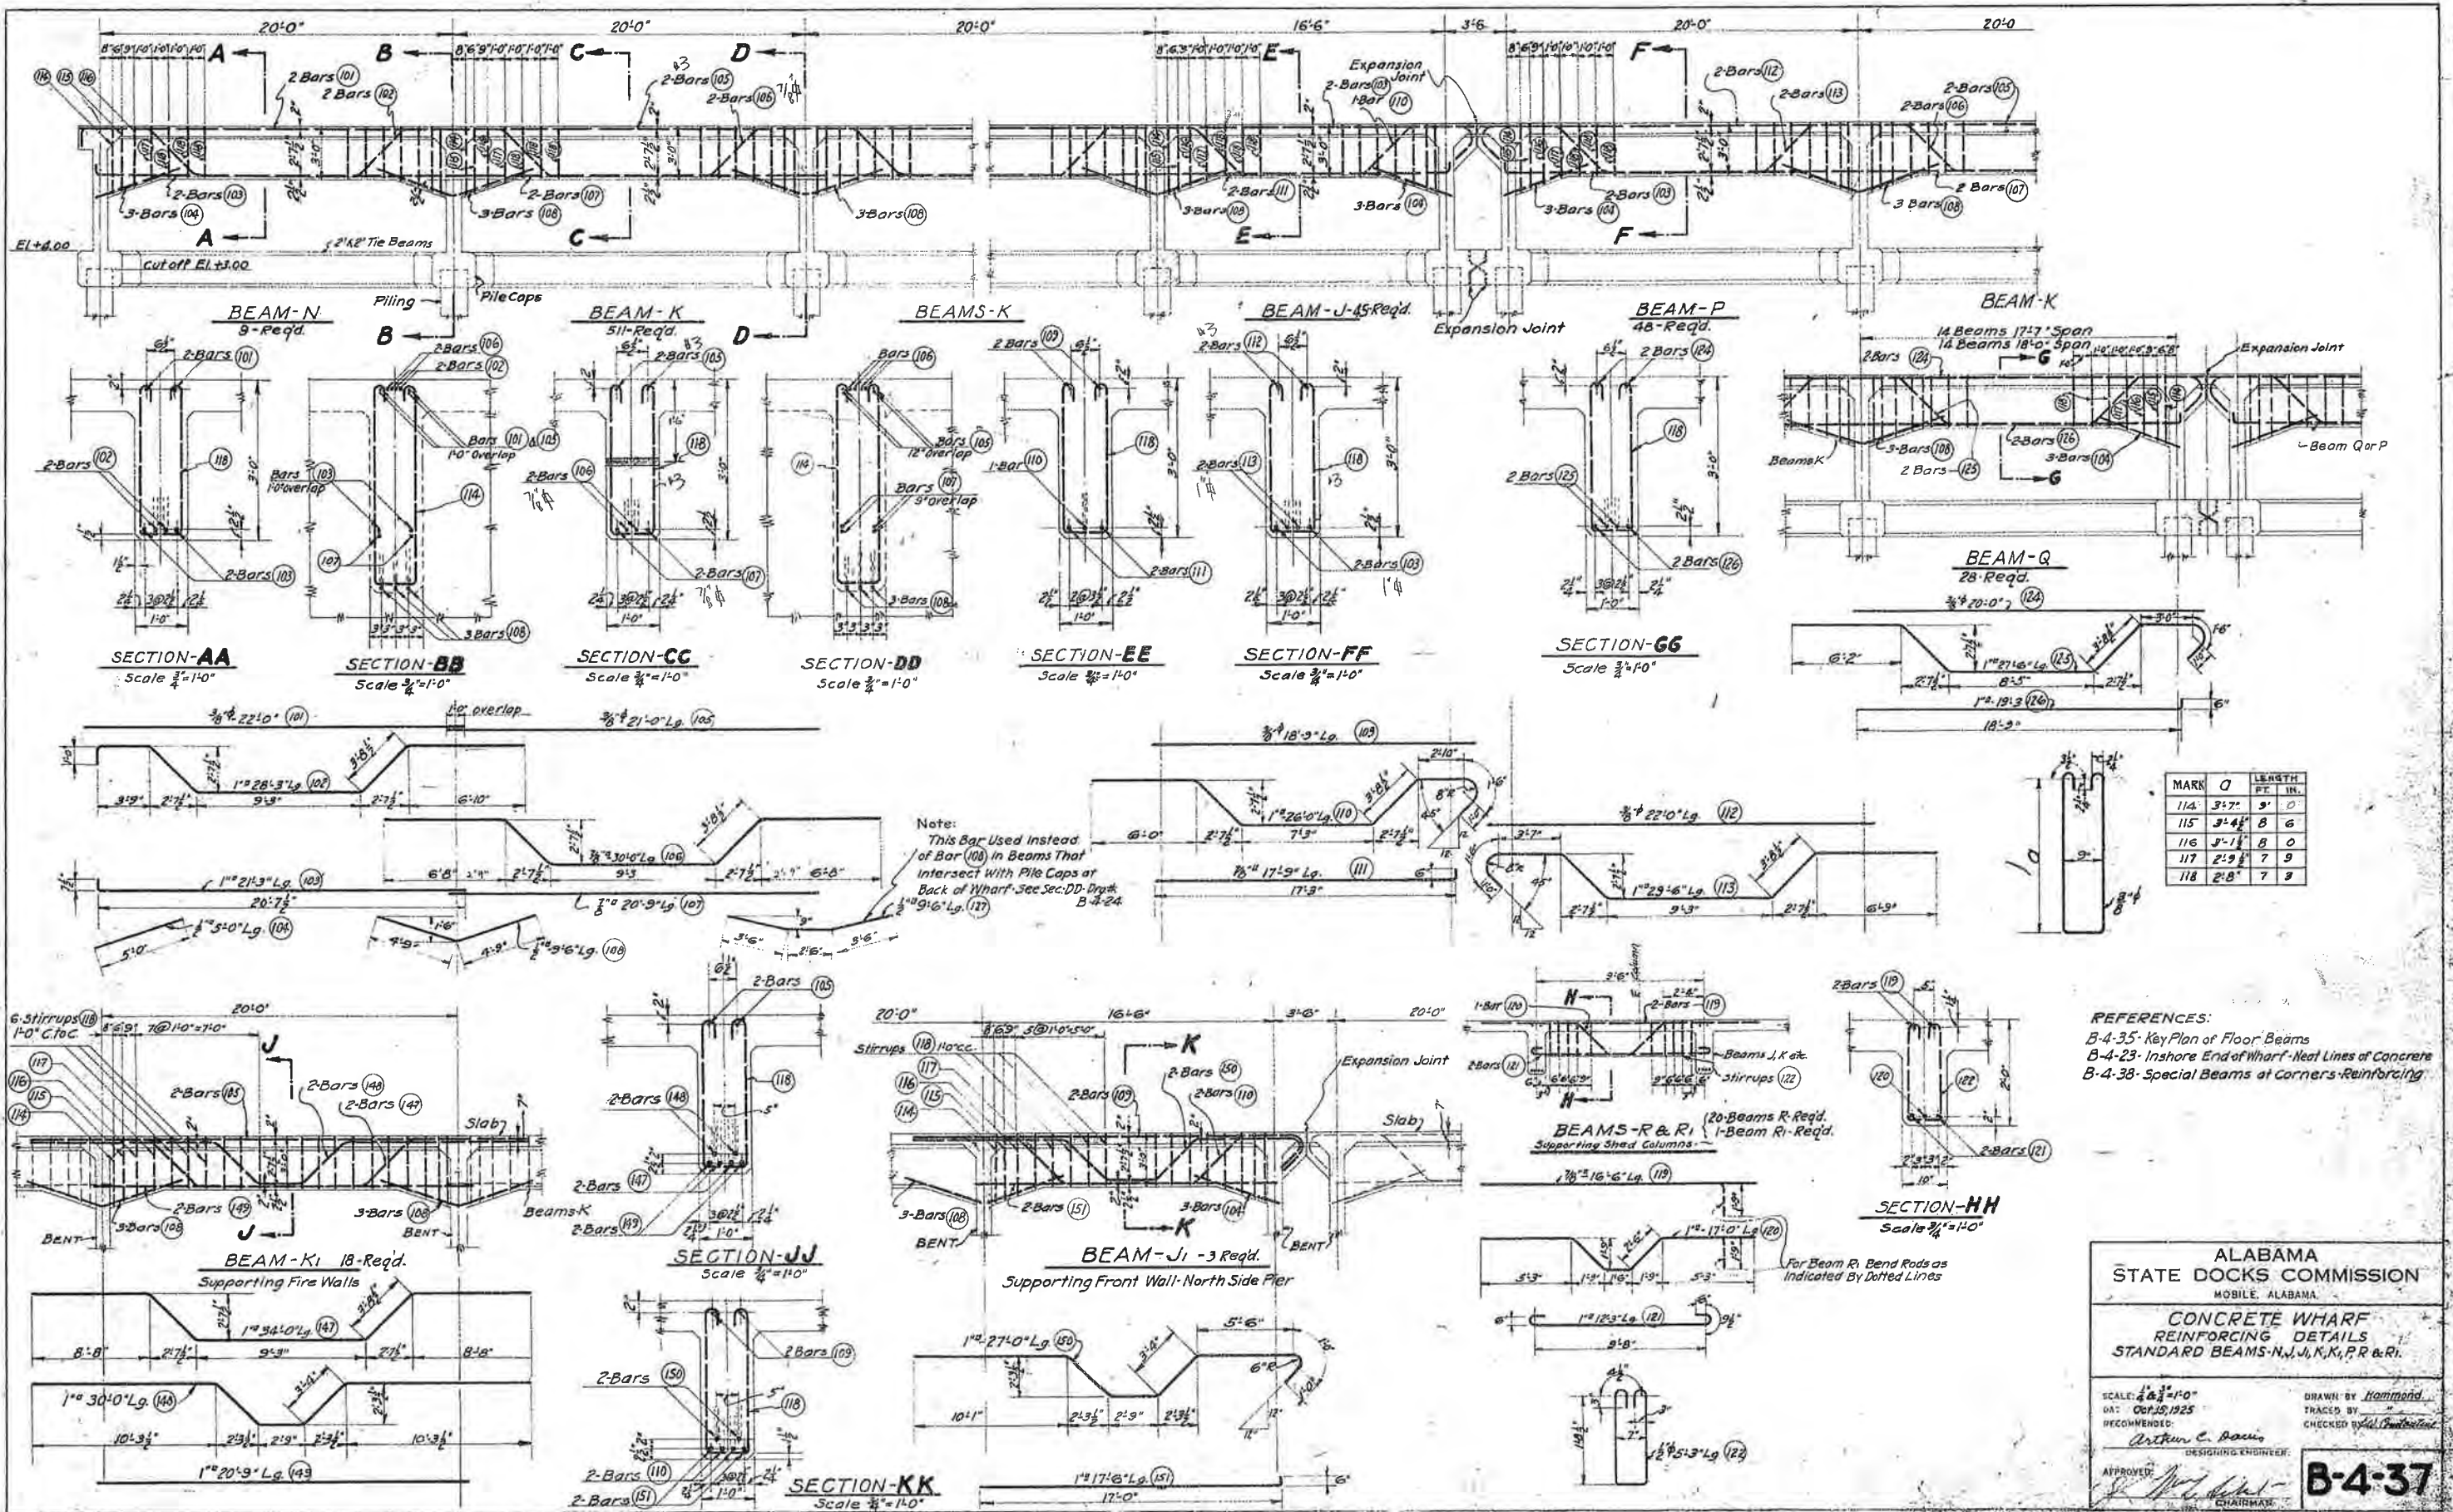

Note:  
 This Bar Used Instead  
 of Bar (108) in Beams That  
 Intersect With Pile Caps at  
 Back of Wharf. See Sec. DD. Draw  
 B-4-24

MARK	O	LENGTH
114	3'-7"	5' 0
115	3'-4"	8' 6
116	3'-1"	8' 0
117	2'-9"	7' 9
118	2'-8"	7' 9

REFERENCES:  
 B-4-35. Key Plan of Floor Beams  
 B-4-23. Inshore End of Wharf - Near Lines of Concrete  
 B-4-38. Special Beams at Corners - Reinforcing


ALABAMA  
 STATE DOCKS COMMISSION  
 MOBILE, ALABAMA.

CONCRETE WHARF  
 REINFORCING DETAILS  
 STANDARD BEAMS-N, J, K, P, R & S.

SCALE:  $\frac{1}{4}'' = 1'-0''$   
 DATE: Oct. 15, 1925  
 RECOMMENDED:  
 Arthur C. Davis  
 DESIGNING ENGINEER

DRAWN BY: Hammond  
 TRACED BY:  
 CHECKED BY: [Signature]  
 APPROVED:  
 [Signature]  
 CHAIRMAN

**B-4-37**

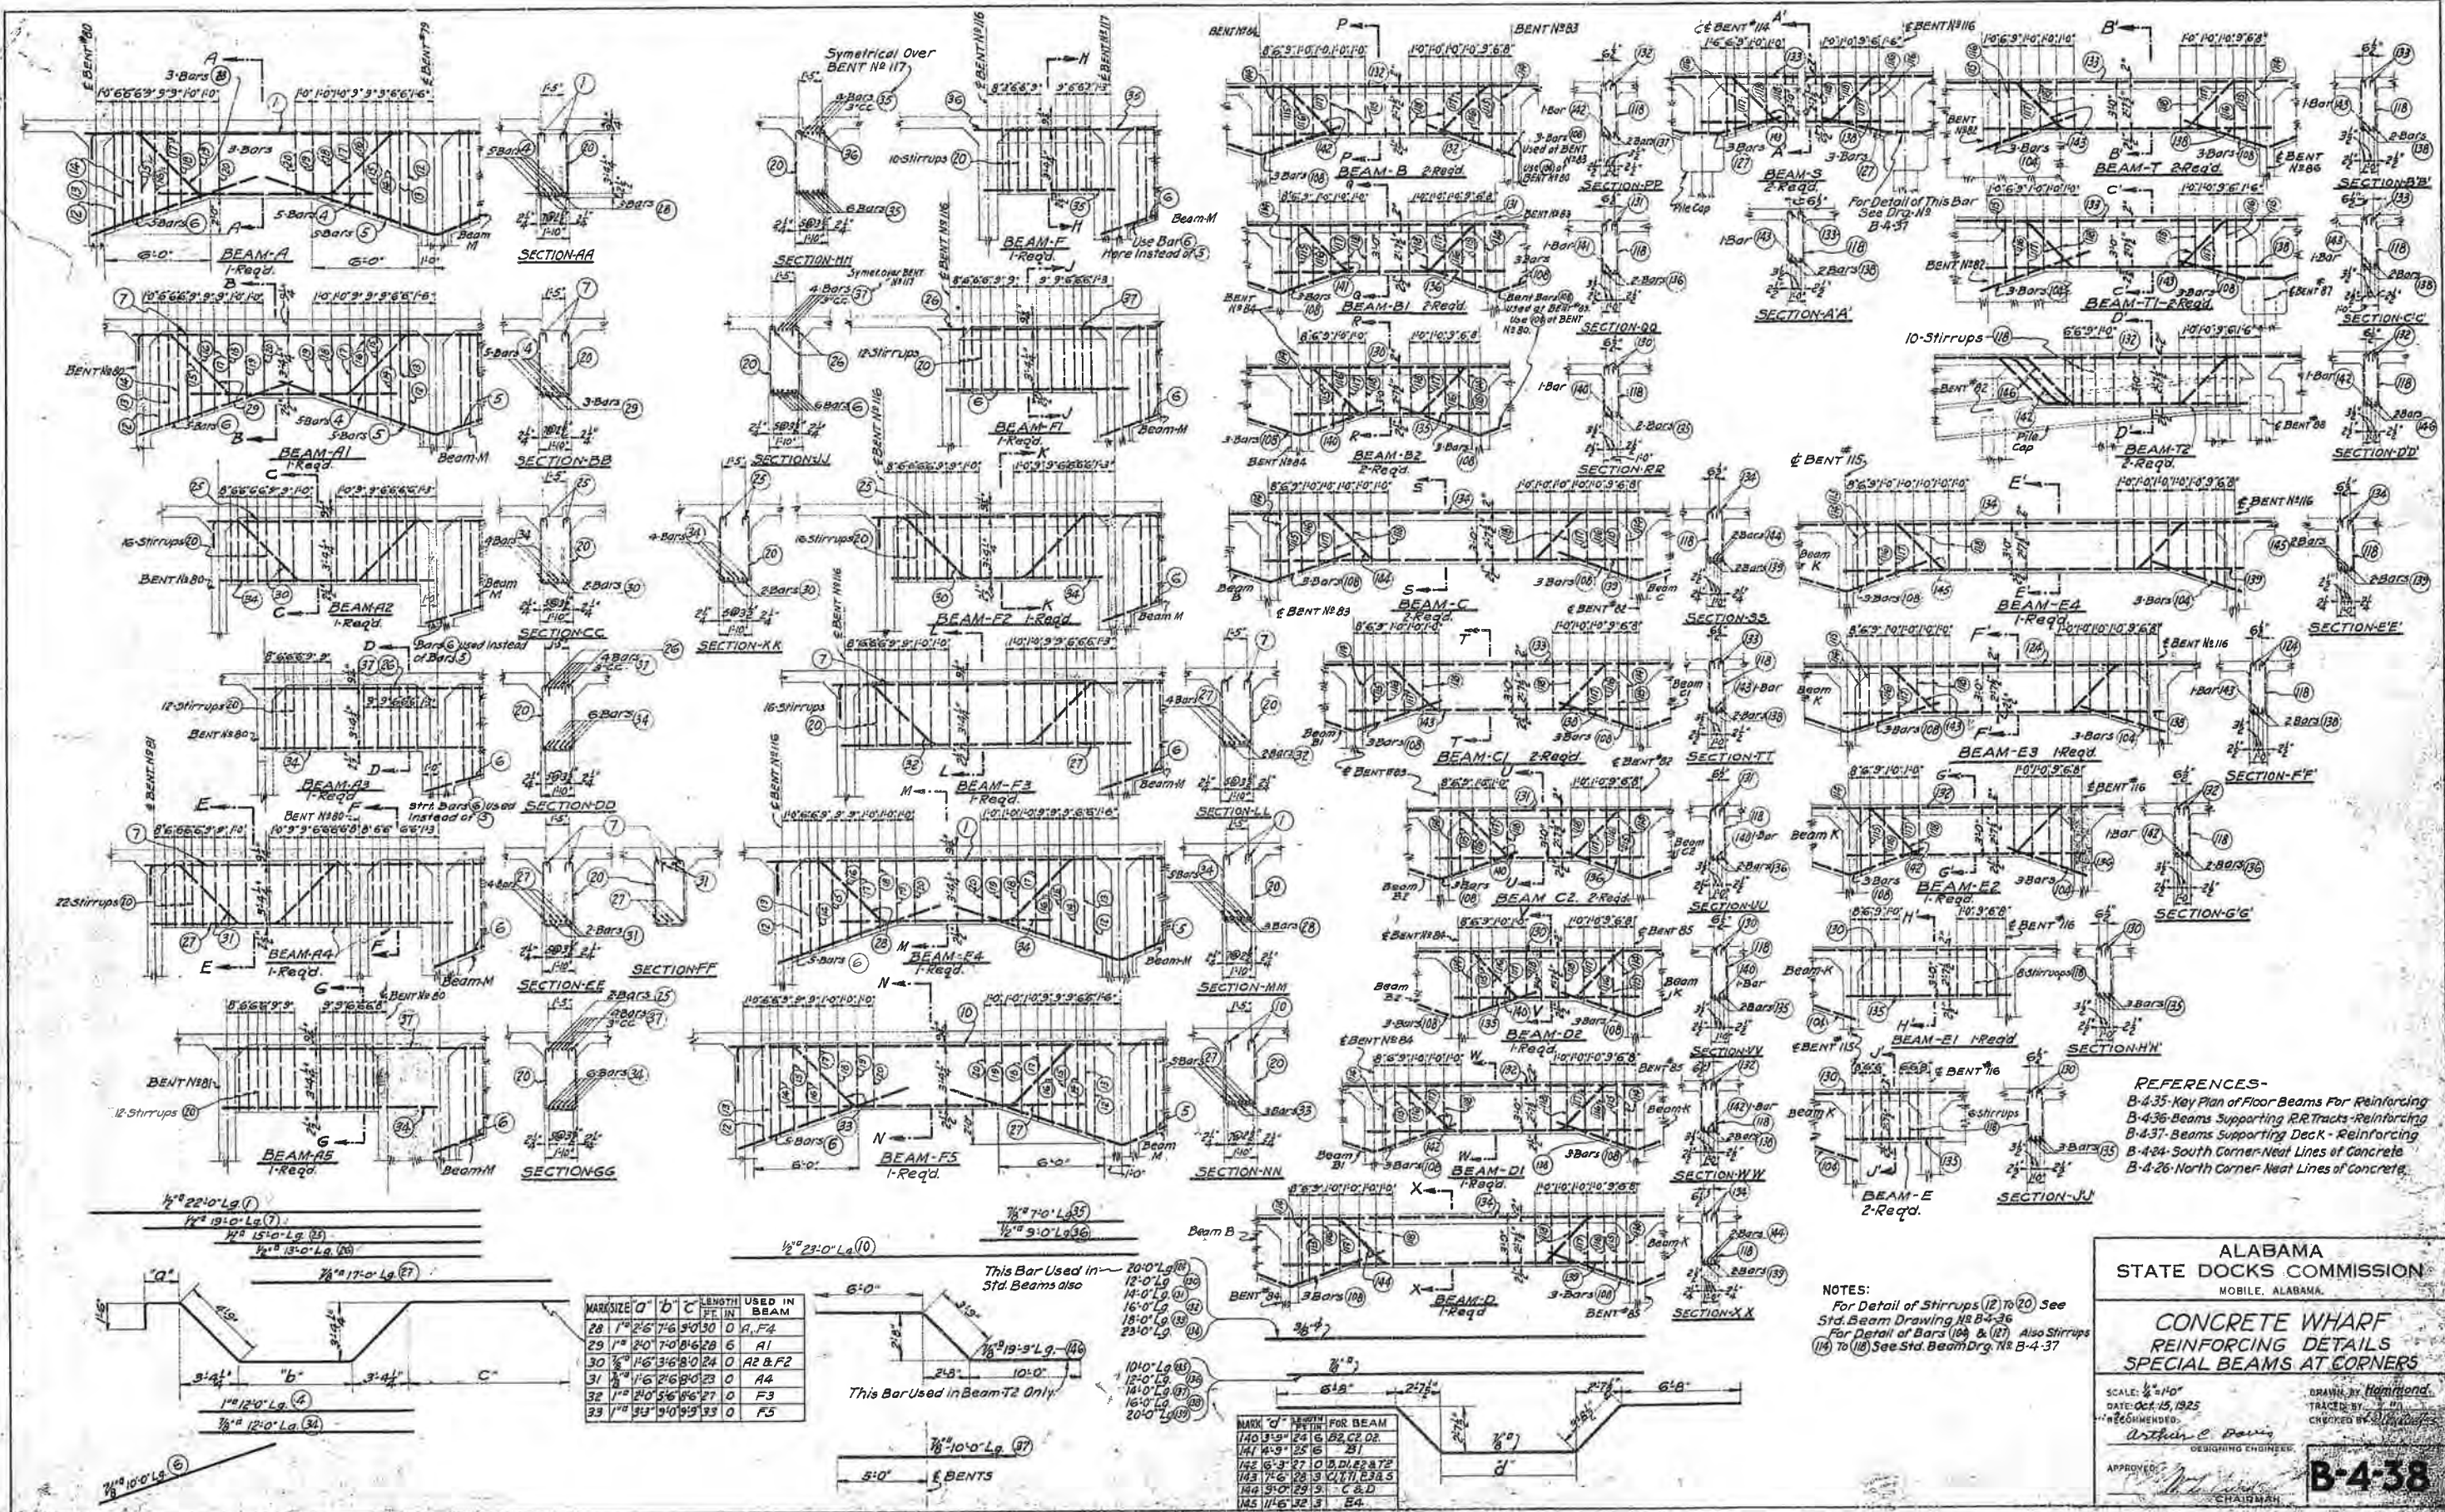

MARK	SIZE	Q	D	C	LENGTH FT. IN.	USED IN BEAM	
28	1"	25	7	50	30	A, F, 4	
29	1"	20	7	0	6	A, 1	
30	1"	16	3	6	28	A, 2, B, F, 2	
31	1"	16	3	6	23	0	A, 4
32	1"	21	0	5	6	F, 3	
33	1"	13	9	0	9	3	F, 5

MARK	Q	REINFORCING FOR BEAM
140	3"	24
141	4"	25
142	6"	27
143	7"	28
144	9"	29
145	11"	32

- REFERENCES-**
- B-4-35-Key Plan of Floor Beams For Reinforcing
  - B-4-36 Beams Supporting R.R. Tracks-Reinforcing
  - B-4-37 Beams Supporting Deck-Reinforcing
  - B-4-24 South Corner-Neat Lines of Concrete
  - B-4-26 North Corner-Neat Lines of Concrete

**NOTES:**  
 For Detail of Stirrups (12) to (20) See Std. Beam Drawing #B-4-36  
 For Detail of Bars (10) & (17) Also Stirrups (14) to (18) See Std. Beam Drg. #B-4-37

**ALABAMA  
STATE DOCKS COMMISSION**  
MOBILE, ALABAMA.


**CONCRETE WHARF  
REINFORCING DETAILS  
SPECIAL BEAMS AT CORNERS**

SCALE: 3/4" = 1'-0"  
 DATE: OCT. 15, 1925  
 RECOMMENDED:  
 Arthur C. Davis  
 DESIGNING ENGINEER

DRAWN BY: Hamilton  
 TRACED BY: [ ]  
 CHECKED BY: [ ]


APPROVED: [ ]  
 CHAIRMAN

B-4-38

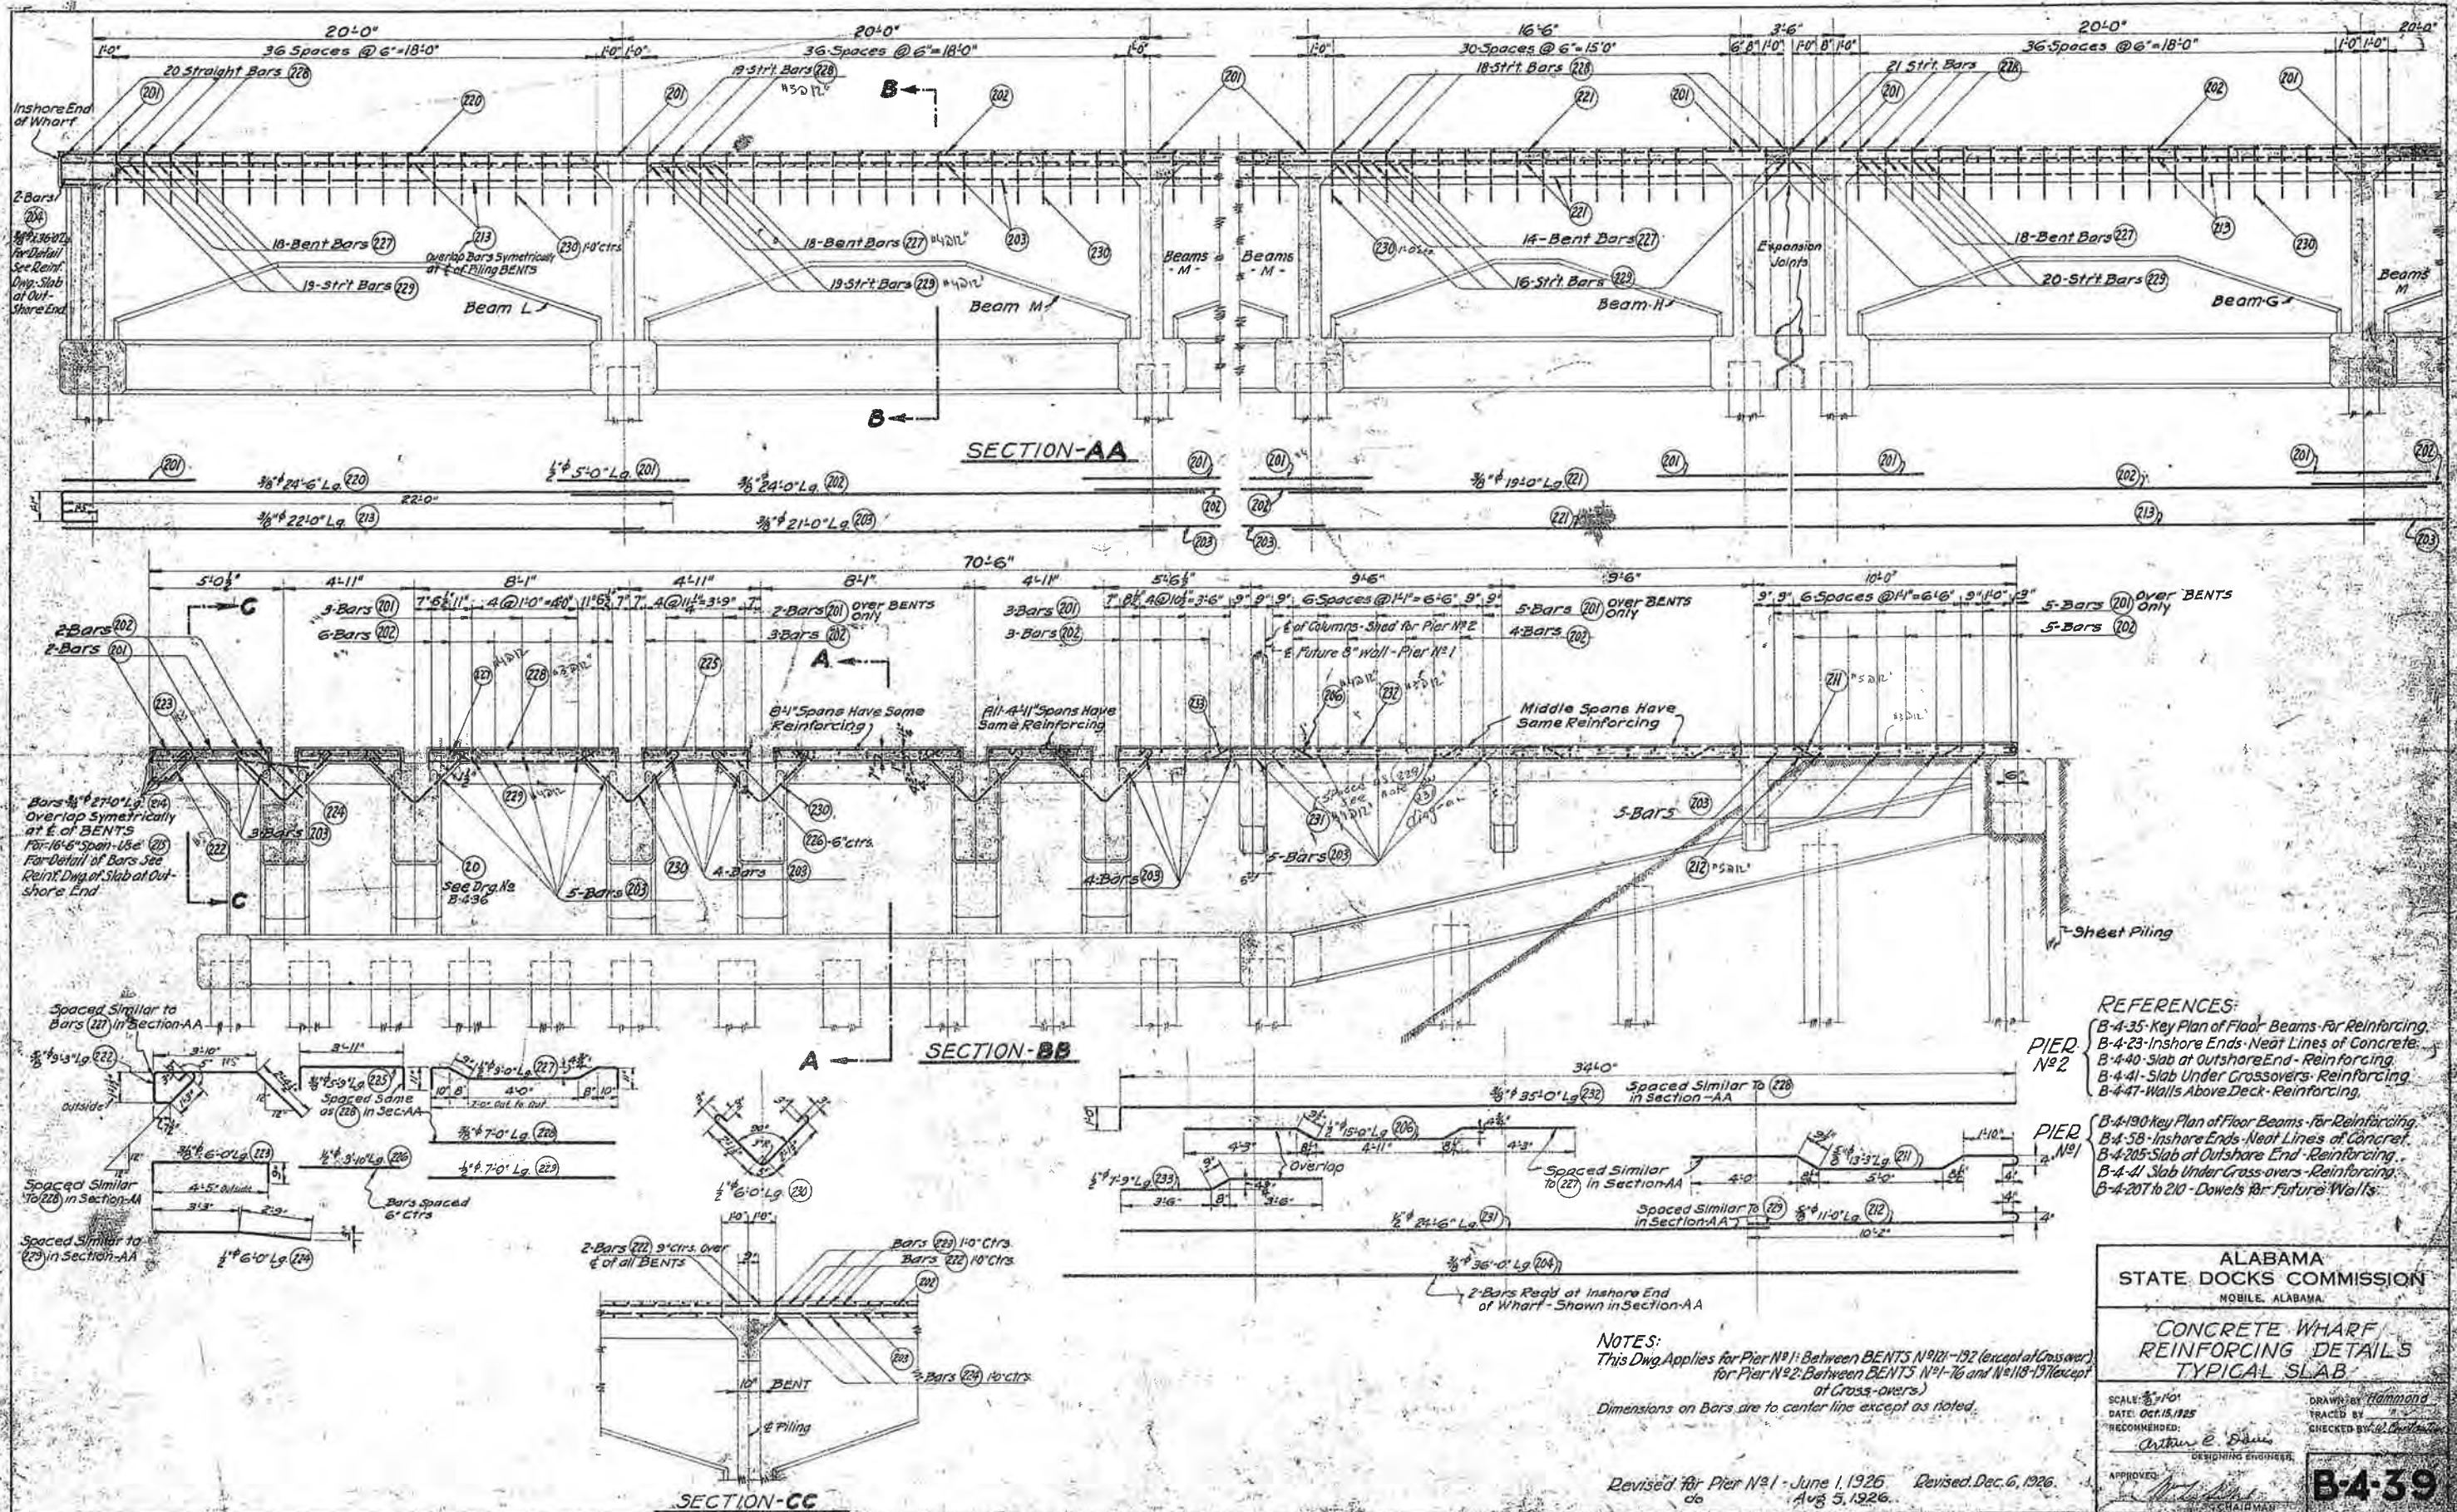

Inshore End of Wharf  
2 Bars (204)  
See Detail of Slab at Outshore End

Bars  $\frac{1}{2}$ "  $\phi$  27" Lg. (224) Overlap Symmetrically at E. of BENTS For 16'6" Span - Use (225) For Detail of Bars See Reinf. Dwg. of Slab at Outshore End

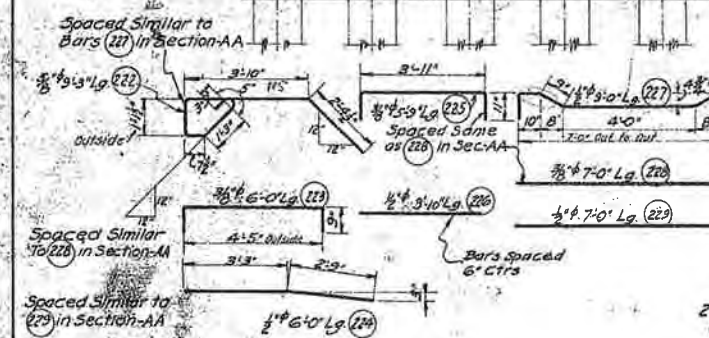


Spaced Similar to Bars (227) in Section-AA

Spaced Same as (228) in Section-AA

Bars spaced 6' ctrs

2 Bars (222) 9' ctrs over E. of all BENTS

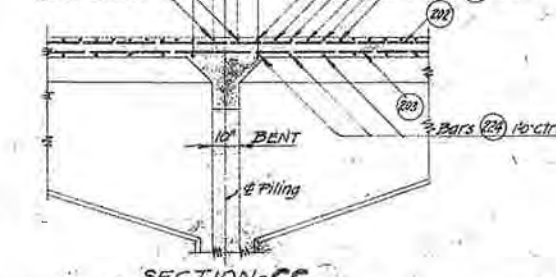

SECTION-AA

SECTION-BB

SECTION-CC

- REFERENCES:
- B-4-35 Key Plan of Floor Beams - For Reinforcing
  - B-4-23 Inshore Ends - Neat Lines of Concrete
  - B-4-40 Slab at Outshore End - Reinforcing
  - B-4-41 Slab Under Crossovers - Reinforcing
  - B-4-47 Walls Above Deck - Reinforcing
- PIER N<sup>o</sup> 2
- B-4-190 Key Plan of Floor Beams - For Reinforcing
  - B-4-58 Inshore Ends - Neat Lines of Concrete
  - B-4-205 Slab at Outshore End - Reinforcing
  - B-4-41 Slab Under Cross-overs - Reinforcing
  - B-4-207 to 210 - Dowels for Future Walls

NOTES:  
This Dwg. Applies for Pier N<sup>o</sup> 1: Between BENTS N<sup>o</sup> 121-192 (except at Cross over) for Pier N<sup>o</sup> 2: Between BENTS N<sup>o</sup> 1-76 and N<sup>o</sup> 113-191 (except at Cross-overs)  
Dimensions on Bars are to center line except as noted.

Revised for Pier N<sup>o</sup> 1 - June 1, 1926  
Revised Dec. 6, 1926  
Aug 5, 1926

ALABAMA  
STATE DOCKS COMMISSION  
MOBILE, ALABAMA




CONCRETE WHARF  
REINFORCING DETAILS  
TYPICAL SLAB

SCALE: 3/4" = 1'  
DATE: Oct. 15, 1925  
RECOMMENDED BY:  
Arthur E. Davis  
DESIGNING ENGINEER

DRAWN BY: Hammond  
TRACED BY:  
CHECKED BY: [Signature]

APPROVED: [Signature]  
CHAIRMAN

**B-4-39**

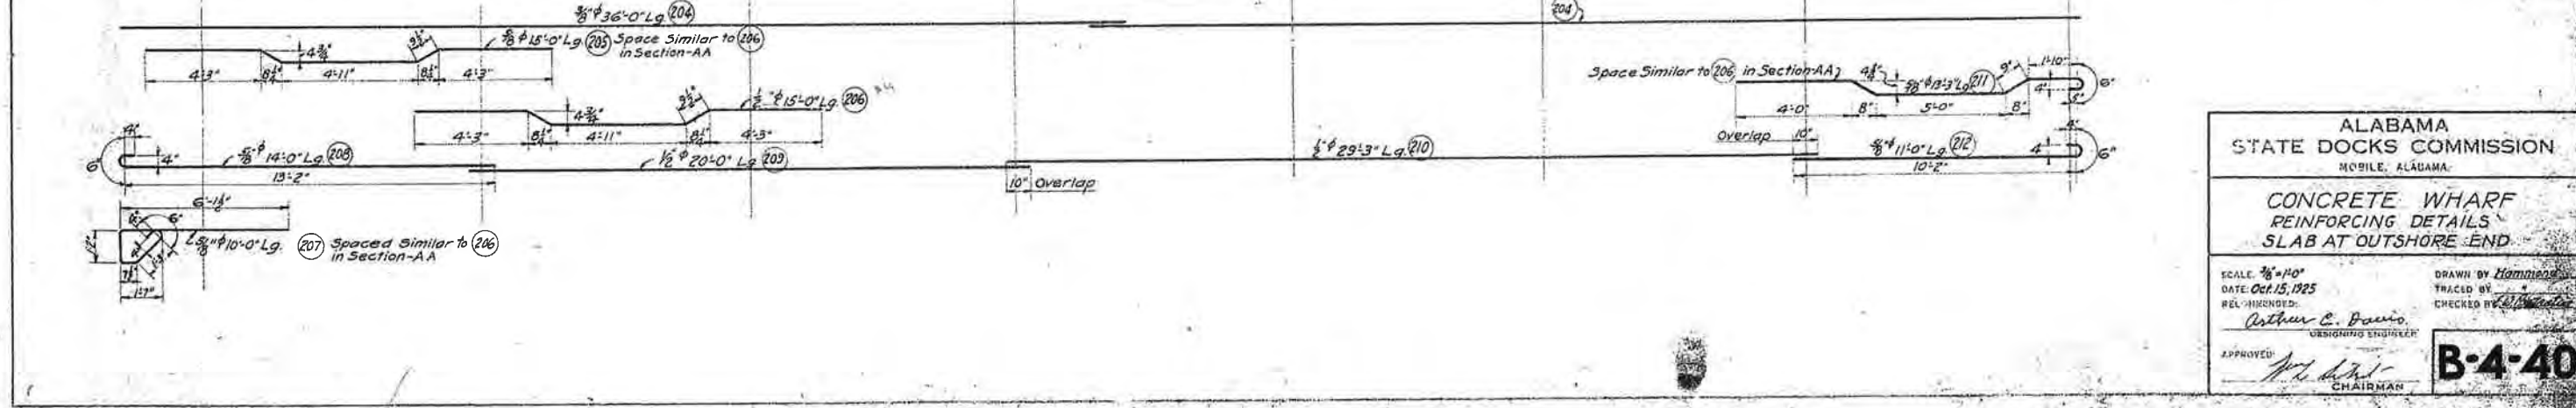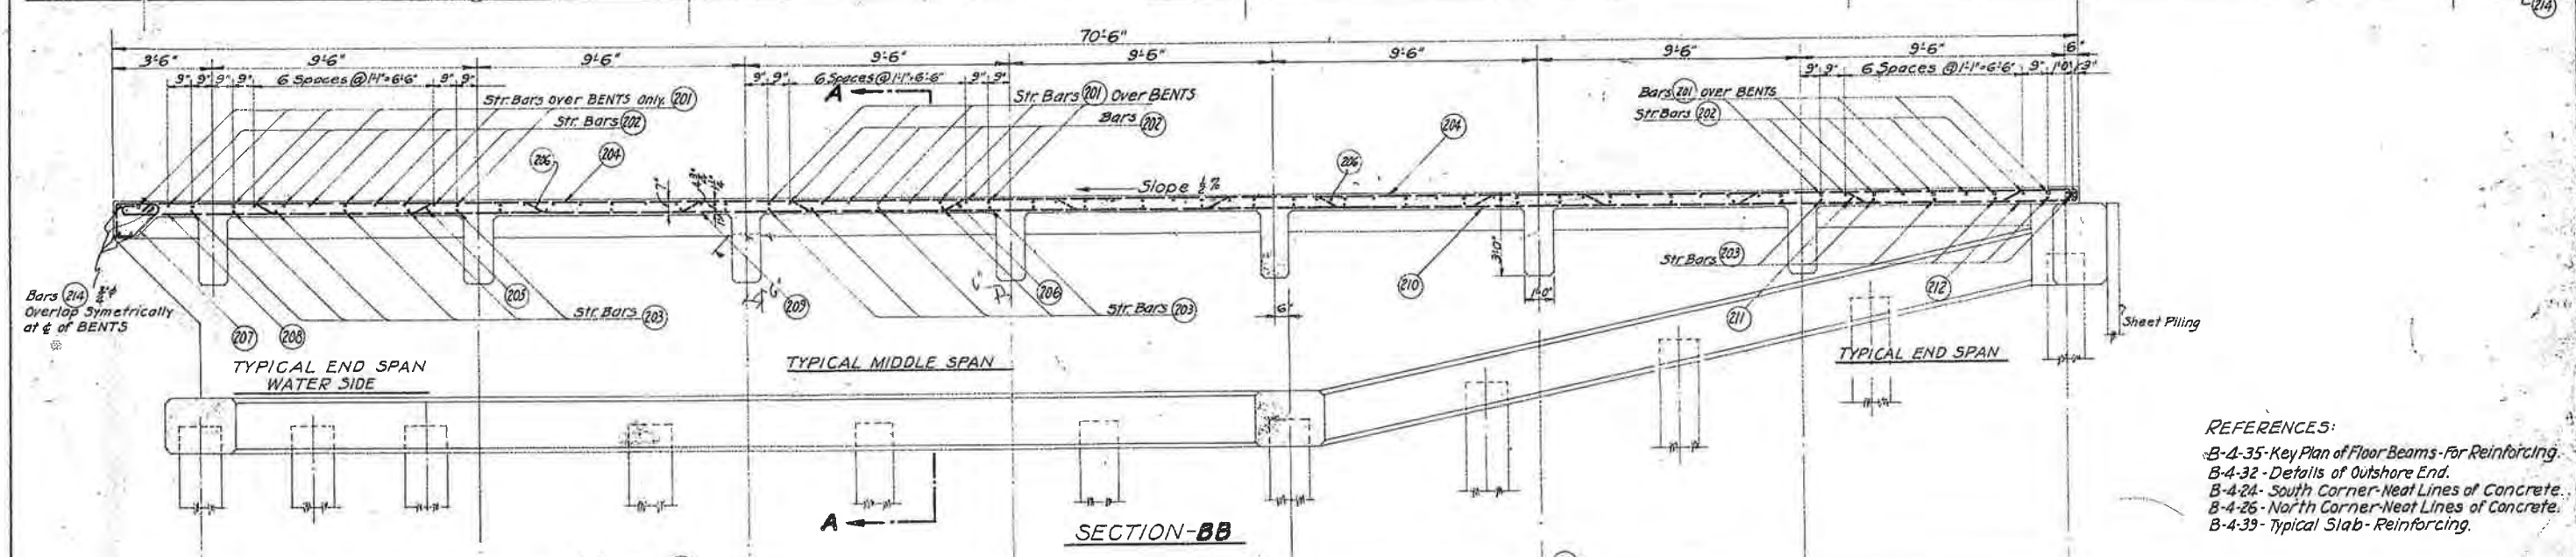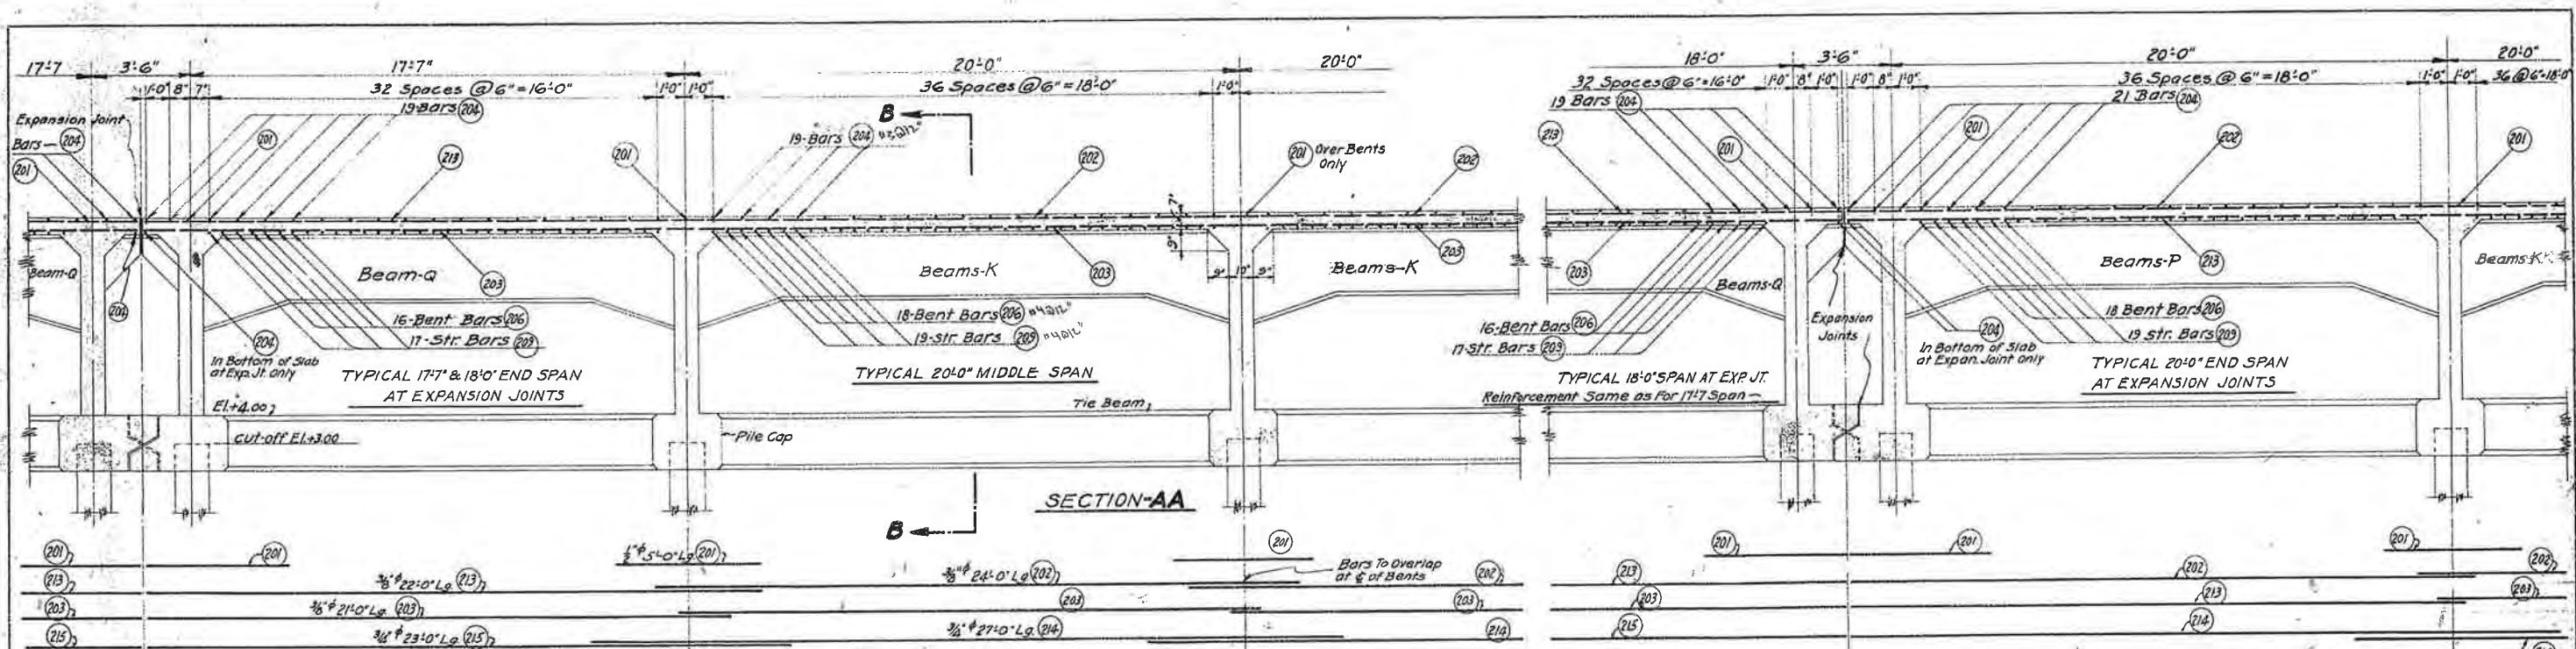

- REFERENCES:
- B-4-35-Key Plan of Floor Beams-For Reinforcing.
  - B-4-32-Details of Outshore End.
  - B-4-24-South Corner-Neat Lines of Concrete.
  - B-4-26-North Corner-Neat Lines of Concrete.
  - B-4-39-Typical Slab-Reinforcing.






ALABAMA  
STATE DOCKS COMMISSION  
MOBILE, ALABAMA

CONCRETE WHARF  
REINFORCING DETAILS  
SLAB AT OUTSHORE END


SCALE: 3/8"=1'-0"  
DATE: Oct. 15, 1925  
REL. REVISIONS:

DRAWN BY Hammons  
TRACED BY  
CHECKED BY  
DESIGNED BY  
APPROVED: Arthur C. Brown  
CHAIRMAN

**B-4-40**

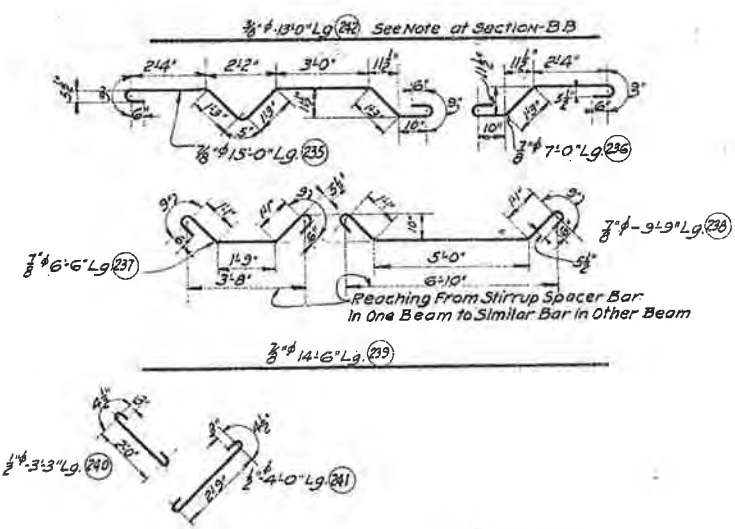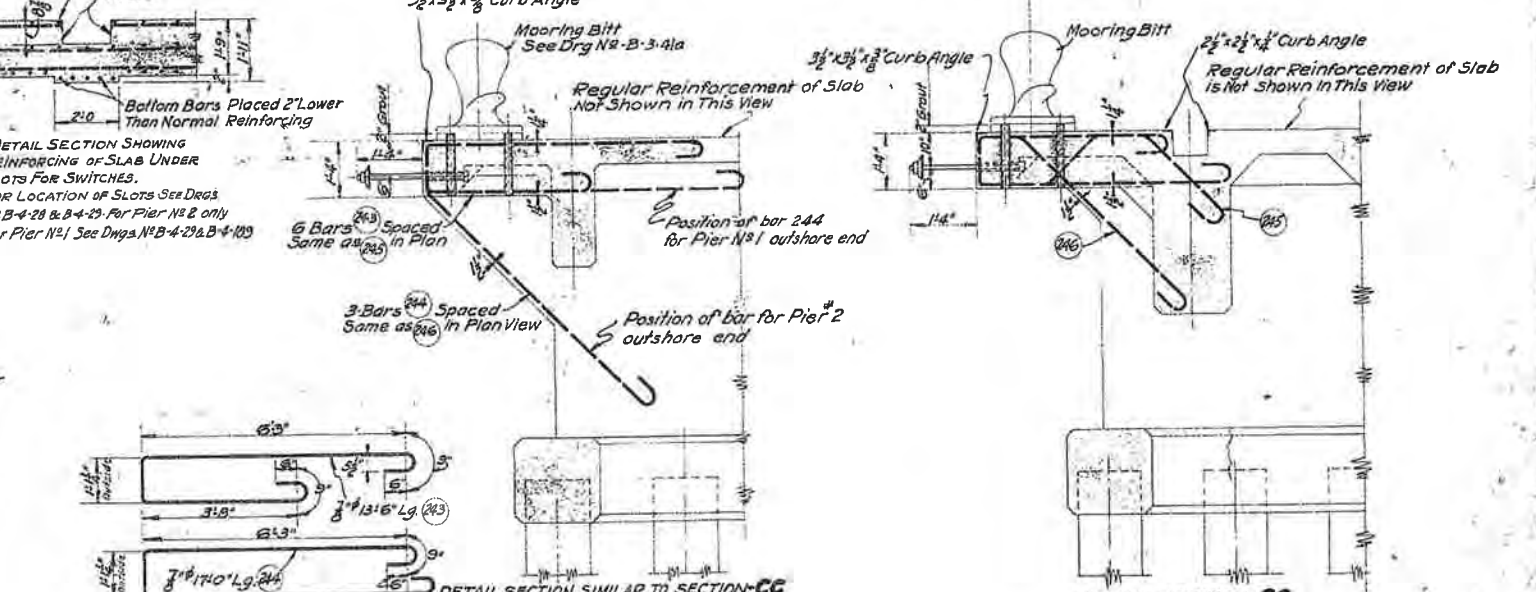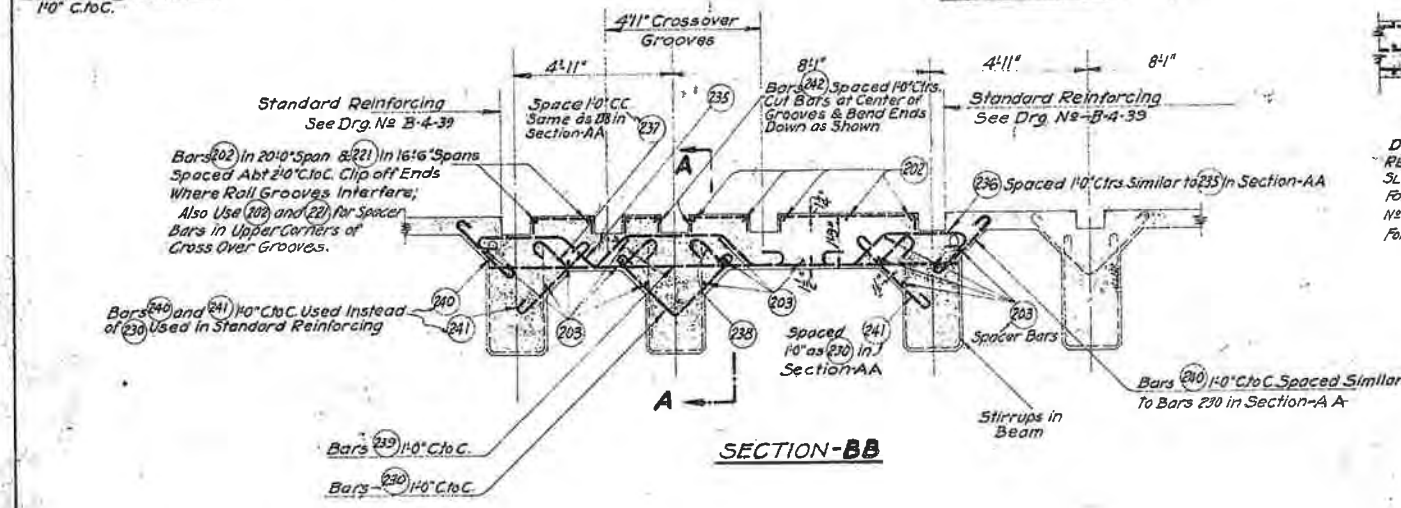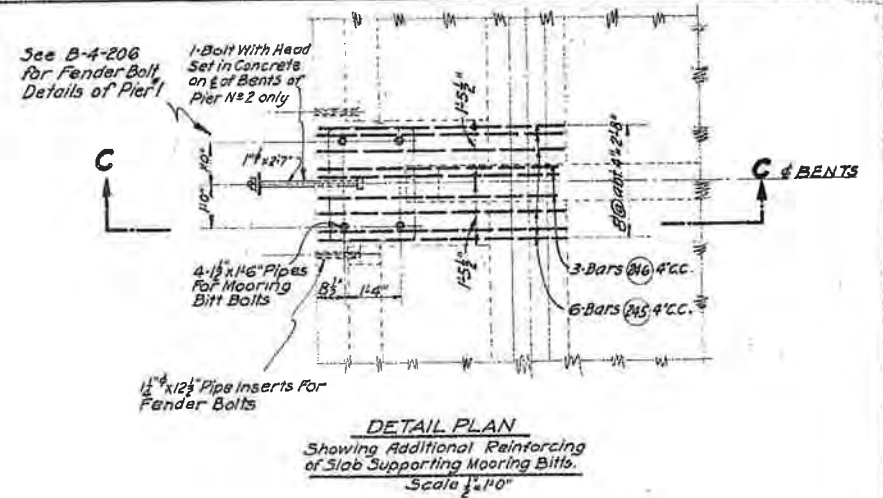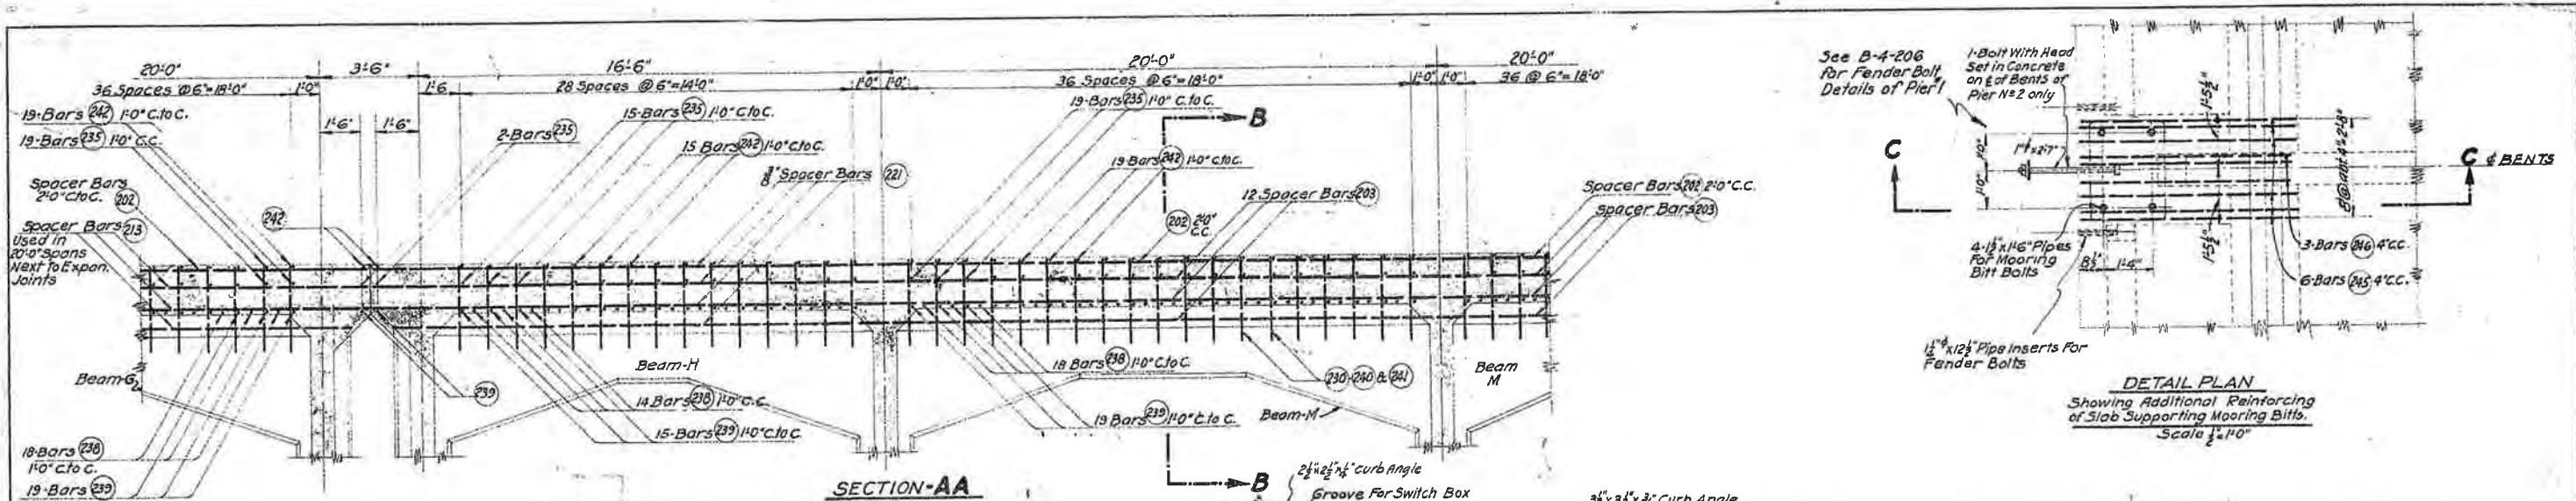

REINFORCING DETAILS OF SLAB AT CROSSOVERS  
See Notes

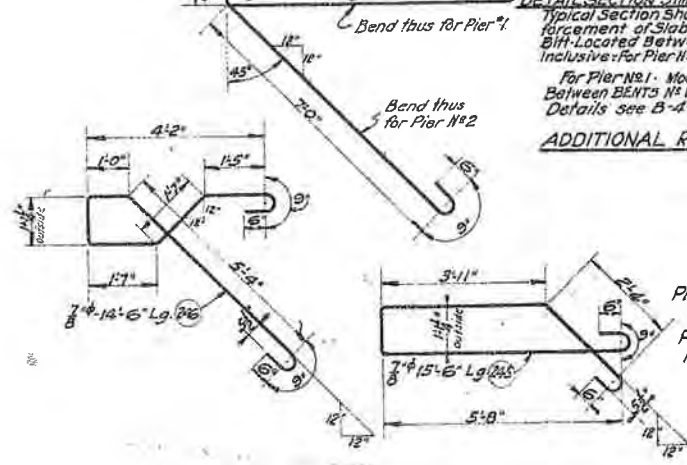

DETAIL SECTION SIMILAR TO SECTION-CC  
Typical Section Showing Special Reinforcing of Slab Supporting Mooring Bits Located Between Bents No. 1 to 115 Inclusive - For Pier No. 2 Only.  
For Pier No. 1 - Mooring Bits Located Between BENTS No. 100 to 116 - Setting Details see B-4-192

DETAIL SECTION-CC  
Typical Section Showing Special Reinforcing of Slab Supporting Mooring Bits Located Between Bents No. 1 to 116 to 137 For Pier No. 2 Only  
Located Between BENTS No. 124 to 139 & No. 126 to 132 For Pier No. 1 Only

NOTES:  
PIER No. 2 - Reinforcement of Slab at Crossovers Between BENTS No. 19 to 34, 46 to 61, 135 to 150 & 165 to 180.  
PIER No. 1 & 2 - Reinforcing Includes Two Spans 4'-11" & 8'-1" Together as Shown in Section-BB, or in Opposite Position as Indicated on Crossover-General Layout - Reinforcing Similar For Both Positions.  
For Details of Bars (202) (203) (213) (221) & (230) See Drg. No. B-4-39

- REFERENCES:  
FOR PIER No. 2 - B-4-35 Key Plan of Floor Beams for Reinforcing  
B-4-28 Crossover-General Layout  
B-4-39 - Typical Slab-Reinforcing  
B-4-29 Crossover-Location of Anchor Bolts  
B-3-41 - Mooring Bit Detail  
FOR PIER No. 1  
B-4-190 Key Plan of Floor Beams for Reinforcing  
B-4-189 - Crossover-General Layout  
B-4-187 & 188 - Location of Mooring Bits  
B-4-192 - Setting Details of Mooring Bits

This Dwg. Revised Jan. 9, 1926  
Revised - June 1, 1926 - for Pier No. 1  
Revised Dec. 6, 1926 - for Pier No. 1

PIER No. 1 - Cross-Overs are Located Between BENTS No. 135 to 150 & No. 163 to 178  
Dimensions on Bars are to center lines except as noted

This Drawing Used for Piers No. 1 & 2


ALABAMA  
STATE DOCKS COMMISSION  
MOBILE, ALABAMA.

CONCRETE WHARF  
REINFORCING DETAILS  
SLAB UNDER CROSSOVERS & MOORING BITS

SCALE: 1/2" = 1'-0"  
DATE: Oct. 15, 1925  
RECOMMENDED:

DRAWN BY: Hammond  
TRACED BY:  
CHECKED BY: J. S. P. [Signature]  
DESIGNING ENGINEER: Arthur L. [Signature]  
APPROVED: [Signature] CHAIRMAN

**B-4-41**

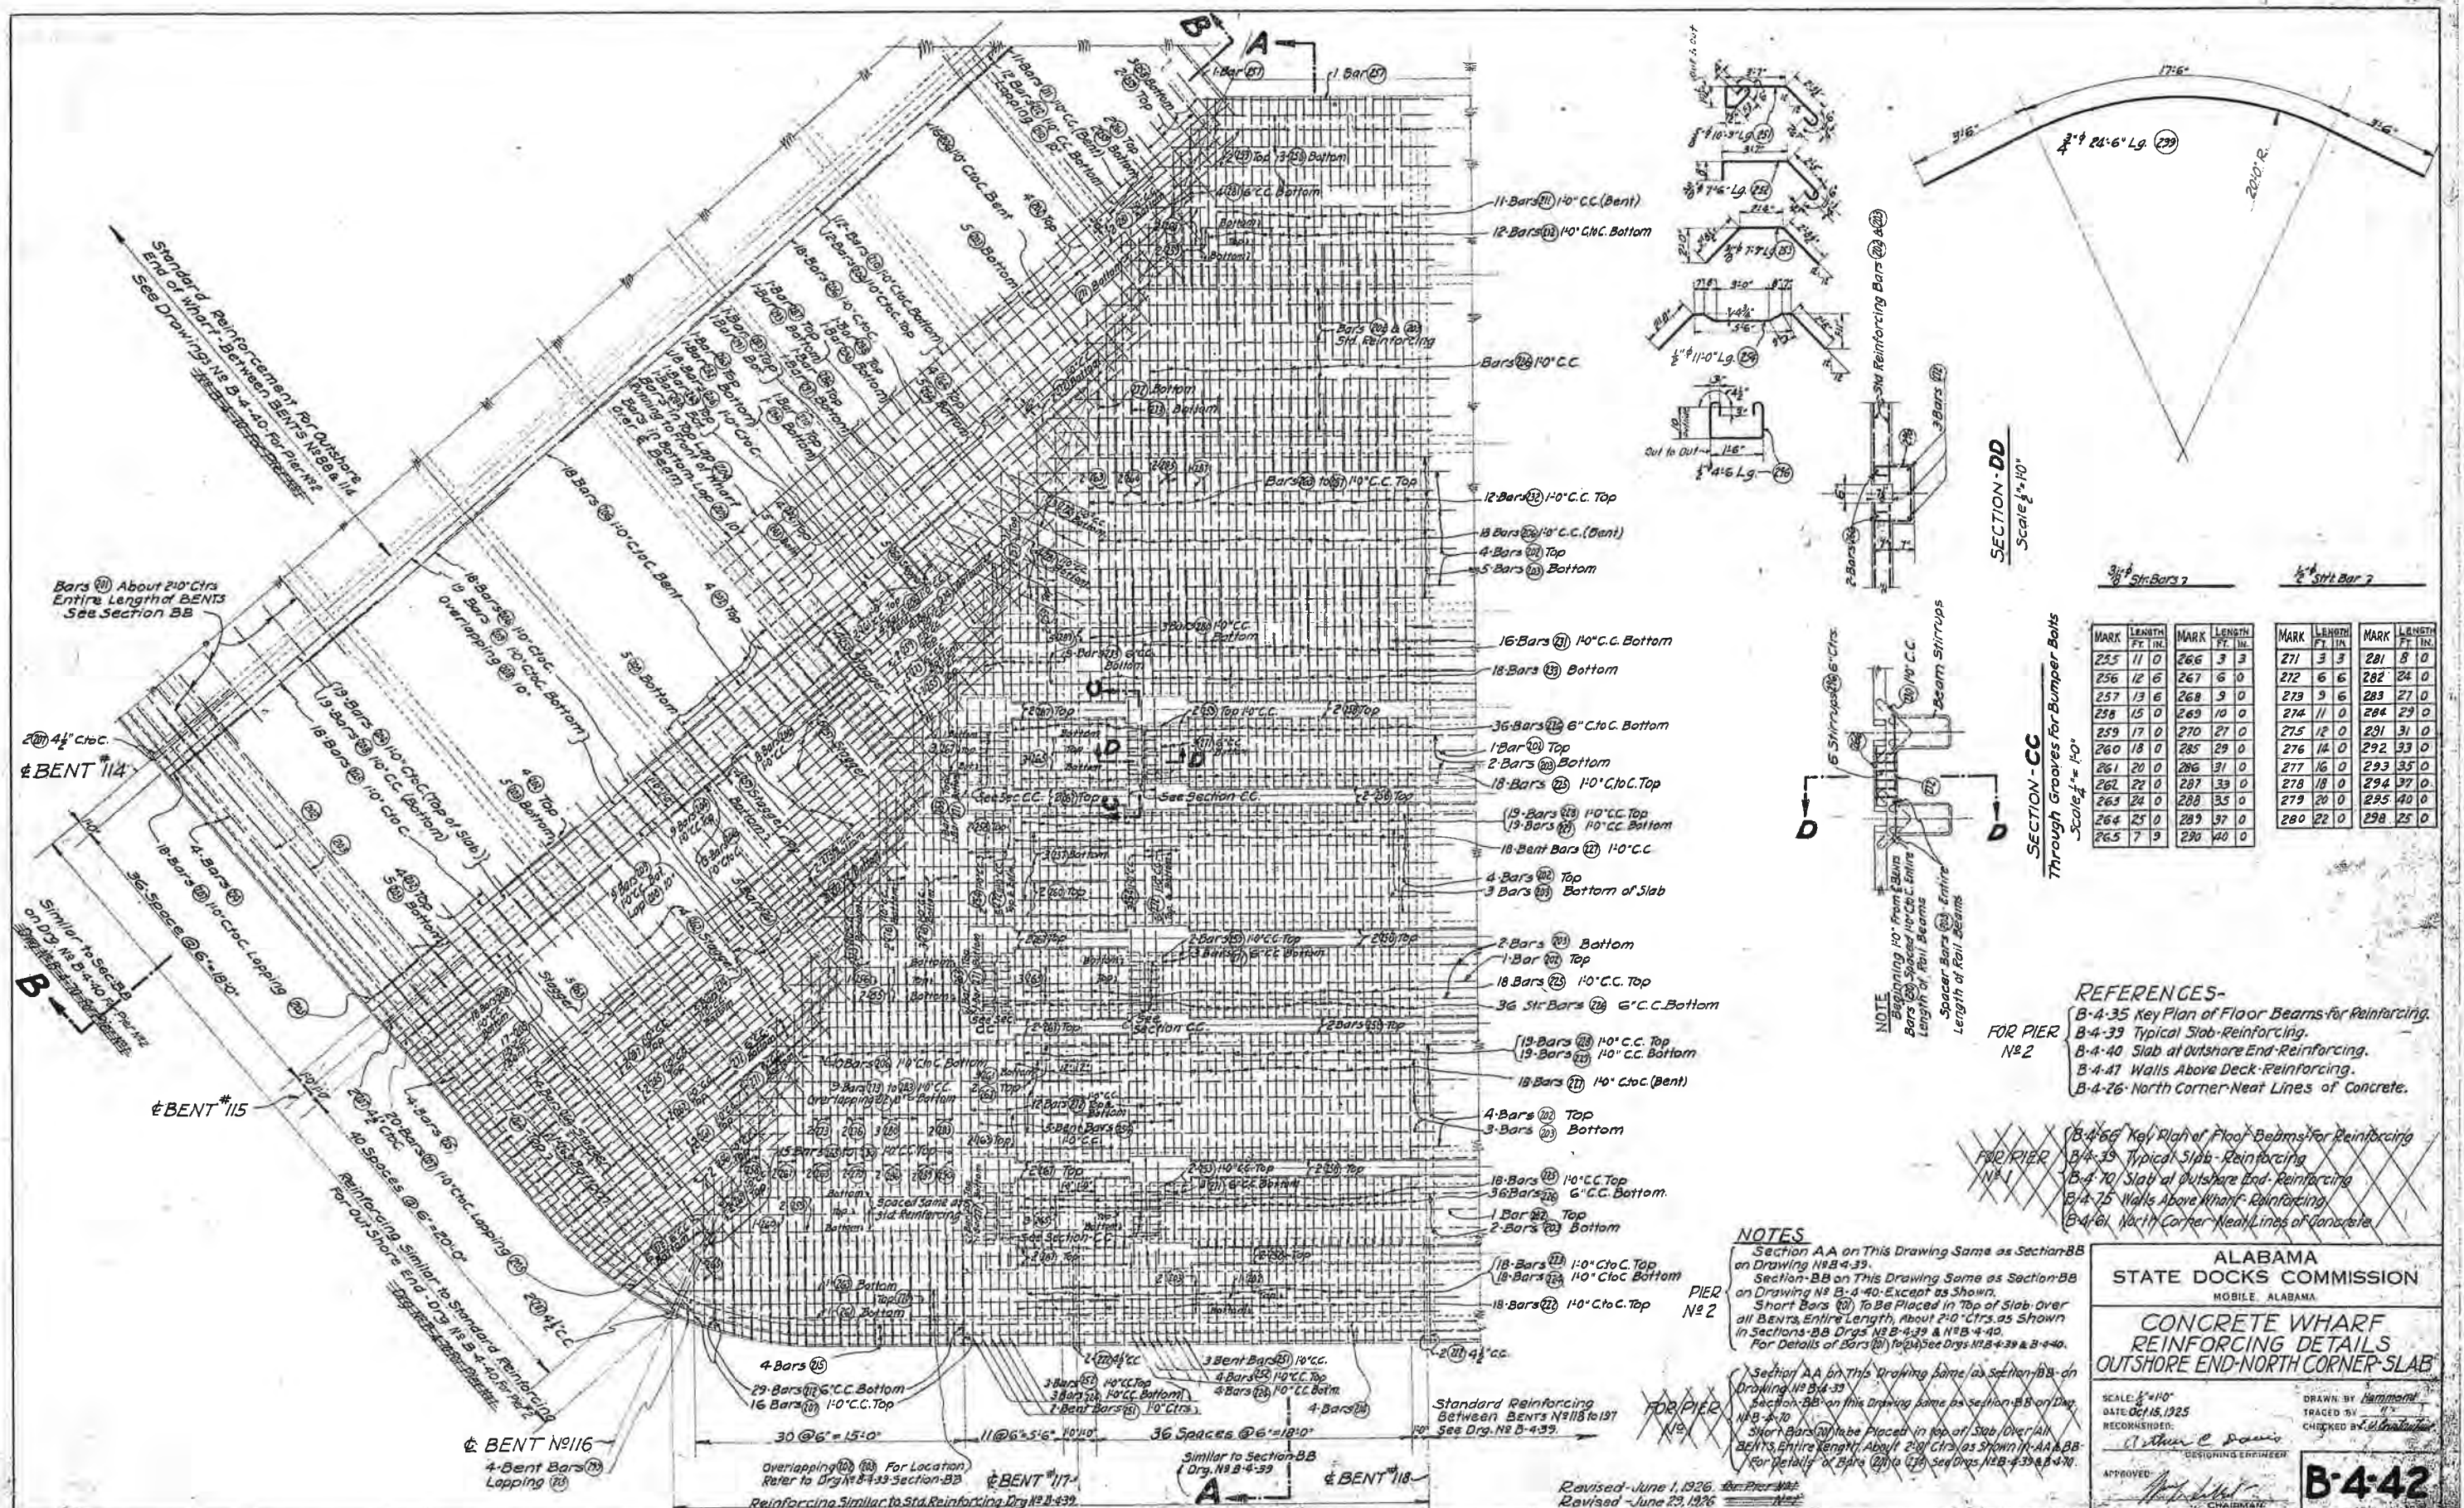

Standard Reinforcement For Outshore End of Wharf - Between BENTS No 88 & 114 See Drawing No B-4-40 For Pier No 2

Bars (11) About 2'0" Ctrs Entire Length of BENTS See Section BB


2 @ 4 1/2" Ctr. BENT #114

BENT #115


BENT #116  
4 Bent Bars (11) Lapping (11)

BENT #117

BENT #118

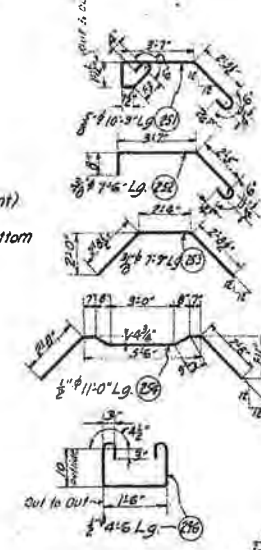

SECTION-DD  
Scale 1/4" = 1'-0"

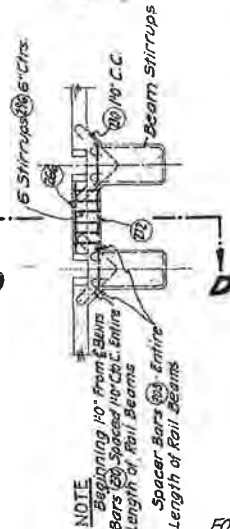

SECTION-CC  
Through Grooves for Bumper Bolts  
Scale 1/4" = 1'-0"

MARK	LENGTH FT. IN.	MARK	LENGTH FT. IN.	MARK	LENGTH FT. IN.	MARK	LENGTH FT. IN.
225	11 0	266	3 3	271	3 3	281	5 0
256	12 6	267	6 0	272	6 6	282	24 0
257	13 6	268	9 0	273	9 6	283	27 0
258	15 0	269	10 0	274	11 0	284	29 0
259	17 0	270	27 0	275	12 0	285	31 0
260	18 0	285	29 0	276	14 0	292	33 0
261	20 0	286	31 0	277	16 0	293	35 0
262	22 0	287	33 0	278	18 0	294	37 0
263	24 0	288	35 0	279	20 0	295	40 0
264	25 0	289	37 0	280	22 0	298	25 0
265	7 9	290	40 0				

REFERENCES-  
B-4-35 Key Plan of Floor Beams for Reinforcing.  
B-4-39 Typical Slab Reinforcing.  
B-4-40 Slab at Outshore End Reinforcing.  
B-4-41 Walls Above Deck Reinforcing.  
B-4-26 North Corner Neat Lines of Concrete.

B-4-66 Key Plan of Floor Beams for Reinforcing  
B-4-39 Typical Slab Reinforcing  
B-4-70 Slab at Outshore End Reinforcing  
B-4-75 Walls Above Wharf Reinforcing  
B-4-61 North Corner Neat Lines of Concrete

NOTES  
Section AA on This Drawing Same as Section BB on Drawing No B-4-39.  
Section BB on This Drawing Same as Section BB on Drawing No B-4-40: Except as Shown.  
Short Bars (11) To Be Placed in Top of Slab Over all BENTS Entire Length, About 2'-0" Ctrs as Shown in Sections BB Drgs No B-4-39 & B-4-40.  
For Details of Bars (11) See Drgs No B-4-39 & B-4-40.

Section AA on This Drawing Same as Section BB on Drawing No B-4-39.  
Section BB on This Drawing Same as Section BB on Drawing No B-4-40.  
Short Bars (11) To Be Placed in Top of Slab Over all BENTS Entire Length, About 2'-0" Ctrs as Shown in AA & BB For Details of Bars (11) See Drgs No B-4-39 & B-4-40.

Standard Reinforcing BETWEEN BENTS No 118 to 191 See Drg. No B-4-39.


Revised June 1, 1926.  
Revised June 23, 1926.

ALABAMA  
STATE DOCKS COMMISSION  
MOBILE, ALABAMA

CONCRETE WHARF  
REINFORCING DETAILS  
OUTSHORE END-NORTH CORNER SLAB

SCALE: 1/4" = 1'-0"  
DATE: Oct 15, 1925  
RECOMMENDED:  
DRAWN BY: Hammond  
TRACED BY:  
CHECKED BY:  
APPROVED:  
CHAIRMAN

B-4-42

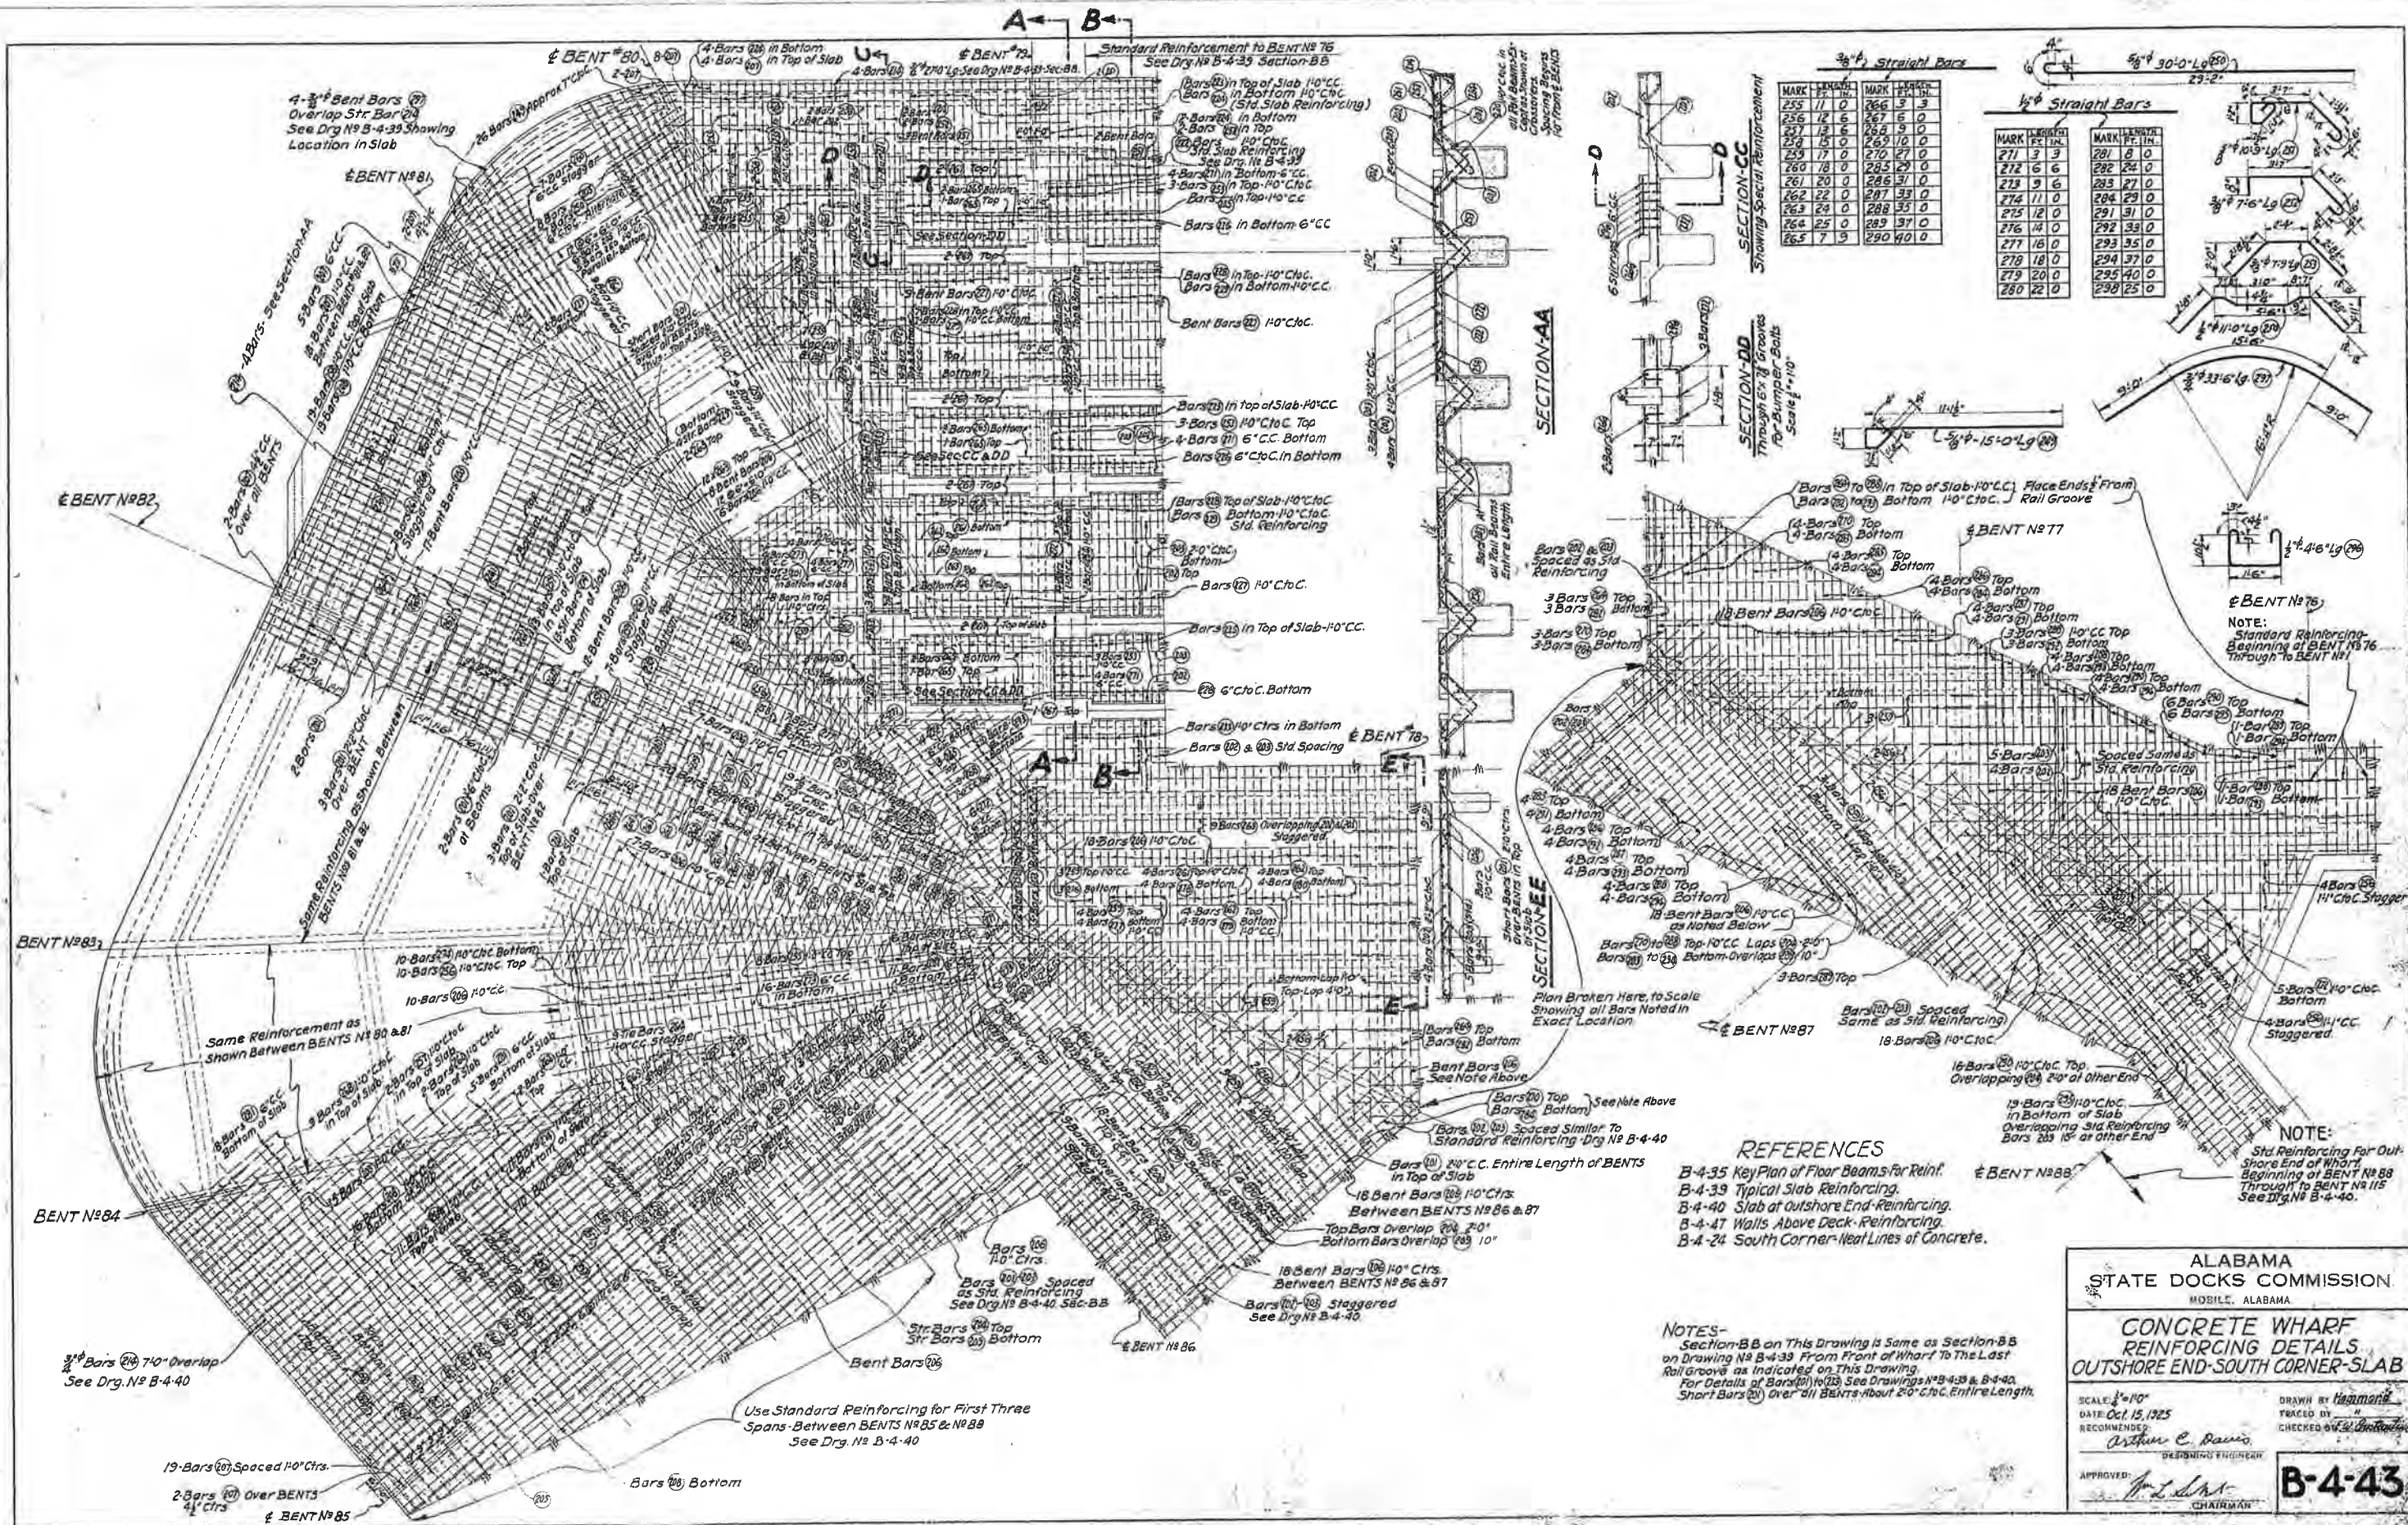

3/8" Straight Bars

MARK	LENGTH	MARK	LENGTH
255	11 0	266	3 0
256	12 6	267	5 0
257	13 6	268	9 0
258	15 0	269	10 0
259	17 0	270	27 0
260	18 0	283	29 0
261	20 0	286	31 0
262	22 0	287	33 0
263	24 0	288	35 0
264	25 0	289	37 0
265	7 3	290	40 0

1/2" Straight Bars

MARK	LENGTH	MARK	LENGTH
271	3 3	281	8 0
272	6 6	282	24 0
273	9 6	283	27 0
274	11 0	284	29 0
275	12 0	289	31 0
276	14 0	292	33 0
277	16 0	293	35 0
278	18 0	294	37 0
279	20 0	295	40 0
280	22 0	298	25 0

SECTION-CC  
Showing Special Reinforcement  
Through 6" Grooves  
for Bumper Bolts  
Scale 1"=10"

SECTION-DD  
Through 6" Grooves  
for Bumper Bolts  
Scale 1"=10"

SECTION-EE  
Scale 1"=10"

SECTION-FF  
Scale 1"=10"

SECTION-AA  
Scale 1"=10"

SECTION-BB  
Scale 1"=10"

SECTION-GG  
Scale 1"=10"

SECTION-HH  
Scale 1"=10"

- REFERENCES
- B-4-35 Key Plan of Floor Beams for Reint.
  - B-4-39 Typical Slab Reinforcing.
  - B-4-40 Slab at Outshore End Reinforcing.
  - B-4-47 Walls Above Deck Reinforcing.
  - B-4-24 South Corner-Neat Lines of Concrete.

NOTES-

- Section-BB on this Drawing is Same as Section-BB on Drawing N-8-4-39 From Front of Wharf To the Last Rail Groove as Indicated on this Drawing.
- For Details of Bars (1) (2) See Drawings N-8-4-39 & B-4-40.
- Short Bars (3) Over all Beams about 20" c/c Entire Length.

ALABAMA  
STATE DOCKS COMMISSION  
MOBILE, ALABAMA

CONCRETE WHARF  
REINFORCING DETAILS  
OUTSHORE END-SOUTH CORNER-SLAB

SCALE: 1"=10"  
DATE: Oct. 15, 1925  
RECOMMENDED:  
Arthur C. Davis  
DESIGNING ENGINEER

DRAWN BY: H. Hamman  
TRACED BY: H. Hamman  
CHECKED BY: J. L. Smith  
CHAIRMAN

APPROVED:  
J. L. Smith  
CHAIRMAN

**B-4-43**

NOTE:  
Standard Reinforcing  
Beginning at BENT #86  
Through to BENT #88

NOTE:  
Std. Reinforcing For Out-  
shore End of Wharf  
Beginning at BENT #88  
Through to BENT #115  
See Drg. N-8-4-40.

Use Standard Reinforcing for First Three  
Spans Between BENTS #85 & #88  
See Drg. N-8-4-40

3/8" Bars (2) 7'-0" Overlap  
See Drg. N-8-4-40

19-Bars (2) Spaced 10" Ctrs.  
2-Bars (2) Over BENTS  
4' Ctrs  
BENT #85

BENT #82

BENT #83

BENT #84

4-3/8" Bent Bars (2)  
Overlap Str Bar (2)  
See Drg. N-8-4-39 Showing  
Location in Slab

BENT #81

A-Bars (2) See Section AA

5-Bars (2) 10" C.C.

13-Bars (2) 10" C.C.

15-Bars (2) 10" C.C.

17-Bars (2) 10" C.C.

89-Bars (2) 10" C.C.

26-Bars (2) Approx. 7' C.C.

28-Bars (2) 10" C.C.

30-Bars (2) 10" C.C.

32-Bars (2) 10" C.C.

114-Bars (2) 10" C.C.

4-Bars (2) in Bottom

4-Bars (2) in Top of Slab

4-Bars (2) 2' 7 1/2" Lg. See Drg. N-8-4-39 Sec. B-B

4-Bars (2) in Bottom

4-Bars (2) in Top of Slab

4-Bars (2) in Bottom

4-Bars (2) in Top of Slab

4-Bars (2) in Bottom

4-Bars (2) in Bottom

4-Bars (2) in Top of Slab

4-Bars (2) in Bottom

4-Bars (2) in Top of Slab




4-Bars (2) in Bottom

4-Bars (2) in Top of Slab

4-Bars (2) in Bottom

4-Bars (2) in Top of Slab



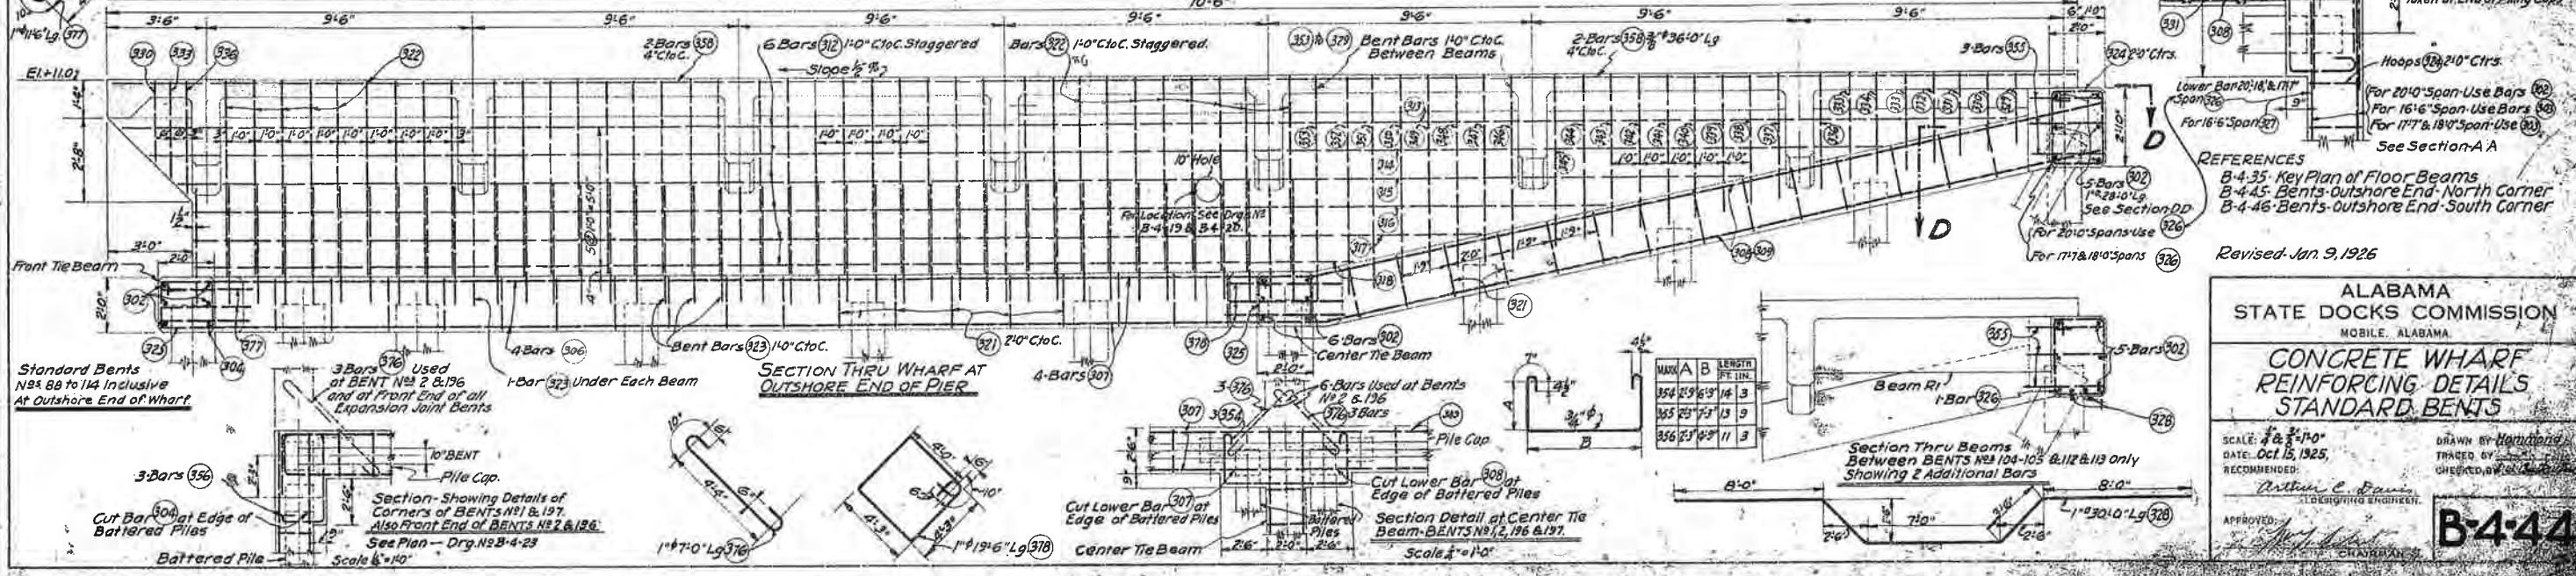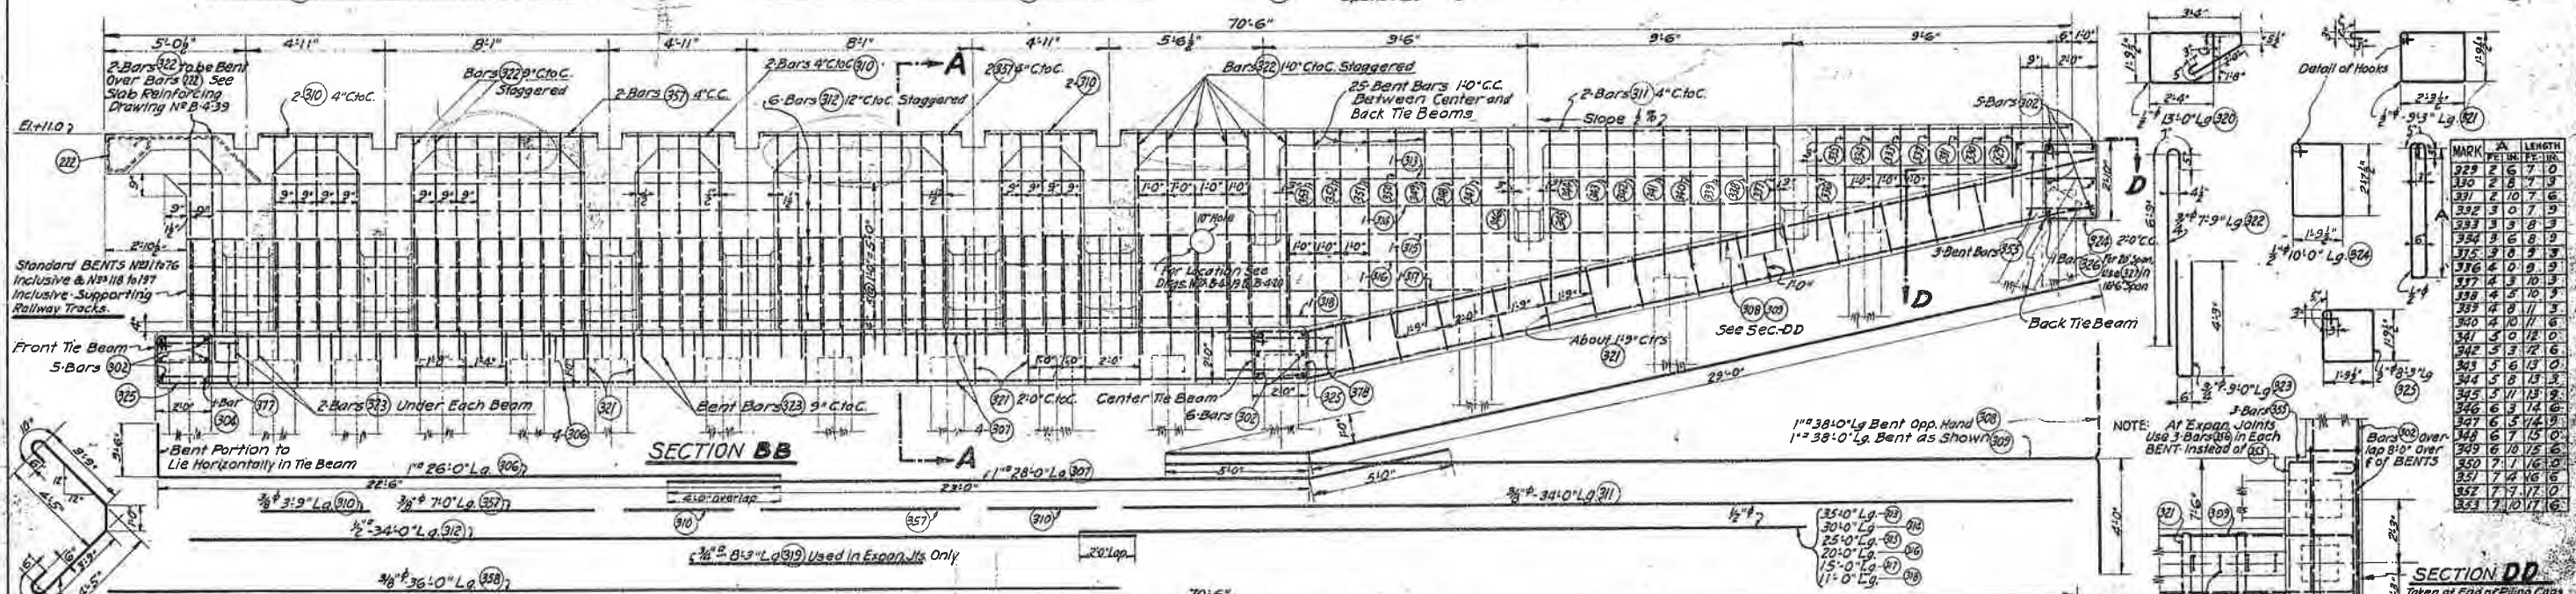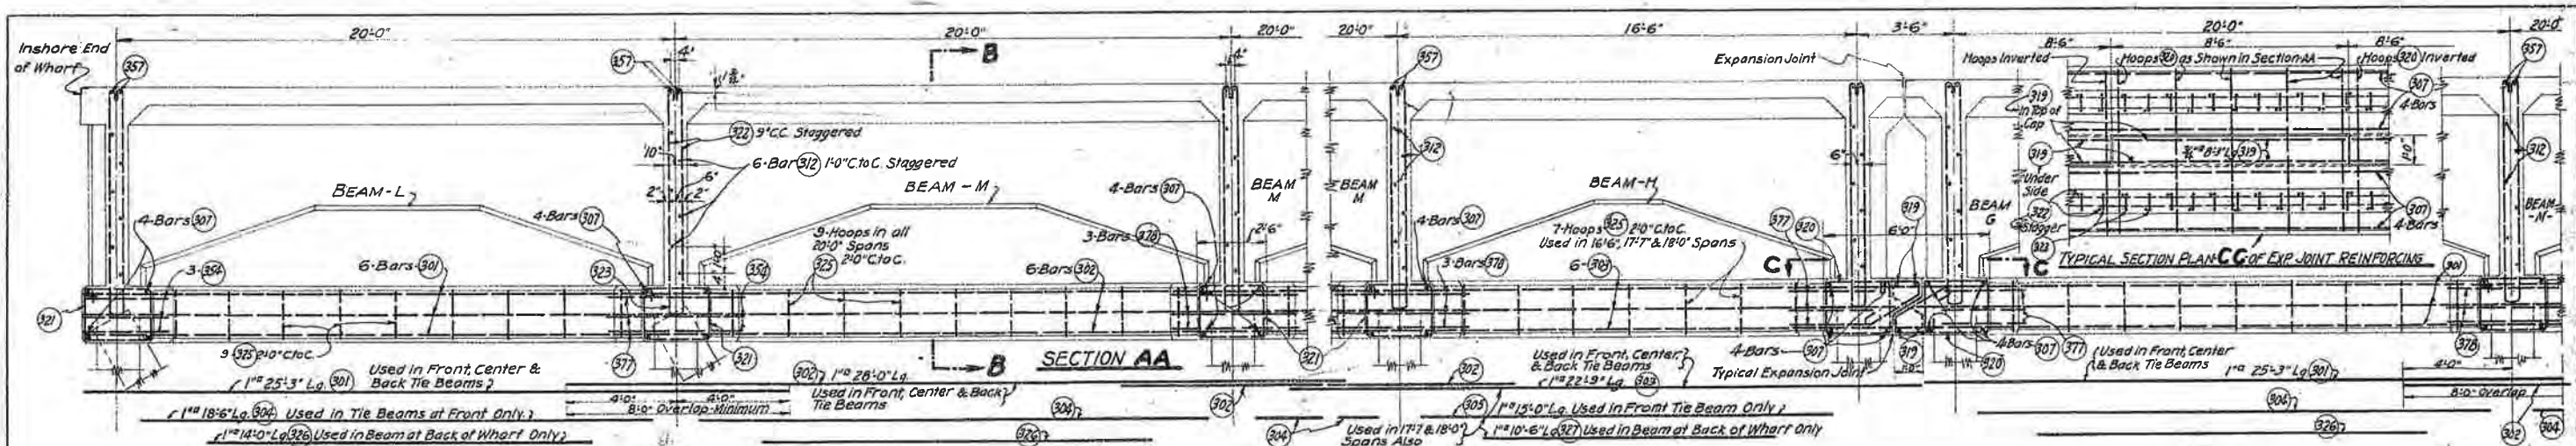

MARK	A	LENGTH	PERIOD
322	2	6	7
323	2	8	7
324	2	10	7
325	3	0	7
326	3	6	8
327	4	0	9
328	4	3	10
329	4	5	10
330	4	10	11
331	3	0	12
332	3	3	12
333	3	6	13
334	3	8	13
335	3	11	13
336	6	3	14
337	6	5	14
338	6	7	15
339	6	10	15
340	7	1	16
341	7	4	16
342	7	7	17
343	7	10	17
344	7	13	17


ALABAMA  
 STATE DOCKS COMMISSION  
 MOBILE, ALABAMA

**CONCRETE WHARF  
 REINFORCING DETAILS  
 STANDARD BENTS**

SCALE: 3/8" = 1'-0"  
 DATE: Oct 15, 1925  
 RECOMMENDED:  
 Arthur C. Davis  
 DESIGNING ENGINEER

APPROVED:  
 [Signature]  
 CHAIRMAN

**B-444**

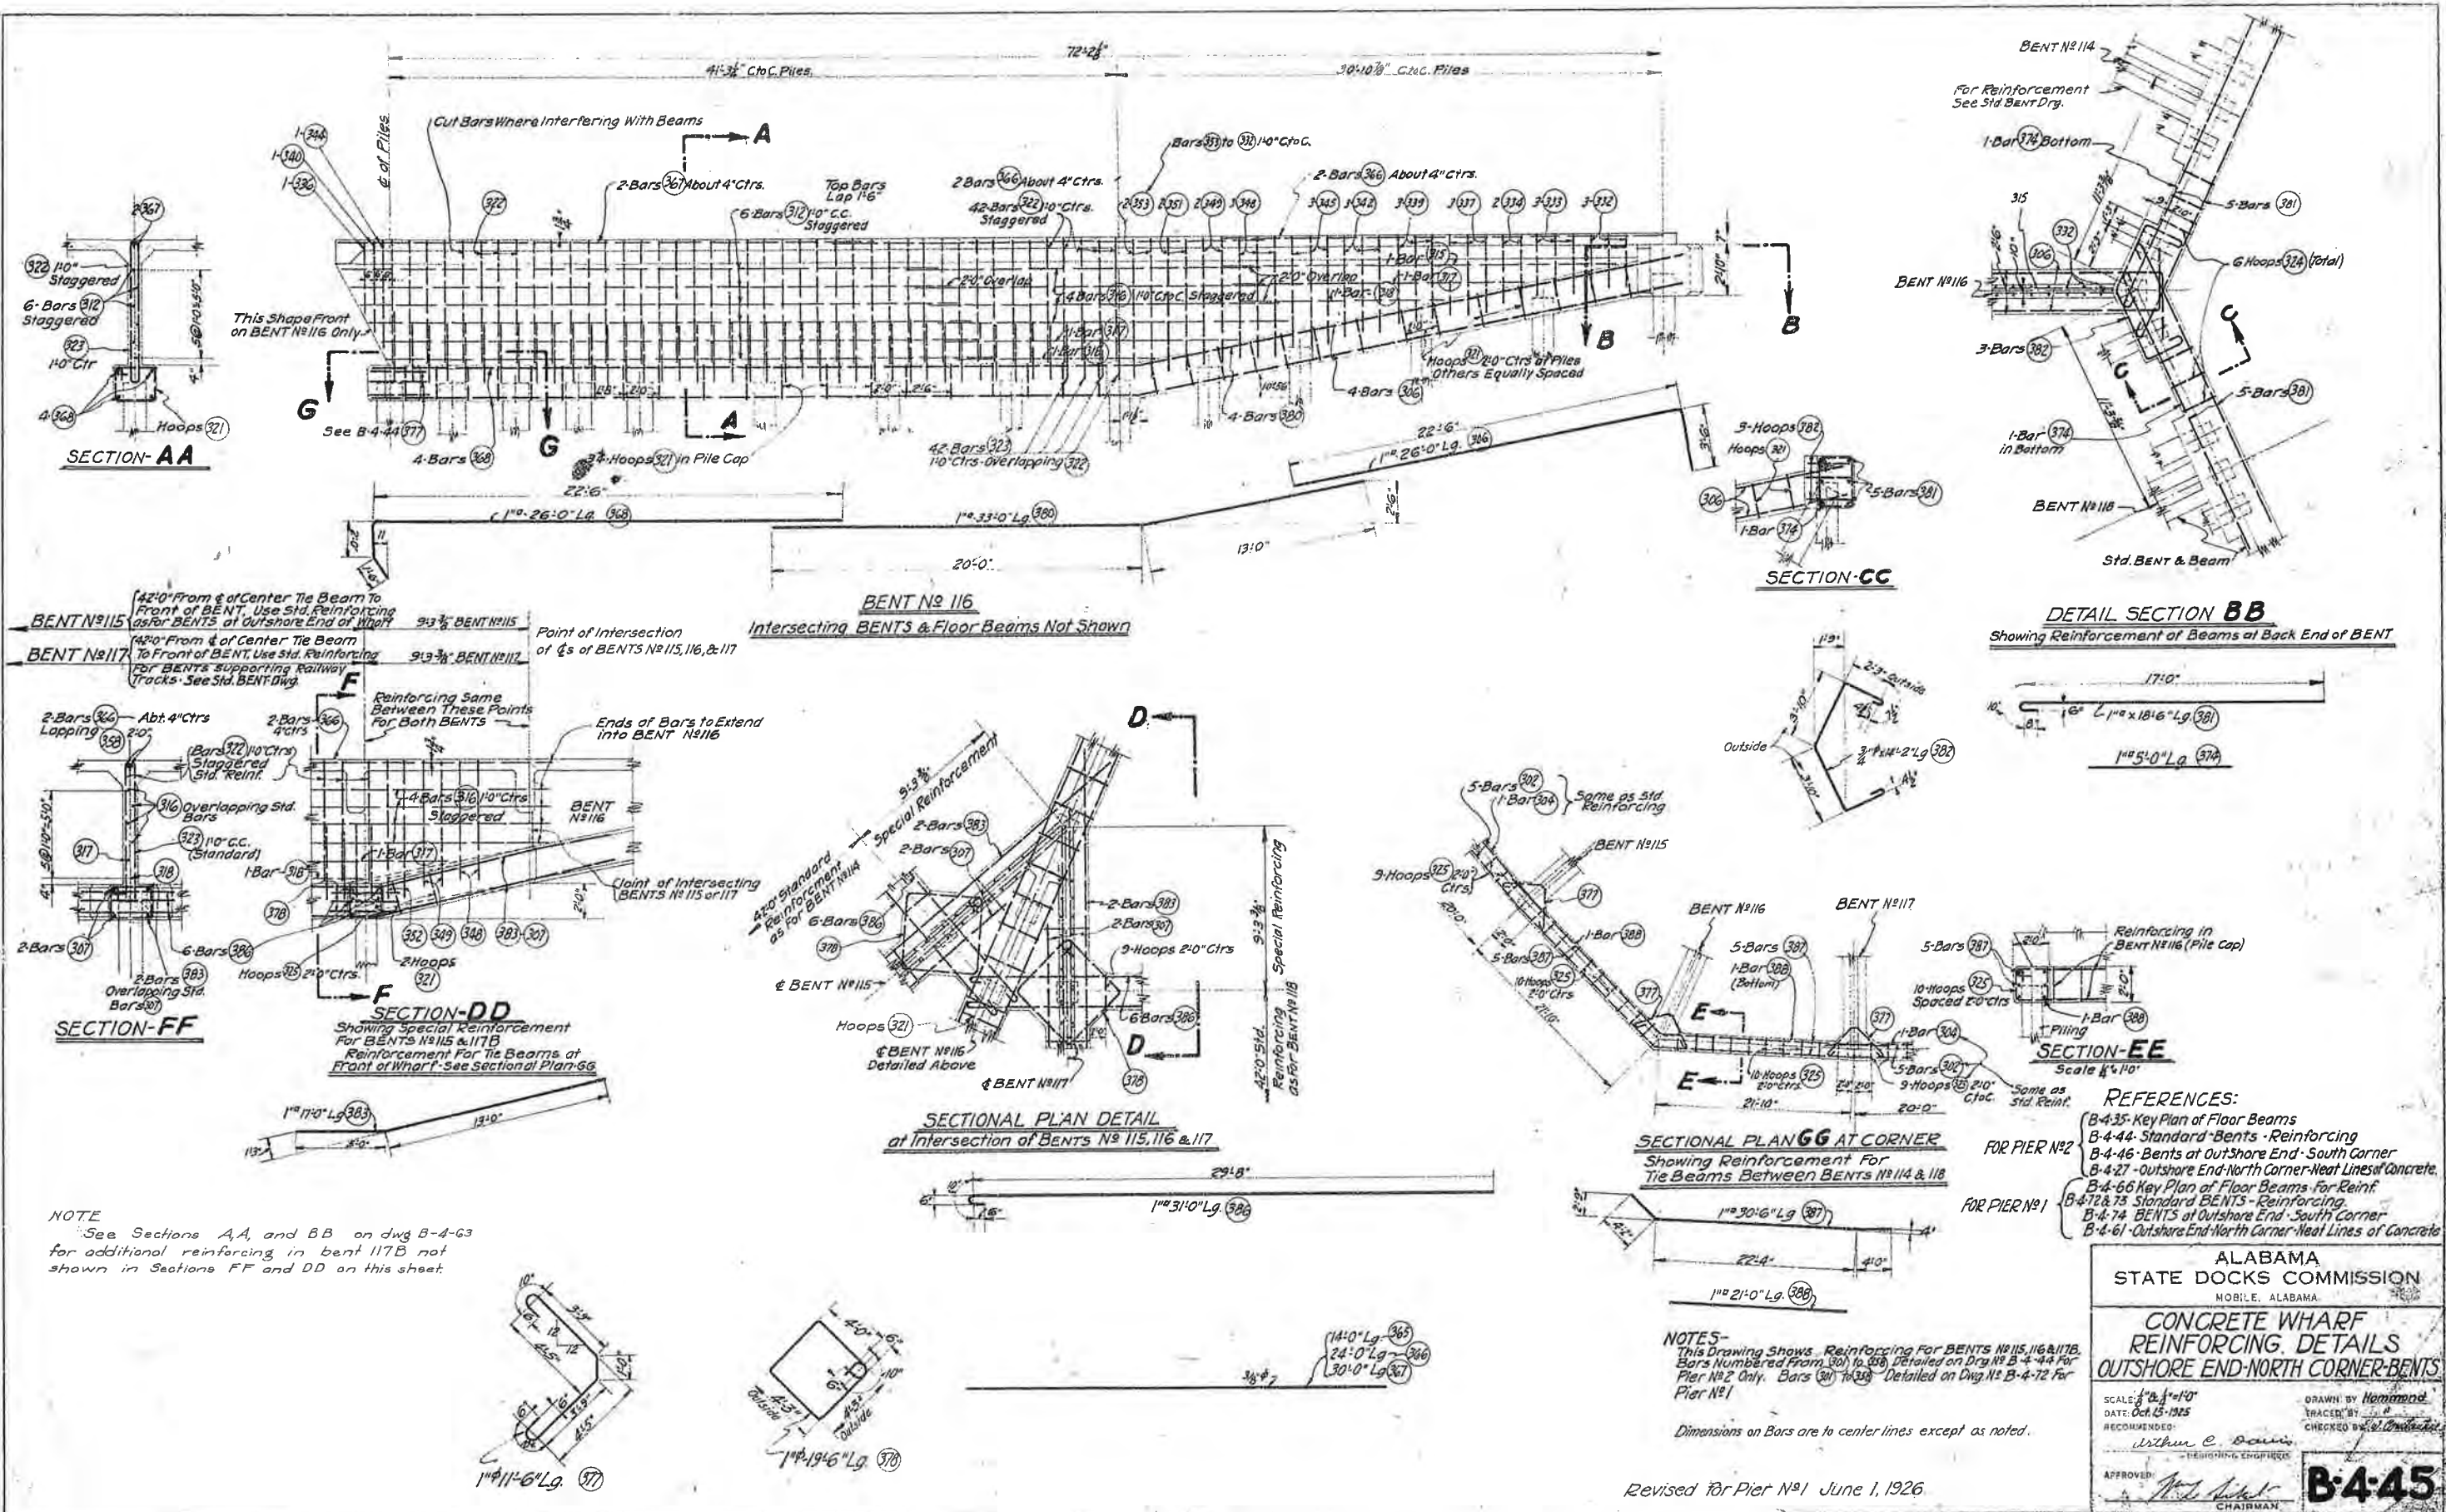

NOTE  
See Sections A, A, and B, B on dwg B-4-63 for additional reinforcing in bent 117B not shown in Sections F, F and D, D on this sheet

- REFERENCES:
- B-4-35 Key Plan of Floor Beams
  - B-4-44 Standard Bents - Reinforcing
  - B-4-46 Bents at Outshore End - South Corner
  - B-4-27 Outshore End-North Corner-Neat Lines of Concrete
  - B-4-66 Key Plan of Floor Beams For Reinf
  - B-4-72 & 73 Standard BENTS - Reinforcing
  - B-4-74 BENTS at Outshore End - South Corner
  - B-4-61 Outshore End-North Corner-Neat Lines of Concrete

ALABAMA  
STATE DOCKS COMMISSION  
MOBILE, ALABAMA

CONCRETE WHARF  
REINFORCING DETAILS  
OUTSHORE END-NORTH CORNER-BENTS


SCALE: 1/4" = 1'-0"  
DATE: Oct. 15-1925  
RECOMMENDED:  
DRAWN BY: Hemmond  
TRACED BY:  
CHECKED BY:  
APPROVED: *William C. Davis*  
ENGINEERING  
CHAIRMAN

**B-4-45**

NOTES-  
This Drawing Shows Reinforcing For BENTS 115, 116 & 117B. Bars Numbered From 301 to 359 Detailed on Dwg. B-4-44 For Pier No 2 Only. Bars 360 to 369 Detailed on Dwg. B-4-72 For Pier No 1

Dimensions on Bars are to center lines except as noted.

Revised for Pier No 1 June 1, 1926

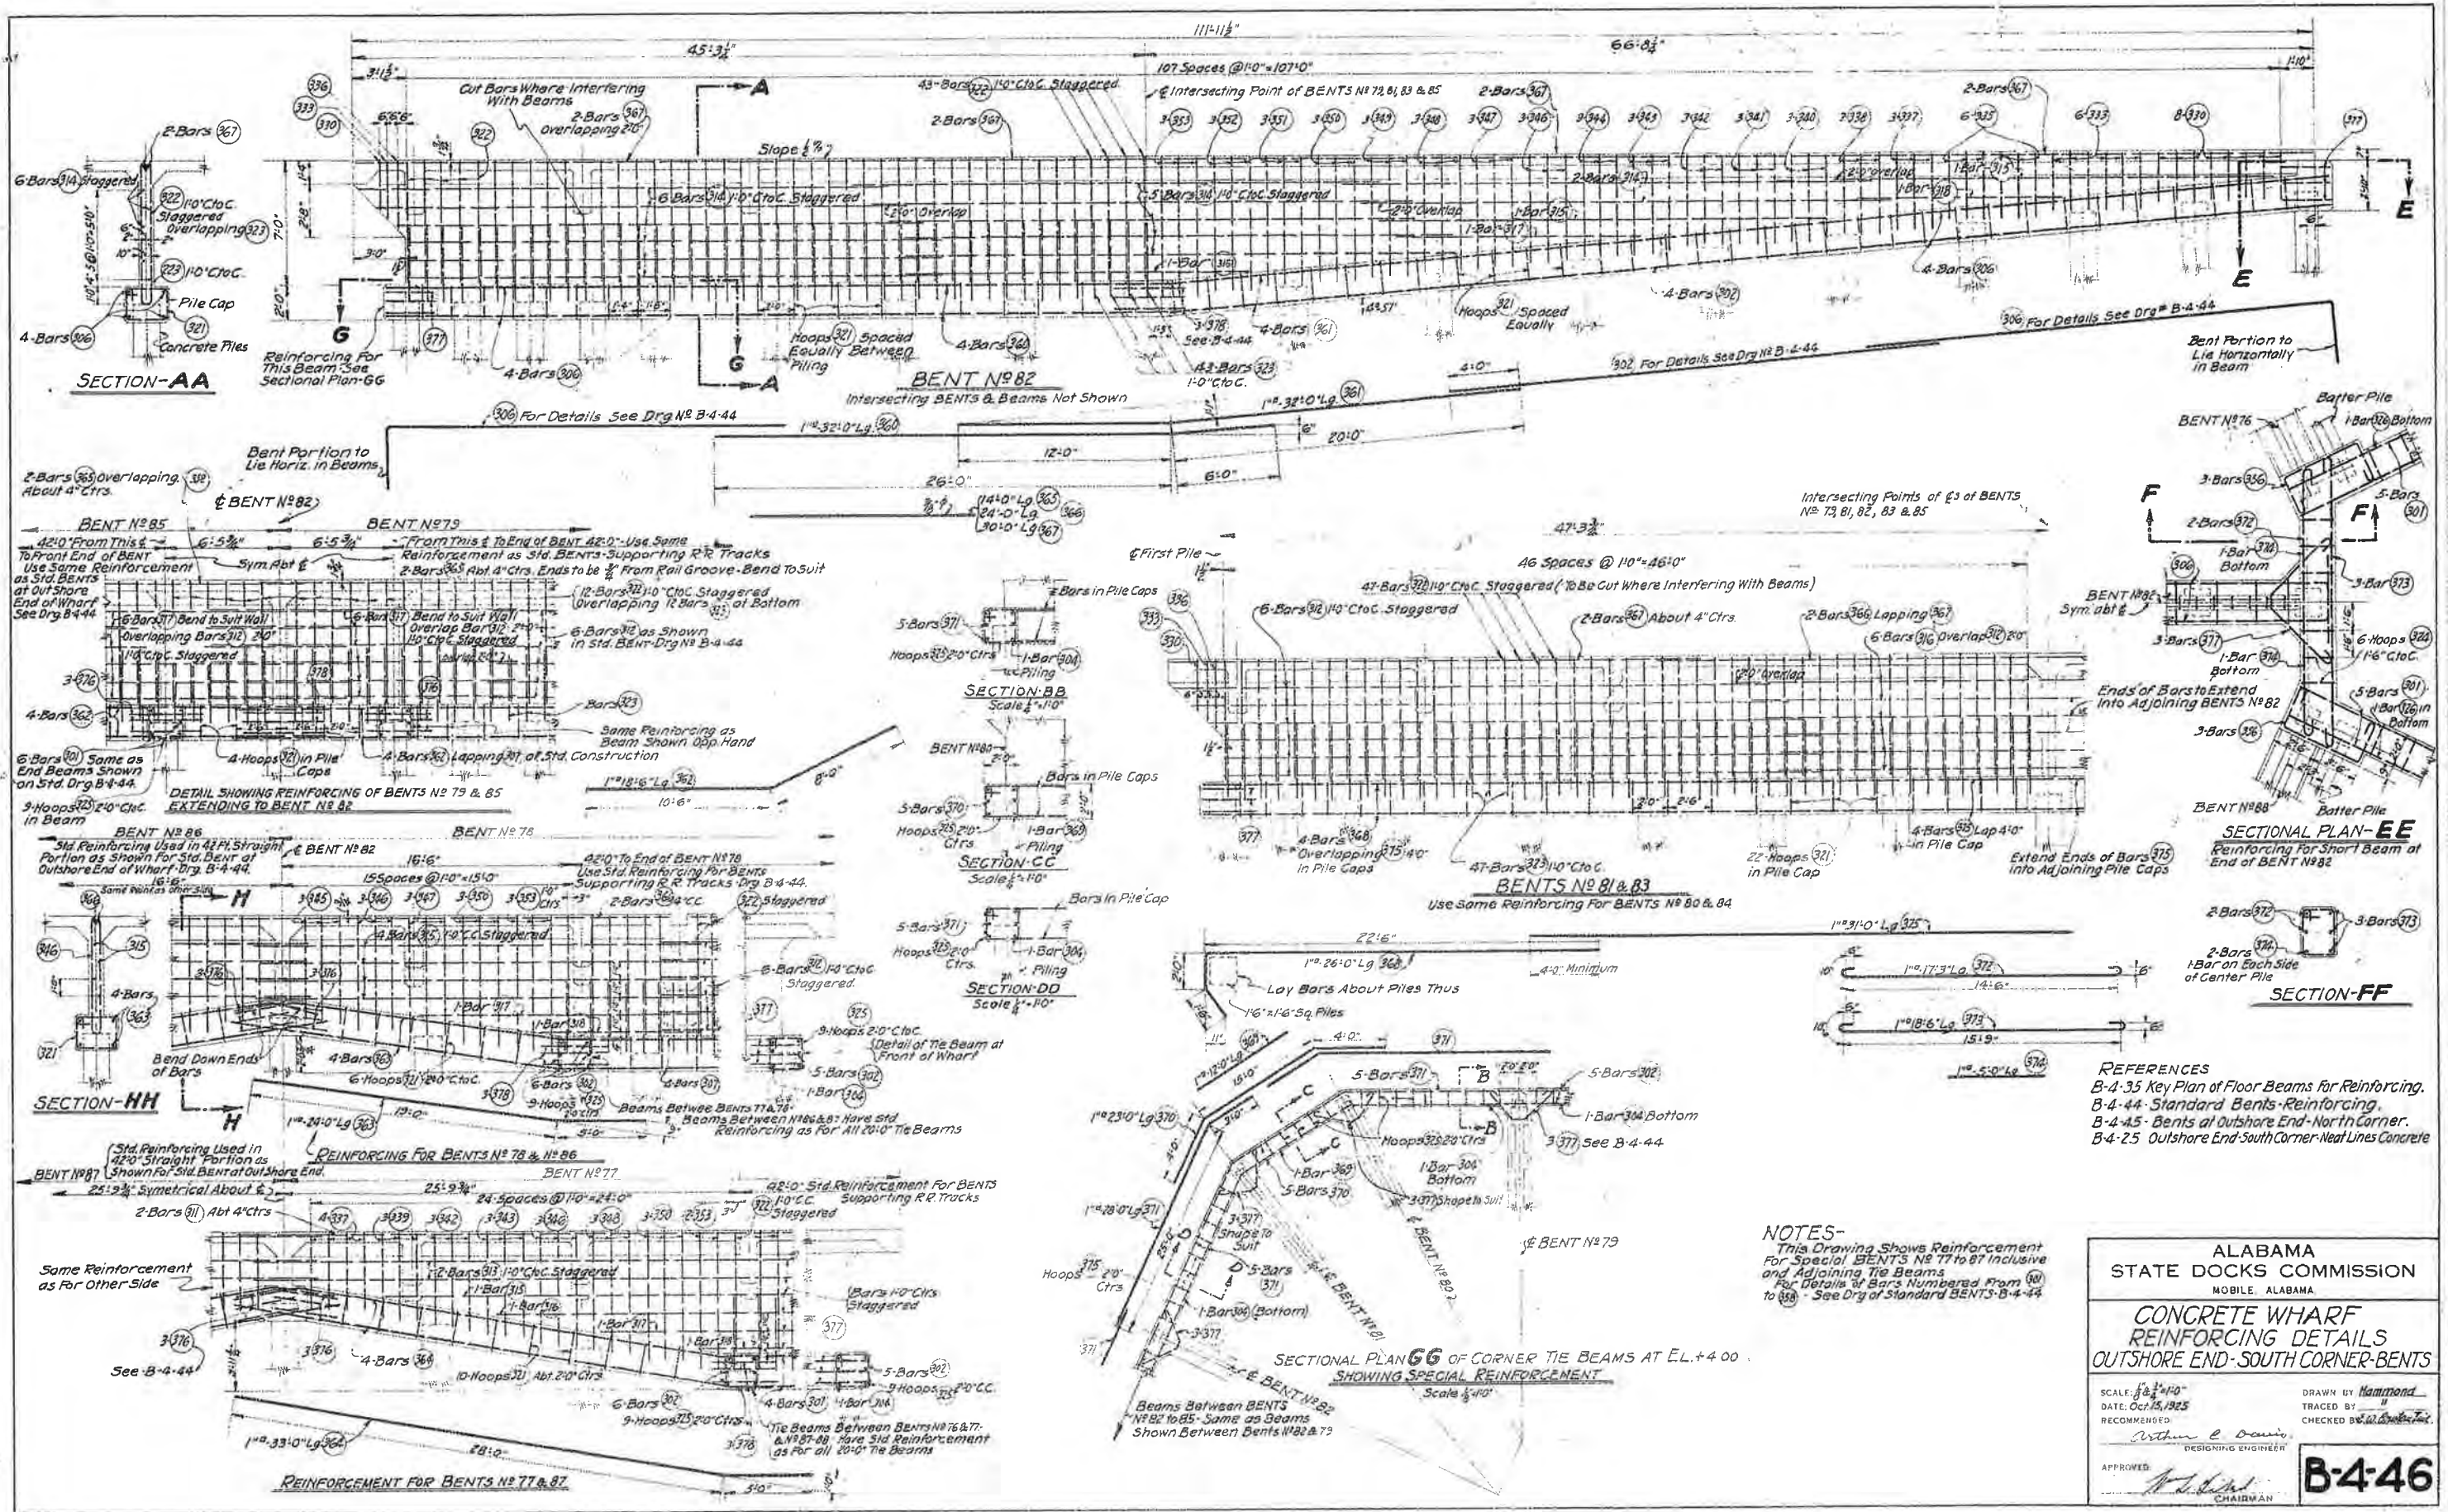

REFERENCES  
 B-4-35 Key Plan of Floor Beams for Reinforcing.  
 B-4-44 Standard Bents-Reinforcing.  
 B-4-45 Bents at Outshore End-North Corner.  
 B-4-25 Outshore End-South Corner-Neat Lines Concrete

NOTES-  
 This Drawing Shows Reinforcing  
 For Special BENTS No 77 to 81 inclusive  
 and Adjoining Tie Beams  
 For Details of Bars Numbered From 300  
 to 359 - See Drg of Standard BENTS-B-4-44

ALABAMA  
 STATE DOCKS COMMISSION  
 MOBILE, ALABAMA


**CONCRETE WHARF  
 REINFORCING DETAILS  
 OUTSHORE END-SOUTH CORNER-BENTS**

SCALE: 1/4" = 1'-0"  
 DATE: Oct. 15, 1925  
 RECOMMENDED

DRAWN BY Hammond  
 TRACED BY  
 CHECKED BY

APPROVED: *Arthur L. Davis*  
 DESIGNING ENGINEER

CHAIRMAN **B-4-46**

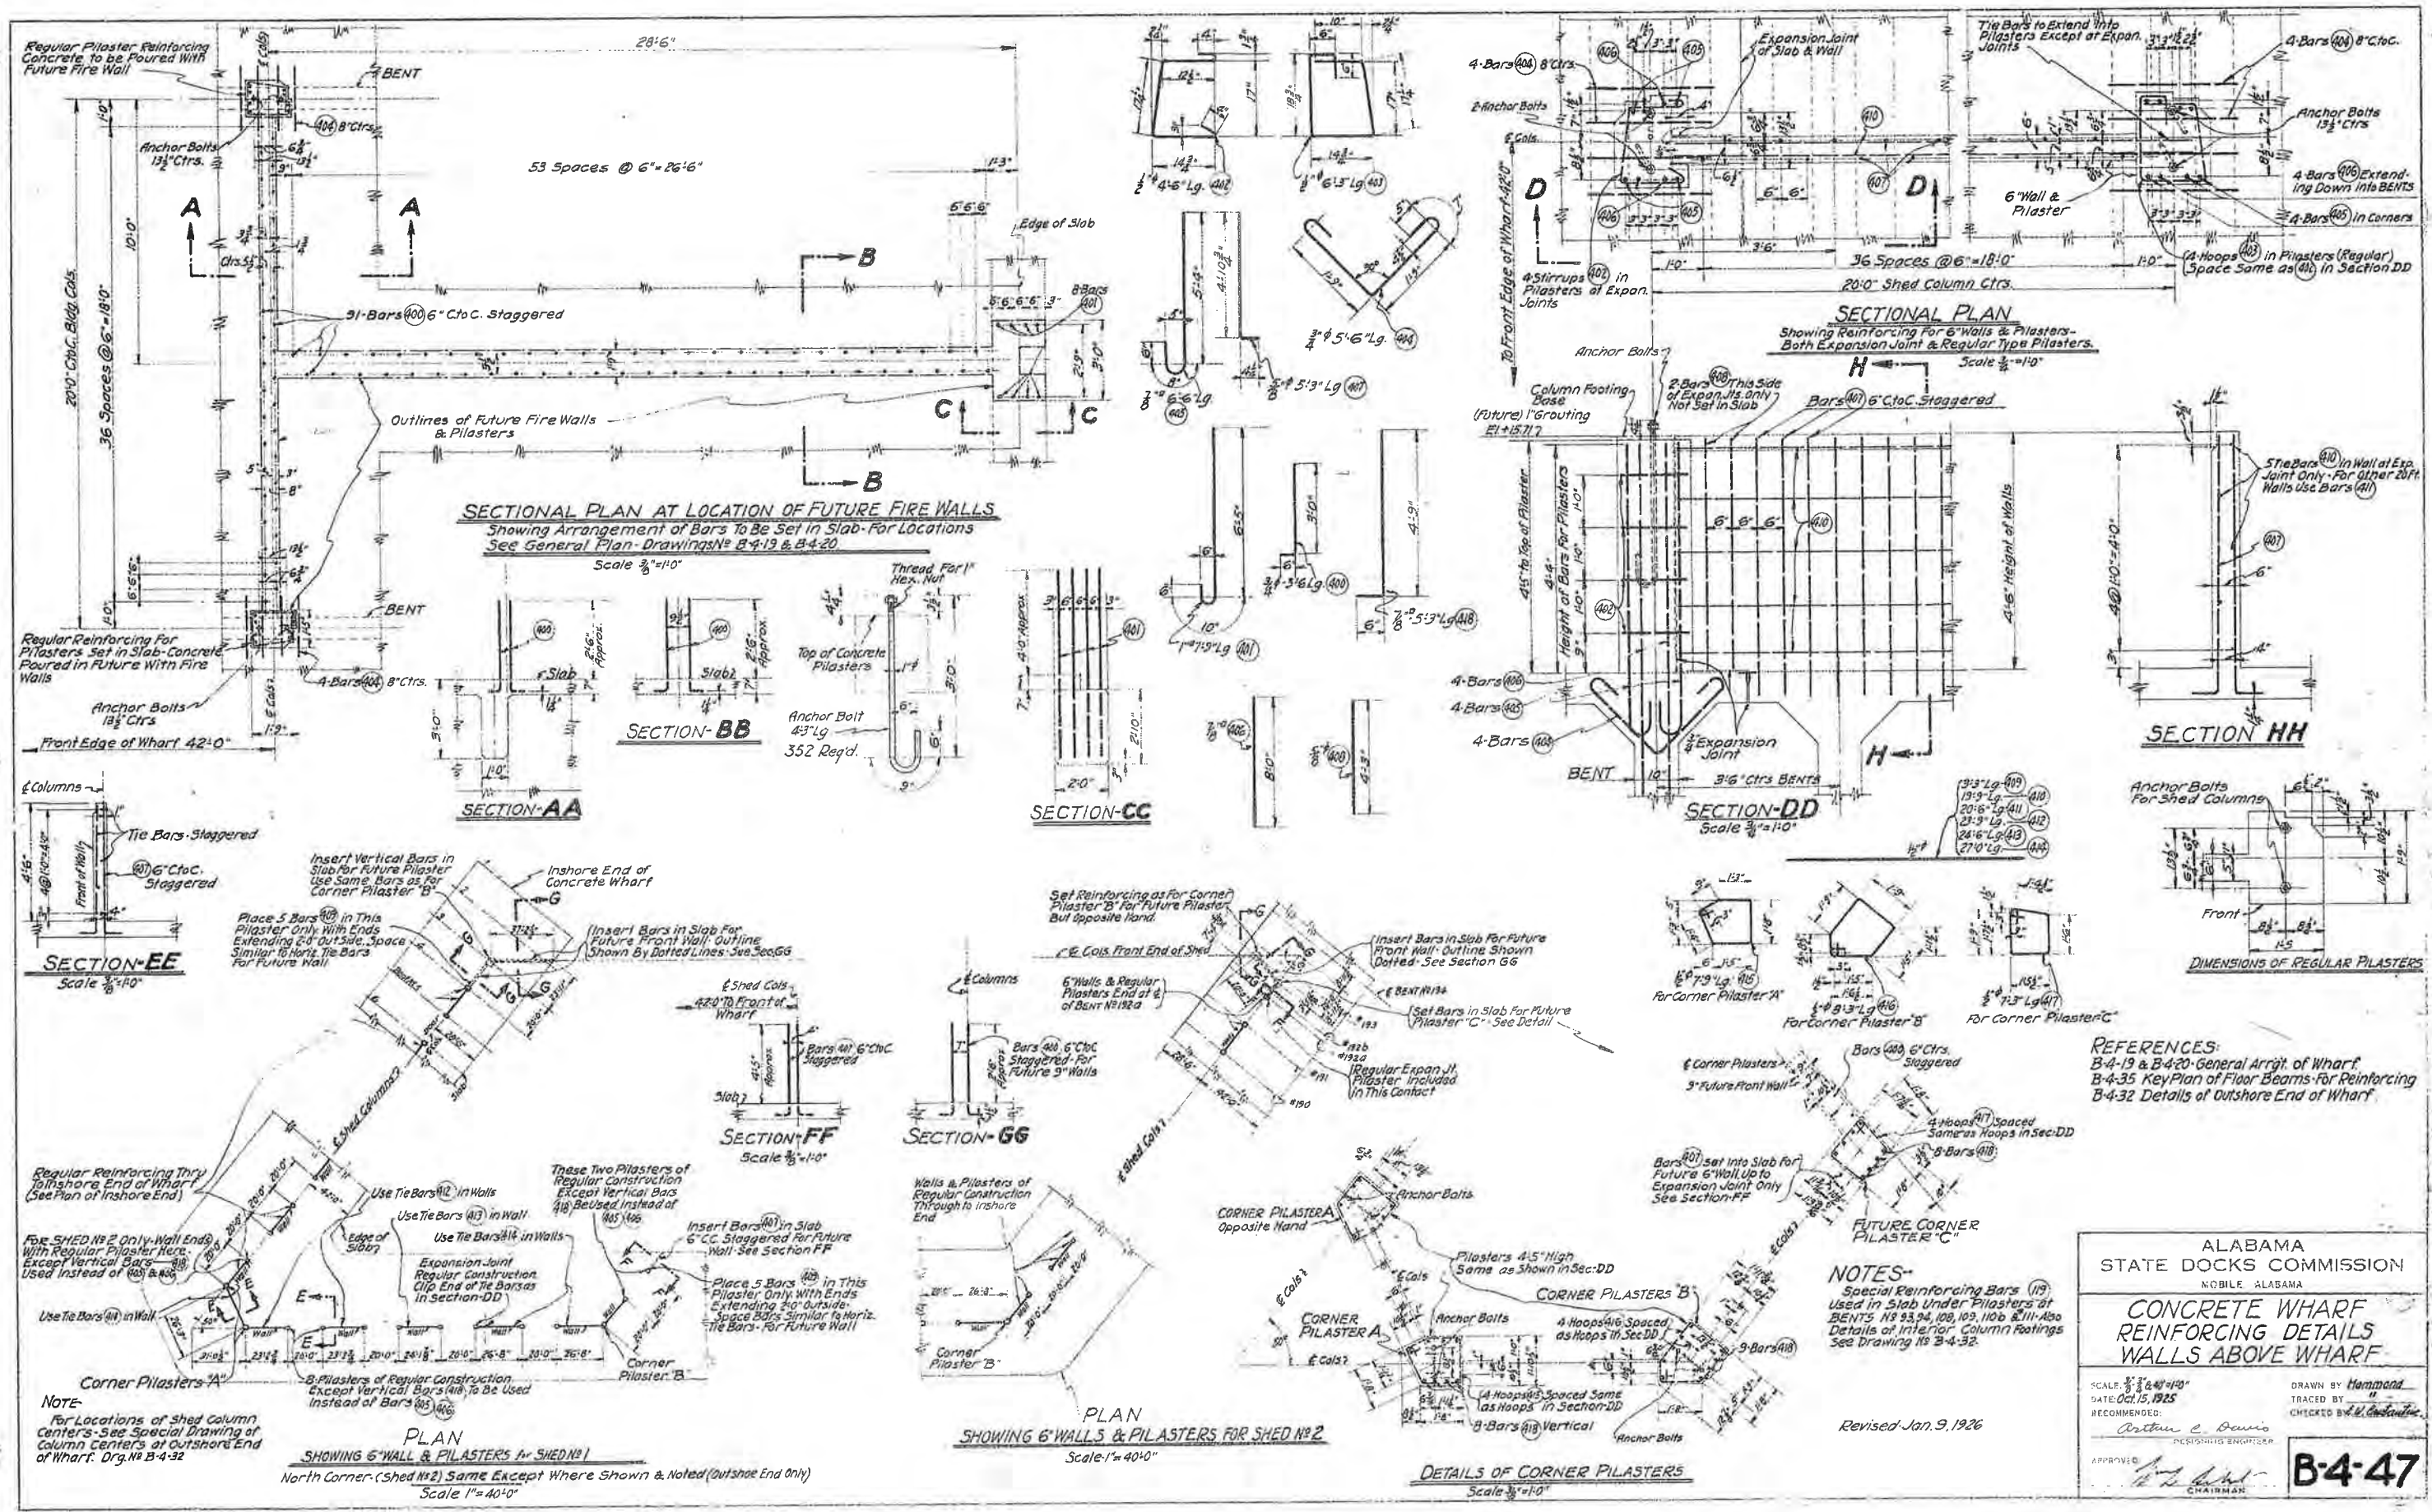

**SECTIONAL PLAN AT LOCATION OF FUTURE FIRE WALLS**  
 Showing Arrangement of Bars to be Set in Slab-For Locations  
 See General Plan-Drawings No. B-4-19 & B-4-20  
 Scale 1/2" = 1'-0"

**SECTIONAL PLAN**  
 Showing Reinforcing For 6" Walls & Pilasters-  
 Both Expansion Joint & Regular Type Pilasters.  
 Scale 1/2" = 1'-0"

**PLAN**  
 SHOWING 6" WALL & PILASTERS FOR SHED NO. 2  
 Scale 1" = 40'-0"

**DETAILS OF CORNER PILASTERS**  
 Scale 1/2" = 1'-0"

**REFERENCES:**  
 B-4-19 & B-4-20-General Arr't of Wharf  
 B-4-35 Key Plan of Floor Beams for Reinforcing  
 B-4-32 Details of Outshore End of Wharf

**NOTES:**  
 Special Reinforcing Bars (119)  
 Used in Slab under Pilasters at  
 BENTS 119, 123, 124, 128, 129, 110b & 111-Also  
 Details of Interior Column Footings  
 See Drawing No. B-4-32

ALABAMA  
 STATE DOCKS COMMISSION  
 MOBILE, ALABAMA

**CONCRETE WHARF  
 REINFORCING DETAILS  
 WALLS ABOVE WHARF**

SCALE: 1/2" = 1'-0"  
 DATE: Oct. 15, 1925  
 RECOMMENDED:  
 APPROVED:  
 DRAWN BY: Hammond  
 TRACED BY:  
 CHECKED BY: [Signature]  
 Revised Jan. 9, 1926  
**B-4-47**

- REFERENCES  
 PIER N<sup>o</sup>2 - B-4-21&22 Piling Plan  
                   B-4-18 Sections & Elevation of Wharf  
 PIER N<sup>o</sup>1 - B-4-36&57 - Piling Plan  
                   B-4-33 - Sections & Elevation of Wharf

NOTES: Provide painted red bands at points A to indicate 1 point lift or 2 point lift for handling lines. Provide painted white bands at points B to indicate places where Piles have to be supported in case of Transport. Provide all piles with 2"x2" Chamfer. Required numbers of piles are approximate only.

MARK	Δ	MARK	Δ
460	1'-1"	472	1'-2 3/4"
461	1'-0 1/2"	473	1'-2"
462	11 3/4"	474	1'-1 1/2"
463	11"	475	1'-0 1/2"
464	10 1/2"	476	1'-0"
465	9 1/2"	477	10 3/4"
466	8 3/4"	478	9 3/4"
467	8 1/4"	479	8 3/4"
468	7 1/2"	480	8"
469	6 3/4"	481	7 1/4"
470	6 1/4"	482	6 1/4"
471	5 1/2"	483	5 3/4"

Schedule For Hooks For Hoops.

NUMBER OF PILES REQUIRED				
LENGTH	60'-0"	55'-0"	50'-0"	45'-0"
SIZE	1'-6" x 1'-6"	1'-6" x 1'-6"	1'-4" x 1'-4"	1'-4" x 1'-4"
PIER N <sup>o</sup> 1				
PIER N <sup>o</sup> 2	883	340	336	750
				1123

Revised Jan. 9, 1926.

ALABAMA STATE DOCKS COMMISSION  
 NO. 2, 1925

CONCRETE WHARF  
 DETAILS OF CONCRETE PILES.

SCALE: 1/2" = 1'-0"  
 DATE: Oct 15, 1925  
 REVISIONS:  
 Arthur C. Davis, CHAIRMAN  
 B-448


40'-0" Pile  
 Size 1'-4" x 1'-4"

45'-0" Pile  
 Size 1'-4" x 1'-4"

50'-0" Pile  
 Size 1'-4" x 1'-4"

55'-0" Pile  
 Size 1'-6" x 1'-6"

60'-0" Pile  
 Size 1'-6" x 1'-6"

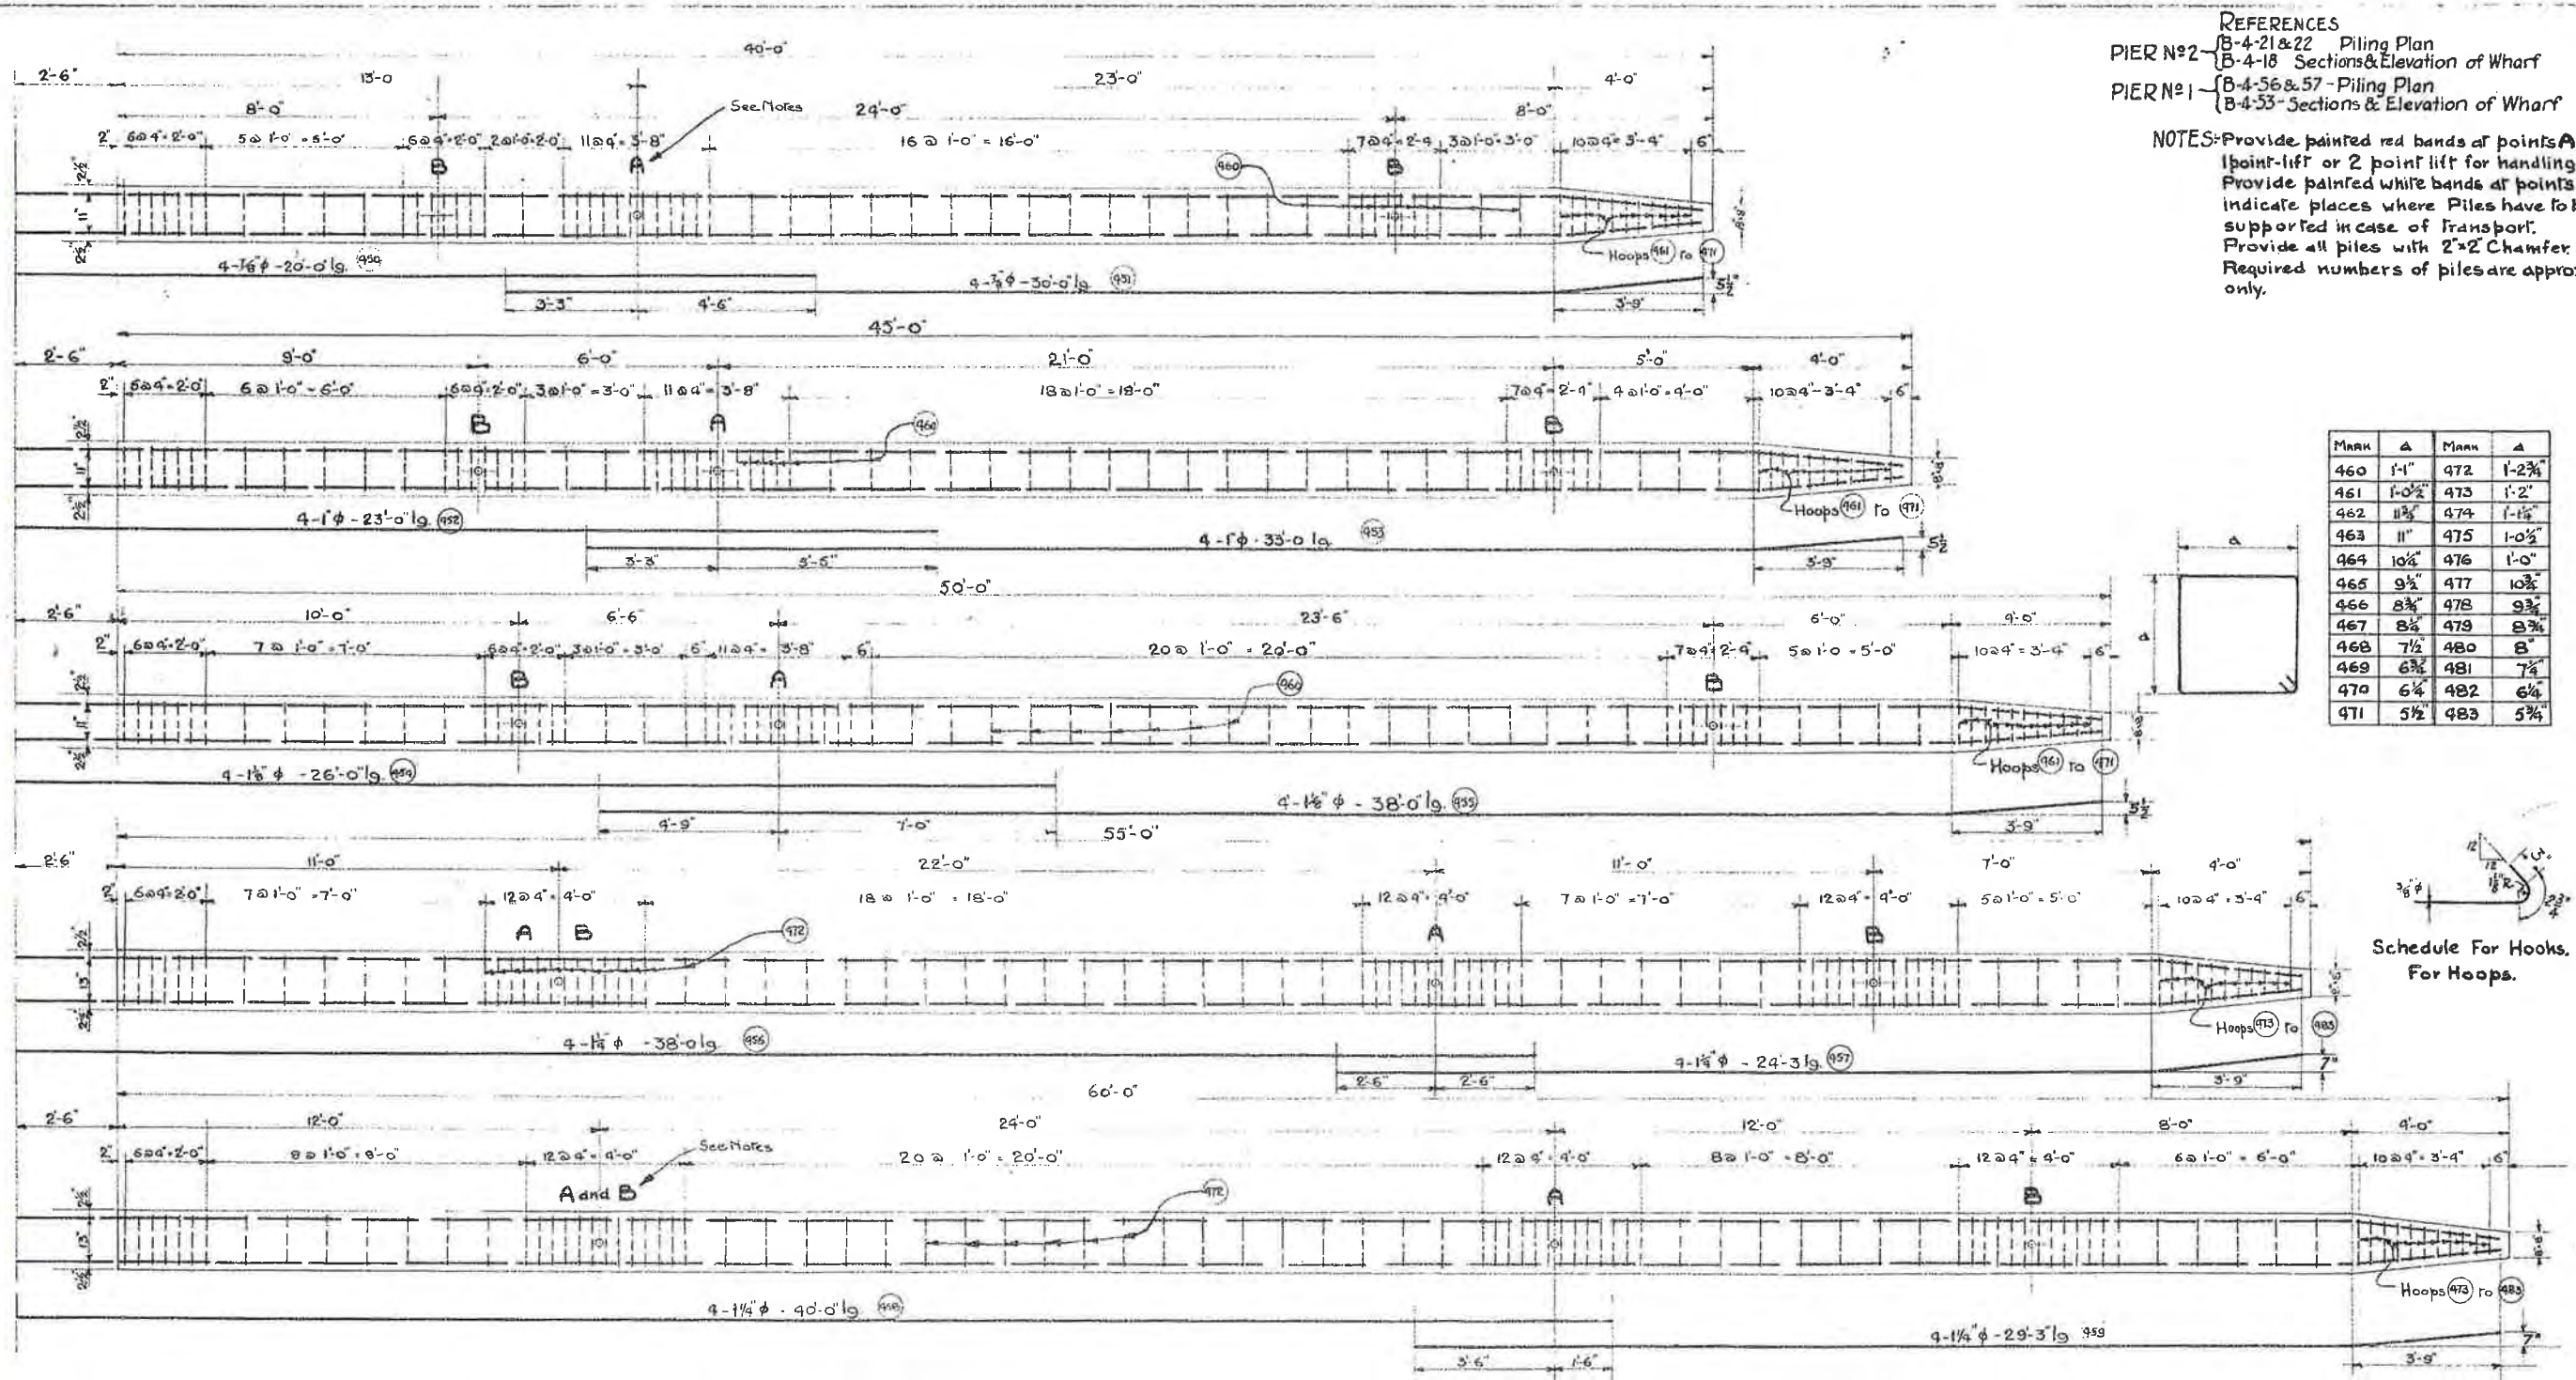

**BILL OF MATERIAL FOR DWG. N° B-4-36**

Beam	No. of Beams	Mark	Number Reqd.	Size	Length Ft.	In.	Tot. Length Ft.	Wt. Per Ft.	Tot. Wt.	Remarks
	4	5	1	12	0	5760	0.34	19584		
	6	5	7/8	10	0	4800	0.26	12480		
	10	2	1/2	23	0	4416	0.85	3754		
	11	3	1	33	0	9504	0.34	32314		
	12	2	1/2	13	6	2592	0.85			
	13	2	1/2	13	3	2544	0			
	14	2	"	12	9	2448	0			
	15	2	"	12	6	2400	0			
G	96	16	2	"	11	9	2256	0	17177	
	17	2	"	11	3	2160	0			
	18	2	"	10	6	2016	0			
	19	2	"	10	0	1920	0			
	20	2	"	9	9	1872	0			
	21	4	3/8	4	0	1536	0.26	7238		
	22	2	"	6	6	1248	0			
	23	1	3/8	7	6	720	0.38	1040		
	24	4	"	5	3	2016	0			
G	5	5	3/8	20	0	600	0.26	1560	at Bent 23 only	
	5	5	3/8	20	0	9600	0.26	37440		
	6	5	"	10	0	4800	0			
	7	2	1/2	19	0	3648	0.85	3101		
	8	3	1	30	0	8640	0.34	39168		
	9	3	"	10	0	2880	0			
	12	2	1/2	13	6	2592	0.85			
	13	2	"	13	3	2544	0			
H	96	14	2	"	12	9	2448	0	15586	
	15	2	"	12	6	2400	0			
	16	2	"	11	9	2256	0			
	17	2	"	11	3	2160	0			
	18	2	"	10	6	2016	0			
	19	2	"	10	0	1920	0			
	21	8	3/8	4	0	3072	0.26	11232		
	22	2	"	6	6	1248	0			
	23	2	3/8	7	6	1440	0.38	1313		
	24	4	"	5	3	2016	0			
	1	2	1/2	22	0	528	0.85	449		
	2	3	1	32	3	1161	0.34	6595		
	4	5	"	12	0	720	0			
	6	5	3/8	10	0	600	0.26	1560		
	12	2	1/2	13	6	324	0.85			
	13	2	"	13	3	318	0			
	14	2	"	12	9	306	0			
	15	2	"	12	6	300	0			
	16	2	"	11	9	282	0			
	17	2	"	11	3	270	0			
L	12	18	2	"	10	6	252	0	2147	
	19	2	"	10	0	240	0			
	20	2	"	9	9	234	0			
	21	4	3/8	4	0	192	0.26	965		
	22	2	"	6	6	156	0			
	23	1	3/8	7	6	90	0.38	154		
	24	5	"	5	3	315	0			
	1	2	1/2	22	0	3276	0.85	27326		
744	3	2	1	36	9	54684	0.34	307346		
	4	4	1	12	0	35712	0			
740	5	5	3/8	20	0	74000	0.26	192400		
	12	2	1/2	13	6	20088	0.85			
	13	2	"	13	3	19716	0			
	14	2	"	12	9	18972	0			
	15	2	"	12	6	18600	0			
M	744	16	2	"	11	9	17484	0	133120	
	17	2	"	11	3	16740	0			
	18	2	"	10	6	15624	0			
	19	2	"	10	0	14880	0			
	20	2	"	9	9	14508	0			
	21	4	3/8	4	0	11904	0.26	30950		
	23	1	3/8	7	6	5580	0.38	2120		
4	6	5	3/8	10	0	200	0.26	520	at Bent 75 only	
								908879		
								or 454.45		

**BILL OF MATERIAL FOR DWG. N° B-4-37**

Beam	No. of Beams	Mark	Number Reqd.	Size	Length Ft.	In.	Tot. Length Ft.	Wt. Per Ft.	Tot. Wt.	Remarks
	101	2	3/8	22	0	396	0.38	150		
	102	2	1	28	3	508	6.34	3029		
	103	2	"	21	3	382	6			
	104	3	1/2	5	0	135	0.85	163	at Bent 66 only	
	108	3	1/2	9	6	57	0			
	114	2	3/8	9	0	162	0.38			
N	115	2	"	8	6	153	0			
	116	2	"	8	0	144	0			
	117	2	"	7	9	139	6		376	
	118	6	"	7	3	391	6			
	105	2	3/8	21	0	2162	0.38	8156		
	106	2	3/8	30	0	3062	0.26	156775		
	107	2	"	29	0	29638	0			
K	136	108	3	1/2	9	6	10687	0.85	12379	
	127	3	"	9	6	3876	0			
	114	2	3/8	9	0	9198	0.38			
	115	2	"	8	6	8687	0			
	116	2	"	8	0	8176	0		21360	
	117	2	"	7	9	7920	6			
	118	6	"	7	3	22228	6			
	105	2	3/8	21	0	756	0.38	287		
	108	3	1/2	9	6	342	0.85	456	Near Pile Cap	
	127	3	"	9	6	171	0			
	114	2	3/8	9	0	324	0.38			
	115	2	"	8	6	306	0			
K	116	2	"	8	0	324	0		964	
	117	2	"	7	9	279	0			
	118	10	"	7	3	1305	0			
	147	2	1	34	0	1224	0.34			
	148	2	"	30	0	1080	0		10373	
	149	2	"	20	9	747	0			
	104	3	1/2	5	0	675	0.85			
	108	3	"	9	6	855	0		1664	
	127	3	"	9	6	427	6			Near Pile Cap
	109	2	3/8	18	6	1665	0.38	633		
	110	1	1	26	0	1170	0.34	3978		
J	45	111	2	3/8	17	9	1597	6.26	4154	
	114	2	3/8	9	0	810	0.38			
	115	2	"	8	6	765	0			
	116	2	"	8	0	720	0		1881	
	117	2	"	7	9	697	6			
	118	6	"	7	3	1957	6			
	104	3	1/2	5	0	45	0.85			
	108	3	"	9	6	57	0		111	
	127	3	"	9	6	28	6			
	109	2	3/8	18	9	112	6.38	43		
	110	2	1	26	0	156	0.34			
	150	2	"	27	0	162	0		1438	
J	3	151	2	"	17	6	105	0		
	114	2	3/8	9	0	54	0.38			
	115	2	"	8	6	57	0			
	116	2	"	8	0	48	0		142	
	117	2	"	7	9	46	6			
	118	8	"	7	3	174	0			
	103	2	1	28	3	2712	0.34	9221		
	104	3	1/2	5	0	720	0.85			
	108	3	"	9	6	57	0		685	Bent 28 only
	127	3	"	9	6	28	6			
	112	2	3/8	22	0	2112	0.38	803		
	113	2	1	29	6	2832	0.34	9629		
P	48	114	2	3/8	9	0	864	0.38		
	115	2	"	8	6	816	0			
	116	2	"	8	0	768	0		2006	
	117	2	"	7	9	744	0			
	118	6	"	7	3	2088	0			

**BILL OF MATERIAL FOR DWG. N° B-4-37 CONT'D.**

Beam	No. of Beams	Mark	Number Reqd.	Size	Length Ft.	In.	Tot. Length Ft.	Wt. Per Ft.	Tot. Wt.	Remarks
	119	2	3/8	16	6	693	0.26	1802		
	120	1	1	17	0	357	0.34	2965		
Rand R	21	121	2	"	12	3	514	6		
	122	10	1/2	5	3	1102	0.67	739		
	104	3	1/2	5	0	420	0.85			
	108	3	"	9	6	342	0		696	Remaining at Bent Beams K
	127	3	"	9	6	57	0			
	124	2	3/8	20	0	1120	0.38	426		
	125	2	1	27	6	1540	0.34	8001		
	126	2	1	19	3	1078	0			
Q	28	114	2	3/8	9	0	504	0.38		
	115	2	"	8	6	476	0			
	116	2	"	8	0	448	0		1170	
	117	2	"	7	9	434	0			
	118	6	"	7	3	1218	0			
									267533	or 133.77

**BILL OF MATERIAL FOR SHEET N° B-4-38**

Beam	No. of Beams	Mark	Number Reqd.	Size	Length Ft.	In.	Tot. Length Ft.	Wt. Per Ft.	Tot. Wt.	Remarks
	1	21	1/2	22	0	44	0.85	37		
	5	10	3/8	20	0	200	0.26	1456		
	6	36	"	10	0	360	0			
	7	2	1/2	19	0	38	0.85	71		
	10	2	"	23	0	46	0			
	12	4	3/8	13	6	54	0.38			
	13	4	"	13	3	53	0			
	14	4	"	12	9	51	0			
	15	4	"	12	6	50	0		360	
	16	4	"	11	9	47	0			
F	Total of all G	18	4	"	11	3	45	0		
F2		18	4							

**BILL OF MATERIAL FOR DWG. NO B-4-38 CONT'D.**

Beam	No of Beams	Mark	Number Reqd.	Size	Length Ft.	Total Length Ft.	Wt. Per Ft.	Total Wt.	Remarks
		108	9	1/2"	9	81	0.085	73	
		114	6	3/8"	9	54	0.38		
		115	6	"	8	48	0		
		116	6	"	8	48	0		
		117	6	"	7	42	0		
		118	12	"	7	84	0	148	
D	Total	130	2	"	12	24	0		
D	Total of all	132	2	"	16	32	0		
D2	3 Beams	134	2	"	23	46	0		
		135	2	3/8"	10	20	0.26		
		138	2	"	16	32	0		
		139	2	"	20	40	0		
		140	1	"	24	24	0	528	
		142	1	"	27	27	0		
		144	2	"	29	58	0		
		104	24	1/2"	5	120	0.085	199	
		108	12	"	9	108	0		
		114	2	3/8"	9	18	0.38		
		115	8	"	8	64	0		
		116	8	"	8	64	0		
T (e)	Total	117	8	"	7	56	0	270	
T. (e)	Total of all	118	40	"	7	280	0		
Ts (e)	Beams	132	4	"	16	64	0		
		133	8	"	18	144	0		
		138	8	3/8"	16	128	0.26		
		142	2	"	27	54	0	972	
		143	4	"	28	112	0		
		146	4	"	19	76	0		
								13331	#
								6.67	T

**BILL OF MATERIAL FOR DWG. NO B-4-39**

Span	No of Spans	Mark	Number Reqd.	Size	Length Ft.	Total Length Ft.	Wt. Per Ft.	Total Wt.	Remarks
		82	201	37	1/2"	5	15170	0.067	10164
		80	202	39	3/8"	24	74880	0.38	
		69	203	45	"	21	63205	0	55260
		1	204	2	"	36	72	0	
		82	206	36	3/8"	15	44280	0.104	
		211	18	"	13	234	0		
		71	212	19	"	11	14839	0	84340
		11	212	20	"	11	2420	0	20 Spans near Exp. Joint
		13	213	45	3/8"	22	12870	0.38	4891
		82	214	4	3/4"	27	8856	0.15	13284
		2	220	39	3/8"	24	1911	0.38	726
		82	222	18	3/8"	9	13653	0.104	14199
		69	223	19	3/8"	6	7966	0.38	Middle Span
		2	223	20	"	6	240	0	3607
		11	223	21	"	6	1386	0	End Span
		71	224	19	1/2"	6	8094	0.067	20 Spans near Exp. Joint
		11	224	20	"	6	1320	0	6307
		69	225	57	3/8"	5	22614	0.38	
		2	225	60	"	5	690	0	10370
		11	225	63	"	5	3984	0	
		71	226	111	1/2"	4	31524	0.067	
		11	226	114	"	4	5016	0	42282
		82	227	36	"	9	26568	0	
		69	228	38	3/8"	7	18354	0.38	
		2	228	40	"	7	560	0	8416
		11	228	42	"	7	3234	0	
		71	229	38	1/2"	7	18886	0.067	
		11	229	40	"	7	3080	0	
		71	230	114	"	6	48564	0	78316
		11	230	120	"	6	7920	0	
		71	231	19	"	24	33050	0	
		11	231	20	"	24	5390	0	
		71	232	19	3/8"	35	47215	0.38	20868
		11	232	20	"	35	7700	0	
		82	233	18	1/2"	7	14439	0.067	7664
		24	201	37	1/2"	5	4440	0.067	2975
		206	28	3/8"	15	5040	0.104		
		211	14	"	13	2226	0	9753	
		212	16	"	11	2112	0		
		215	4	3/4"	23	1104	0.15	1656	

**BILL OF MATERIAL FOR DWG. NO B-4-39 CONT'D.**

Span	No of Spans	Mark	Number Reqd.	Size	Length Ft.	Total Length Ft.	Wt. Per Ft.	Total Wt.	Remarks
		221	84	3/8"	19	1512	0.38	7278	
		222	14	3/8"	9	1534	0.104	1616	
		223	18	3/8"	6	1296	0.38	492	
16'-6"	12	224	16	1/2"	6	1152	0.067	772	
Total 12 Spans		225	54	3/8"	5	3726	0.38	1416	
		226	90	1/2"	4	4320	0.067	4920	
		227	28	"	9	3024	0		
		228	36	3/8"	7	3024	0.38	1149	
		229	32	1/2"	7	2688	0.067		
		230	36	"	6	6912	0	2584	
		231	16	"	24	4704	0		
		232	16	3/8"	35	6720	0.38	2554	
		233	14	1/2"	7	1302	0.067	872	
		222	2	3/8"	9	2090	0.104	2174	on # of all Beams
								405905	#
								202.95	T

**BILL OF MATERIAL FOR DWG. NO B-4-40**

Span	No of Spans	Mark	Number Reqd.	Size	Length Ft.	Total Length Ft.	Wt. Per Ft.	Total Wt.	Remarks	
		23	201	37	1/2"	5	4255	0.067	2851	
		22	202	29	3/8"	24	1512	0.38		
		20	203	37	"	21	15340	0	23160	
			204	38	"	36	30096	0		
			205	18	3/8"	15	5940	0.104		
20' Spans		206	90	"	15	29100	0			
		207	18	"	10	3960	0	47270		
		208	19	"	14	5852	0			
		209	19	1/2"	20	8360	0.067	13793		
		210	19	"	29	12226	0			
		211	18	3/8"	13	5247	0.104	10239		
		212	19	3/8"	"	0	4598	0		
		214	4	3/4"	27	2376	0.15	3564		
		213	37	3/8"	22	1628	0.38	783	20 Spans near Exp. Joint	
		204	6	"	36	432	0			
		6	201	37	1/2"	5	1110	0.067	744	
			213	29	3/8"	22	2552	0.38		
			203	37	"	21	3108	0	3245	
			204	20	"	36	2880	0		
			205	16	3/8"	15	960	0.104		
			206	80	"	15	4800	0	7646	
			207	16	"	10	640	0		
17'-7" and 18'-0" Spans	4	208	17	"	14	952	0			
		209	17	1/2"	20	1360	0.067			
		210	17	"	29	1989	0	2244		
		211	16	3/8"	13	848	0.104	1660		
		212	17	"	11	748	0			
		215	4	3/4"	23	368	0.15	552		
		30	207	2	3/8"	10	600	0.104	624	on # of all Beams
								118375	#	
								59.19	T	

**BILL OF MATERIAL FOR DWG. NO B-4-41**

Span	No of Spans	Mark	Number Reqd.	Size	Length Ft.	Total Length Ft.	Wt. Per Ft.	Total Wt.	Remarks	
		64	201	32	1/2"	5	10240	0.067	6861	
		56	202	30	3/8"	24	40320	0.38		
		52	203	34	"	21	37128	0	29430	
		56	206	36	3/8"	15	30240	0.104		
		4	206	28	"	15	1680	0		
		56	211	18	"	13	13356	0		
		4	211	14	"	13	742	0	60809	
		52	212	19	"	11	10868	0		
		4	212	20	"	11	880	0		
		4	212	16	"	11	704	0		
		4	213	34	3/8"	22	2392	0.38	1137	
		56	214	4	3/8"	27	6048	0.15	9624	
		4	215	4	"	23	368	0		
		4	221	64	3/8"	19	4864	0.38	1848	
		56	222	18	3/8"	9	9324	0.104	10236	
		4	222	14	"	9	518	0		
		52	223	19	3/8"	6	5928	0.38		
		4	223	18	"	6	432	0	2608	
		4	223	21	"	6	504	0		
		52	224	19	1/2"	6	5928	0.067		

**BILL OF MATERIAL FOR DWG. NO B-4-41 CONT'D.**

Span	No of Spans	Mark	Number Reqd.	Size	Length Ft.	Total Length Ft.	Wt. Per Ft.	Total Wt.	Remarks
20'-0" and 16'-6" Total 60 Spans	4	224	20	1/2"	6	480	0.067	4551	
	4	224	16	"	6	584	0		
	52	225	38	3/8"	5	11362	0.38		
	4	225	42	"	5	966	0	4999	
	4	225	36	"	5	828	0		
	52	226	74	1/2"	4	15392	0.067		
	4	226	76	"	4	1216	0		
	4	226	60	"	4	960	0	18186	
	56	227	18	"	9	9072	0		
	4	227	14	"	9	504	0		
	52	228	19	3/8"	7	6916	0.38		
	4	228	21	"	7	588	0	3043	
	4	228	18	"	7	504	0		
	52	229	19	1/2"	7	6916	0.067		
	4	229	20	"	7	560	0		
	4	229	16	"	7	448	0		
	52	230	57	"	6	17784	0		
	4	230	80	"	6	1920	0		
	4	230	64	"	6	1536	0	38122	
	52	231	19	"	24	24206	0		
	4	231	20	"	24	1920	0		
	4	231	16	"	24	1568	0		
	52	232	19	3/8"	35	34580	0.38		
	4	232	20	"	35	2800	0	15056	
	4	232	16	"	35	2240	0		

**BILL OF MATERIAL FOR DWG. N<sup>o</sup> B-4-43**

Span	Number of Spans	Mark	Number Reqd.	Size	Length Ft.	In.	Tot. Length Ft.	In.	Wt. per Ft.	Total Wt.	Remarks
		201	392	1/2"	5	0	1960	0	0.67	1313	
		202	174	3/8"	24	0	4176	0	0.38		
		203	205	"	21	0	4505	0	"	4005	
		204	57	"	36	0	2052	0	"		
		205	131	3/8"	15	0	1965	0	1.04		
		206	432	"	15	0	6480	0	"		
		207	149	"	10	0	1490	0	"	11949	
		208	111	"	14	0	1554	0	"		
		209	57	1/2"	20	0	1140	0	0.67	764	Standard Bars
		212	17	3/8"	11	0	187	0	1.04	194	
		214	40	3/8"	27	0	1080	0	1.5	1620	
		222	60	3/8"	9	3	555	0	1.04	577	
		223	64	3/8"	6	0	384	0	0.38	146	
		224	70	1/2"	6	0	420	0	0.67	281	
		225	192	3/8"	5	9	1104	0	0.38	420	
		226	372	1/2"	4	0	1488	0	0.67	1727	
		227	121	"	9	0	1089	0	"		
		228	128	3/8"	7	0	896	0	0.38	540	
		229	140	1/2"	7	0	980	0	0.67		
		230	411	"	6	0	2466	0	"	2589	
		233	54	"	7	9	418	6	"		
		249	26	3/8"	15	0	390	0	1.04		
		250	24	"	30	0	720	0	"	1233	
		251	7	"	10	9	75	3	"		
		252	4	3/8"	7	6	30	0	0.38	47	
		253	12	"	7	9	93	0	"		
		254	10	1/2"	11	0	110	0	0.67	74	
		255	25	3/8"	11	0	275	0	0.38		
		256	36	"	12	6	450	0	"		
		257	22	"	13	6	297	0	"		
		258	49	"	15	0	735	0	"		
		259	61	"	17	0	1037	0	"		
		260	45	"	18	0	810	0	"		
		261	28	"	20	0	560	0	"		
		262	33	"	22	0	726	0	"	3078	
		263	58	"	24	0	1392	0	"		
		264	30	"	25	0	750	0	"		
		265	33	"	7	9	255	9	"		
		266	12	"	3	5	39	0	"		
		267	16	"	6	0	96	0	"		
		268	20	"	9	0	180	0	"		
		269	6	"	10	0	60	0	"		
		270	17	"	27	0	459	0	"		
		271	29	1/2"	3	3	94	3	0.67		
		272	55	"	6	6	357	6	"		
		273	46	"	9	6	437	0	"		
		274	51	"	11	0	561	0	"		
		275	6	"	12	0	72	0	"		
		276	7	"	14	0	98	0	"		
		277	16	"	16	0	256	0	"	2240	
		278	6	"	18	0	108	0	"		
		279	13	"	20	0	260	0	"		
		280	6	"	22	0	132	0	"		
		281	33	"	8	0	264	0	"		
		282	7	"	24	0	168	0	"		
		283	8	"	27	0	216	0	"		
		284	11	"	29	0	319	0	"		
		285	8	3/8"	29	0	232	0	0.38		
		286	8	"	31	0	248	0	"		
		287	8	"	35	0	280	0	"		
		288	12	"	35	0	420	0	"	894	
		289	4	"	37	0	148	0	"		
		290	26	3/8"	40	0	1040	0	"		
		291	8	1/2"	31	0	248	0	0.67		
		292	7	"	33	0	231	0	"		
		293	9	"	35	0	315	0	"		
		294	9	"	37	0	333	0	"	1534	
		295	25	"	40	0	1000	0	"		
		296	36	"	4	6	162	0	"		
		297	8	3/8"	33	6	268	0	1.5	402	
		298	4	1/2"	25	0	100	0	0.67	670	
										36095	
										18.05	

**BILL OF MATERIAL FOR DWG. N<sup>o</sup> B-4-44**

Beam	N <sup>o</sup> of Beams	Mark	Number Reqd.	Size	Length Ft.	In.	Tot. Length Ft.	In.	Wt. per Ft.	Total Wt.	Remarks
Front and Back	40	301	5	1"	25	3	5050	0	3.4		of Exp. Joints
Center	20	301	6	"	25	3	3030	0	"		at Ends of Wharf
Front and Back	280	302	5	"	28	0	3920	0	"		20' Spans
Center	140	302	6	"	28	0	2520	0	"		
Front and Back	40	303	5	"	22	9	4530	0	"	276556	16'-17'-7" 18' Spans
Center	20	303	6	"	22	9	2730	0	"		of all 20' Spans
Front	160	304	1	"	18	6	2960	0	"		of all 20' Spans
Front	20	305	1	"	15	0	300	0	"		of all 20' Spans
Back	160	324	9	1/2"	10	0	1440	0	0.67		For all shorter Spans
Back	20	324	7	"	10	0	1400	0	"		
Front and Back	320	325	9	"	8	3	2376	0	"	28053	20' Spans
Front and Back	40	325	7	"	8	3	2310	0	"		For all shorter Spans
Back	160	326	1	1"	14	0	2240	0	3.4		All 20' Spans
Back	20	327	1	"	10	6	210	0	"	8738	16'-17'-7" and 18' Spans
Back	2	328	2	"	30	0	120	0	"		in Beams 1044 & 1045
Bents											
			306	4	1"	26	0	1456	0	3.4	
			307	4	"	26	0	1456	0	"	171360
			308	2	"	38	0	1064	0	"	
			309	2	"	38	0	1064	0	"	
			310	6	3/8"	3	9	3870	0	0.38	5915
			311	2	"	34	0	1168	0	"	
			312	6	1/2"	34	0	3508	0	0.67	
			313	1	"	35	0	6020	0	"	
			314	1	"	30	0	5160	0	"	
			315	1	"	25	0	4300	0	"	
			316	1	"	20	0	3440	0	"	39182
			317	1	"	15	0	2580	0	"	
			318	1	"	11	0	1892	0	"	
			319	32	3/8"	8	3	4224	0	1.91	8068
			320	68	1/2"	12	9	13872	0	0.67	
			321	34	"	9	3	44030	0	"	38794
			322	41	3/8"	7	9	5463	0	1.5	205046
			323	53	"	9	0	8204	0	"	
			329	1	1/2"	7	0	1204	0	0.67	
			330	2	"	7	3	2494	0	"	
			331	1	"	7	6	1290	0	"	
			332	1	"	7	9	1333	0	"	
			333	2	"	8	3	2838	0	"	
			334	1	"	8	9	1505	0	"	
			335	1	"	9	3	1591	0	"	
			336	2	"	9	9	3354	0	"	
			337	1	"	10	3	1763	0	"	
			338	1	"	10	9	1849	0	"	
			339	1	"	11	3	1935	0	"	
			340	1	"	11	6	1978	0	"	
			341	1	"	12	0	2064	0	"	37539
			342	1	"	12	6	2150	0	"	
			343	1	"	13	0	2236	0	"	
			344	1	"	13	3	2279	0	"	
			345	1	"	13	9	2365	0	"	
			346	1	"	14	6	2494	0	"	
			347	1	"	14	9	2537	0	"	
			348	1	"	15	0	2580	0	"	
			349	1	"	15	6	2666	0	"	
			350	1	"	16	0	2752	0	"	
			351	1	"	16	6	2838	0	"	
			352	1	"	17	0	2924	0	"	
			353	1	"	17	6	3010	0	"	
			354	3	3/8"	14	3	171	0	1.5	
			355	3	"	13	9	5610	0	"	10545
			356	3	"	11	3	1248	9	"	Beams 1, 16 and 17
			357	4	3/8"	7	0	4916	0	0.38	1830
			358	3	1"	7	0	714	0	2.67	Beams 2 and 36 and Exp. Joints
			359	3	"	11	6	5865	0	"	38808
			360	3	"	19	6	7956	0	"	
			361	4	3/8"	36	0	4320	0	0.38	1642
			362	4	1"	26	0	3120	0	3.4	
			363	4	"	26	0	3120	0	"	
			364	2	"	38	0	2280	0	"	36720
			365	2	"	38	0	2280	0	"	
			366	6	1/2"	34	0	6120	0	0.67	
			367	1	"	35	0	1050	0	"	
			368	1	"	30	0	900	0	"	
			369	1	"	25	0	750	0	"	
			370	1	"	20	0	600	0	"	6834
			371	1	"	15	0	450	0	"	
			372	1	"	11	0	330	0	"	

**BILL OF MATERIAL FOR DWG. N<sup>o</sup> B-4-44 CONT'D.**

Bents	N <sup>o</sup> of Bents	Mark	Number Reqd.	Size	Length Ft.	In.	Tot. Length Ft.	In.	Wt. per Ft.	Total Wt.	Remarks	
			3	3/8"	32	3/8"	8	3	792	0	1.91	1513



**BILL OF MATERIAL FOR DWG. N° B-4-46 CONT'D.**

Bent	Number of Bents	Mark	Number Reqd.	Size	Length Ft.	In.	Total Length Ft.	In.	Wt. per Ft.	Total Wt.	Remarks
Bents 77 and 87	2	318	1	1/2" #	11	0	22	0	0.67		
	2	321	30	"	9	3	55.5	0	"		
	1	322	78	3/4" #	7	9	60.4	6	1.5	2189	
	1	323	95	"	9	0	85.5	0	"		
	1	330	1	1/2" #	7	3	7	3	0.67		
	1	333	1	"	8	3	8	3	"		
	1	336	1	"	9	9	9	9	"		
	2	337	4	"	10	3	82	0	"		
	2	339	3	"	11	3	67	6	"		
	2	342	3	"	12	6	75	0	"	482	
	2	343	3	"	13	0	78	0	"		
	2	346	3	"	14	6	87	0	"		
	2	348	3	"	15	0	90	0	"		
	3	350	3	"	16	0	144	0	"		
	2	353	2	"	17	6	70	0	"		
	1	357	4	3/8" #	28	0	112	0	0.38	70	
	1	358	2	"	36	0	72	0	"		
	2	364	4	1" #	33	0	264	0	3.4		
	2	306	4	"	26	0	208	0	"	2312	
	2	307	4	"	26	0	208	0	"		
	1	310	6	3/8" #	3	9	22	6	0.38	9	
	2	312	6	1/2" #	34	0	408	0	0.67		
	2	315	4	"	25	0	200	0	"		
	2	317	1	"	15	0	30	0	"	764	
	2	318	1	"	11	0	22	0	"		
	2	321	26	"	9	3	481	0	"		
	1	322	78	3/4" #	7	9	60.4	6	1.5	2189	
	1	323	95	"	9	0	85.5	0	"		
Bents 78 and 86	1	330	1	1/2" #	7	3	7	3	0.67		
	1	333	1	"	8	3	8	3	"		
	1	336	1	"	9	9	9	9	"		
	2	345	3	"	13	9	82	6	"	324	
	2	346	3	"	14	6	87	0	"		
	2	347	3	"	14	9	88	6	"		
	2	350	3	"	16	0	96	0	"		
	2	353	3	"	17	6	105	0	"		
	1	357	4	3/8" #	28	0	112	0	0.38	70	
	1	358	2	"	36	0	72	0	"		
	2	363	4	1" #	24	0	192	0	3.4	653	
	2	364	2	3/8" #	24	0	96	0	0.38	36	
	2	306	4	1" #	26	0	208	0	3.4	1414	
	2	307	4	"	26	0	208	0	"		
	1	310	6	3/8" #	3	9	22	6	0.38	9	
	2	312	6	1/2" #	34	0	408	0	0.67		
	2	317	6	"	15	0	180	0	"	667	
	2	321	22	"	9	3	407	0	"		
	1	322	90	3/8" #	7	9	697	6	1.5	2423	
Bents 79 and 85	1	323	102	"	9	0	918	0	"		
	1	330	1	1/2" #	7	3	7	3	0.67		
	1	333	1	"	8	3	8	3	"	17	
	1	336	1	"	9	9	9	9	"		
	1	357	4	3/8" #	28	0	112	0	0.38	70	
	1	358	2	"	36	0	72	0	"		
	2	362	4	1" #	18	6	74	0	3.4	252	
	2	365	2	3/8" #	14	0	28	0	0.38	11	
		312	6	1/2" #	34	0	816	0	0.67		
		316	6	"	20	0	480	0	"	1414	
		321	22	"	9	3	814	0	"		
		322	47	3/4" #	7	9	1457	0	1.5	4724	
		323	47	"	9	0	1692	0	"		
Bents 80, 81, 83 and 84	4	330	1	1/2" #	7	3	29	0	0.67		
		333	1	"	8	3	33	0	"	68	
		336	1	"	9	9	39	0	"		
		366	2	3/8" #	24	0	192	0	0.38	164	
		367	2	"	30	0	240	0	"		
		368	4	1" #	26	0	416	0	3.4		
		375	4	"	31	0	496	0	"	4189	
		302	4	"	28	0	112	0	"		
		306	8	"	26	0	208	0	"		
		314	15	1/2" #	30	0	390	0	0.67		
		315	2	"	25	0	50	0	"		
		316	1	"	20	0	20	0	"		
		317	1	"	15	0	15	0	"	654	
		318	1	"	11	0	11	0	"		
		321	53	"	9	3	490	3	"		
		322	43	3/4" #	7	9	333	3	1.5	1080	
		323	43	"	9	0	387	0	"		
		330	9	1/2" #	7	3	63	3	0.67		
		333	7	"	8	3	57	9	"		


**BILL OF MATERIAL FOR DWG. N° B-4-46 CONT'D.**

Bent	Number of Bents	Mark	Number Reqd.	Size	Length Ft.	In.	Total Length Ft.	In.	Wt. per Ft.	Total Wt.	Remarks
		335	6	1/2" #	9	3	55	6	0.67		
		336	1	"	9	9	9	9	"		
Bent 52		337	3	"	10	3	30	9	"		
		338	3	"	10	9	32	3	"		
		340	3	"	11	6	34	6	"		
		341	3	"	12	0	36	0	"		
		342	3	"	12	6	37	6	"		
		343	3	"	13	0	39	0	"		
		344	3	"	13	3	39	9	"		
		346	3	"	14	6	43	6	"	548	
		347	3	"	14	9	44	3	"		
		348	3	"	15	0	45	0	"		
		349	3	"	15	6	46	6	"		
		350	3	"	16	0	48	0	"		
		351	3	"	16	6	49	6	"		
		352	3	"	17	0	51	0	"		
		353	3	"	17	6	52	6	"		
		360	4	1" #	32	0	128	0	3.4	870	
		361	4	"	32	0	128	0	"		
		367	8	3/8" #	30	0	240	0	0.38	91	
										44085 #	
										22.05	or


**BILL OF MATERIAL FOR DWG. N° B-4-47 AND B-4-32**

	Mark	Number Reqd.	Size	Length Ft.	In.	Total Length Ft.	In.	Wt. per Ft.	Total Wt.	Remarks
Regular Pilasters	135	403	4	1/2" #	6	3	337.5	0	0.67	2261
		404	4	3/4" #	5	6	297.0	0	1.5	4455
		405	4	7/8" #	6	6	357.0	0	2.6	20358
		406	4	"	8	0	432.0	0	"	
		402	4	1/2" #	4	6	288	0	0.67	193
Pilasters of Exp. Joint	16	404	4	3/8" #	5	6	352	0	1.5	528
		405	4	3/8" #	6	6	416	0	2.04	1893
		406	4	"	8	0	512	0	"	
Long Pilasters at Outshore End	17	403	4	1/2" #	6	3	425	0	0.67	285
		418	8	7/8" #	5	3	714	0	2.6	1856
Pilasters of Exp. Joint at Outshore End	2	402	4	1/2" #	4	6	36	0	0.67	24
		418	9	7/8" #	5	3	84	0	2.6	218
		415	4	1/2" #	7	9	124	0	0.67	83
Pilasters "B"	4	418	8	7/8" #	5	3	168	0	2.6	437
		416	4	7/8" #	8	3	132	0	0.67	88
		418	9	7/8" #	5	3	189	0	2.6	491
		417	4	1/2" #	7	5	29	0	0.67	19
		418	8	7/8" #	5	3	42	0	2.6	109
Pilasters "A"	4	404	4	3/8" #	5	6	22	0	1.5	33
Standard 6" Wall	127	407	37	3/8" #	5	3	2466.5	9	1.04	25657
6" Wall near Exp. Joint	15	411	5	1/2" #	20	6	15017	6	0.67	8722
		407	35	3/8" #	5	3	2766	3	1.04	2999
		408	2	"	4	3	127	6	"	
		410	5	1/2" #	19	9	1481	3	0.67	992
		400	158	3/8" #	3	6	553	0	1.5	830
		407	590	3/8" #	5	3	3097	6	1.04	3292
		408	16	"	4	3	68	0	"	
		409	10	1/2" #	3	3	32	6	0.67	

NOTE: If Preferable Steel Straps May Be Welded Instead of Riveted To Curb Angle

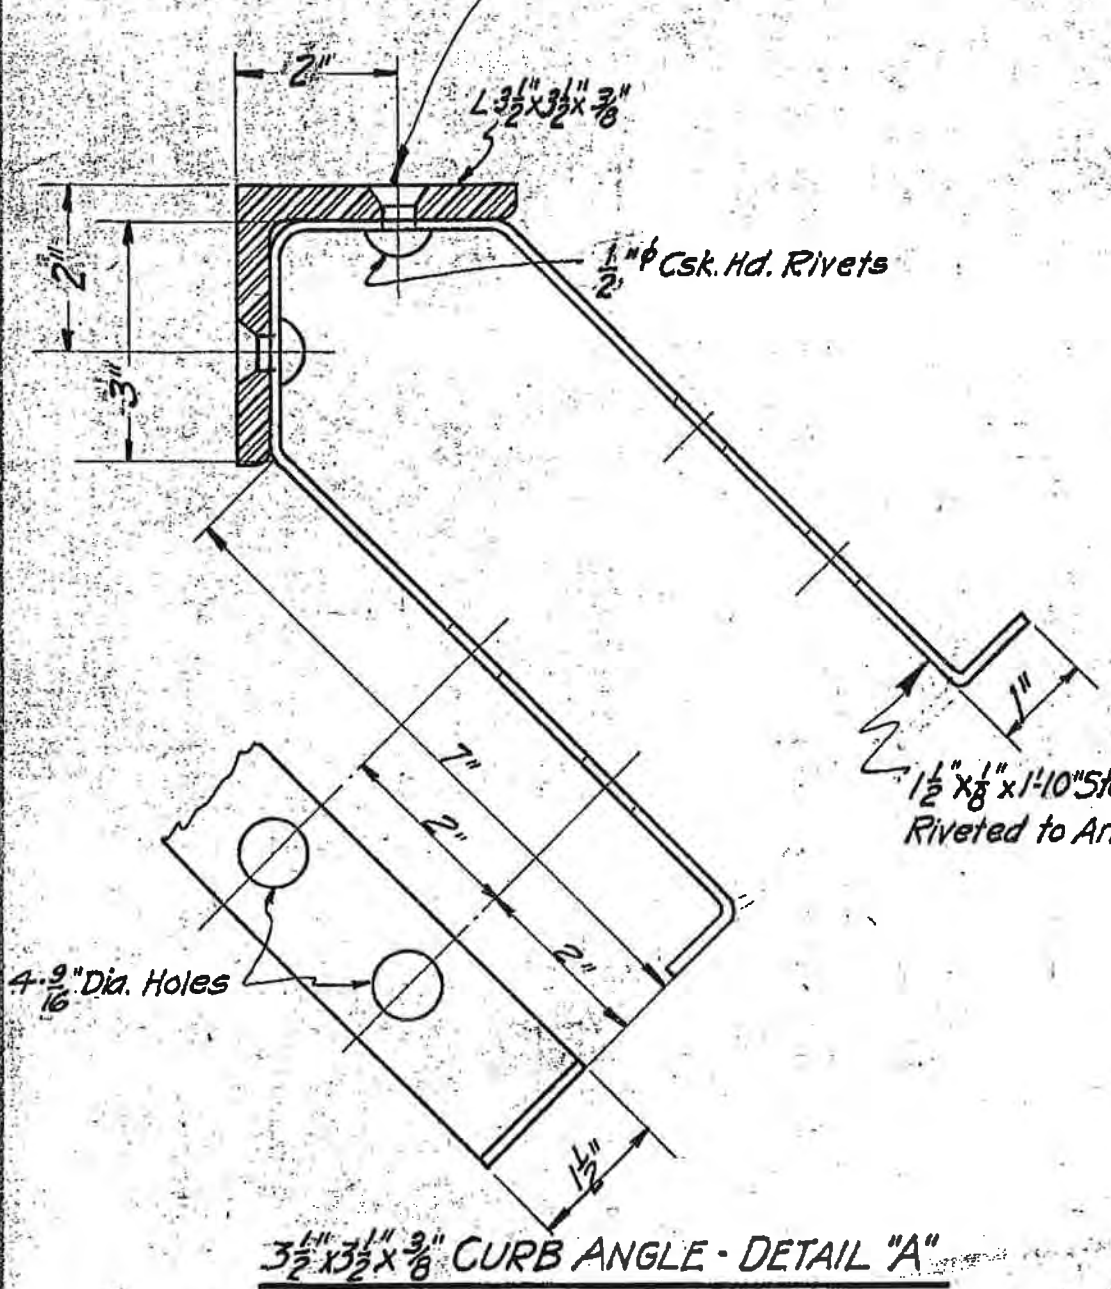

3 1/2" x 3 1/2" x 3/8" CURB ANGLE - DETAIL "A"


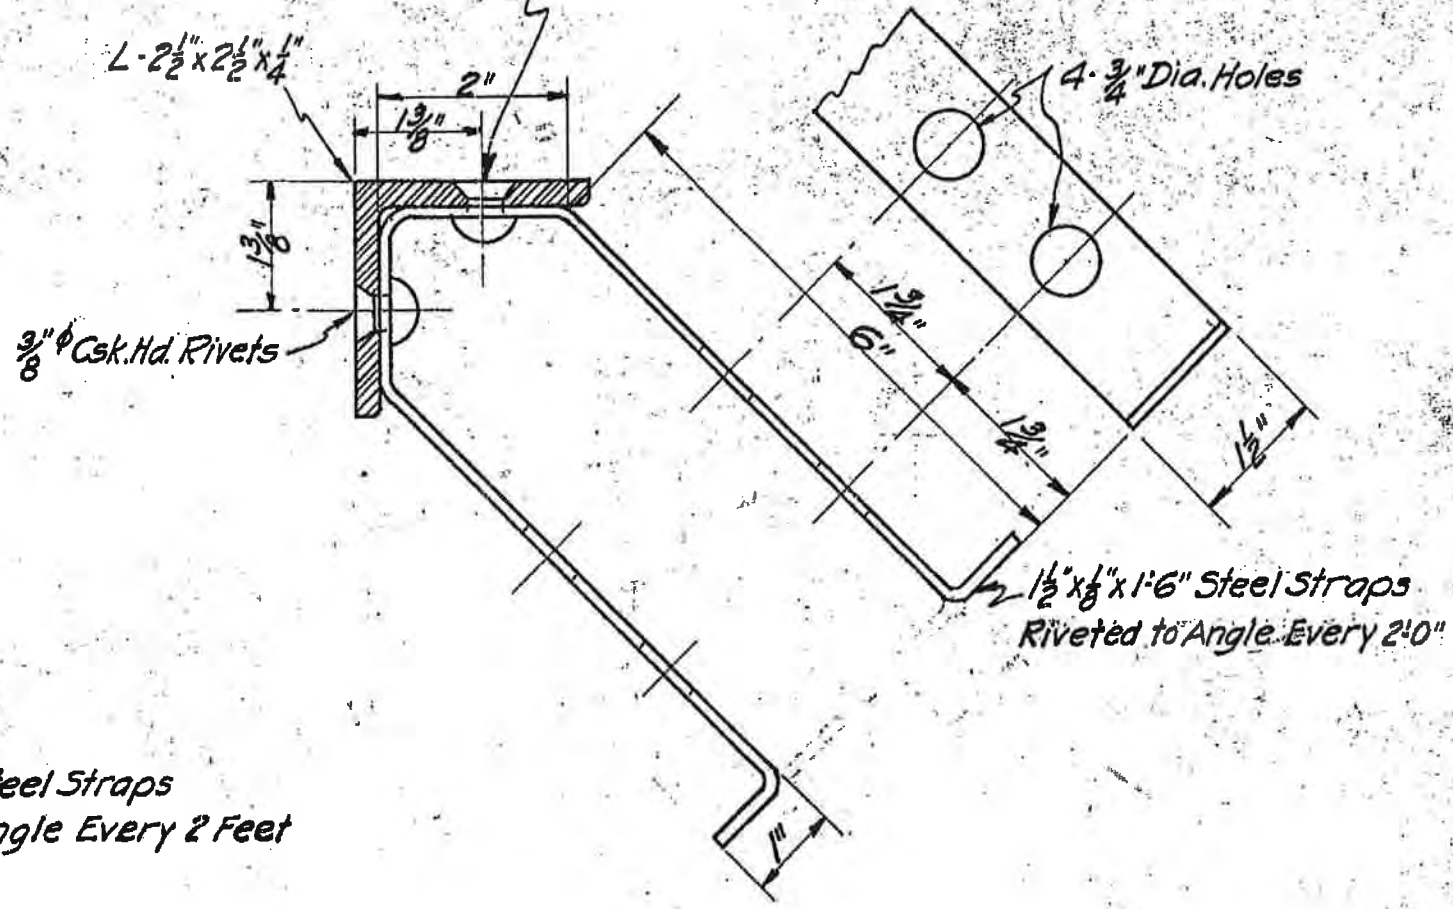


2 1/2" x 2 1/2" x 1/4" CURB ANGLE - DETAIL "B"

Note: This is not suitable for a 6" slab r/s.


Revised - Jan. 9, 1926

ALABAMA STATE DOCKS COMMISSION MOBILE, ALABAMA.	
<b>CONCRETE WHARF CURB ANGLES</b>	
SCALE: 6" = 1'-0"	DRAWN BY W. H. H.
DATE: Oct. 15, 1925	CHECKED BY E. W. C.
 CHAIRMAN	
B342a	

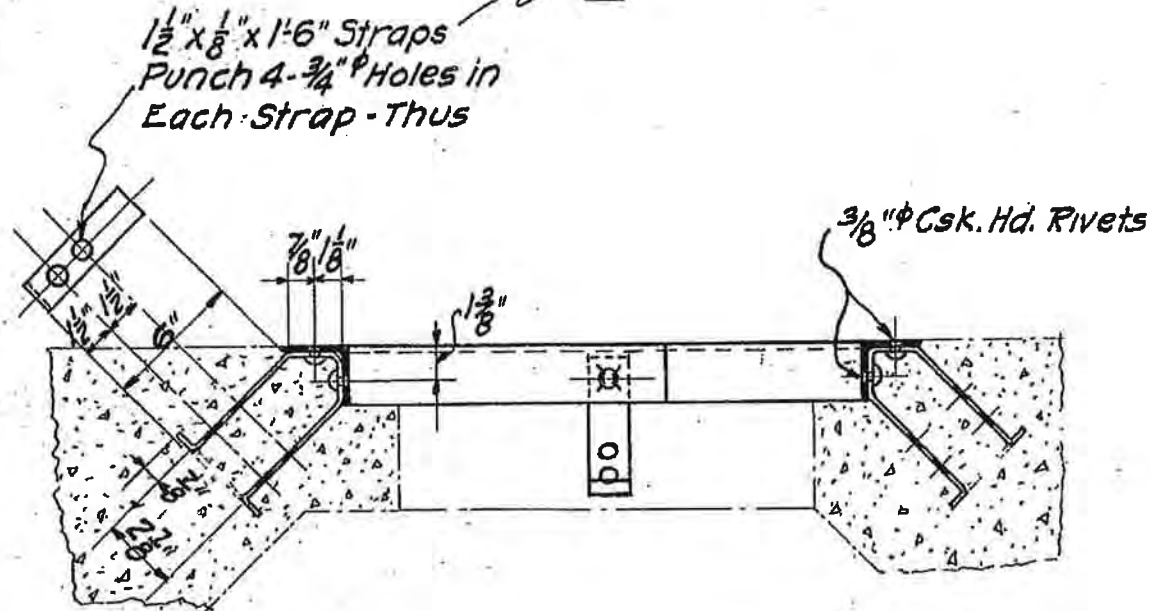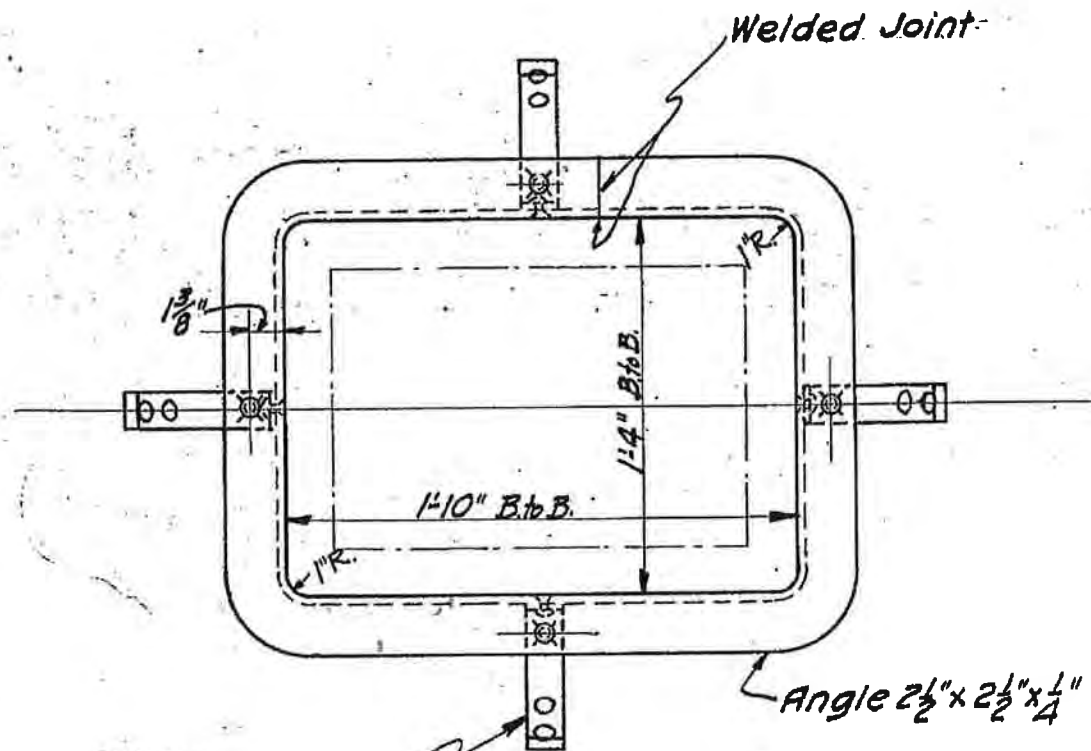

MAN HOLE FRAME


NOTE: If Preferable Steel Straps May Be Welded  
Instead of Riveted to Curb Angle


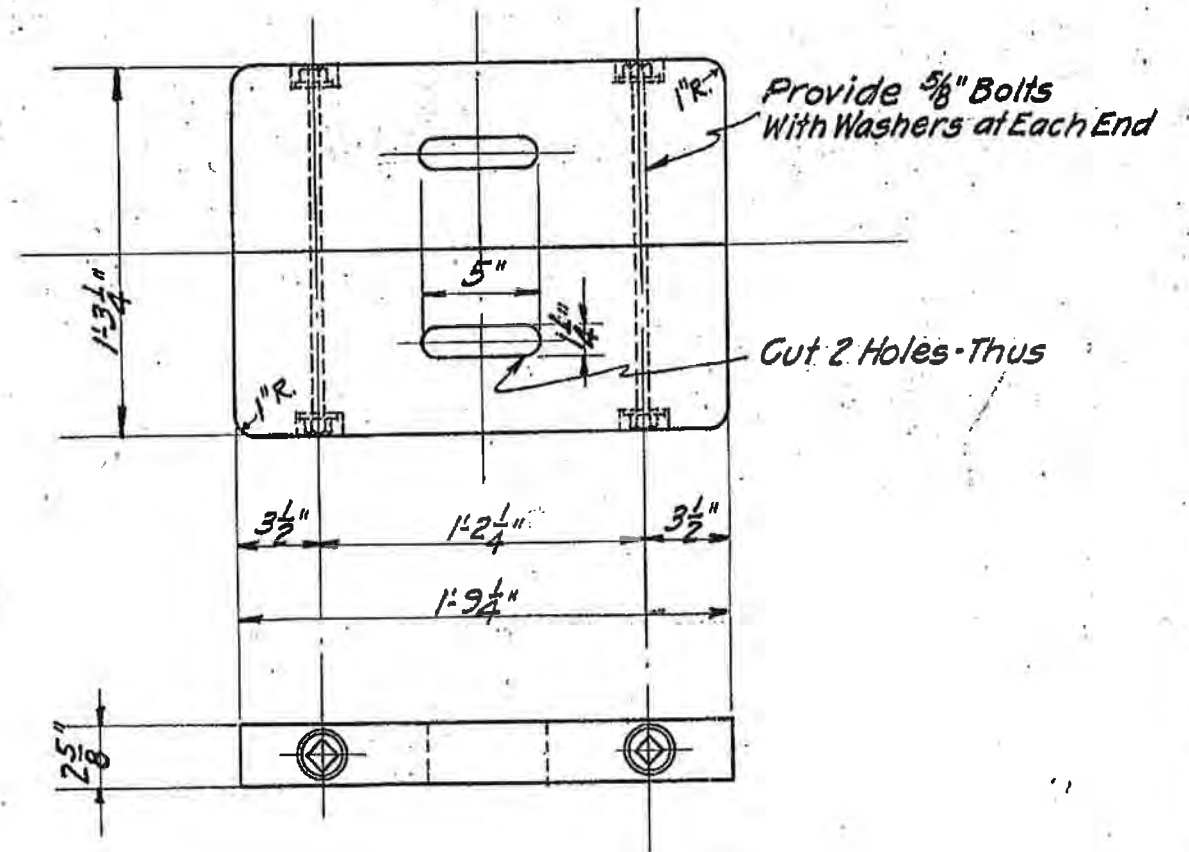


MAN HOLE COVER  
HARD WOOD

Revised-Jan. 9, 1926

This Frame Used in Connection  
With Water Service Lines Only!

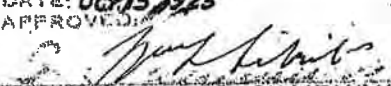
ALABAMA STATE DOCKS COMMISSION MOBILE, ALABAMA.	
CONCRETE WHARF MANHOLE FRAME & COVER	
SCALE: 1 1/2" = 1'-0"	DRAWN BY W.L.H.
DATE: OCT 15 1925	CHECKED BY E.W.C.
APPROVED:	
 CHAIRMAN	
B-3-43a	

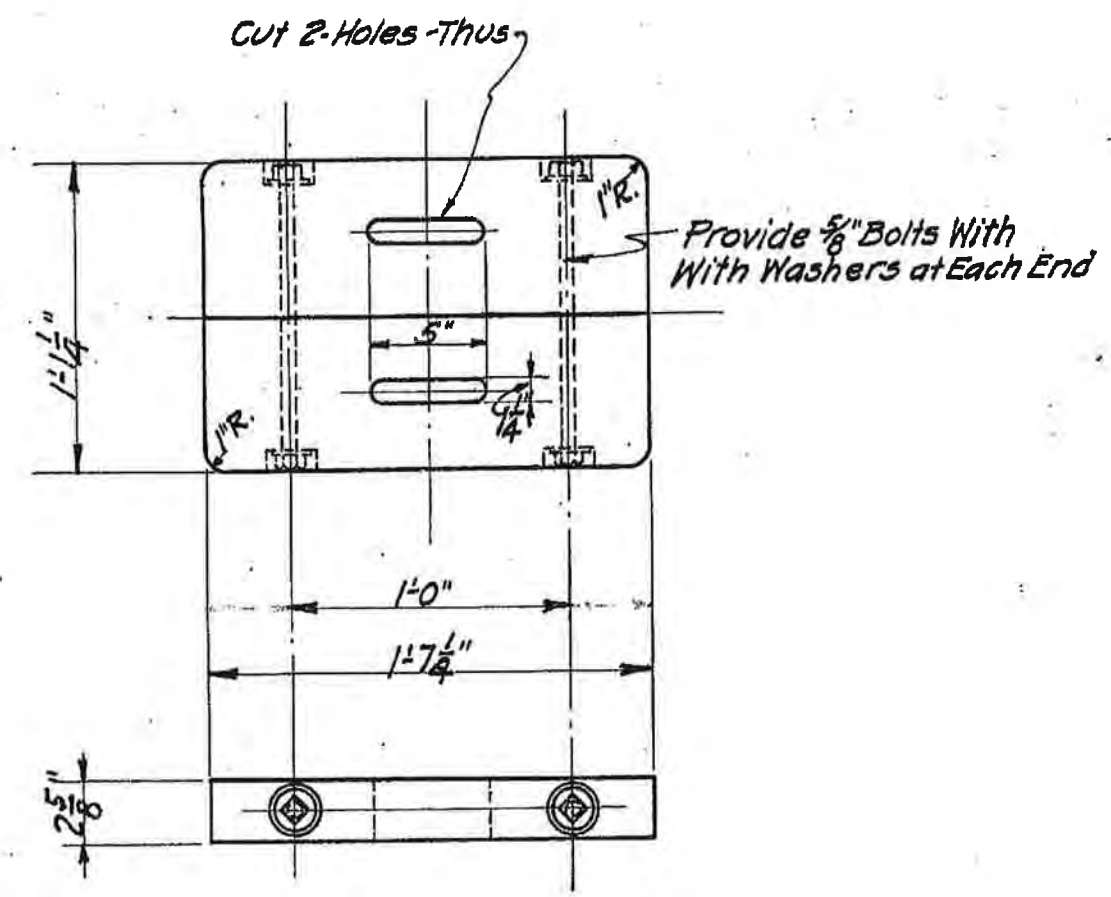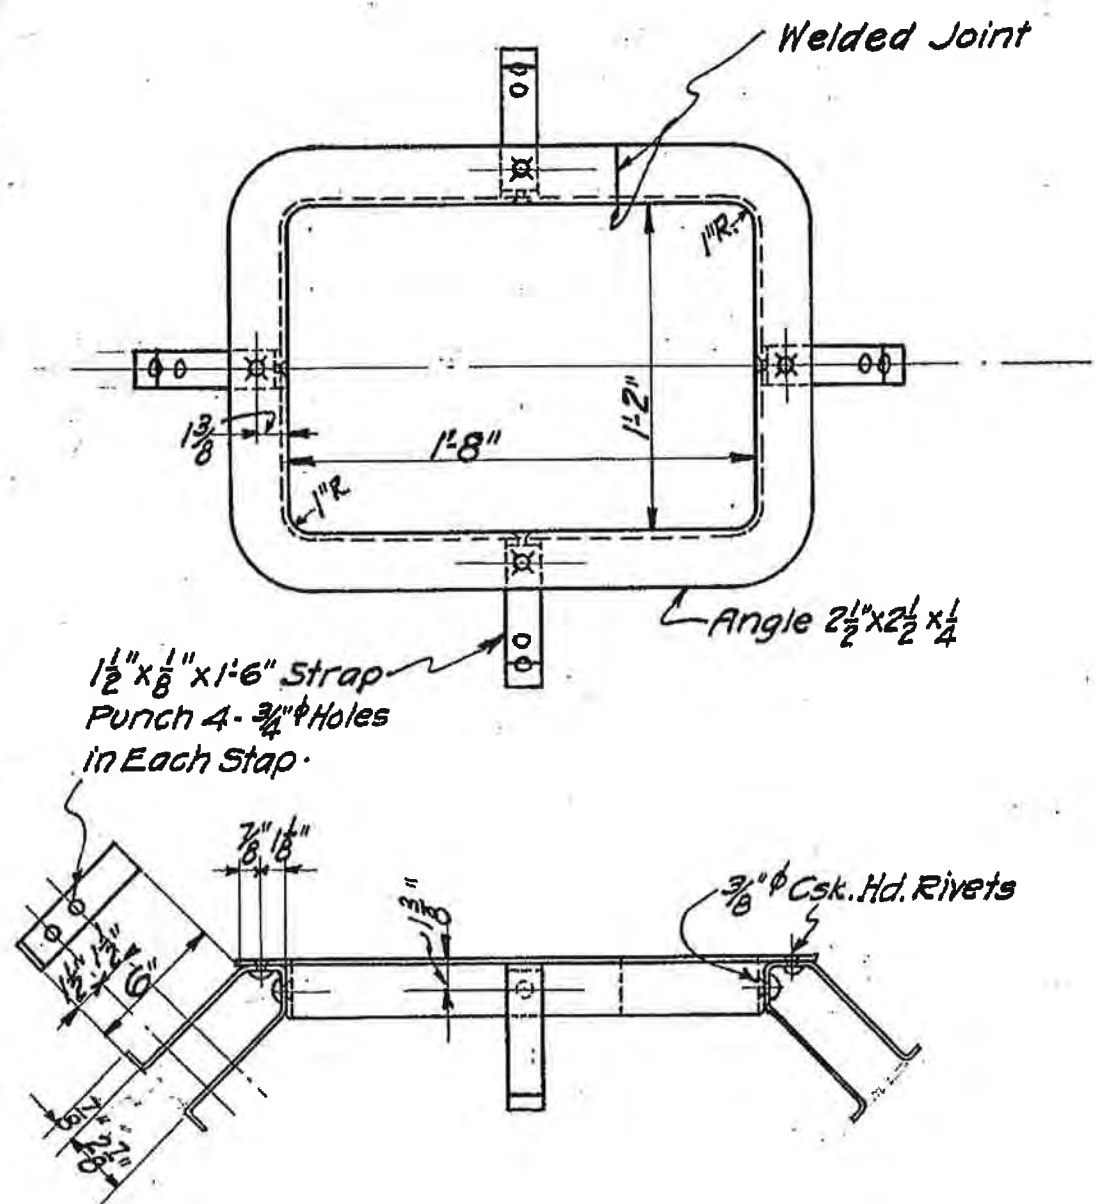


NOTE - If Preferable Steel Straps May Be Welded Instead of Riveted To Curb Angles.

Revised - Jan. 9, 1926


This Frame Used in Connection With Electric Service Lines Only

ALABAMA STATE DOCKS COMMISSION MOBILE, ALABAMA.	
CONCRETE WHARF MANHOLE FRAME & COVER	
SCALE: $\frac{1}{2}'' = 1'-0''$	DRAWN BY W.L.H.
DATE: 1/9/26	CHECKED BY E.W.C.
APPROVED:	
 CHAIRMAN	
<b>B-344a</b>	

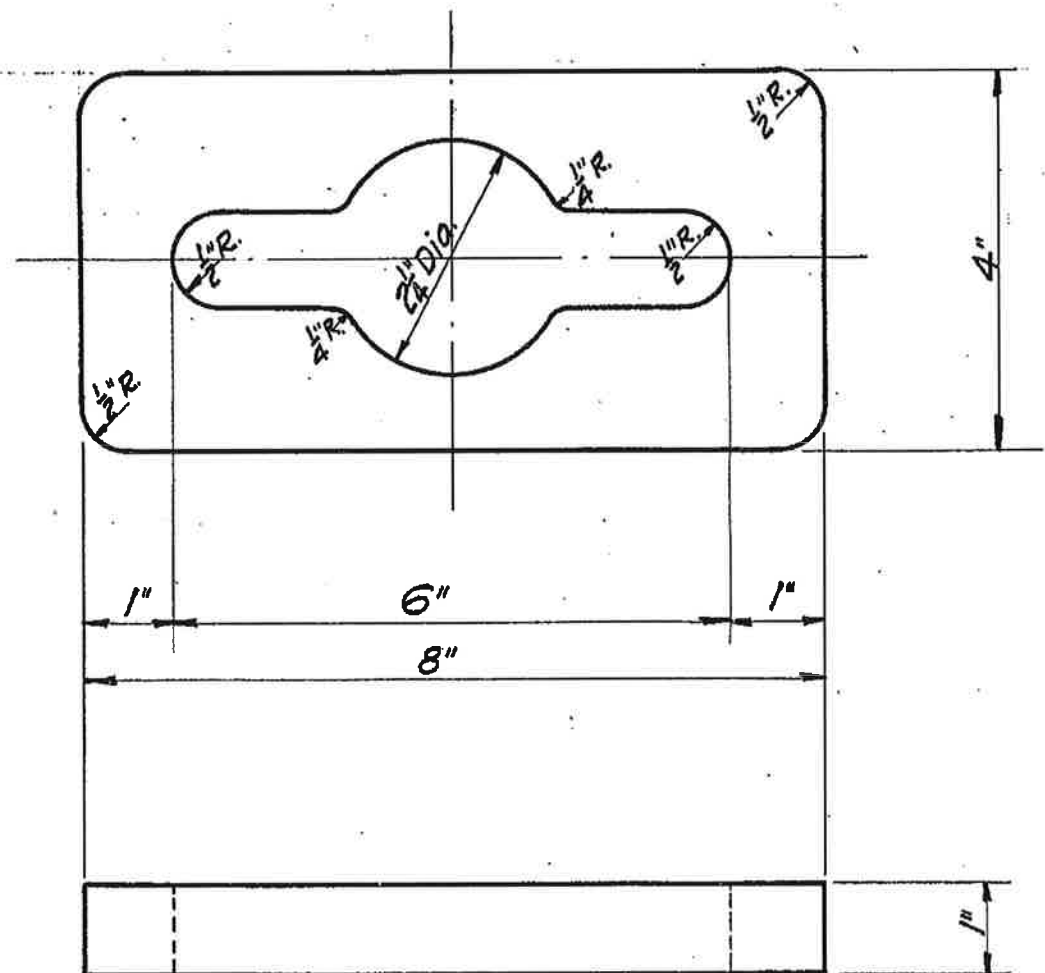

KEY HOLE PLATE  
Cast Iron -

ALABAMA STATE DOCKS COMMISSION MOBILE, ALABAMA.	
<b>CONCRETE WHARF KEY HOLE PLATE</b>	
SCALE: 6"=1'-0"	DRAWN BY <i>W.H.</i>
DATE: <i>Oct 15, 1925</i>	CHECKED BY <i>C.W.C.</i>
APPROVED:	
<i>[Signature]</i> CHAIRMAN	
<b>B3-45a.</b>	

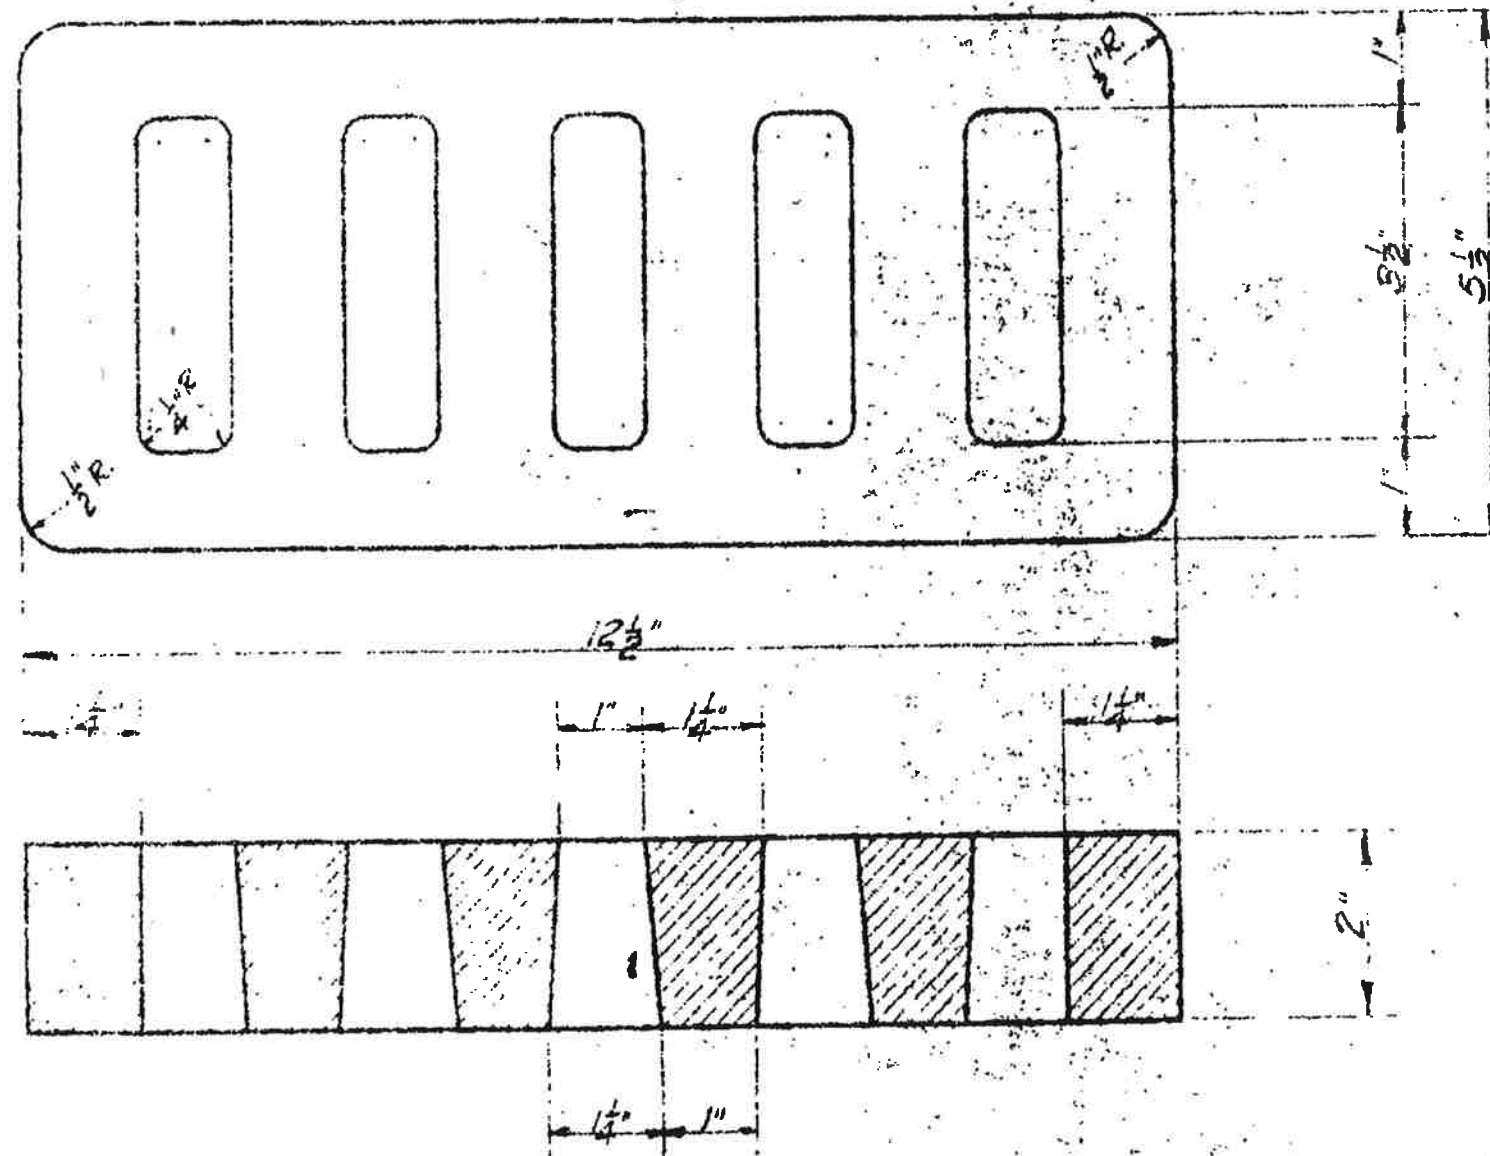

VENT GRATING  
Cast Iron

ALABAMA STATE DOCKS COMMISSION MOBILE, ALABAMA.	
CONCRETE WHARF VENT GRATING	
SCALE: 6"=1'-0"	DRAWN BY: [Signature]
DATE: Oct. 15, 1945	CHECKED BY: [Signature]
APPROVED: [Signature]	CHAIRMAN
	83-46a